

CITY OF MILLERSBURG, OREGON

for the construction of the
TRANSITION PARKWAY AND LINEAR PARK

VOLUME 5
REFERENCE INFORMATION

Project No. 2022-006

Bid Documents

JACOBS

Corvallis, Oregon

May 2024

This project was funded in part with a financial award from the Special Public Works Fund, funded by the Oregon State Lottery and administered by the Oregon Infrastructure Finance Authority.

© Jacobs 2023. All rights reserved.

Any reuse, modification, or alteration of this document and the ideas and designs incorporated herein is at the sole risk of the party(ies) reusing, modifying, or altering it. All references to Jacobs and its employees and all professional seals shall be removed prior to any reuse, modification, or alteration of this document.

Project No. D3395316

Copy No. _____

TABLE OF CONTENTS

VOLUME 5

REFERENCE INFORMATION

1. Radiation Sources and Remedial Actions for the SAA Property in Millersburg, OR
2. Geotechnical Data Report
3. City of Millersburg Sanitary Sewer Collection System Contract 2
4. City of Millersburg Sanitary Sewer Collection System Contract 3
5. City of Millersburg Sanitary Sewer Collection System Contract 4
6. Drain Tile Figure with Streets Added
7. Millersburg Fire Station 15 Conformed Civil Drawings
8. Level 3 Communications Fiber-Optic Cable Route

1. Radiation Sources and Remedial Actions for the SAA Property in Millersburg, OR

January 29, 2024

Technical Memorandum

Radiation Sources and Remedial Actions for the SAA
Property in Millersburg, OR

Prepared by Radian Consulting Group, LLC

Colby D. Mangini, Ph.D., CHP

Emily A. Caffrey, Ph.D., CHP

Introduction

This memorandum addresses potential concerns regarding the naturally occurring radiological material (NORM) that is present at the Soil Amendment Area, or SAA (hereafter “Site”). The Site is located on Conser Road NE in Millersburg, Oregon (Linn County) and is approximately 41 acres in size. In 1975 and 1976, the Oregon Department of Environmental Quality (DEQ) issued a solid waste permit for a one-time application of solids from ATI’s (formerly Teledyne Wah Chang) wastewater treatment system as an experimental soil amendment. The solids applied to the soil contained NORM from the processing of zircon sands. The Site was listed on the National Priorities List (NPL) in 1983 by the Environmental Protection Agency (EPA). Ownership of the SAA was transferred to the City of Millersburg in 1990 (EPA 2006).

Radiation Sources at the SAA

The NORM used on the SAA consisted primarily of radium-226. Radium is a naturally occurring, silvery white radioactive metal that is formed when uranium and thorium decay in the environment. It has been found at very low levels in soil, water, rocks, coal, plants, and food (NCRP 1984; WHO 2012). Radium-226 decays into radon-222 when it undergoes a nuclear transformation. The rate of this transformation is driven by the half-life of radium-226, or the time required for half of the radium-226 atoms to transform into radon-222. Given that the half-life of radium-226 is 1,602 years, the radiological concerns associated with its presence may require remedial actions and institutional controls for extensive periods of time.

Radon-222 is a gas that when inhaled represents one of the largest sources of radiation exposure in the environment and is found in both outdoor and indoor air of buildings of all kinds (EPA 2003). Radon-222, with a 3.8-day half-life, decays to into a series of short-lived decay products that get filtered by the human lungs when inhaled. The National Council on Radiation Protection and Measurements (NCRP) has documented contributions from sources of radiation exposure to the total radiological dose per individual in the U.S. population, most recently for the year 2006 (NCRP 2009). The NCRP report estimates that radon exposure accounts for ~75% of an individual’s yearly dose from natural background sources (not including medical sources).

Radon levels vary widely across the United States, with elevated levels most commonly found in the Appalachians, the upper Midwest, and the Rocky Mountain states (NCRP 2009; Marsh et al. 2010). The average radon concentration in the indoor air of America’s homes is about 1.3 pCi/liter (pico-Curie per liter of air). For enclosed structures in Linn County, the average radon concentration is less than 2.0 pCi/ liter. The average radon concentration in outdoor air is 0.4 pCi/ liter, or one-tenth of EPA’s 4 pCi/ liter action level (EPA 2003). The EPA action level of 4 pCi/ liter is directly correlated to the amount of radium-226 present in the ground surrounding and beneath an enclosed structure. The presence of radium-226 is typically measured in units of pCi per gram of material, or pCi/gram.

Terrestrial radiation, or external terrestrial radiation, consists of radiation emitted from natural sources in the earth and accounts for roughly 7% of an individual’s yearly background exposure (NCRP 2009). The primary path of exposure from terrestrial radiation is simply being in close proximity to the source in the environment (e.g., standing on soil, concrete, etc.). Sources such as radium-226 and the short-lived radon-222 decay products are contributors to terrestrial radiation due to the gamma-ray and x-ray emissions that are associated with their decay. Accurate measurement of the external gamma radiation levels in units of

µrem/hour (micro-rem per hour) is used to monitor and control potential exposures to terrestrial radiation sources.

Remedial Actions for SAA

There are two governing documents that provide the regulatory framework for the Site as it pertains to NORM and corresponding radiological safeguards and remedial actions:

1. The EPA *Record of Decision, Declaration, Decision Summary and Responsiveness Summary of Final Remedial Action for Surface and Subsurface Soil Operable Unit* (the “ROD”) with ATI (EPA 1995).
2. The City of Millersburg Consent Decree (EPA et al. 2006).

In the ROD, dated September 27, 1995, the EPA Region 10 Regional Administrator selected a remedial action plan for the Site (EPA 1995).

The ROD remedial actions pertaining to radionuclide contamination addressed the risks posed by surface external gamma radiation and radon. From Section 10.1 of the ROD, it is stated that Site

Areas with surface gamma radiation levels exceeding 20 µrem/hour over background levels (equal to 30.5 µrem/hour) averaged over 100 square meters will be excavated.

The SAA uses a “reference level” of 12.5 µrem/hour (ROD Section 6.4.1.1) as background (rather than the 10.5 µrem/hour Main Plant background level), resulting in a gamma cleanup level of 32.5 µrem/hour. From Table 6-5 and Figure 6-6 of the ROD, it is clear that none of the averaged gamma radiation levels exceeded the 32.5 µrem/hour cleanup level (20 µrem/hour above the reference level, measured at a height of 1 meter). In fact, none of the average levels were found to be more than 10 µrem/hour over the reference level. As a result, no remedial action pertaining to external gamma radiation levels was required for the SAA.

In November of 2021, an SAA scoping survey was performed by GSI Water Solutions, Inc. on behalf of the City of Millersburg. The results of this survey were published in a technical memorandum on January 28, 2022 entitled *Soil Amendment Area Scoping Survey Summary*. The memorandum demonstrated that the geospatial behavior in 2021 is consistent with that of the 1995 ROD gamma survey. In their December 5, 2022 report entitled *Evaluation of SAA Remedial Actions and GSI Survey Results*, the Certified Health Physicists at Radian Scientific demonstrated that the results presented in the GSI memorandum are consistent with the conclusion of the 1995 ROD that no areas in the SAA exceed the gamma radiation levels of 20 µrem/hour above the reference level. In fact, their review suggested that the gamma radiation levels at the SAA are more than likely at or below the levels measured in the original 1995 ROD and therefore the ROD conclusion of no remedial actions pertaining to surface gamma radiation levels is still valid.

Remedial actions for mitigating radon in future buildings are provided in Section 10.2 of the ROD where it is stated that

Action for radon is required for the entire Soil Amendment Area, and for areas on the Main Plant plan where surface and subsurface soil radium-226 concentrations exceed 3 pCi/gram. These areas could exceed the action level for radon of 4 pCi/liter if buildings are constructed in the future.

Additionally,

The selected remedy requires that future buildings be constructed using radon controlling construction methods.

It goes on to say,

The only other effective remedial alternative for mitigation of radon in the Soil Amendment Area was excavation of soil to background levels. This option was eliminated as being prohibitively expensive. Current plans for the Soil Amendment Area are for use as an industrial park. During a meeting with the city of Millersburg, it was suggested that the contaminated material in the Soil Amendment Area might be excavated and used to construct landscaping and berms. The efficacy of this potential option has not been considered. However, if it is later offered as a potential option by the City, proves viable, and meets the remedy selection criteria, EPA may reconsider this portion of the selected remedy.

The EPA did in fact reconsider this alternative in the *Explanation of Significant Differences to the To the September 27, 1995 Record of Decision: Final Remedial Action for Surface and Subsurface Soil Operable Unit* (the “ESD”; EPA 2001), where it provided the city of Millersburg the option for radium-226 contaminated soil in the SAA to be excavated to an EPA approved radium-226 concentration with the excavated material being used in on-site berms or disposed of in an EPA approved off-site landfill (Section 4.6 of ESD; EPA 2001). The EPA approved radium-226 level is one that is “statistically indistinguishable” from background. The risk from radon in future buildings must not exceed an excess cancer risk of 1×10^{-4} (Section 4.2.2.3 of ESD; EPA 2001). Modeling results indicate that approximately 0.3 pCi/gram radium-226 equates to the 1×10^{-4} risk level. This concentration is approximately 25% of the background radium-226 concentration and is unlikely to be differentiable from background levels analytically.

In October of 1996, the City of Millersburg, the EPA, the Oregon Department of Environmental Quality (ODEQ) and Teledyne Wah Chang entered into a Consent Decree implementing the decisions outlined in the ROD (EPA 2006). Exhibit C of this Consent Decree is the *Requirements for Remedial Design and Remedial Action (RD/RA) for Soil Removing or Berming* and Exhibit A is the *Environmental Protection Easement and Equitable Servitude*. In Section 3 of Exhibit A, it is stated that the applicability of building construction requirements on the SAA “does not apply to open structures such as parking areas (including parking areas that are covered, but not enclosed), exterior storage areas, utility vaults, or other similar structures.” Furthermore, the introductory paragraph of Exhibit C goes on to say that “earth moving and site grading activities associated with development or construction do not constitute excavation activities subject to this Exhibit C.”

The Consent Decree specifically differentiates between excavation for purposes of building an enclosed building and the earth moving and site grading activities that may occur at the SAA for other purposes. According to the Consent Decree, the building of roads, parking lots, storage areas, etc., would not require any radon mitigation building techniques, nor would they require soil excavation to an EPA approved radium-226 level. Activities such as earth moving and site grading are not considered excavation and the materials moved within the SAA would not require berming or disposal at an EPA-approved landfill.

Radiological Risks Associated with SAA

Risk in the context of radiation exposure is the increased chance of developing cancer above the rate normally expected in the population at large, where according to the most recent report by National Academy of Sciences Biologic Effects of Ionizing Radiation (BEIR), 42 out of 100 persons are expected to develop cancer from sources other than radiation exposure in their lifetime (NRC 2006). Risk estimates that are used to predict public health effects are based on detailed epidemiological studies of exceedingly well-defined populations. Such studies have not demonstrated health effects to individuals exposed to less than 10,000 millirem (mrem) as statistical limitations making it difficult to evaluate cancer risk in humans at these lower doses (HPS 2004; NRC 2006). A comprehensive review of available biological and biophysical data led the BEIR committee to assume that the risk would continue in a linear fashion at lower doses without a threshold (i.e., any dose greater than zero has the potential to cause a small increase in risk to humans). This assumption is termed the “linear-no-threshold” (LNT) model.

The EPA performed a detailed radiological human risk assessment for the SAA, as documented in Section 7.0 of the ROD (EPA 1995). The EPA used an incremental excess lifetime cancer risk threshold of 1×10^{-4} (incremental means risk in excess of background risk). An incremental excess cancer risk of 1×10^{-4} indicates that an individual has a 1 in 10,000 chance of developing cancer when exposed to a given amount of radiation over their lifetime. The radiation dose corresponding to a risk level of 1×10^{-4} is 100 mrem (NRC 2006). While this dose is 100 times lower than the 10,000 mrem discussed previously, the LNT model provides a risk estimate associated with this low dose. By comparison, the background or normal lifetime risk of developing cancer is 4.2×10^{-1} (42 out of 100).

The threshold value of 20 μ rem/hour (or 0.02 mrem/hour) above background is selected to ensure the risk from gamma exposure is minimized. Exposure to the external gamma radiation field of the SAA occurs when an individual is either standing directly on the SAA soil surface or on a ground covering directly over the SAA soil (parking lot, road, slab foundation, etc.). The EPA considered the current use of the SAA (agricultural) and anticipated future use (industrial) when identifying likely exposure scenarios (EPA 1995). In the agricultural setting, the individual is assumed to spend 40 hours per week outside for a period of 30 days per year for 25 years. In the industrial setting, the individual is assumed to spend 10 hours per week outside and 30 hours per week inside a building located on top of SAA soil for a period of 250 days per year for 25 years. Based on the average gamma exposure rates of the SAA, the incremental excess lifetime cancer risk for the agricultural scenario was found to be of 9.1×10^{-6} (EPA 1995). The average incremental excess lifetime cancer risk for the future industrial scenario was 5.8×10^{-5} . Both of these scenarios are below the EPA threshold value of 1×10^{-4} and can be considered insignificant when compared to the normal cancer risk from sources other than radiation.

The 20 μ rem/hour above background threshold is consistent with the EPA’s indoor gamma radiation limit for the remediation of inactive uranium processing sites (EPA 1982). The National Research Council estimated that the annual gamma radiation dose associated with 20 μ rem/hour above background is roughly 100 mrem (i.e., risk level of 1×10^{-4}) (NRC 1999). As a point of reference, the NCRP estimates that on average, a person in the United States receives about 311 mrem of dose each year from natural background radiation sources (NCRP 2009).

Conclusion

The ROD, ESD, and Consent Decree provide very clear guidance on remedial actions required for the SAA. If an enclosed building is going to be built on the SAA, the risk of radon must be mitigated in one of two ways:

1. If no excavation of radium-226 contaminated soils will occur at the proposed build site, enclosed buildings must be constructed using radon controlling construction methods.
2. In the absence of approved radon controlling construction methods, radium-226 contaminated soils must be excavated to a cleanup level that is statistically indistinguishable from background. The excavated soil can be bermed at the SAA or disposed of at an off-site landfill (ESD Section 4.6.2).

Exhibit A and C of the Consent Decree state that such remediation actions are not required for activities such as road building, parking lot building, or earth moving and site grading.

The risk associated with external gamma radiation is mitigated by ensuring that radionuclides present in the SAA soils do not result in a gamma dose rate greater than 20 $\mu\text{rem}/\text{hour}$ above background, measured at 1 m above the surface and averaged over 100 m^2 . Areas where this cleanup level is exceeded must be excavated. It has been concluded in the ROD, and subsequently supported by analyzing the GSI scanning survey results, that the SAA does not contain any areas that need to be excavated to mitigate the gamma radiation risks.

References

- EPA. 1982. Final Environmental Impact Statement for Remedial Action Standards for Inactive Uranium Processing Sites (40 CFR 192). EPA 520/4/82/013-1. Washington, DC: Environmental Protection Agency.
- EPA. 1995. Record of Decision Declaration, Decision Summary, and Responsiveness Summary for Final Remedial Action for Surface and Subsurface Soil Operable Unit, Teledyne Wah Chang Albany Superfund Site, Millersburg, Oregon. Prepared by the U. S. Environmental Protection Agency.
- EPA. 2001. Explanation of Significant Differences to the September 27, 1995 Record of Decision: Final Remedial Action for Surface and Subsurface Soil Operable Unit, Teledyne Wah Chang Albany Superfund Site, Albany, Oregon. Prepared by the U. S. Environmental Protection Agency.
- EPA. 2003. *EPA Assessment of Risks from Radon in Homes*. EPA 402-R-03-003. Office of Radiation and Indoor Air, U.S. EPA, Washington, D.C. June.
- EPA. 2006. Consent Decree. United States and State of Oregon v. City of Millersburg, Civil Action No. 6:06-CV-06069-TC. United States District Court for the District of Oregon. U.S. Environmental Protection Agency, Oregon Department of Environmental Quality, and City of Millersburg.
- DOD (Department of Defense). 2000. Multi-Agency Radiation Survey and Site Investigation Manual (MARSSIM). Revision 1. Prepared by the U.S. Department of Defense (DOD), U.S. Department of Energy (DOE), U.S. Environmental Protection Agency (EPA), and U.S. Nuclear Regulatory Commission (NRC). Report Numbers: NUREG-1575, Rev.1; EPA-402-R-97-016, Rev. 1; and DOE/EH-0624, Rev. 1.
- HPS (Health Physics Society). 2004. Radiation Risk in Perspective: Position Statement of the Health Physics Society. Retrieved from: <https://hps.org/documents/radiationrisk.pdf>.

- Marsh, J.W., J.D. Harrison, D. Laurier, E. Blanchardon, F. Paquet, and M. Tirmarche. 2010. "Dose Conversion Factors for Radon: Recent Developments." *Health Physics* 99 (4): 511–516.
- NCRP (National Council on Radiation Protection and Measurements). 1984. *Exposures from the Uranium Series with Emphasis on Radon and Its Daughters*. NCRP Report No. 77. National Council on Radiation Protection and Measurements, Bethesda, Maryland.
- NCRP. 2009. *Ionizing Radiation Exposure of the Population of the United States*. Report No. 160. National Council on Radiation Protection and Measurements, Bethesda, Maryland. March.
- NRC (National Research Council). 1999. National Research Council (US) Committee on Evaluation of EPA Guidelines for Exposure to Naturally Occurring Radioactive Materials. Evaluation of Guidelines for Exposures to Technologically Enhanced Naturally Occurring Radioactive Materials. Washington (DC): National Academies Press (US); 1999. Available from: <https://www.ncbi.nlm.nih.gov/books/NBK230656/> doi: 10.17226/6360
- NRC. 2006. Health Risks from Exposure to Low Levels of Ionizing Radiation: BEIR VII Phase 2. Washington, DC: The National Academies Press. <https://doi.org/10.17226/11340>.

2. Geotechnical Data Report

Geotechnical Data Report

Document no: 230928093106_fe77bcbf
Final

City of Millersburg

Millersburg Transition Parkway Project
Volume 1
May 20, 2024





Geotechnical Data Report

Client name: City of Millersburg
Project name: Millersburg Transition Parkway Project
Document no: 230928093106_fe77bcbf **Project no:** D3395316
Revision no: Final **Project manager:** Matthew Baldwin
Date: May 20, 2024 **Prepared by:** Jithin Nair, EIT.
File name: Millersburg Transition Parkway_GeotechDataRpt_Final

Document History and Status

Revision	Date	Description	Author	Reviewed	Approved
Draft	9/29/2023	For Review	Jithin Nair	Paul Davis	Paul Davis
Final	5/20/2024		Jithin Nair	Paul Davis	Paul Davis

Jacobs

1100 NE Circle Blvd
Suite 300
Corvallis, OR 97330
United States

T +1.541.752.4271
www.jacobs.com

Copyright Jacobs © 2024.

All rights reserved. The concepts and information contained in this document are the property of the Jacobs group of companies. Use or copying of this document in whole or in part without the written permission of Jacobs constitutes an infringement of copyright. Jacobs, the Jacobs logo, and all other Jacobs trademarks are the property of Jacobs.

NOTICE: This document has been prepared exclusively for the use and benefit of Jacobs' client. Jacobs accepts no liability or responsibility for any use or reliance upon this document by any third party.

Contents

Acronyms and Abbreviations.....	ii
1. Introduction	1
2. Project Description	1
3. Review of Local Geologic and Soil Data	1
4. Field Exploration.....	2
5. Soil Laboratory Testing	3
6. General Soil Profiles.....	4
6.1 Railroad Crossing	5
6.2 Fire Station to Power Station Alignment	5
7. Groundwater	5
8. Limitations.....	5
9. References	5

Tables

Table 1. Summary of Geotechnical Exploration	2
Table 2. Summary of the Laboratory Results	4

Figures

1	Project Vicinity
2	Geotechnical Exploration Plan

Appendices

A	Ground Exploration Logs
B	Soil Laboratory Test Results

Acronyms and Abbreviations

ASTM	ASTM International
bgs	below ground surface
City	City of Millersburg

1. Introduction

This Geotechnical Data Report provides a summary of geotechnical data collected for the Millersburg Transition Parkway Project for City of Millersburg (City). The City is going to construct improvements to the Central Industrial Property, located adjacent to and south of Conser Road NE between the existing segment of NE Transition Parkway and Woods Road NE to support industrial development. The project improvements include an arterial road, stormwater management facilities for the arterial road, extension of water and sewer utilities in the arterial road right of way, and a linear park including a multi-use path to provide a buffer between the residential areas north of Conser Road NE and future industrial development.

The scope of work included the following:

- Review geologic data along project alignment.
- Perform a subsurface exploration by drilling six soil borings and excavating six test pits located along the project alignment. Field geotechnical data collection was performed by Jacobs.
- Perform laboratory testing on selected soil samples to evaluate engineering properties of subsurface materials along the project alignment.
- Prepare this Geotechnical Data Report.

The collected soil data will be interpreted to provide geotechnical recommendations to aid in the design and construction of the project. The geotechnical interpretation of the data and recommendations for design criteria for the facilities will be presented in a separate Geotechnical Recommendations Report by Jacobs.

2. Project Description

NE Transition Parkway will be extended approximately 0.7 mile from the existing eastern segment of NE Transition Parkway, adjacent to Millersburg Fire Station 15, to Conser Road NE, as shown on Figure 1. The storm drain system and potable water pipelines will be routed through City right-of-way along new NE Transition Parkway. The potable water pipeline will consist of 12-inch ductile iron and 20-inch high-density polyethylene water lines and connections to existing lines. The storm drain pipeline will consist of 12-inch and 36-inch ductile iron and polyvinyl chloride materials.

The pipelines will be constructed using conventional open-cut trench excavation methods for the majority of the pipeline. One trenchless installation is currently proposed beneath the BNSF Railway tracks.

3. Review of Local Geologic and Soil Data

Before the geotechnical exploration, geologic maps and soil reports were reviewed. Geologic information for the site and the surrounding area was obtained from the *Preliminary Geologic Maps of The Albany Quadrangle, Linn, Marion, and Benton Counties, Oregon* (Wiley 2006).

Surficial deposits in the vicinity of the site are mapped as Willamette silt (Q_{ws}). The Willamette silt deposits typically consist of thin- to medium-bedded rhythmites of silt, sandy silt, and silty clay that were caused by repeated Missoula (Bretz) floods when glacial dams in the upper Columbia River drainage catastrophically failed and generated floodwaters that temporarily filled the Willamette Valley. Beneath the Willamette silt older, buried, soils and weathered zones are often preserved along the top of the buried unit. Underlying the Quaternary Willamette silt is a late Pleistocene deposit consisting of Stratified bench gravel, sand, and mud, locally referred to as Leffler Gravel (Q_{le}). The thickness of Leffler gravels is estimated up to 50 feet. The Willamette silt and Leffler gravels are underlain by the Spencer Formation (T_{es}). The Spencer Formation consists of shallow marine sandstone, pebbly sandstone, conglomerate, siltstone, claystone, and coal.

Soil reports available from the National Resources Conservation Service provide information on shallow soil materials to about 6 feet deep. The mapped Willamette silt on the Natural Resources Conservation Service interactive geologic map corresponds with the Amity silt loam, Willamette Silt loam, and Woodburn silt loam soils in the soil report covering the project alignment (NRCS n.d.).

4. Field Exploration

Jacobs conducted a geotechnical exploration for Millersburg Transition Parkway in January 2023 to collect soil samples for laboratory testing and to observe soil materials and conditions. Four soil borings and six test pits were explored along the project alignment and two deep soil borings were drilled at trenchless crossing locations near the proposed launch and receiving pits as summarized in Table 1. Figure 2 shows the approximate locations of the boreholes. Soil boring logs are included in Appendix A.

Before starting the geotechnical subsurface exploration program, Jacobs notified the Oregon Utility Notification Center and obtained the necessary utility clearances. The borings were located in the field by Jacobs and adjusted to avoid utility conflicts.

Table 1. Summary of Geotechnical Exploration

Boring No.	Latitude	Longitude	Ground Surface Elevation (feet)	Completion Depth (feet bgs)	Exploration Method Type	Location
B-1-23	44.6808	-123.0762	234	21.5	Hollow Stem Auger	East of power station
B-2-23	44.6808	-123.0726	231	21.5	Hollow Stem Auger	South of Conser Road NE
B-3-23	44.6808	-123.0670	241	21.5	Hollow Stem Auger	South of Conser Road NE
B-4-23	44.6808	-123.0642	225	21.5	Hollow Stem Auger	South of Conser Road NE
B-5-23	44.6796	-123.0775	212	61.5	Sonic Core	South of power station
B-6-23	44.6793	-123.0787	211	61.5	Sonic Core	Southwest of substation on the other side of rail
TP-1-23	44.6808	-123.0753	233	10	Excavation	South of Conser Road NE
TP-2-23	44.6808	-123.0739	235	10	Excavation	South of Conser Road NE
TP-3-23	44.6808	-123.0670	229	10	Excavation	South of Conser Road NE
TP-4-23	44.6808	-123.0656	225	10	Excavation	South of Conser Road NE
TP-5-23	44.6804	-123.0644	224	10	Excavation	South of Conser Road NE
TP-6-23	44.6796	-123.0644	225	10	Excavation	Southwest of fire station

Abbreviations:

bgs = below ground surface

The exploratory test borings were advanced using a hollow-stem auger drilling and sonic core drilling method with an 8-inch-diameter auger and a truck-mounted CME-850, as well as an 8-inch-diameter barrel and a track-mounted Geoprobe 8150 drill rig. The test pits were excavated using a Deere 50G compact excavator. The borings and test pits were located as close to the proposed project alignment as possible considering equipment accessibility, utility easements, encroachment, and property access. Locations were measured from existing site features during the field investigation and have not been surveyed. The locations and elevations are approximate.

In situ testing and soil sampling were performed in the soil borings using standard penetration test split-spoon samplers at 5-foot intervals. The standard penetration test was performed in accordance with ASTM International (ASTM) D1586, *Standard Test Method for Standard Penetration Test (SPT) and Split-Barrel Sampling of Soils* (ASTM 2022). The blow counts recorded on the logs and graphical profiles in this report

are the actual blows per foot recorded during drilling and are not corrected for overburden or hammer energy.

The split-spoon samplers provide a disturbed sample of the soil and an empirical indication (N-value) of the soil density or consistency. The Jacobs field representative provided continuous field observations and logging of the soils encountered. Visual classification of collected soil samples was completed in accordance with ASTM D2488, *Standard Practice for Description and Identification of Soils (Visual-Manual Procedure)* (ASTM 2018a). Sample descriptions, results of field tests, and observations made during drilling were recorded on the soil boring and test pit logs. Where laboratory tests were available, the soil classification was re-evaluated and updated if necessary.

5. Soil Laboratory Testing

FEI Testing & Inspection, Inc of Corvallis, Oregon, performed a series of laboratory tests on representative soil samples recovered from the soil borings and the test pit. The visual field classifications were modified, as necessary, based on laboratory test results. The following laboratory tests were conducted:

- Natural moisture content in accordance with ASTM D-2216, *Standard Test Methods for Laboratory Determination of Water (Moisture) Content of Soil and Rock by Mass* (ASTM 2019)
- Percent finer than No. 200 sieve in accordance with ASTM D-1140, *Standard Test Methods for Determining the Amount of Material Finer than 75- μ m (No. 200) Sieve in Soils by Washing* (ASTM 2017a)
- Particle-size analysis in accordance with ASTM D-6913, *Standard Test Methods for Particle-Size Distribution (Gradation) of Soils Using Sieve Analysis* (ASTM 2017b)
- Liquid limit, plasticity limit, and plasticity index of soils – Atterberg limits in accordance with ASTM D-4318, *Standard Test Methods for Liquid Limit, Plastic Limit, and Plasticity Index of Soils* (ASTM 2018b)

Table 2 summarizes the laboratory test results, which also are presented on the field boring logs in Appendix A next to the corresponding sample. Appendix B provides the laboratory test results.

Geotechnical Data Report

Table 2. Summary of the Laboratory Results

Boring No.	Sample	Depth (feet bgs)	USCS Soil Type	Moisture Content (%)	Sieve			Atterberg Limits	
					Gravel (%)	Sand (%)	Fines (%)	Liquid Limit	Plasticity Limit
B-1-23	1-SS	2.5	CL	31.3	-	-	73.2	-	-
B-1-23	2-SS	5	CL	28.9	-	-	-	43	21
B-2-23	1-SS	2.5	CL	30.6	-	-	-	42	24
B-2-23	2-SS	5	CL	33.2	-	-	87.9	-	-
B-3-23	3-SS	10	ML	23	-	-	65	-	-
B-3-23	4-SS	15	MH	51.8	-	-	-	75	41
B-4-23	2-SS	5	ML	35.1	-	-	-	42	27
B-4-23	3-SS	10	ML	31	-	-	74.5	-	-
B-5-23	2-SS	5	CL	30.5	-	-	56.2	-	-
B-5-23	3-SS	7.5	CL	35.5	-	-	-	34	21
B-5-23	4-SS	10	CL	34.1	-	-	72.7	-	-
B-5-23	5-SS	12.5	CL	34.2	-	-	-	33	22
B-5-23	8-SS	20	CL	31.6	0	20	80	-	-
B-5-23	10-SS	30	SM	27	0	61	39	-	-
B-5-23	13-SS	45	SM	21.7	0	76	24	-	-
B-5-23	15-SS	60	SM	21.5	-	-	22	-	-
B-6-23	1-SS	2.5	CL	34.1	-	-	-	39	25
B-6-23	2-SS	5	CL	26.6	-	-	57.7	-	-
B-6-23	3-SS	7.5	CL	33.7	-	-	-	34	21
B-6-23	6-SS	15	CH	34.7	-	-	-	53	23
B-6-23	9-SS	25	SP-SM	13.2	41	48	11	-	-
B-6-23	11-SS	35	SP-SM	27.8	0	84	16	-	-
B-6-23	13-SS	45	SM	25.1	0	71	29	-	-
B-6-23	15-SS	60	SM	21.4	0	71	29	-	-

Abbreviations:

-- = not applicable

bgs = below ground surface

CH = fat clay

CL = lean clay

MH = elastic silt

ML = sandy silt or silt with sand

SM = silty sand

SP-SM = poorly graded sand with silt

USCS = Unified Soil Classification System

6. General Soil Profiles

The pipeline will generally be installed using conventional open-cut excavation methods with a pipe cover depth of approximately 3 to 5 feet bgs. Trenchless crossings are proposed to be installed using auger boring methods at depths of 10 to 20 feet bgs. The soil profile at the trenchless crossing is described in

Section 6.1, and is based on two borings drilled at the railroad crossing—one on the west side and one on the east side of the existing features. Detailed descriptions of soil materials encountered in the explorations are presented on the soil boring and test pit logs in Appendix A.

6.1 Railroad Crossing

The upper 22 to 25 feet bgs at the railroad crossing was Willamette silt, which generally consisted of lean clay, with a bottom layer of sandy clay with gravel sandy lean clay. The clay soil materials had a plasticity index of 11 to 14, indicating medium plasticity. The clay soils were firm to stiff, with uncorrected N-values varying from 4 to 12.

The upper clayey clay soils were underlain by Leffler gravels. Leffler gravels generally consist of poorly graded sand, silt sand, and sand with silt with varying amount of gravels present. The Leffler gravels were dense to very dense, with uncorrected N-values varying from 32 to greater than 50. Railroad crossing borings (B-5-23 and B-6-23) extended to 61.5 feet bgs and terminated in this unit.

6.2 Fire Station to Power Station Alignment

The upper 20 feet bgs along the roadway alignment also was Willamette silt, which consisted of silt, lean clay and elastic silt with trace sand. The Willamette silt soils along the alignment had a plastic index of 15 to 41, indicating medium to high plasticity and uncorrected N-values varying from 7 to 27 indicating firm to very stiff conditions. The borings and test pits along the alignment terminated in this unit.

7. Groundwater

Groundwater was not observed in borings or test pits during the January 2023 exploration program.

8. Limitations

This report has been prepared for the exclusive use of the City for specific application to the Millersburg Transition Parkway Project in accordance with generally accepted geotechnical engineering practice. No other warranty, express or implied, is made.

The data contained in this report were collected during the geotechnical subsurface investigations for the proposed roadway and pipeline. Soil borings indicate subsurface conditions only at specific locations and times, and only to the depths penetrated. They do not necessarily reflect strata variations that may exist between such locations.

Jacobs is not responsible for claims, damages, or liability associated with the subsurface data or reuse of the subsurface data without the express written authorization of Jacobs.

9. References

ASTM International (ASTM). 2017a. *Standard Test Methods for Amount of Material in Soils Finer Than the No. 200 (75- μ m) Sieve*. ASTM D-1140. February 28. <https://www.astm.org/d1140-17.html>.

ASTM. 2017b. *Standard Test Methods for Particle-Size Distribution (Gradation) of Soils Using Sieve Analysis*. ASTM D-6913. February 15. https://www.astm.org/d6913_d6913m-17.html.

ASTM. 2018a. *Standard Practice for Description and Identification of Soils (Visual-Manual Procedure)*. ASTM D2488. April 4. <https://www.astm.org/d2488-17e01.html>.

ASTM. 2018b. *Standard Test Methods for Liquid Limit, Plastic Limit, and Plasticity Index of Soils*. ASTM D-4318. April 17. <https://www.astm.org/d4318-17e01.html>

Geotechnical Data Report


ASTM. 2019. *Standard Test Methods for Laboratory Determination of Water (Moisture) Content of Soil and Rock by Mass*. ASTM D-2216. March 19. <https://www.astm.org/d2216-19.html>.

ASTM. 2022. *Standard Test Method for Standard Penetration Test (SPT) and Split-Barrel Sampling of Soils*. ASTM D1586. May 3. https://www.astm.org/d1586_d1586m-18e01.html

National Resources Conservation Service (NRCS). n.d. Web Soil Survey Interactive Map. <https://websoilsurvey.sc.egov.usda.gov/App/WebSoilSurvey.aspx>.

Wiley, Thomas J. 2006. *Preliminary Geologic Map of the Albany Quadrangle, Linn, Marion, and Benton Counties, Oregon*. 1Open-File Report O-06-26. State of Oregon Department of Geology and Mineral Industries.

Figures

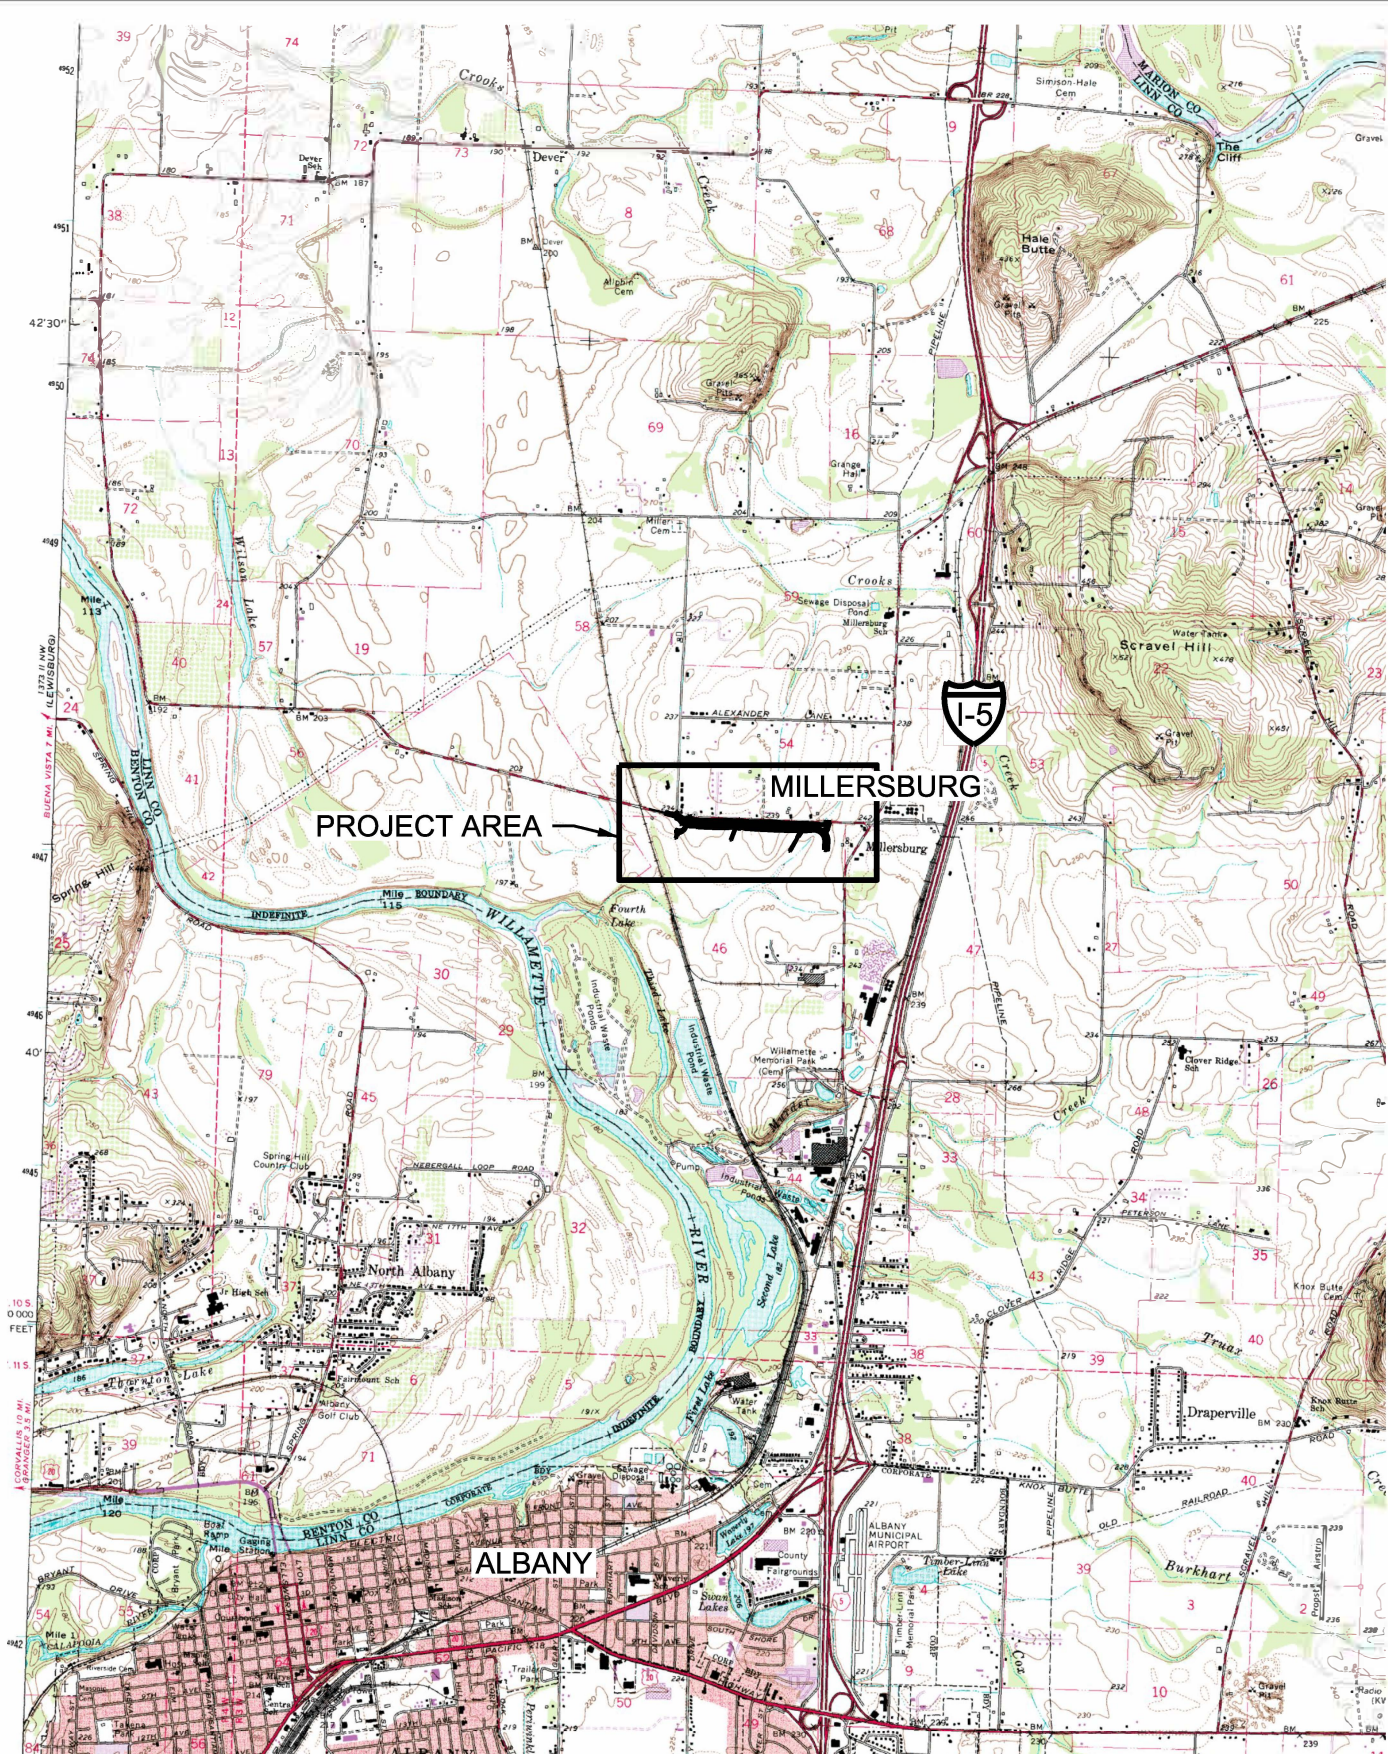

PROJECT AREA

MILLERSBURG


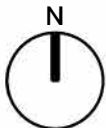


FIGURE 1
PROJECT VICINITY

TRANSITION PARKWAY AND LINEAR
PARK MILLERSBURG, OREGON

D3395316



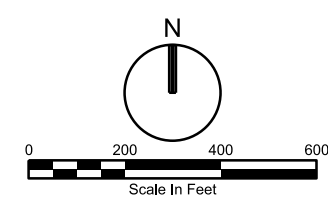

EXPLORATION LEGEND

- ⊕ B-1-23 BORING
- ⊞ TP-1-23 TESTPIT

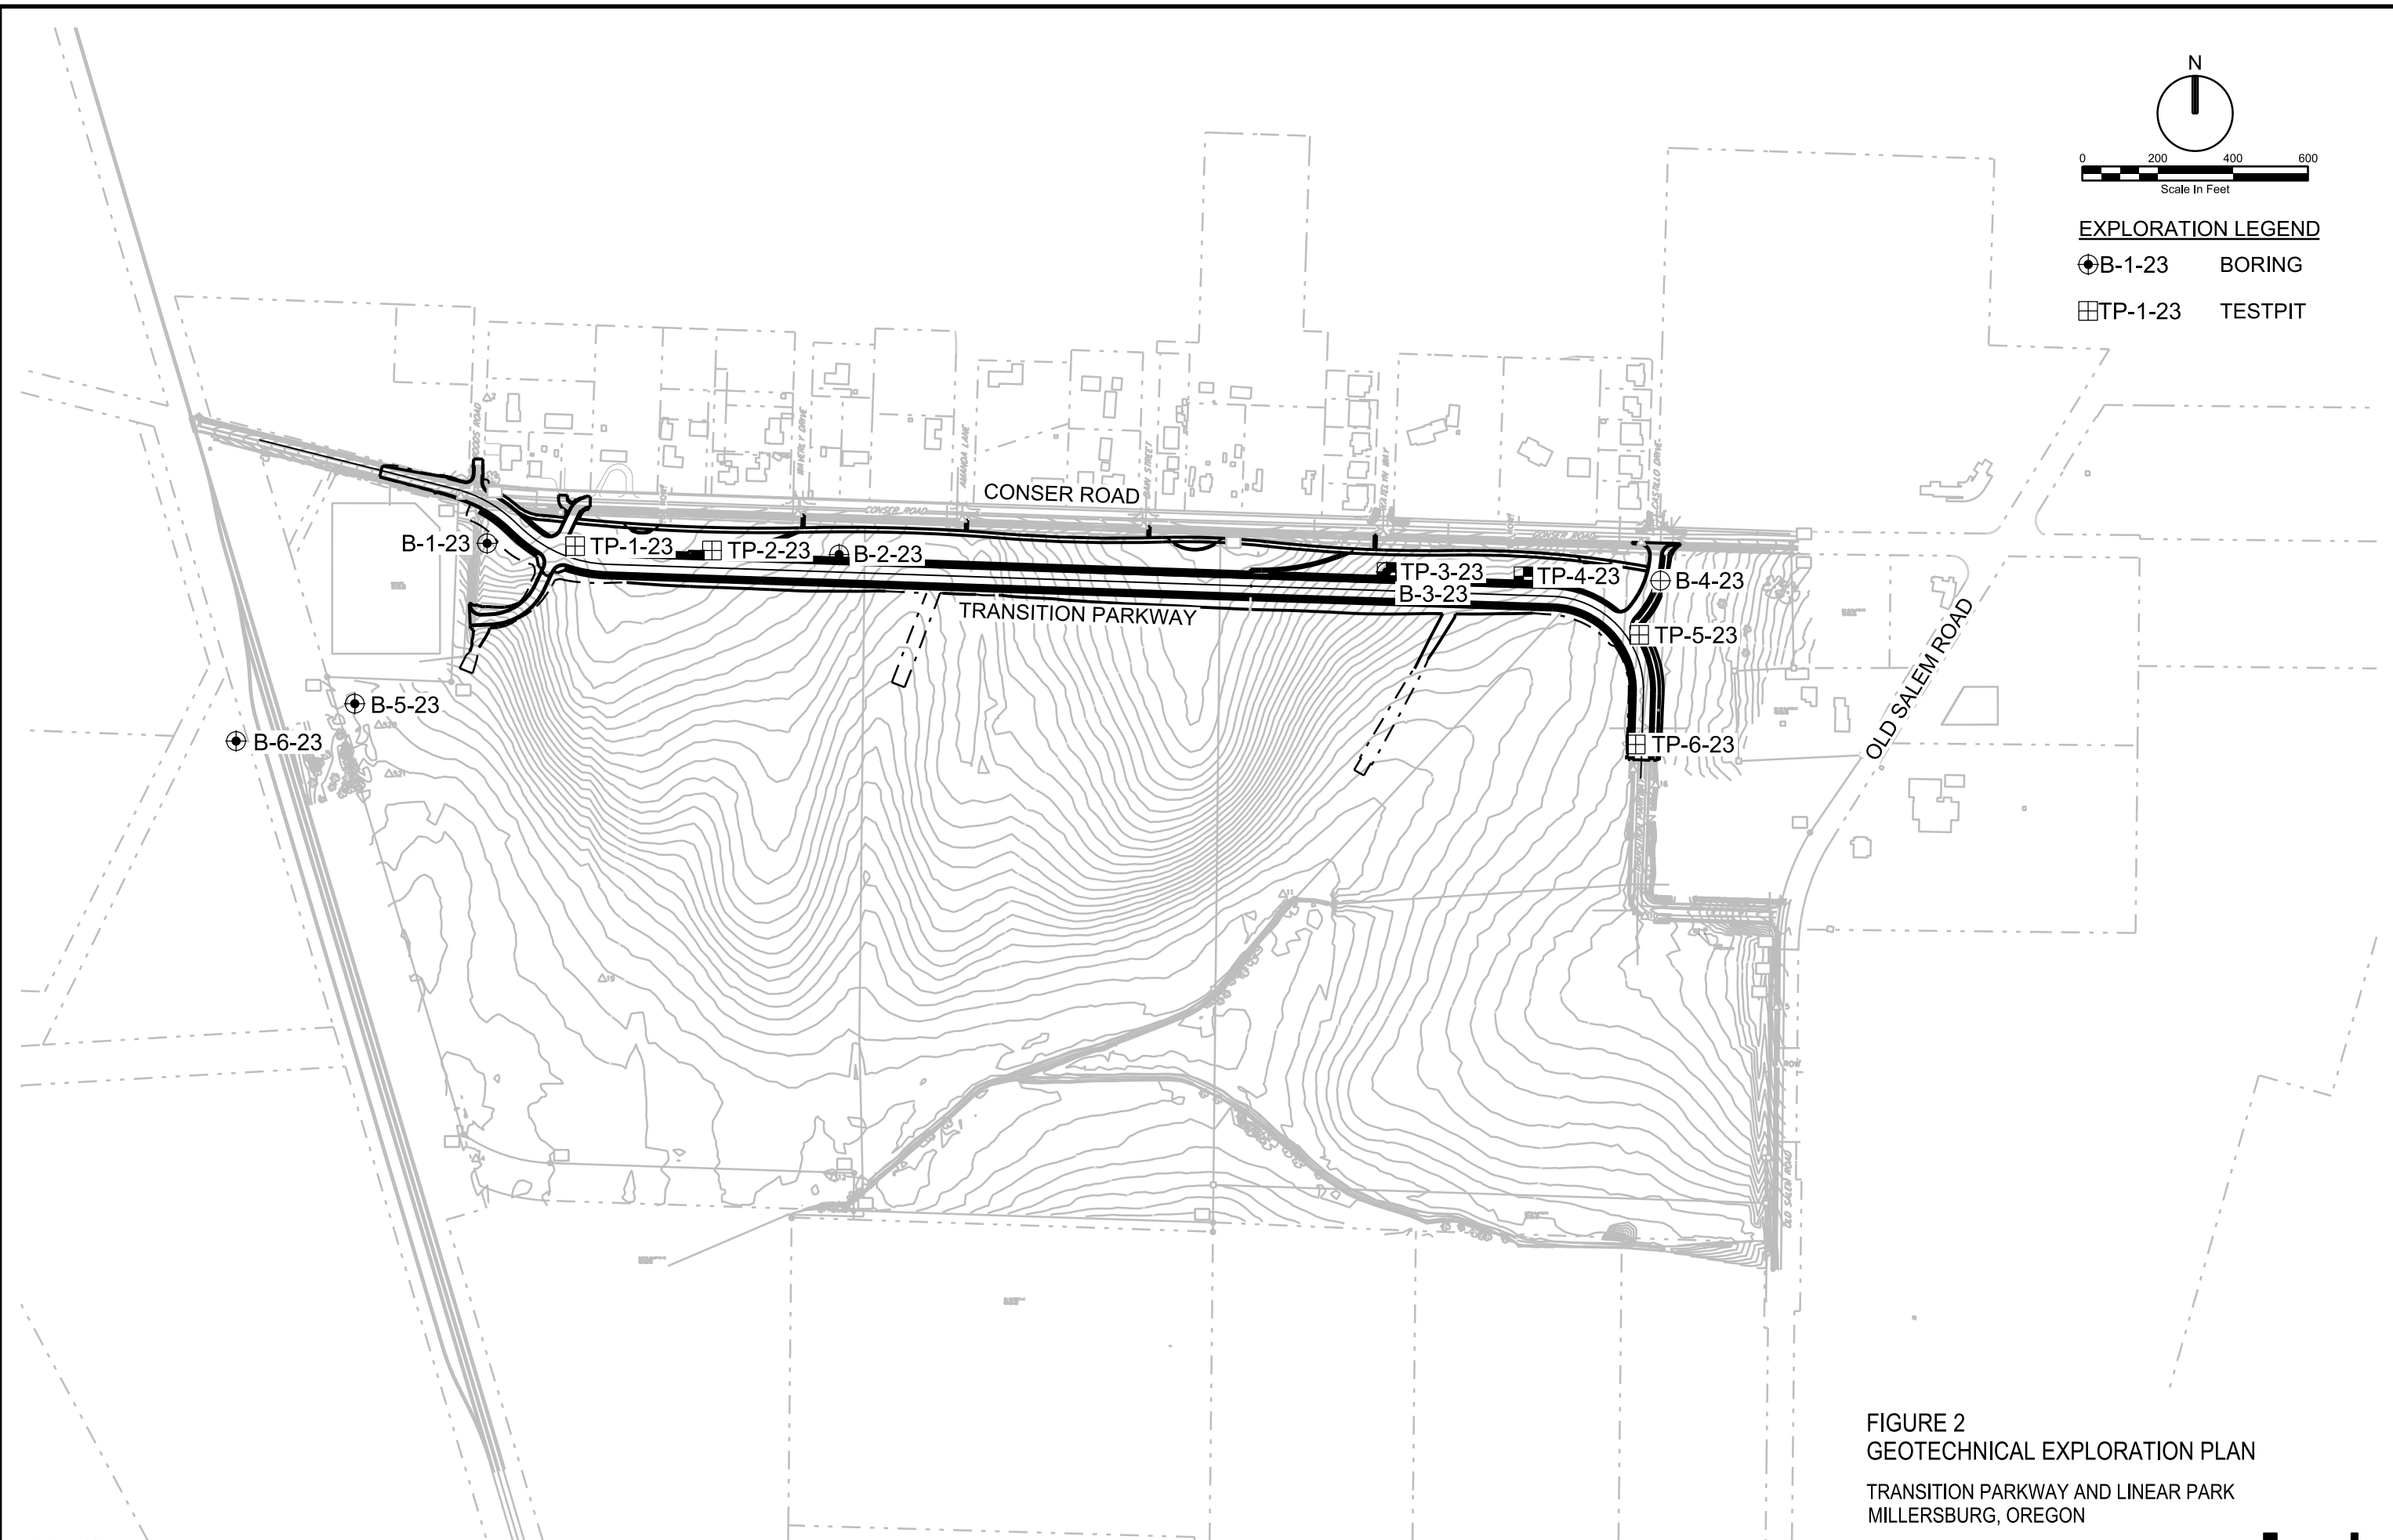


FIGURE 2
GEOTECHNICAL EXPLORATION PLAN
 TRANSITION PARKWAY AND LINEAR PARK
 MILLERSBURG, OREGON

D3395316



Appendix A

Ground Exploration Logs



PROJECT NUMBER: D3395316	BORING NUMBER: B-1-23	SHEET 1 OF 1
SOIL BORING LOG		

PROJECT : Millersburg Transition Parkway, Millersburg, OR LOCATION : (44.7 N, -123.1 E)
 ELEVATION : 234.0 ft DRILLING CONTRACTOR : Western States Soil Conservation
 DRILLING EQUIPMENT AND METHOD : CME-850, Track-Mounted Drill, Hollow Stem Auger ORIENTATION : Vertical
 WATER LEVELS : -- START : 1/5/23 10:45 END : 1/5/23 11:30 LOGGER : J.S. Nair

DEPTH BELOW EXISTING GRADE (ft)	INTERVAL (ft)	SAMPLE RECOVERY (ft)	#TYPE	STANDARD PENETRATION TEST RESULTS	SOIL DESCRIPTION	SYMBOLIC LOG	COMMENTS
				6"-6"-6" (N)	SOIL NAME, USCS GROUP SYMBOL, COLOR, MOISTURE CONTENT, RELATIVE DENSITY OR CONSISTENCY, SOIL STRUCTURE, MINERALOGY		DEPTH OF CASING, DRILLING RATE, DRILLING FLUID LOSS, TESTS, AND INSTRUMENTATION
234.0					TOPSOIL/DUFF		
	2.5						
	4.0	1.5	1-SS	3-4-4 (8)	LEAN CLAY (CL) brown, moist, firm, low to medium plasticity, trace fine sand		Lab Results: MC : 31.3% P200 : 73.2%
5	5.0						
229.0	6.5	1.2	2-SS	3-3-6 (9)	LEAN CLAY (CL) similar to above, except stiff		Lab Results: MC : 28.9% LL : 43 PI : 22
10	10.0						
224.0	11.5	1.2	3-SS	3-5-6 (11)	LEAN CLAY (CL) similar to above		
15	15.0						
219.0	16.5	1.4	4-SS	20-24-42 (66)	SANDY SILT (ML) brown, moist, hard, low to medium plasticity, fine to medium sand		
20	20.0						
214.0	21.5	1.5	5-SS	27-26-31 (57)	POORLY GRADED SAND (SP) brown gray, moist, very dense, fine to medium sand		
					Bottom of Boring at 21.5 ft bgs on 1/5/23 11:30		
25							
209.0							
30							



PROJECT NUMBER: D3395316	BORING NUMBER: B-2-23	SHEET 1 OF 1
SOIL BORING LOG		

PROJECT : Millersburg Transition Parkway, Millersburg, OR LOCATION : (44.7 N, -123.1 E)
 ELEVATION : 231.0 ft DRILLING CONTRACTOR : Western States Soil Conservation
 DRILLING EQUIPMENT AND METHOD : CME-850, Track-Mounted Drill, Hollow Stem Auger ORIENTATION : Vertical
 WATER LEVELS : -- START : 1/5/23 09:40 END : 1/5/23 10:30 LOGGER : J.S. Nair

DEPTH BELOW EXISTING GRADE (ft)	INTERVAL (ft)	SAMPLE RECOVERY (ft)	#TYPE	STANDARD PENETRATION TEST RESULTS	SOIL DESCRIPTION	SYMBOLIC LOG	COMMENTS
				6"-6"-6" (N)	SOIL NAME, USCS GROUP SYMBOL, COLOR, MOISTURE CONTENT, RELATIVE DENSITY OR CONSISTENCY, SOIL STRUCTURE, MINERALOGY		DEPTH OF CASING, DRILLING RATE, DRILLING FLUID LOSS, TESTS, AND INSTRUMENTATION
231.0					TOPSOIL/DUFF		
	2.5						
	4.0	1.5	1-SS	3-3-4 (7)	LEAN CLAY (CL) brown, moist, firm, low to medium plasticity, trace fine sand		Lab Results: MC : 30.6% LL : 42 PI : 18
5	5.0						
226.0	6.5	1.5	2-SS	1-3-4 (7)	LEAN CLAY (CL) similar to above		Lab Results: MC : 33.2% P200 : 87.9%
10	10.0						
221.0	11.5	1.5	3-SS	2-5-6 (11)	LEAN CLAY (CL) similar to above, except stiff, ferrous staining		
15	15.0						
216.0	16.5	1.4	4-SS	7-12-15 (27)	SANDY SILT (ML) brown, moist, very stiff, low to medium plasticity, fine to medium sand, ferrous staining		
20	20.0						
211.0	21.5	1.5	5-SS	16-20-36 (56)	SANDY SILT with GRAVEL (ML) brown, moist, hard, low to medium plasticity, fine to medium sand, fine gravel, ferrous staining Bottom of Boring at 21.5 ft bgs on 1/5/23 10:30		
25							
206.0							
30							



PROJECT NUMBER: D3395316	BORING NUMBER: B-3-23	SHEET 1 OF 1
SOIL BORING LOG		

PROJECT : Millersburg Transition Parkway, Millersburg, OR LOCATION : (44.7 N, -123.1 E)
 ELEVATION : 241.0 ft DRILLING CONTRACTOR : Western States Soil Conservation
 DRILLING EQUIPMENT AND METHOD : CME-850, Track-Mounted Drill, Hollow Stem Auger ORIENTATION : Vertical
 WATER LEVELS : -- START : 1/5/23 08:30 END : 1/5/23 09:30 LOGGER : J.S. Nair

DEPTH BELOW EXISTING GRADE (ft)	INTERVAL (ft)	SAMPLE RECOVERY (ft)	#TYPE	STANDARD PENETRATION TEST RESULTS	SOIL DESCRIPTION	SYMBOLIC LOG	COMMENTS
				6"-6"-6" (N)	SOIL NAME, USCS GROUP SYMBOL, COLOR, MOISTURE CONTENT, RELATIVE DENSITY OR CONSISTENCY, SOIL STRUCTURE, MINERALOGY		DEPTH OF CASING, DRILLING RATE, DRILLING FLUID LOSS, TESTS, AND INSTRUMENTATION
241.0					TOPSOIL/DUFF	1 1/2	
	2.5						
	4.0	0.4	1-SS	2-2-3 (5)	SILT (ML) brown, moist, firm, low to medium plasticity, trace fine sand		
5	5.0						
236.0	6.5	1.5	2-SS	3-4-5 (9)	SILT (ML) similar to above, except stiff		
10	10.0						
231.0	11.5	1.5	3-SS	5-7-10 (17)	SILT (ML) similar to above, except very stiff		Lab Results: MC : 23.0% P200 : 65.0%
15	15.0						
226.0	16.5	1.4	4-SS	3-5-7 (12)	ELASTIC SILT (MH) brown, moist, stiff, medium to high plasticity, trace fine sand		Lab Results: MC : 51.8% LL : 75 PI : 41
20	20.0						
221.0	21.5	1.5	5-SS	4-7-10 (17)	ELASTIC SILT (MH) similar to above, except very stiff		
					Bottom of Boring at 21.5 ft bgs on 1/5/23 09:30		
25							
216.0							
30							



PROJECT NUMBER: D3395316	BORING NUMBER: B-4-23	SHEET 1 OF 1
SOIL BORING LOG		

PROJECT : Millersburg Transition Parkway, Millersburg, OR LOCATION : (44.7 N, -123.1 E)
 ELEVATION : 225.0 ft DRILLING CONTRACTOR : Western States Soil Conservation
 DRILLING EQUIPMENT AND METHOD : Geoprobe 8150, Track-Mounted Drill, Sonic ORIENTATION : Vertical
 WATER LEVELS : -- START : 1/4/23 08:30 END : 1/4/23 11:00 LOGGER : J.S. Nair

DEPTH BELOW EXISTING GRADE (ft)	INTERVAL (ft)	SAMPLE RECOVERY (ft)	#TYPE	STANDARD PENETRATION TEST RESULTS	SOIL DESCRIPTION	SYMBOLIC LOG	COMMENTS
				6"-6"-6" (N)	SOIL NAME, USCS GROUP SYMBOL, COLOR, MOISTURE CONTENT, RELATIVE DENSITY OR CONSISTENCY, SOIL STRUCTURE, MINERALOGY		DEPTH OF CASING, DRILLING RATE, DRILLING FLUID LOSS, TESTS, AND INSTRUMENTATION
225.0					TOPSOIL/DUFF	1 1/2	
	2.5						
	4.0	1.4	1-SS	3-3-3 (6)	SILT (ML) brown, moist, firm, low to medium plasticity, trace fine sand		
5	5.0						
220.0	6.5	1.3	2-SS	4-4-5 (9)	SILT (ML) similar to above, except stiff		Lab Results: MC : 35.1% LL : 42 PI : 15
10	10.0						
215.0	11.5	1.5	3-SS	6-7-9 (16)	SILT (ML) similar to above, except very stiff		Lab Results: MC : 31.0% P200 : 74.5%
15	15.0						
210.0	16.5	1.4	4-SS	4-4-8 (12)	SILT (ML) similar to above, except stiff		
20	20.0						
205.0	21.5	1.5	5-SS	5-7-9 (16)	SILT (ML) similar to above, except very stiff		
					Bottom of Boring at 21.5 ft bgs on 1/4/23 11:00		
25							
200.0							
30							



PROJECT NUMBER: D3395316	BORING NUMBER: B-5-23	SHEET 1 OF 3
SOIL BORING LOG		

PROJECT : Millersburg Transition Parkway, Millersburg, OR LOCATION : (44.7 N, -123.1 E)
 ELEVATION : 212.0 ft DRILLING CONTRACTOR : Western States Soil Conservation
 DRILLING EQUIPMENT AND METHOD : Geoprobe 8150, Track-Mounted Drill, Sonic ORIENTATION : Vertical
 WATER LEVELS : -- START : 1/4/23 12:00 END : 1/4/23 16:30 LOGGER : J.S. Nair

DEPTH BELOW EXISTING GRADE (ft)	INTERVAL (ft)	SAMPLE RECOVERY (ft)	#TYPE	STANDARD PENETRATION TEST RESULTS	SOIL DESCRIPTION	SYMBOLIC LOG	COMMENTS
				6"-6"-6" (N)	SOIL NAME, USCS GROUP SYMBOL, COLOR, MOISTURE CONTENT, RELATIVE DENSITY OR CONSISTENCY, SOIL STRUCTURE, MINERALOGY		DEPTH OF CASING, DRILLING RATE, DRILLING FLUID LOSS, TESTS, AND INSTRUMENTATION
212.0					TOPSOIL/DUFF		
	2.5						
	4.0	1.5	1-SS	2-5-7 (12)	LEAN CLAY (CL) brown, moist, stiff, low to medium plasticity, trace fine sand		
5	5.0						
207.0	6.5	1.5	2-SS	3-3-4 (7)	LEAN CLAY (CL) similar to above, except firm		Lab Results: MC : 30.5% P200 : 56.2%
	7.5						
	9.0	1.5	3-SS	5-2-3 (5)	LEAN CLAY (CL) similar to above		Lab Results: MC : 35.5% LL : 34 PI : 13
10	10.0						
202.0	11.5	1.5	4-SS	2-2-5 (7)	LEAN CLAY (CL) similar to above		Lab Results: MC : 34.1% P200 : 72.7%
	12.5						
	14.0	1.5	5-SS	3-4-3 (7)	LEAN CLAY (CL) similar to above		Lab Results: MC : 34.2% LL : 33 PI : 11
15	15.0						
197.0	16.5	0.0	6-SS	3-3-3 (6)	No Recovery		
	17.5						
	19.5		7-ST		LEAN CLAY (CL) gray, moist, medium plasticity, trace fine sand		
20	20.0						
192.0	21.5	1.5	8-SS	18-22-20 (42)	LEAN CLAY WITH SAND (CL) gray, moist, hard, low to medium plasticity, fine to medium sand		Lab Results: MC : 31.6% GRAVEL : 0% SAND : 20% FINES : 80%
	25.0						
25	26.5	1.5	9-SS	16-27-31 (58)	POORLY GRADED SAND (SP) gray, moist, very dense, fine to medium sand		
187.0							
30							



PROJECT NUMBER: D3395316	BORING NUMBER: B-5-23	SHEET 2 OF 3
SOIL BORING LOG		

PROJECT : Millersburg Transition Parkway, Millersburg, OR LOCATION : (44.7 N, -123.1 E)
 ELEVATION : 212.0 ft DRILLING CONTRACTOR : Western States Soil Conservation
 DRILLING EQUIPMENT AND METHOD : Geoprobe 8150, Track-Mounted Drill, Sonic ORIENTATION : Vertical
 WATER LEVELS : -- START : 1/4/23 12:00 END : 1/4/23 16:30 LOGGER : J.S. Nair

DEPTH BELOW EXISTING GRADE (ft)	INTERVAL (ft)	SAMPLE RECOVERY (ft)	#TYPE	STANDARD PENETRATION TEST RESULTS	SOIL DESCRIPTION	SYMBOLIC LOG	COMMENTS
				6"-6"-6" (N)	SOIL NAME, USCS GROUP SYMBOL, COLOR, MOISTURE CONTENT, RELATIVE DENSITY OR CONSISTENCY, SOIL STRUCTURE, MINERALOGY		DEPTH OF CASING, DRILLING RATE, DRILLING FLUID LOSS, TESTS, AND INSTRUMENTATION
182.0	30.0	1.5	10-SS	10-15-24 (39)	SILTY SAND (SM) gray, moist, dense, fine to medium sand		Lab Results: MC : 27.0% GRAVEL : 0% SAND : 61% FINES : 39%
	31.5						
35	35.0						
177.0	36.5	1.3	11-SS	16-41-44 (85)	POORLY GRADED SAND with GRAVEL (SP) gray, moist, very dense, fine to medium sand		
40	40.0						
172.0	41.5	1.3	12-SS	16-14-22 (36)	POORLY GRADED SAND with GRAVEL (SP) similar to above, except dense		
45	45.0						
167.0	46.5	1.3	13-SS	44-36-49 (85)	SILTY SAND (SM) gray, moist, very dense, fine to medium sand		Lab Results: MC : 21.7% GRAVEL : 0% SAND : 76% FINES : 24%
50	50.0						
162.0	51.5	1.2	14-SS	13-23-31 (54)	POORLY GRADED SAND with GRAVEL (SP) gray, moist, very dense, fine to medium sand		
55							
157.0							
60							



PROJECT NUMBER: D3395316	BORING NUMBER: B-5-23
SHEET 3 OF 3	
SOIL BORING LOG	

PROJECT : Millersburg Transition Parkway, Millersburg, OR LOCATION : (44.7 N, -123.1 E)
 ELEVATION : 212.0 ft DRILLING CONTRACTOR : Western States Soil Conservation
 DRILLING EQUIPMENT AND METHOD : Geoprobe 8150, Track-Mounted Drill, Sonic ORIENTATION : Vertical

WATER LEVELS : -- START : 1/4/23 12:00 END : 1/4/23 16:30 LOGGER : J.S. Nair

DEPTH BELOW EXISTING GRADE (ft)	INTERVAL (ft)	SAMPLE RECOVERY (ft)	#TYPE	STANDARD PENETRATION TEST RESULTS	SOIL DESCRIPTION	SYMBOLIC LOG	COMMENTS
				6"-6"-6" (N)	SOIL NAME, USCS GROUP SYMBOL, COLOR, MOISTURE CONTENT, RELATIVE DENSITY OR CONSISTENCY, SOIL STRUCTURE, MINERALOGY		DEPTH OF CASING, DRILLING RATE, DRILLING FLUID LOSS, TESTS, AND INSTRUMENTATION
152.0	60.0	1.3	15-SS	18-31-49 (80)	SILTY SAND (SM) gray, moist, very dense, fine to medium sand		Lab Results: MC : 21.5% P200 : 22.0%
	61.5				Bottom of Boring at 61.5 ft bgs on 1/4/23 16:30		
65							
147.0							
70							
142.0							
75							
137.0							
80							
132.0							
85							
127.0							
90							



PROJECT NUMBER: D3395316	BORING NUMBER: B-6-23	SHEET 1 OF 3
SOIL BORING LOG		

PROJECT : Millersburg Transition Parkway, Millersburg, OR LOCATION : (44.7 N, -123.1 E)
 ELEVATION : 211.0 ft DRILLING CONTRACTOR : Western States Soil Conservation
 DRILLING EQUIPMENT AND METHOD : Geoprobe 8150, Track-Mounted Drill, Sonic ORIENTATION : Vertical
 WATER LEVELS : -- START : 1/5/23 12:00 END : 1/5/23 15:00 LOGGER : J.S. Nair

DEPTH BELOW EXISTING GRADE (ft)	INTERVAL (ft)	SAMPLE RECOVERY (ft)	#TYPE	STANDARD PENETRATION TEST RESULTS	SOIL DESCRIPTION	SYMBOLIC LOG	COMMENTS
				6"-6"-6" (N)	SOIL NAME, USCS GROUP SYMBOL, COLOR, MOISTURE CONTENT, RELATIVE DENSITY OR CONSISTENCY, SOIL STRUCTURE, MINERALOGY		DEPTH OF CASING, DRILLING RATE, DRILLING FLUID LOSS, TESTS, AND INSTRUMENTATION
211.0					TOPSOIL/DUFF		
	2.5						
	4.0	1.5	1-SS	2-4-3 (7)	LEAN CLAY (CL) brown, moist, firm, low to medium plasticity, trace fine sand		Lab Results: MC : 34.1% LL : 39 PI : 14
5	5.0						
206.0	6.5	1.5	2-SS	3-4-6 (10)	LEAN CLAY (CL) similar to above, except stiff		Lab Results: MC : 26.6% P200 : 57.6%
	7.5						
	9.0	1.5	3-SS	0-2-2 (4)	LEAN CLAY (CL) similar to above, except firm		Lab Results: MC : 33.7% LL : 34 PI : 13
10	10.0						
201.0	12.0		4-ST				
	12.5						
	14.0	1.5	5-SS	3-3-4 (7)	LEAN CLAY (CL) similar to above, except stiff		
15	15.0						
196.0	16.5	1.5	6-SS	3-4-5 (9)	LEAN CLAY (CL) gray, moist, firm, medium plasticity, trace fine sand		Lab Results: MC : 34.7% LL : 53 PI : 30
	17.5						
	19.0	0.0	7-SS	2-3-3 (6)	No Recovery		
20	20.0						
191.0	21.5	1.0	8-SS	2-14-27 (41)	SANDY CLAY with GRAVEL (CL) gray, moist, firm, medium plasticity, fine to medium sand, fine gravel		
25	25.0						
186.0	26.5	1.0	9-SS	27-31-29 (60)	POORLY GRADED SAND with SILT and GRAVEL (SP-SM) gray, moist, very dense, fine to medium sand, fine gravel, low to medium plasticity		Lab Results: MC : 13.2% GRAVEL : 41% SAND : 48% FINES : 11%
30							



PROJECT NUMBER: D3395316	BORING NUMBER: B-6-23	SHEET 2 OF 3
SOIL BORING LOG		

PROJECT : Millersburg Transition Parkway, Millersburg, OR LOCATION : (44.7 N, -123.1 E)

ELEVATION : 211.0 ft DRILLING CONTRACTOR : Western States Soil Conservation

DRILLING EQUIPMENT AND METHOD : Geoprobe 8150, Track-Mounted Drill, Sonic ORIENTATION : Vertical

WATER LEVELS : -- START : 1/5/23 12:00 END : 1/5/23 15:00 LOGGER : J.S. Nair

DEPTH BELOW EXISTING GRADE (ft)	INTERVAL (ft)	SAMPLE RECOVERY (ft)	#TYPE	STANDARD PENETRATION TEST RESULTS	SOIL DESCRIPTION	SYMBOLIC LOG	COMMENTS
				6"-6"-6" (N)	SOIL NAME, USCS GROUP SYMBOL, COLOR, MOISTURE CONTENT, RELATIVE DENSITY OR CONSISTENCY, SOIL STRUCTURE, MINERALOGY		DEPTH OF CASING, DRILLING RATE, DRILLING FLUID LOSS, TESTS, AND INSTRUMENTATION
181.0	30.0	1.2	10-SS	17-34-28 (62)	POORLY GRADED SAND with GRAVEL (SP) similar to above		
	31.5						
35	35.0	1.5	11-SS	10-18-50/5 (68/11")	SILTY SAND (SM) gray, moist, very dense, fine to medium sand, low to medium plasticity		Lab Results: MC : 27.8% GRAVEL : 0% SAND : 84% FINES : 16%
176.0	36.5						
40	40.0	1.2	12-SS	23-10-23 (33)	POORLY GRADED SAND with GRAVEL (SP) gray, moist, dense, fine to medium sand, fine gravel, low to medium plasticity		
171.0	41.5						
45	45.0	0.4	13-SS	50/5 (50/5")	SILTY SAND (SM) gray, moist, very dense, fine to medium sand, low to medium plasticity		Lab Results: MC : 25.1% GRAVEL : 0% SAND : 71% FINES : 29%
166.0	46.5						
50	50.0	0.3	14-SS	50/3 (50/3")	POORLY GRADED SAND with GRAVEL (SP) gray, moist, very dense, fine to medium sand, fine gravel, low to medium plasticity		
161.0	51.5						
55							
156.0							
60							



PROJECT NUMBER: D3395316	BORING NUMBER: B-6-23
SHEET 3 OF 3	
SOIL BORING LOG	



PROJECT : Millersburg Transition Parkway, Millersburg, OR LOCATION : (44.7 N, -123.1 E)
 ELEVATION : 211.0 ft DRILLING CONTRACTOR : Western States Soil Conservation
 DRILLING EQUIPMENT AND METHOD : Geoprobe 8150, Track-Mounted Drill, Sonic ORIENTATION : Vertical
 WATER LEVELS : -- START : 1/5/23 12:00 END : 1/5/23 15:00 LOGGER : J.S. Nair

DEPTH BELOW EXISTING GRADE (ft)	INTERVAL (ft)	SAMPLE RECOVERY (ft)	#TYPE	STANDARD PENETRATION TEST RESULTS	SOIL DESCRIPTION	SYMBOLIC LOG	COMMENTS
				6"-6"-6" (N)	SOIL NAME, USCS GROUP SYMBOL, COLOR, MOISTURE CONTENT, RELATIVE DENSITY OR CONSISTENCY, SOIL STRUCTURE, MINERALOGY		DEPTH OF CASING, DRILLING RATE, DRILLING FLUID LOSS, TESTS, AND INSTRUMENTATION
151.0	60.0 61.5	0.2	15-SS	50/2 (50/2")	SILTY SAND (SM) gray, moist, very dense, fine to medium sand, low to medium plasticity Bottom of Boring at 61.5 ft bgs on 1/5/23 15:00		<u>Lab Results:</u> MC : 21.4% GRAVEL : 0% SAND : 71% FINES : 29%
65 146.0							
70 141.0							
75 136.0							
80 131.0							
85 126.0							
90							



PROJECT NUMBER: D3395316	TEST PIT NUMBER: TP-1-23	SHEET 1 OF 1
TEST PIT LOG		



PROJECT: Millersburg Transition Parkway, Millersburg, OR LOCATION: Millersburg, OR [Lat/Long: 44.6808, -123.0753]
 ELEVATION: 233.0 ft CONTRACTOR: Western States Soil Conservation
 EXCAVATION EQUIPMENT: DEERE 50G DATE EXCAVATED: 1/6/2023
 WATER LEVELS: None APPROX. DIMENSIONS: LOGGER: J.S. Nair

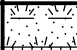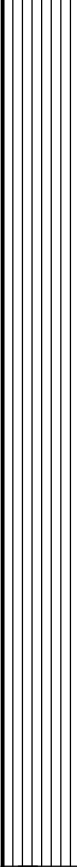DEPTH BELOW SURFACE (FT)	SAMPLE		SOIL DESCRIPTION	GRAPHIC LOG	COMMENT
	INTERVAL (ft)	#TYPE			
			TOPSOIL/DUFF		11:00 started excavation
			SILT (ML) brown, moist, low to medium plasticity, trace fine sand		
4.0	4.0	1-GRAB			
5					
10			Bottom of Boring at 10.0 ft bgs on		11:30 finished excavation
15					



PROJECT NUMBER: D3395316	TEST PIT NUMBER: TP-2-23	SHEET 1 OF 1
TEST PIT LOG		




PROJECT: Millersburg Transition Parkway, Millersburg, OR LOCATION: Millersburg, OR [Lat/Long: 44.6808, -123.0739]
 ELEVATION: 235.0 ft CONTRACTOR: Western States Soil Conservation
 EXCAVATION EQUIPMENT: DEERE 50G DATE EXCAVATED: 1/6/2023
 WATER LEVELS: None APPROX. DIMENSIONS: LOGGER: J.S. Nair

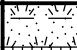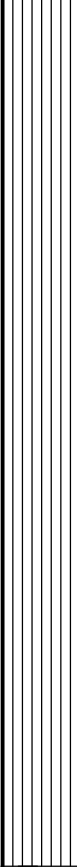DEPTH BELOW SURFACE (FT)	SAMPLE		SOIL DESCRIPTION	GRAPHIC LOG	COMMENT
	INTERVAL (ft)	#TYPE			
			TOPSOIL/DUFF		10:30 started excavation
			SILT (ML) brown, moist, low to medium plasticity, trace fine sand		
4.0	4.0	1-GRAB			
5					
10			Bottom of Boring at 10.0 ft bgs on		11:00 finished excavation
15					



PROJECT NUMBER: D3395316	TEST PIT NUMBER: TP-3-23	SHEET 1 OF 1
TEST PIT LOG		



PROJECT: Millersburg Transition Parkway, Millersburg, OR LOCATION: Millersburg, OR [Lat/Long: 44.6808, -123.0670]
 ELEVATION: 229.0 ft CONTRACTOR: Western States Soil Conservation
 EXCAVATION EQUIPMENT: DEERE 50G DATE EXCAVATED: 1/6/2023
 WATER LEVELS: None APPROX. DIMENSIONS: LOGGER: J.S. Nair

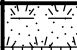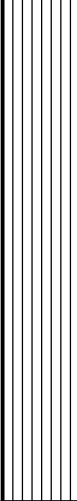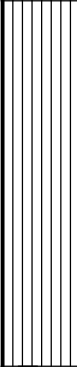DEPTH BELOW SURFACE (FT)	SAMPLE		SOIL DESCRIPTION	GRAPHIC LOG	COMMENT
	INTERVAL (ft)	#TYPE			
			TOPSOIL/DUFF		10:00 started excavation
			SILT (ML) brown, moist, low to medium plasticity, trace fine sand		
4.0	1-GRAB		SILT with GRAVEL (ML) brown, moist, low to medium plasticity, fine to coarse gravel, trace fine sand		
10			Bottom of Boring at 10.0 ft bgs on		10:30 finished excavation
15					



PROJECT NUMBER: D3395316	TEST PIT NUMBER: TP-4-23	SHEET 1 OF 1
TEST PIT LOG		


 
PROJECT: Millersburg Transition Parkway, Millersburg, OR LOCATION: Millersburg, OR [Lat/Long: 44.6808, -123.0656]
 ELEVATION: 225.0 ft CONTRACTOR: Western States Soil Conservation
 EXCAVATION EQUIPMENT: DEERE 50G DATE EXCAVATED: 1/6/2023
 WATER LEVELS: None APPROX. DIMENSIONS: LOGGER: J.S. Nair

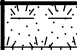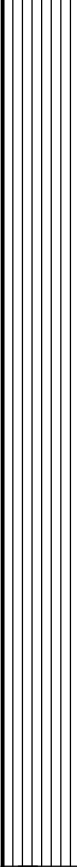DEPTH BELOW SURFACE (FT)	SAMPLE		SOIL DESCRIPTION	GRAPHIC LOG	COMMENT
	INTERVAL (ft)	#TYPE			
			TOPSOIL/DUFF		09:30 started excavation
			SILT (ML) brown, moist, low to medium plasticity, trace fine sand		
4.0	4.0	1-GRAB			
5					
10			Bottom of Boring at 10.0 ft bgs on		10:00 finished excavation
15					



PROJECT NUMBER: D3395316	TEST PIT NUMBER: TP-5-23	SHEET 1 OF 1
TEST PIT LOG		


 
PROJECT: Millersburg Transition Parkway, Millersburg, OR LOCATION: Millersburg, OR [Lat/Long: 44.6804, -123.0644]
 ELEVATION: 224.0 ft CONTRACTOR: Western States Soil Conservation
 EXCAVATION EQUIPMENT: DEERE 50G DATE EXCAVATED: 1/6/2023
 WATER LEVELS: None APPROX. DIMENSIONS: LOGGER: J.S. Nair

DEPTH BELOW SURFACE (FT)	SAMPLE		SOIL DESCRIPTION	GRAPHIC LOG	COMMENT
	INTERVAL (ft)	#TYPE			
			TOPSOIL/DUFF		09:00 started excavation
			SILT (ML) brown, moist, low to medium plasticity, trace fine sand		
4.0	4.0	1-GRAB			
5					
10			Bottom of Boring at 10.0 ft bgs on		09:30 finished excavation
15					



PROJECT NUMBER: D3395316	TEST PIT NUMBER: TP-6-23	SHEET 1 OF 1
TEST PIT LOG		

PROJECT: Millersburg Transition Parkway, Millersburg, OR LOCATION: Millersburg, OR [Lat/Long: 44.6796, -123.0644]
 ELEVATION: 225.0 ft CONTRACTOR: Western States Soil Conservation
 EXCAVATION EQUIPMENT: DEERE 50G DATE EXCAVATED: 1/6/2023
 WATER LEVELS: None APPROX. DIMENSIONS: LOGGER: J.S. Nair

SAMPLE		SOIL DESCRIPTION	GRAPHIC LOG	COMMENT
DEPTH BELOW SURFACE (FT)	INTERVAL (ft)	SOIL NAME, USCS GROUP SYMBOL, COLOR, MOISTURE CONTENT, RELATIVE DENSITY OR CONSISTENCY, SOIL STRUCTURE, MINERALOGY		DIFFICULTY IN EXCAVATION, RUNNING GRAVEL CONDITION, COLLAPSE OF WALLS, SAND HEAVE, DEBRIS ENCOUNTERED, WATER SEEPAGE GRADATIONAL CONTACTS, TEST INSTRUMENTATION
		TOPSOIL/DUFF		08:30 started excavation
		SILT (ML) brown, moist, low to medium plasticity, trace fine sand		
5	5.0	1-GRAB		
10		Bottom of Boring at 10.0 ft bgs on		09:00 finished excavation
15				

Appendix B

Soil Laboratory Test Results

Date: February 6, 2023

Project No.: 2226031-600

Re: Millersburg Transition Pkwy.

To: Jacobs
1100 NE Circle Blvd. Suite 300
Corvallis, OR 97330

Attn: Jithin Nair

Enclosed are:

- Report Drawings Test Results (12 Pages Total Incl. Cover)
 Copy of Letter Specifications
 Other

These are transmitted as checked below:

- For your use For your review/approval
 As requested For your files

Remarks: Requested laboratory testing results attached. Please call if you have any questions.

Date Sampled: unknown
Location Tested: Corvallis Laboratory
Sample No.: 8819

Copy to:

Signature:



Rachel Ray
President

This report and/or enclosed test data is the confidential property of the client to whom it is addressed and pertains to the specific process and/or material evaluated. As such, information contained herein shall not be reproduced in part or full and/or any part thereof be disclosed without FEI Testing & Inspection, Inc.'s written authorization.

**Percent Fines & Water Content Test
 (ASTM D 1140)**

PROJECT NAME	<u>Millersburg Transition Pkwy.</u>	PROJECT NUMBER	<u>2226031-600</u>
		FEI SAMPLE NUMBER	<u>8819</u>
RECORDED BY	<u>RR</u>	DATE	<u>2/3/2023</u>
CLIENT	<u>Jacobs</u>	CLIENT PROJECT NUMBER	<u>D3395316</u>

WATER CONTENT DIR or AUX*	DIR	DIR	DIR	DIR	DIR	DIR	DIR
SAMPLE DESIGNATION	B-1-23, 1-SS	B-2-23, 2-SS	B-3-23, 3-SS	B-4-23, 3-SS	B-5-23, 2-SS	B-5-23, 4-SS	B-5-23, 15-SS
SAMPLE DEPTH	2.5'	5.0'	10.0'	10.0'	5.0'	10.0'	60.0'
Pan Number	2	31	18	30	12	55	36
Wt. of Wet Soil + Pan (g)	339.46	375.00	353.82	306.56	358.26	325.43	478.70
Wt. of Dry Soil + Pan (g)	276.75	301.58	300.69	253.11	290.78	263.40	408.18
Wt. of Water (g)	62.71	73.42	53.13	53.45	67.48	62.03	70.52
Wt. of Pan (g)	76.35	80.20	69.98	80.85	69.57	81.33	79.75
Wt. of Dry Soil (g)	200.40	221.38	230.71	172.26	221.21	182.07	328.43
Water Content (%)	31.3%	33.2%	23.0%	31.0%	30.5%	34.1%	21.5%

TEST SAMPLE DATA							
TEST METHOD A or B	B	B	B	B	B	B	B
Length of Time Sample Soaked (hrs)	4	4	4	4	4	4	4
Pan Number	2	31	18	30	12	55	36
Wet Wt. + Pan (g)	339.46	375.00	353.82	306.56	358.26	325.43	478.70
Wet Wt. (g)	263.11	294.80	283.84	225.71	288.69	244.10	398.95
Wt. of Pan (g)	76.35	80.20	69.98	80.85	69.57	81.33	79.75
(A) Dry Soil (g) (Total Sample)	200.40	221.38	230.71	172.26	221.21	182.07	328.43

AFTER WASHING							
Pan Number	2	31	18	30	12	55	36
Dry Wt. + Pan (g)	130.13	107.01	150.81	124.70	166.50	131.11	336.01
Wt. of Pan (g)	76.35	80.20	69.98	80.85	69.57	81.33	79.75
(B) Wt. of Dry Soil	53.78	26.81	80.83	43.85	96.93	49.78	256.26
(C) Total Loss (g) (No. 200) (C=A-B)	146.62	194.57	149.88	128.41	124.28	132.29	72.17
% Fines (C/A)	73.2%	87.9%	65.0%	74.5%	56.2%	72.7%	22.0%

*DIR=Dry mass was determined directly by drying the test specimen

*AUX=Dry mass was determined using an auxiliary water content specimen

Equipment Used

Oven ID # 6060
 Scale ID # 6067
 Sieve ID # LS30B

Reviewed By Rachel Day

**Percent Fines & Water Content Test
 (ASTM D 1140)**

PROJECT NAME	<u>Millersburg Transition Pkwy.</u>	PROJECT NUMBER	<u>2226031-600</u>
		FEI SAMPLE NUMBER	<u>8819</u>
RECORDED BY	<u>RR</u>	DATE	<u>2/3/2023</u>
CLIENT	<u>Jacobs</u>	CLIENT PROJECT NUMBER	<u>D3395316</u>

WATER CONTENT DIR or AUX*	DIR						
SAMPLE DESIGNATION	B-6-23, 2-SS						
SAMPLE DEPTH	5.0'						
Pan Number	61						
Wt. of Wet Soil + Pan (g)	364.79						
Wt. of Dry Soil + Pan (g)	304.80						
Wt. of Water (g)	59.99						
Wt. of Pan (g)	79.22						
Wt. of Dry Soil (g)	225.58						
Water Content (%)	26.6%						

TEST SAMPLE DATA							
TEST METHOD A or B	B						
Length of Time Sample Soaked (hrs)	4						
Pan Number	61						
Wet Wt. + Pan (g)	364.79						
Wet Wt. (g)	285.57						
Wt. of Pan (g)	79.22						
(A) Dry Soil (g) (Total Sample)	225.58						

AFTER WASHING							
Pan Number	61						
Dry Wt. + Pan (g)	174.94						
Wt. of Pan (g)	79.22						
(B) Wt. of Dry Soil	95.72						
(C) Total Loss (g) (No. 200) (C=A-B)	129.86						
% Fines (C/A)	57.6%						

*DIR=Dry mass was determined directly by drying the test specimen


*AUX=Dry mass was determined using an auxiliary water content specimen

Equipment Used

Oven ID # 6060
 Scale ID # 6067
 Sieve ID # LS30B

Reviewed By Rachel Day

LIQUID AND PLASTIC LIMITS TEST REPORT

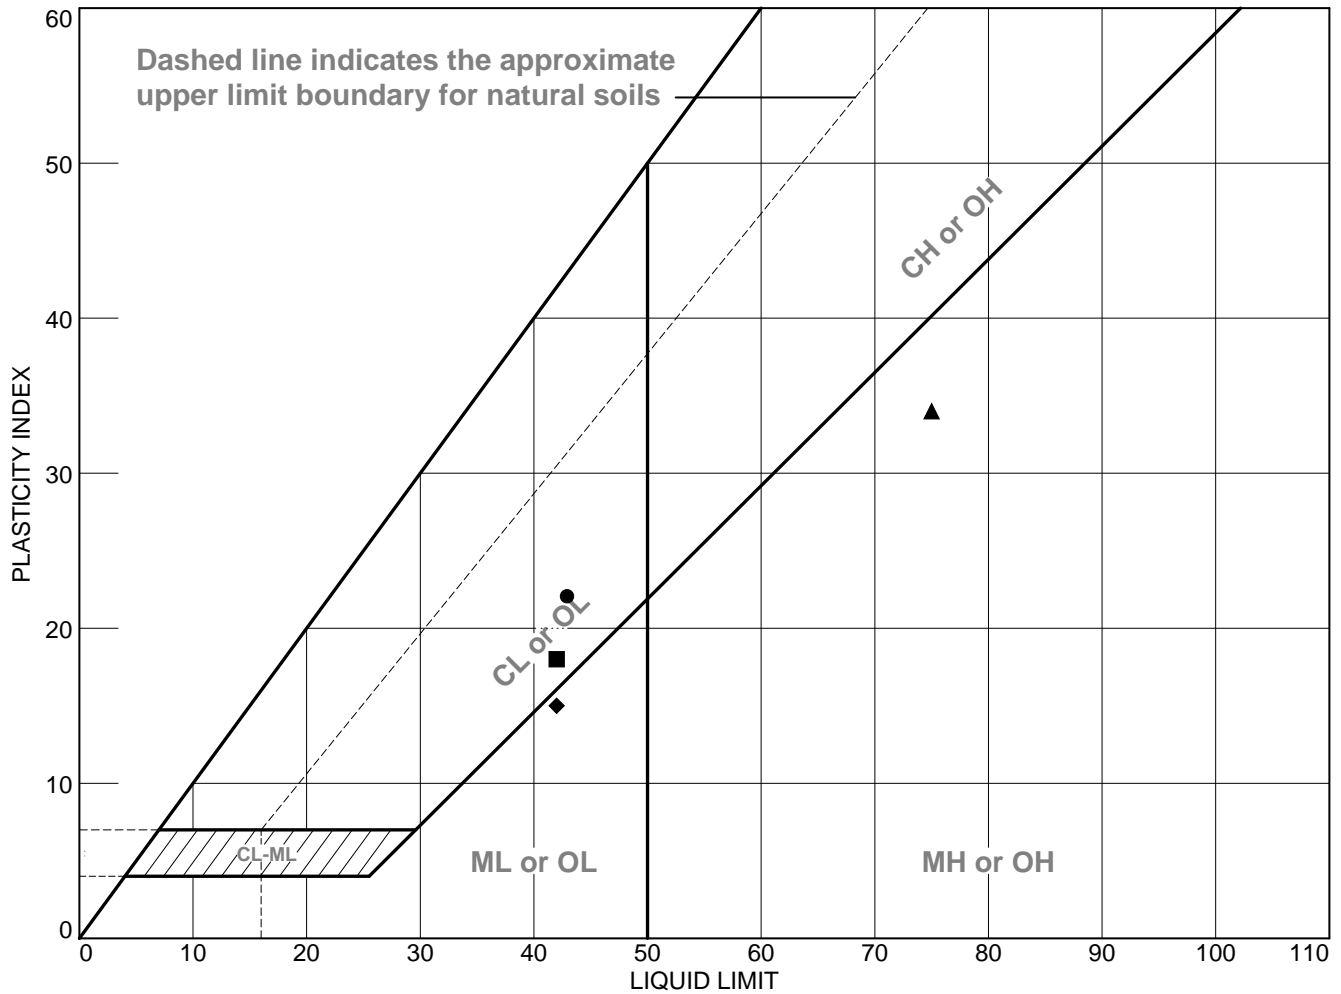

SOIL DATA								
SYMBOL	SOURCE	SAMPLE NO.	DEPTH	NATURAL WATER CONTENT (%)	PLASTIC LIMIT (%)	LIQUID LIMIT (%)	PLASTICITY INDEX (%)	USCS
●	8819	B-1-22, 2-SS	5.0'	28.9	21	43	22	CL
■	8819	B-2-23, 1-SS	2.5'	30.6	24	42	18	CL
▲	8819	B-3-22, 4-SS	15.0'	51.8	41	75	34	MH
◆	8819	B-4-23, 2-SS	5.0'	35.1	27	42	15	ML


FEI Testing & Inspection, Inc.
Corvallis, OR

Client: Jacobs (Project No. D3395316)
Project: Millersburg Transition Pkwy.

Project No.: 2236031-600

Figure

LIQUID AND PLASTIC LIMITS TEST REPORT

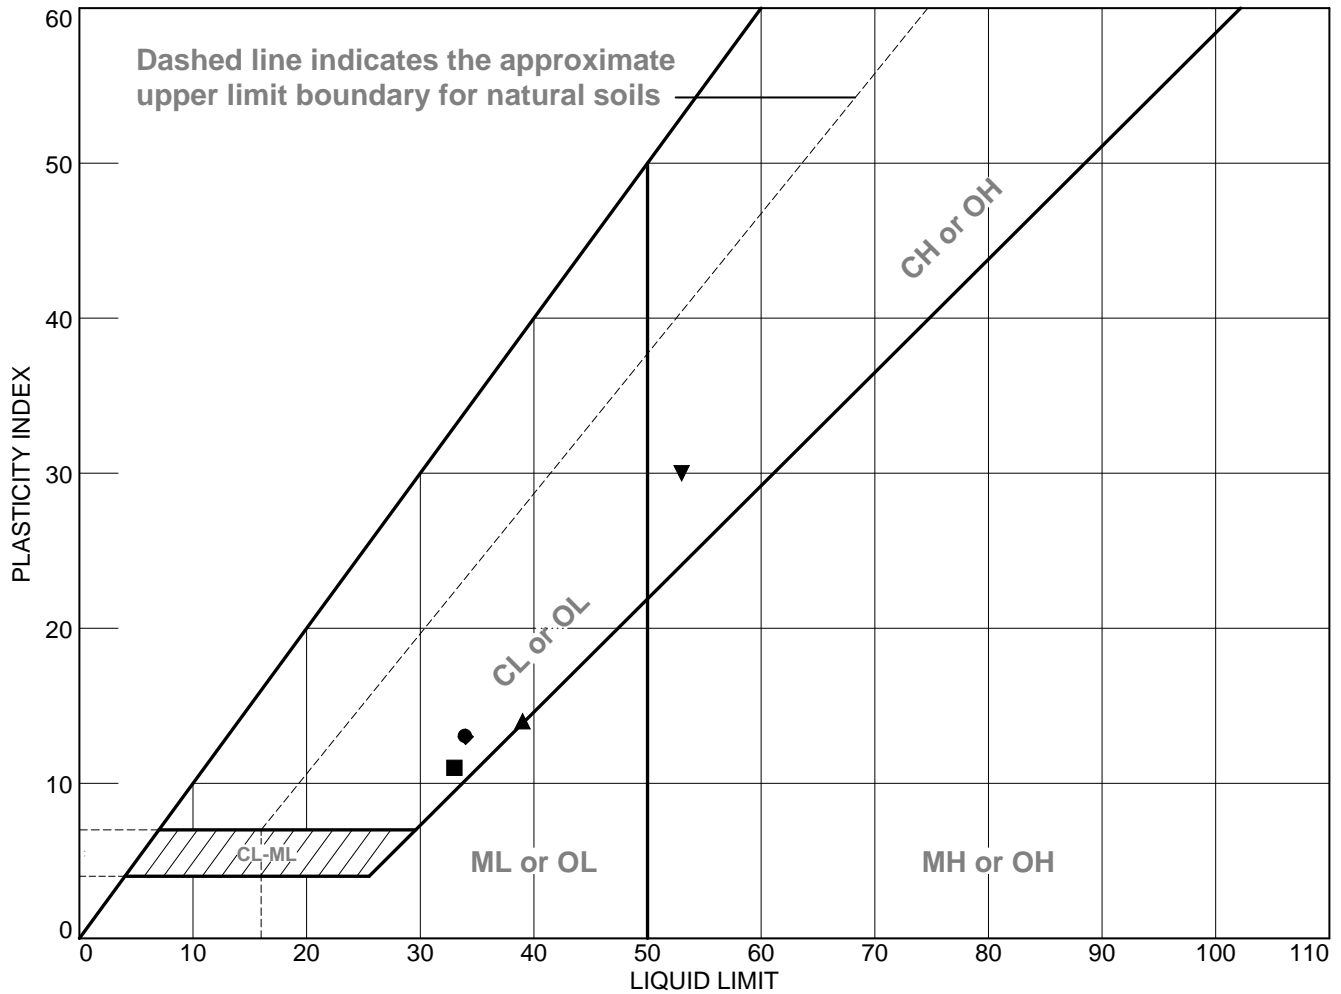

SOIL DATA								
SYMBOL	SOURCE	SAMPLE NO.	DEPTH	NATURAL WATER CONTENT (%)	PLASTIC LIMIT (%)	LIQUID LIMIT (%)	PLASTICITY INDEX (%)	USCS
●	8819	B-5-23, 3-SS	7.5'	35.5	21	34	13	CL
■	8819	B-5-23, 5-SS	12.5'	34.2	22	33	11	CL
▲	8819	B-6-22, 1-SS	2.5'	34.1	25	39	14	CL
◆	8819	B-6-22, 3-SS	7.5'	33.7	21	34	13	CL
▼	8819	B-6-22, 6-SS	15.0'	34.7	23	53	30	CH


FEI Testing & Inspection, Inc.
Corvallis, OR

Client: Jacobs (Project No. D3395316)
Project: Millersburg Transition Pkwy.

Project No.: 2236031-600

Figure

Sieve Analysis ASTM C 136/C 117

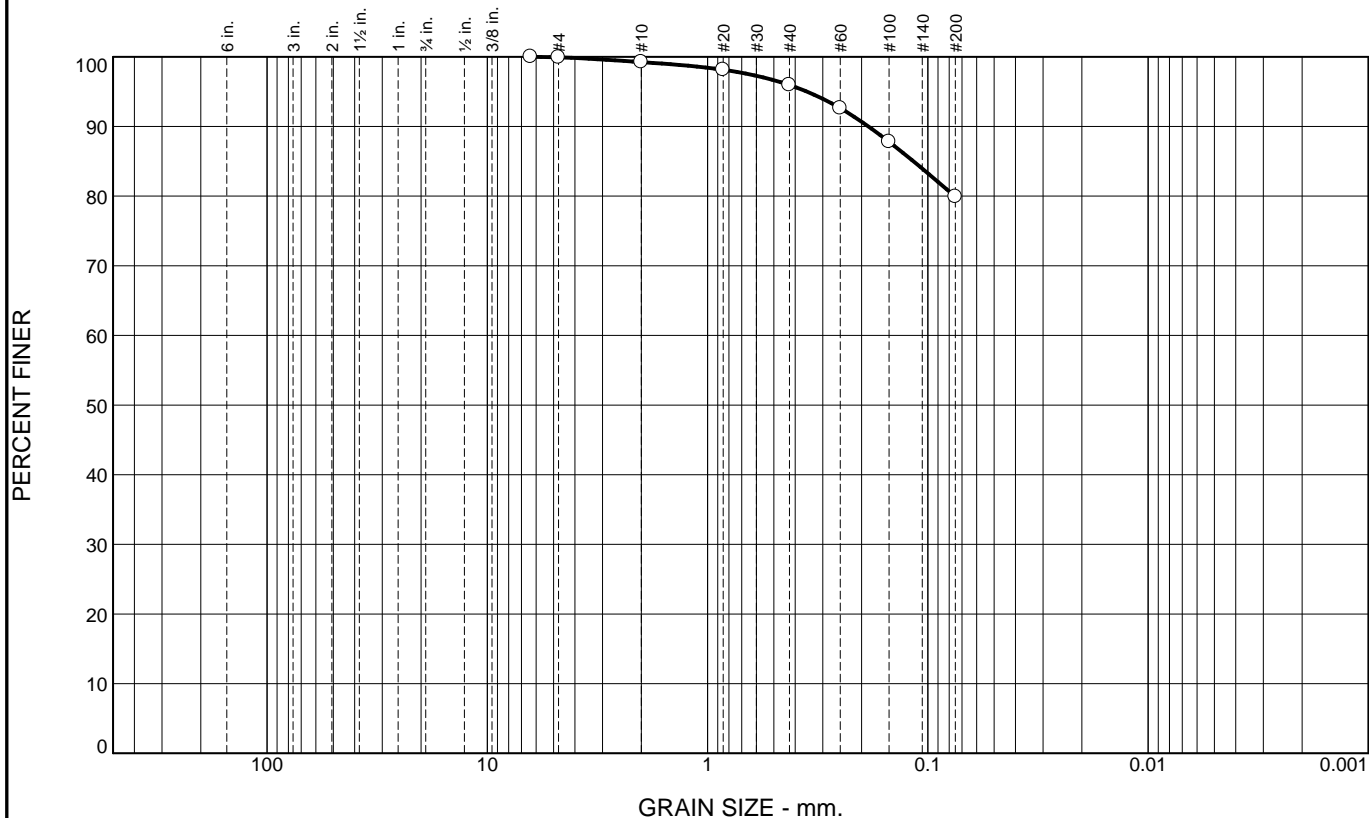

% +3"	% Gravel		% Sand			% Fines	
	Coarse	Fine	Coarse	Medium	Fine	Silt	Clay
0	0	0	1	3	16	80	

SIEVE SIZE	PERCENT FINER	SPEC.* PERCENT	PASS? (X=NO)
1/4	100		
#4	100		
#10	99		
#20	98		
#40	96		
#60	93		
#100	88		
#200	80		

Soil Description

Atterberg Limits
 PL= LL= PI=

Coefficients
 D₉₀= 0.1862 D₈₅= 0.1163 D₆₀=
 D₅₀= D₃₀= D₁₅=
 D₁₀= C_u= C_c=

Classification
 USCS= AASHTO=

Remarks
 Water Content: 31.6%

* (no specification provided)

Source of Sample: 8819 Depth: 20.0'
 Sample Number: B-5-23, 8-SS

Date: 02-03-2023


FEI Testing & Inspection, Inc.
Corvallis, OR

Client: Jacobs (Project No. D3395316)
 Project: Millersburg Transition Pkwy.

Project No: 2236031-600

Figure

Sieve Analysis ASTM C 136/C 117

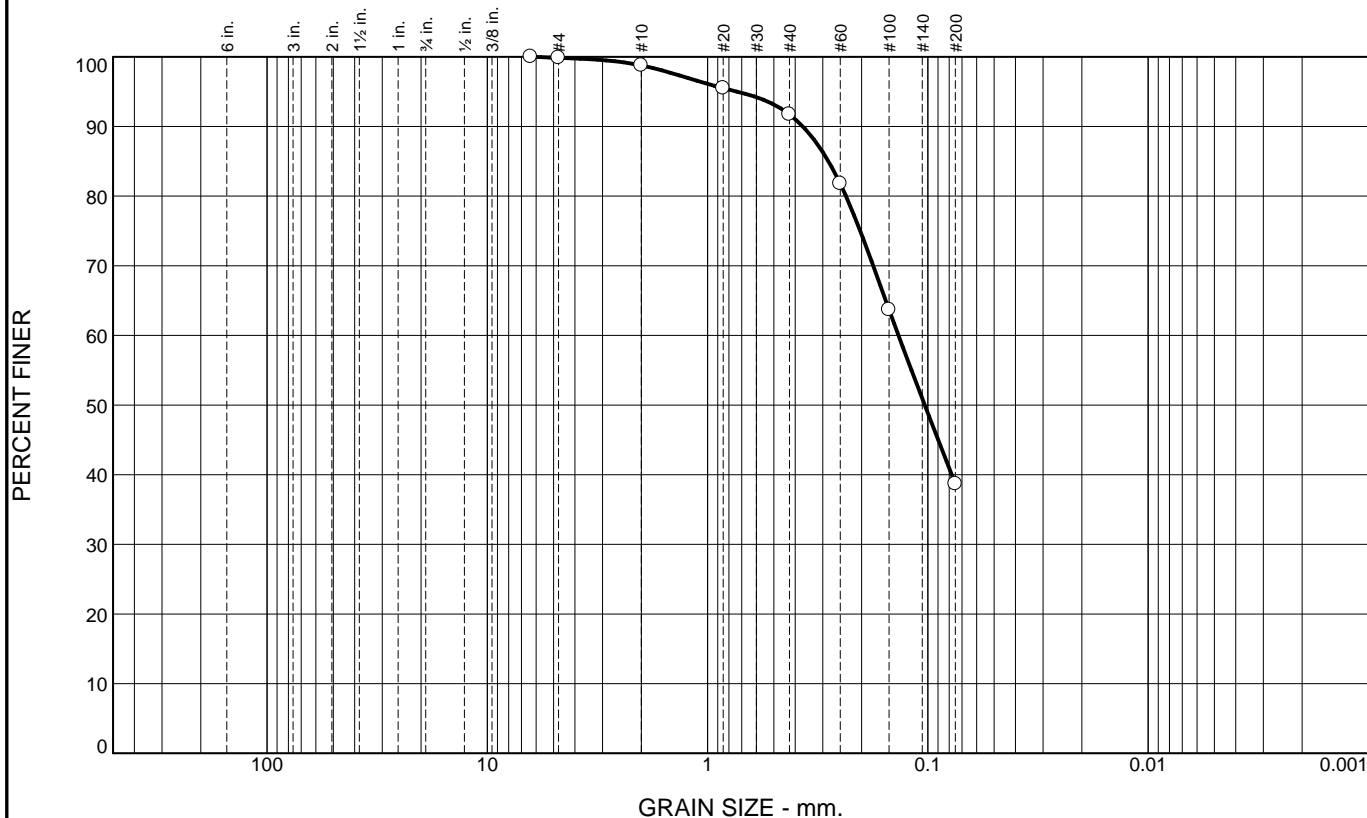

% +3"	% Gravel		% Sand			% Fines	
	Coarse	Fine	Coarse	Medium	Fine	Silt	Clay
0	0	0	1	7	53	39	

SIEVE SIZE	PERCENT FINER	SPEC.* PERCENT	PASS? (X=NO)
1/4	100		
#4	100		
#10	99		
#20	95		
#40	92		
#60	82		
#100	64		
#200	39		

Soil Description

Atterberg Limits
 PL= LL= PI=

Coefficients
 D₉₀= 0.3697 D₈₅= 0.2828 D₆₀= 0.1360
 D₅₀= 0.1033 D₃₀= D₁₅=
 D₁₀= C_u= C_c=

Classification
 USCS= AASHTO=

Remarks
 Water Content: 27.0%

* (no specification provided)

Source of Sample: 8819 Depth: 30.0'
 Sample Number: B-5-23, 10-SS

Date: 02-03-2023


FEI Testing & Inspection, Inc.
Corvallis, OR

Client: Jacobs (Project No. D3395316)
 Project: Millersburg Transition Pkwy.

Project No: 2236031-600

Figure

Sieve Analysis ASTM C 136/C 117

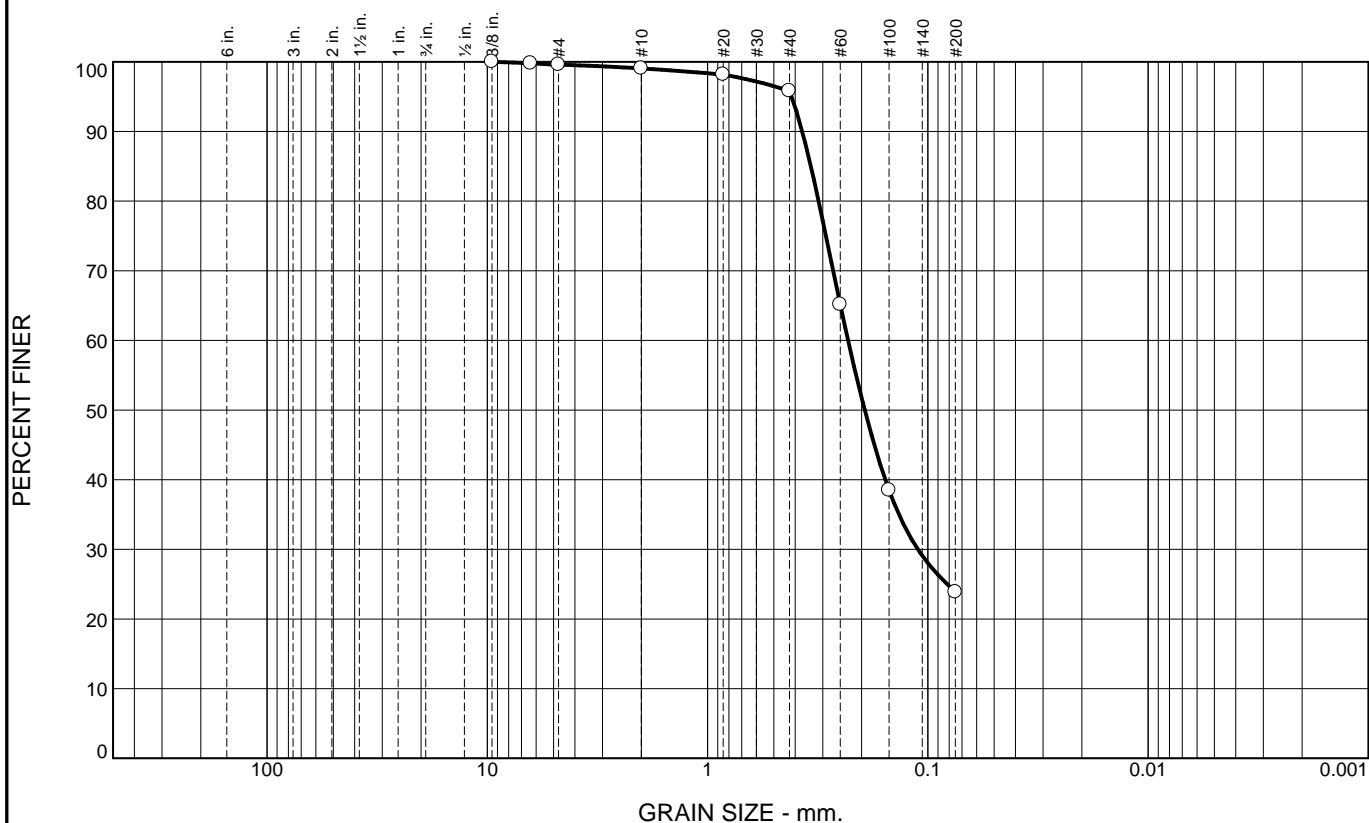

GRAIN SIZE - mm.

% +3"	% Gravel		% Sand			% Fines	
	Coarse	Fine	Coarse	Medium	Fine	Silt	Clay
0	0	0	1	3	72	24	

SIEVE SIZE	PERCENT FINER	SPEC.* PERCENT	PASS? (X=NO)
3/8	100		
1/4	100		
#4	100		
#10	99		
#20	98		
#40	96		
#60	65		
#100	38		
#200	24		

Soil Description

Atterberg Limits
 PL= LL= PI=

Coefficients
 D₉₀= 0.3718 D₈₅= 0.3398 D₆₀= 0.2303
 D₅₀= 0.1934 D₃₀= 0.1110 D₁₅=
 D₁₀= C_u= C_c=

Classification
 USCS= AASHTO=

Remarks
 Water Content: 21.7%

* (no specification provided)

Source of Sample: 8819 Depth: 45.0'
 Sample Number: B-5-23, 13-SS

Date: 02-03-2023


FEI Testing & Inspection, Inc.
Corvallis, OR

Client: Jacobs (Project No. D3395316)
Project: Millersburg Transition Pkwy.

Project No: 2236031-600

Figure

Sieve Analysis ASTM C 136/C 117

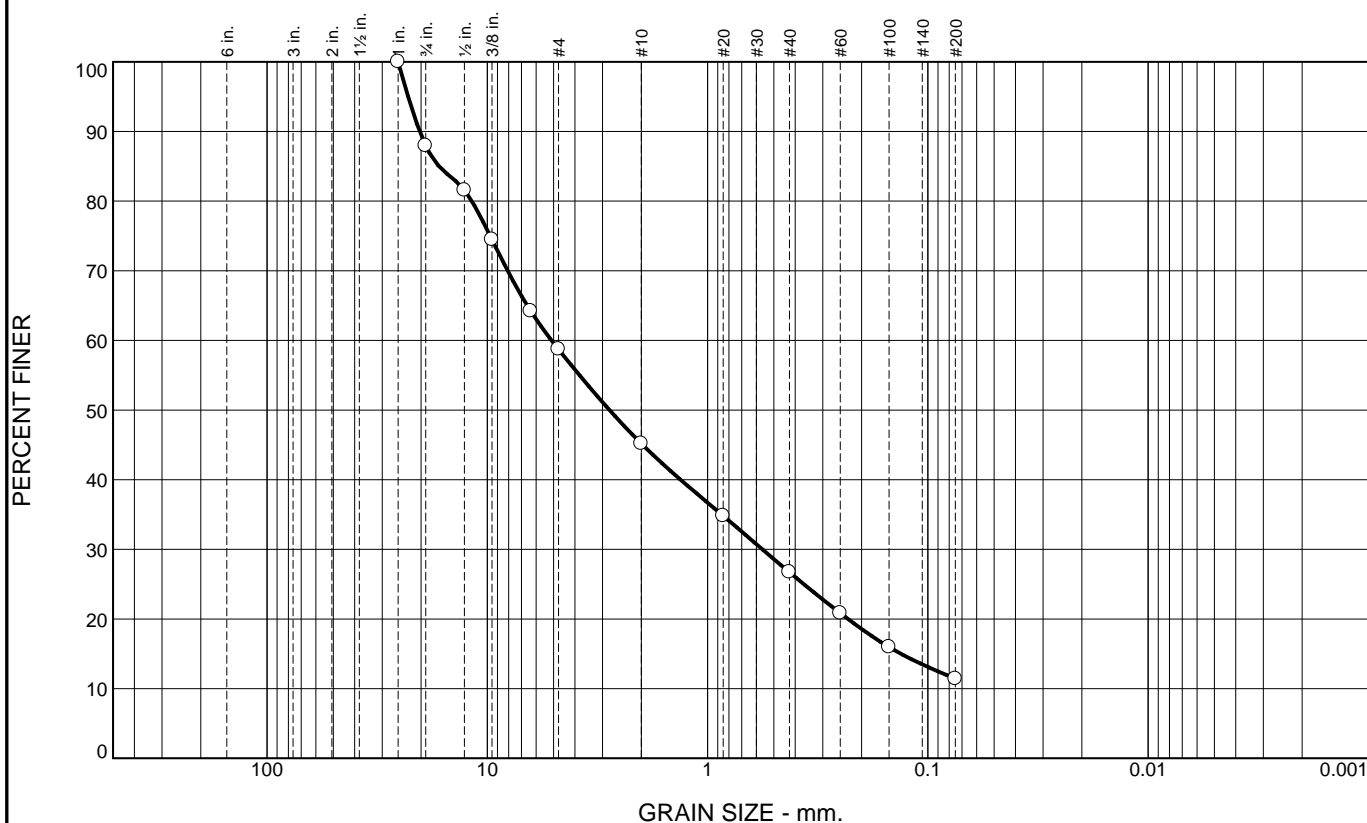

% +3"	% Gravel		% Sand			% Fines	
	Coarse	Fine	Coarse	Medium	Fine	Silt	Clay
0	12	29	14	18	16	11	

SIEVE SIZE	PERCENT FINER	SPEC.* PERCENT	PASS? (X=NO)
1	100		
3/4	88		
1/2	82		
3/8	74		
1/4	64		
#4	59		
#10	45		
#20	35		
#40	27		
#60	21		
#100	16		
#200	11		

Soil Description

Atterberg Limits
 PL= LL= PI=

Coefficients
 D₉₀= 20.2835 D₈₅= 16.5576 D₆₀= 5.1086
 D₅₀= 2.7878 D₃₀= 0.5635 D₁₅= 0.1323
 D₁₀= C_u= C_c=

Classification
 USCS= AASHTO=

Remarks
 Water Content: 13.2%

* (no specification provided)

Source of Sample: 8819 Depth: 25.0'
 Sample Number: B-6-23, 9-SS

Date: 02-03-2023


FEI Testing & Inspection, Inc.
Corvallis, OR

Client: Jacobs (Project No. D3395316)
 Project: Millersburg Transition Pkwy.

Project No: 2236031-600

Figure

Sieve Analysis ASTM C 136/C 117

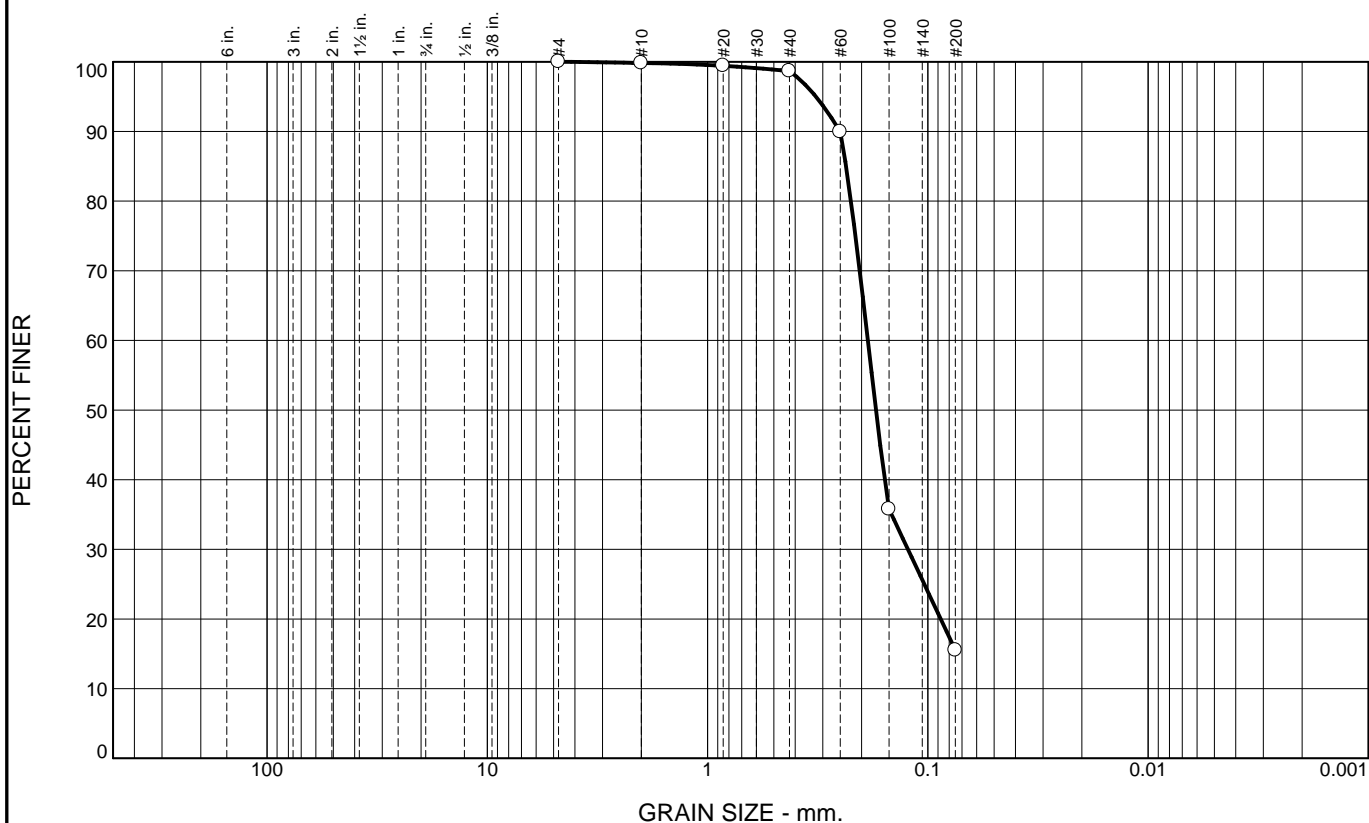

% +3"	% Gravel		% Sand			% Fines	
	Coarse	Fine	Coarse	Medium	Fine	Silt	Clay
						100	

SIEVE SIZE	PERCENT FINER	SPEC.* PERCENT	PASS? (X=NO)
#4	100		
#10	100		
#20	99		
#40	99		
#60	90		
#100	36		
#200	16		

Soil Description

Atterberg Limits
 PL= LL= PI=

Coefficients
 D₉₀= D₈₅= D₆₀=
 D₅₀= D₃₀= D₁₅=
 D₁₀= C_u= C_c=

Classification
 USCS= AASHTO=

Remarks
 Water Content: 27.8%

* (no specification provided)

Source of Sample: 8819 Depth: 35.0'
 Sample Number: B-6-23, 11-SS

Date: 02-03-2023


FEI Testing & Inspection, Inc.
Corvallis, OR

Client: Jacobs (Project No. D3395316)
Project: Millersburg Transition Pkwy.

Project No: 2236031-600

Figure

Sieve Analysis ASTM C 136/C 117

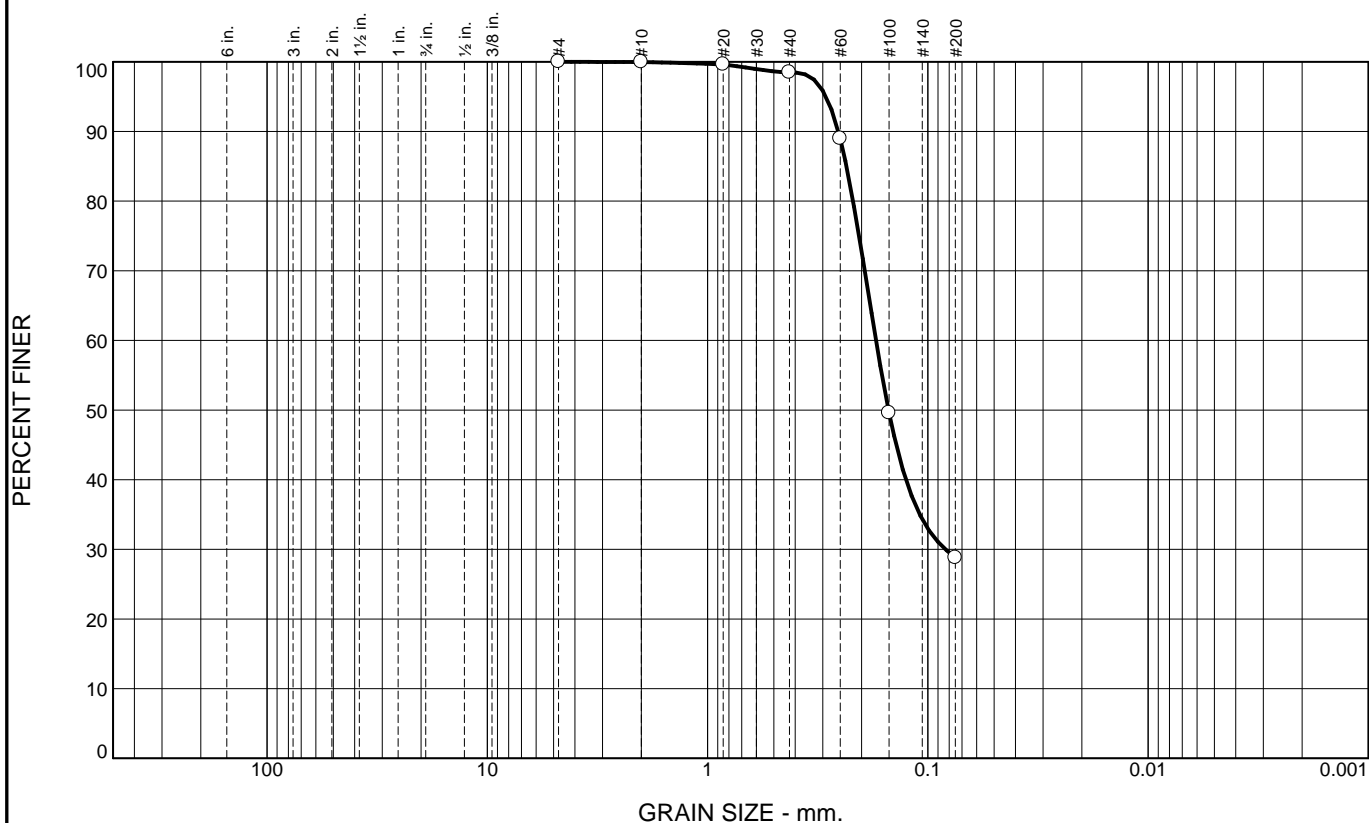

% +3"	% Gravel		% Sand			% Fines	
	Coarse	Fine	Coarse	Medium	Fine	Silt	Clay
						100	

SIEVE SIZE	PERCENT FINER	SPEC.* PERCENT	PASS? (X=NO)
#4	100		
#10	100		
#20	100		
#40	98		
#60	89		
#100	50		
#200	29		

Soil Description

Atterberg Limits
 PL= LL= PI=

Coefficients
 D₉₀= D₈₅= D₆₀=
 D₅₀= D₃₀= D₁₅=
 D₁₀= C_u= C_c=

Classification
 USCS= AASHTO=

Remarks
 Water Content: 25.1%

* (no specification provided)

Source of Sample: 8819 Depth: 45.0'
 Sample Number: B-6-23, 13-SS

Date: 02-03-2023


FEI Testing & Inspection, Inc.
Corvallis, OR

Client: Jacobs (Project No. D3395316)
 Project: Millersburg Transition Pkwy.

Project No: 2236031-600

Figure

Sieve Analysis ASTM C 136/C 117

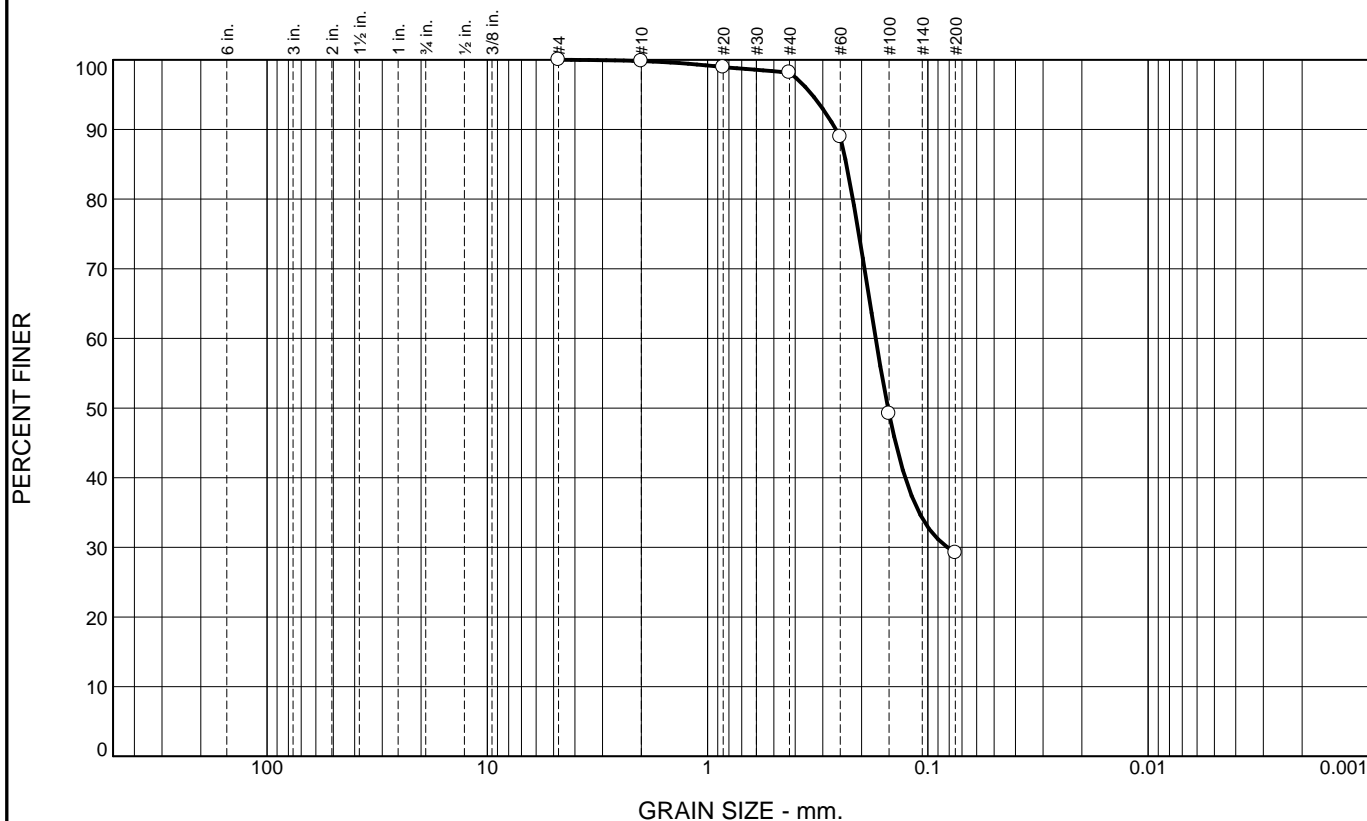

% +3"	% Gravel		% Sand			% Fines	
	Coarse	Fine	Coarse	Medium	Fine	Silt	Clay
						100	

SIEVE SIZE	PERCENT FINER	SPEC.* PERCENT	PASS? (X=NO)
#4	100		
#10	100		
#20	99		
#40	98		
#60	89		
#100	49		
#200	29		

Soil Description

Atterberg Limits
 PL= LL= PI=

Coefficients
 D₉₀= D₈₅= D₆₀=
 D₅₀= D₃₀= D₁₅=
 D₁₀= C_u= C_c=

Classification
 USCS= AASHTO=

Remarks
 Water Content: 21.4%

* (no specification provided)

Source of Sample: 8819 Depth: 60.0'
 Sample Number: B-6-23, 15-SS

Date: 02-03-2023


FEI Testing & Inspection, Inc.
Corvallis, OR

Client: Jacobs (Project No. D3395316)
Project: Millersburg Transition Pkwy.

Project No: 2236031-600

Figure

3. City of Millersburg Sanitary Sewer Collection System Contract 2

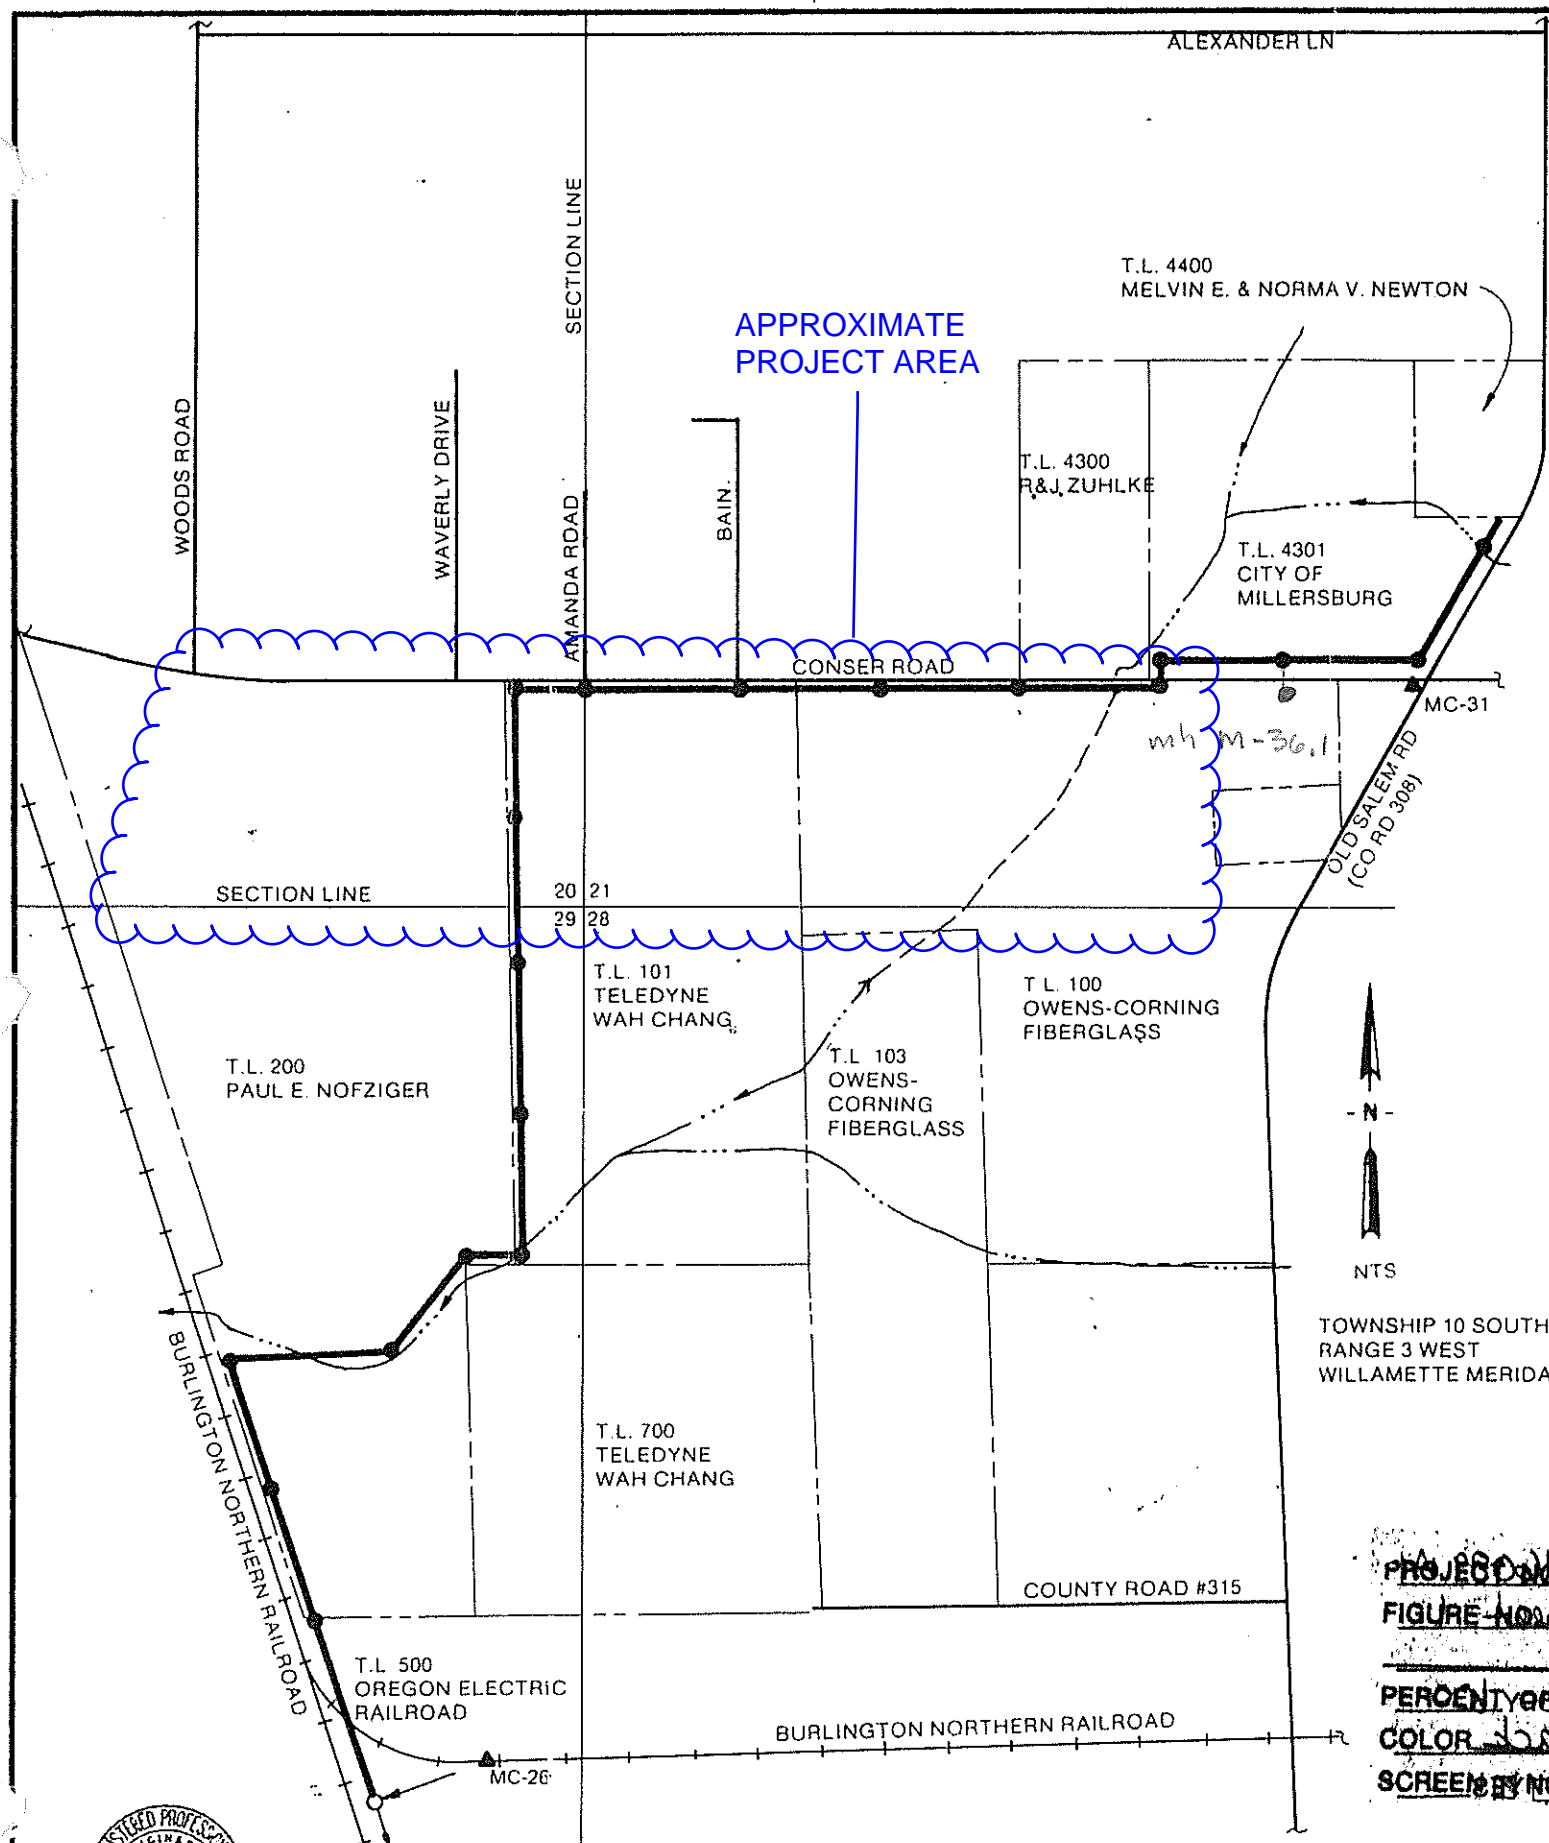


LEGEND

- NEW**
- MH "M"-6 MANHOLE DESIGNATION
 - GRAVITY SEWER WITH MANHOLE
 - BACKFILL CLASSIFICATION
 - 8" @ 0.004 SIZE AND SLOPE OF PIPE (8" PIPE AT 0.0040 FT/FT)
 - IV ASTM C-76. CLASS III, IV OR V AS NOTED
- EXISTING**
- SANITARY SEWER WITH MANHOLE
 - STORM SEWER WITH CATCH BASIN AND MANHOLE
 - 12" IRR IRRIGATION PIPELINE
 - 8" W WATER PIPELINE WITH FIRE HYDRANT AND VALVE
 - 2" G GAS PIPELINE
 - P UNDERGROUND POWER CABLE
 - T UNDERGROUND TELEPHONE CABLE
 - TV UNDERGROUND TELEVISION CABLE
 - 12" CMP CULVERT (SIZE AND TYPE INDICATED)
 - *-*-* FENCE LINE
 - UTILITY POLE WITH GUY ANCHOR
- GENERAL**
- RIGHT-OF-WAY AND/OR PROPERTY LINE
 - T.L. 4400 TAX LOT NUMBER
 - EL EASEMENT LINE
 - 20P WIDTH OF PERMANENT EASEMENT
 - 30T WIDTH OF TEMPORARY EASEMENT
 - BM-1 BENCH MARK LOCATION AND NUMBER
 - DITCH SHOWING DIRECTION OF FLOW

ABBREVIATIONS LEGEND

- EL ELEVATION
- FLL FLOW LINE LEVEL
- GND GROUND
- IE INVERT ELEVATION
- MH MANHOLE

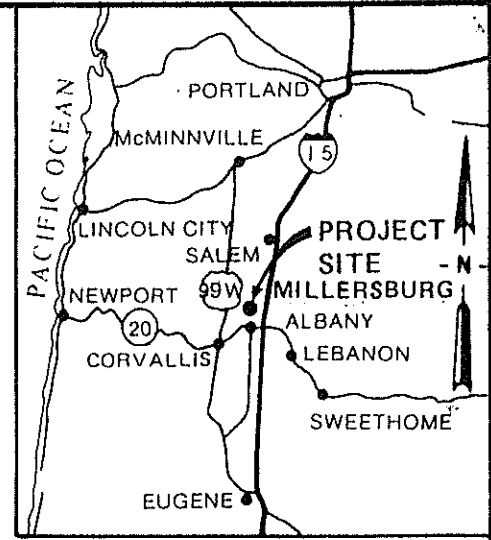

VICINITY MAP

BENCHMARK DESCRIPTION

TBM NO.	USC & GS ELEVATION	DESCRIPTION AND LOCATION
MC-26	218.02	NAIL AND SHINER IN CENTERLINE OF R.R. 2600 ± WEST OF COUNTY ROAD NUMBER 308, 70' ± EAST OF P.C. IN R.R. TRACKS, 45' EAST OF NORTH-SOUTH ROW OF TREES IN OLD FENCE LINE, APPROXIMATE STA 4+40 "MB" LINE.
MC-31	242.36	NAIL AND SHINER IN CENTER OF RAISED ISLAND OF OLD SALEM ROAD AND CONSER ROAD

INDEX TO DRAWINGS

SHEET NO.	TITLE
1	VICINITY MAP, LOCATION MAP, BENCHMARK, DESCRIPTIONS, INDEX TO DRAWINGS AND LEGEND
MILLERSBURG TRUNK SEWER "M" LINE	
2	PLAN AND PROFILE - STA 0+00 TO STA 12+00
3	PLAN AND PROFILE - STA 12+00 TO STA 24+00
4	PLAN AND PROFILE - STA 24+00 TO STA 37+00
5	PLAN AND PROFILE - STA 37+00 TO STA 48+00
6	PLAN AND PROFILE - STA 48+00 TO STA 61+00
7	PLAN AND PROFILE - STA 61+00 TO STA 72+00
8	PLAN AND PROFILE - STA 72+00 TO STA 81+03
MISCELLANEOUS DETAILS	
9	RAILROAD UNDERCROSSING AND MANHOLE DETAILS
10	MANHOLE DETAILS
11	PIPELINE, TRENCH AND SURFACING DETAILS
12	SERVICE CONNECTION DETAILS

PROJECT LOCATION MAP
 FIGURE NO. 1
 PERCENTAGE OF TOTAL
 COLOR BLACK
 SCREENED ON REVISIONS





DES. CRS				
DR. CRS				
CHK. DAC	11/82	RECORD DWG	JLM	
APPD. DAC	NO	DATE	BY	APPD

SANITARY SEWAGE COLLECTION SYSTEM
CONTRACT NO. 2

CITY OF MILLERSBURG
LINN COUNTY, OREGON

**VICINITY MAP; LOCATION MAP,
BENCHMARK DESCRIPTIONS,
INDEX TO DRAWINGS AND LEGEND**

SHEET 1
OF 12
DATE JUNE 82
DWG. NO. E16089 A1

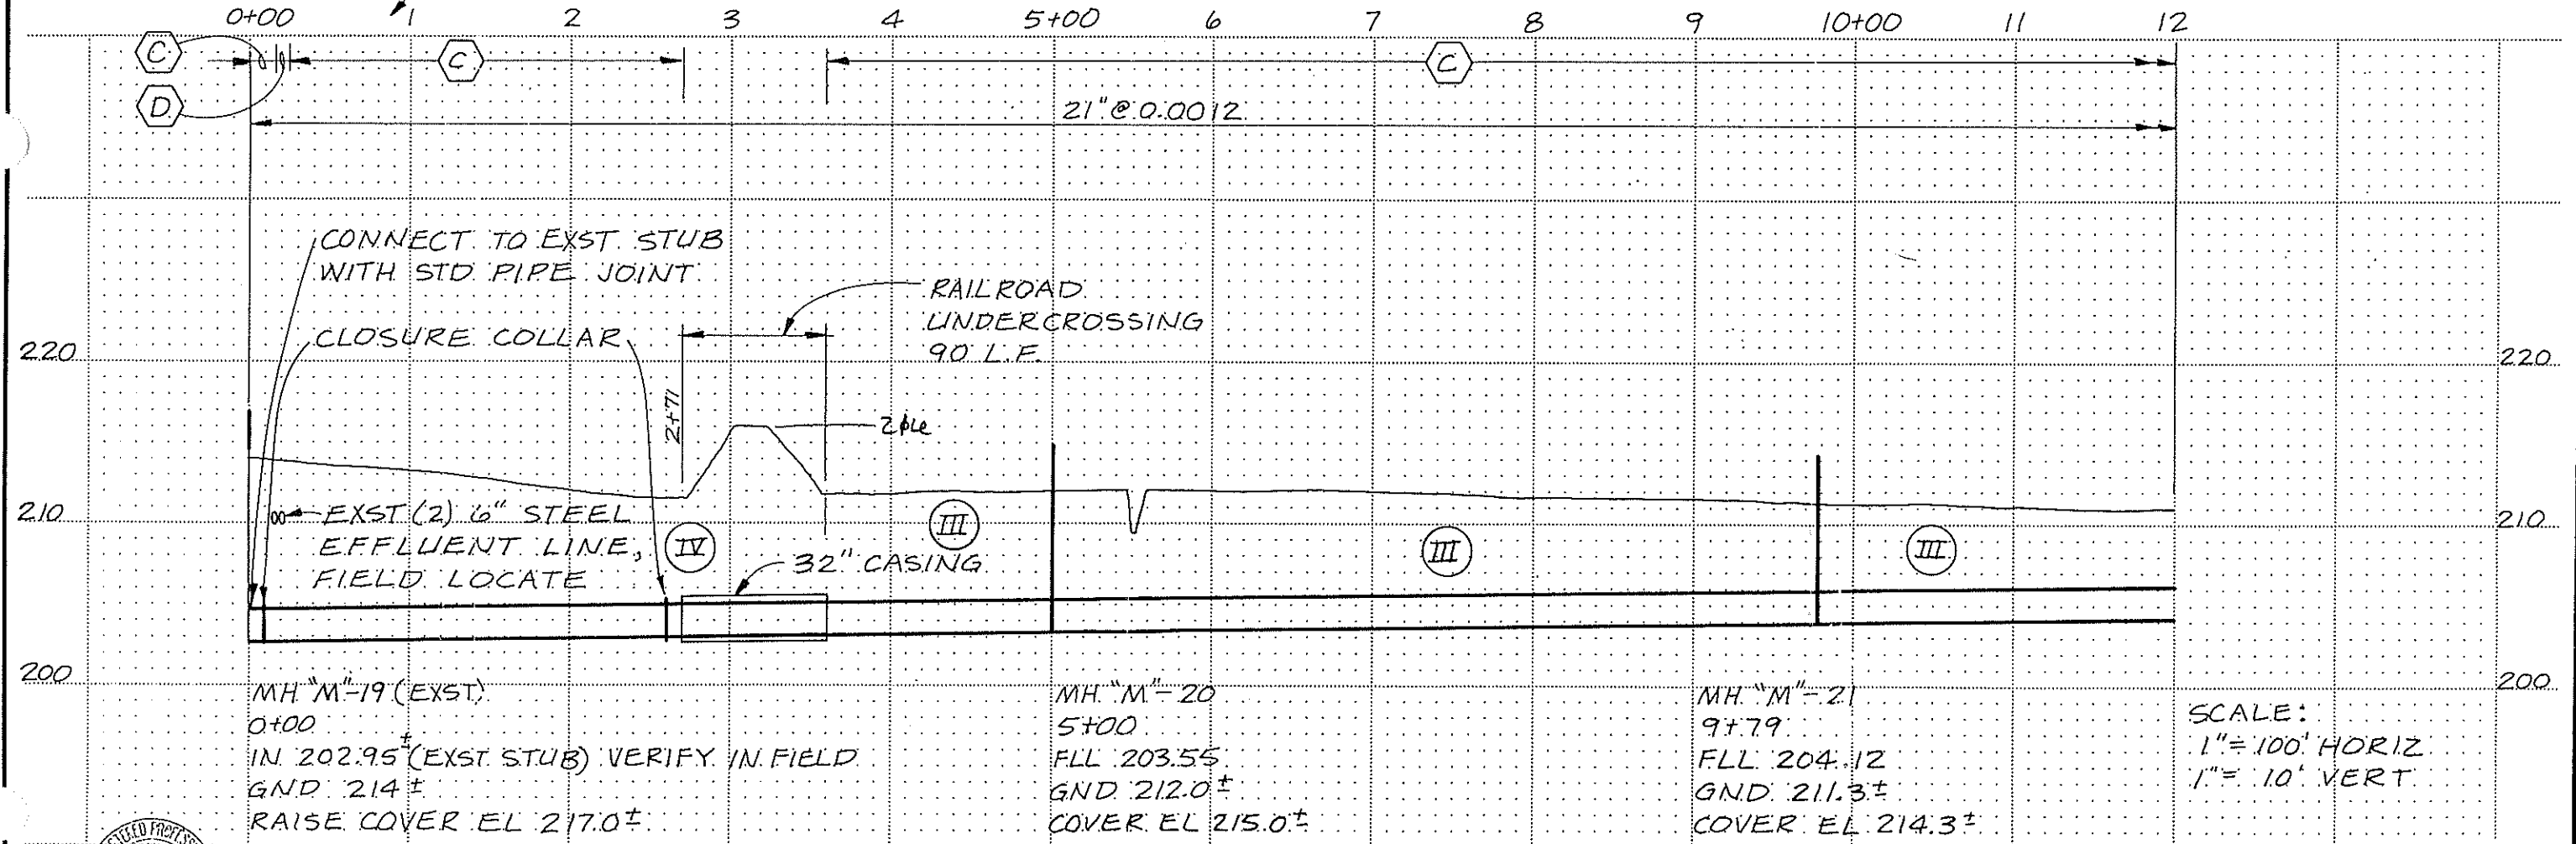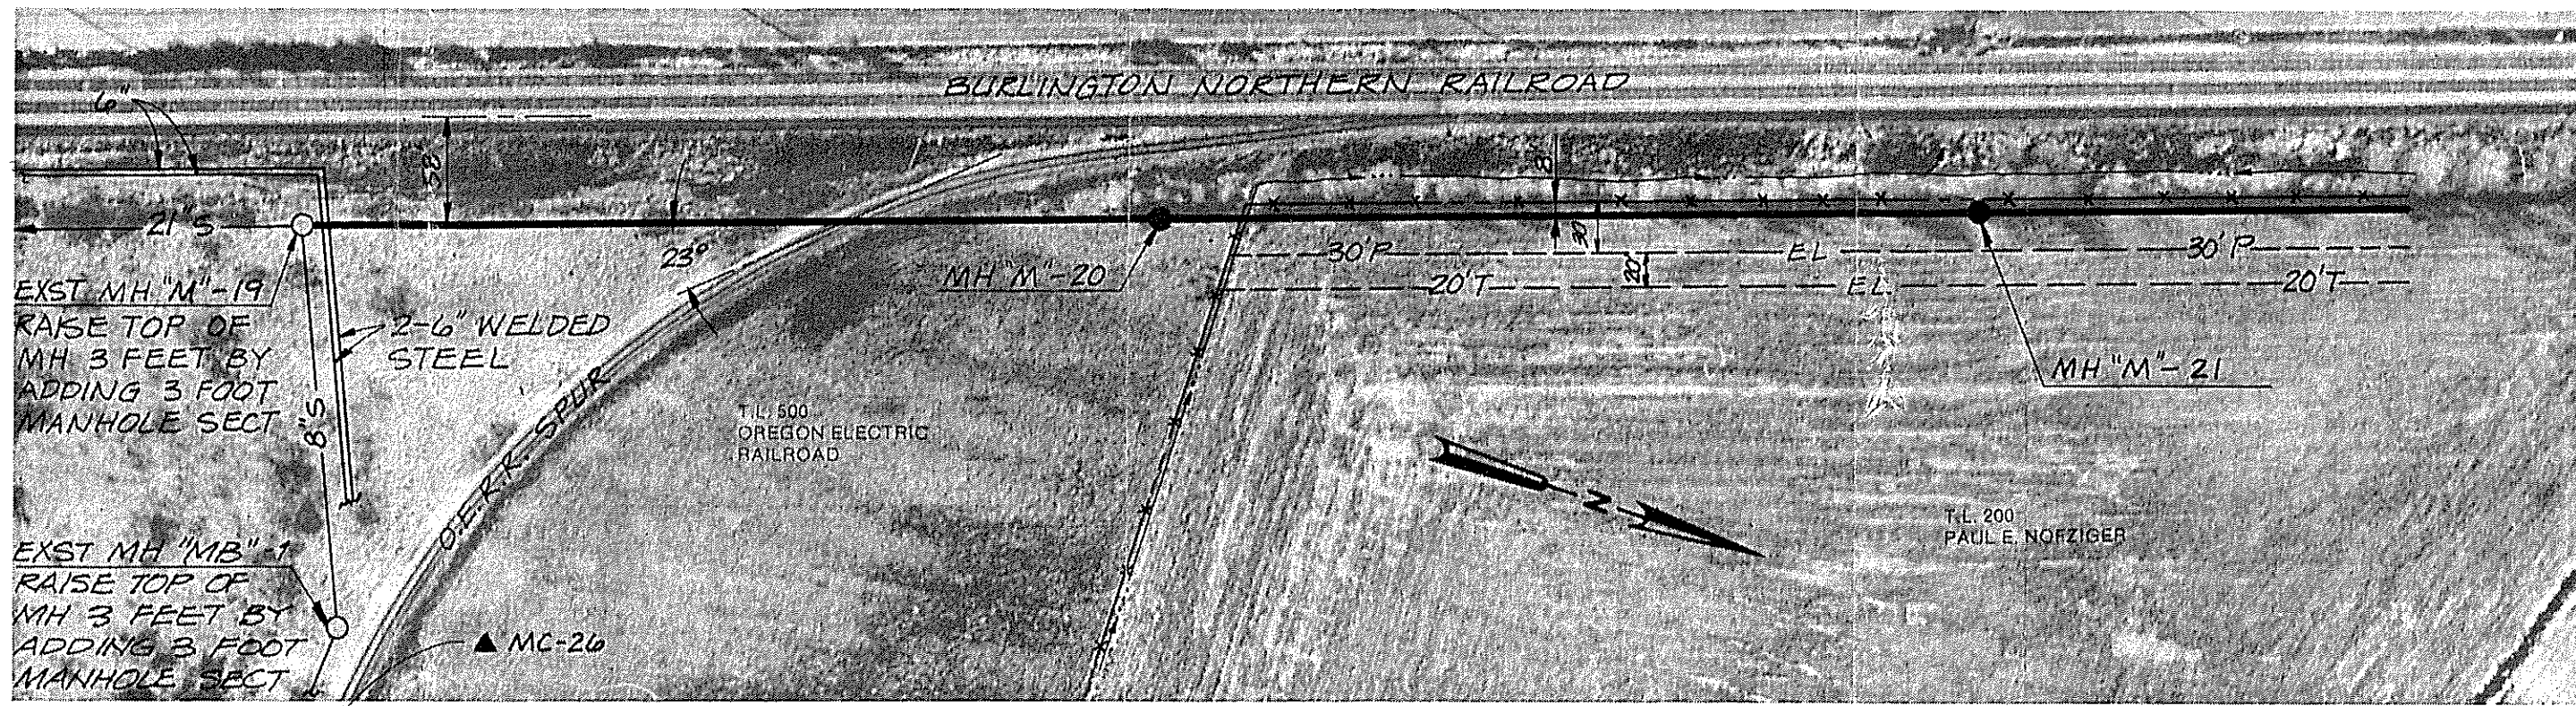

MH "M"-19 (EXST.)
0+00

IN 202.95' (EXST. STUB) VERIFY IN FIELD
GND. 214.0±
RAISE COVER EL 217.0±

MH "M"-20
5+00

FLL 203.55'
GND. 212.0±
COVER EL 215.0±

MH "M"-21
9+79

FLL 204.12'
GND. 211.3±
COVER EL 214.3±

SCALE:
1" = 100' HORIZ.
1" = 10' VERT.





CH2M HILL	DES. CRS	11/82	RECORD DWG	JLM	BY	APPD.
	DR. CRS					
	CHK. DAC					
	APPD. DAC					

SANITARY SEWAGE COLLECTION SYSTEM
CONTRACT NO 2

CITY OF MILLERSBURG
LINN COUNTY, OREGON

MILLERSBURG TRUNK SEWER
"M" LINE
PLAN AND PROFILE
STA 0+00 TO STA 12+00

SHEET 2
OF 12
DATE JUNE 82
DWG. NO. E16089 A1

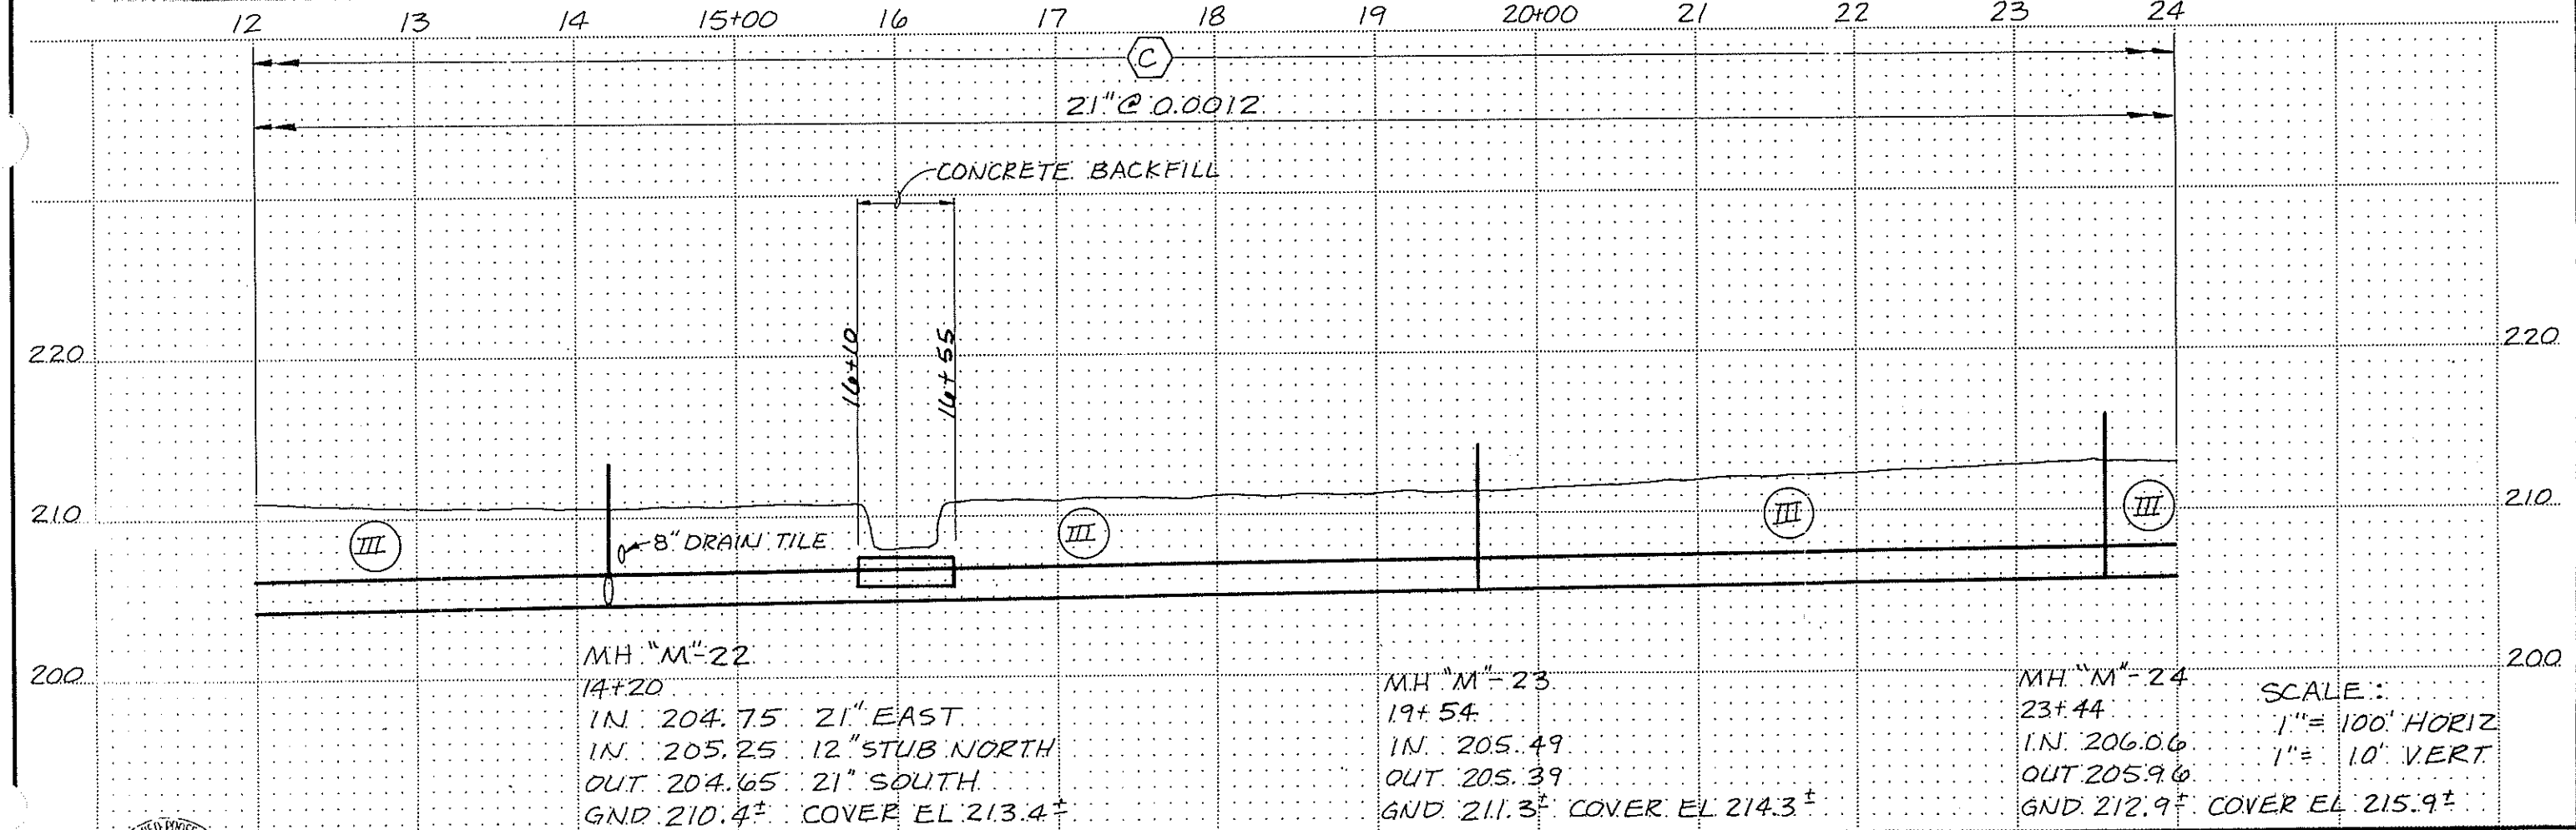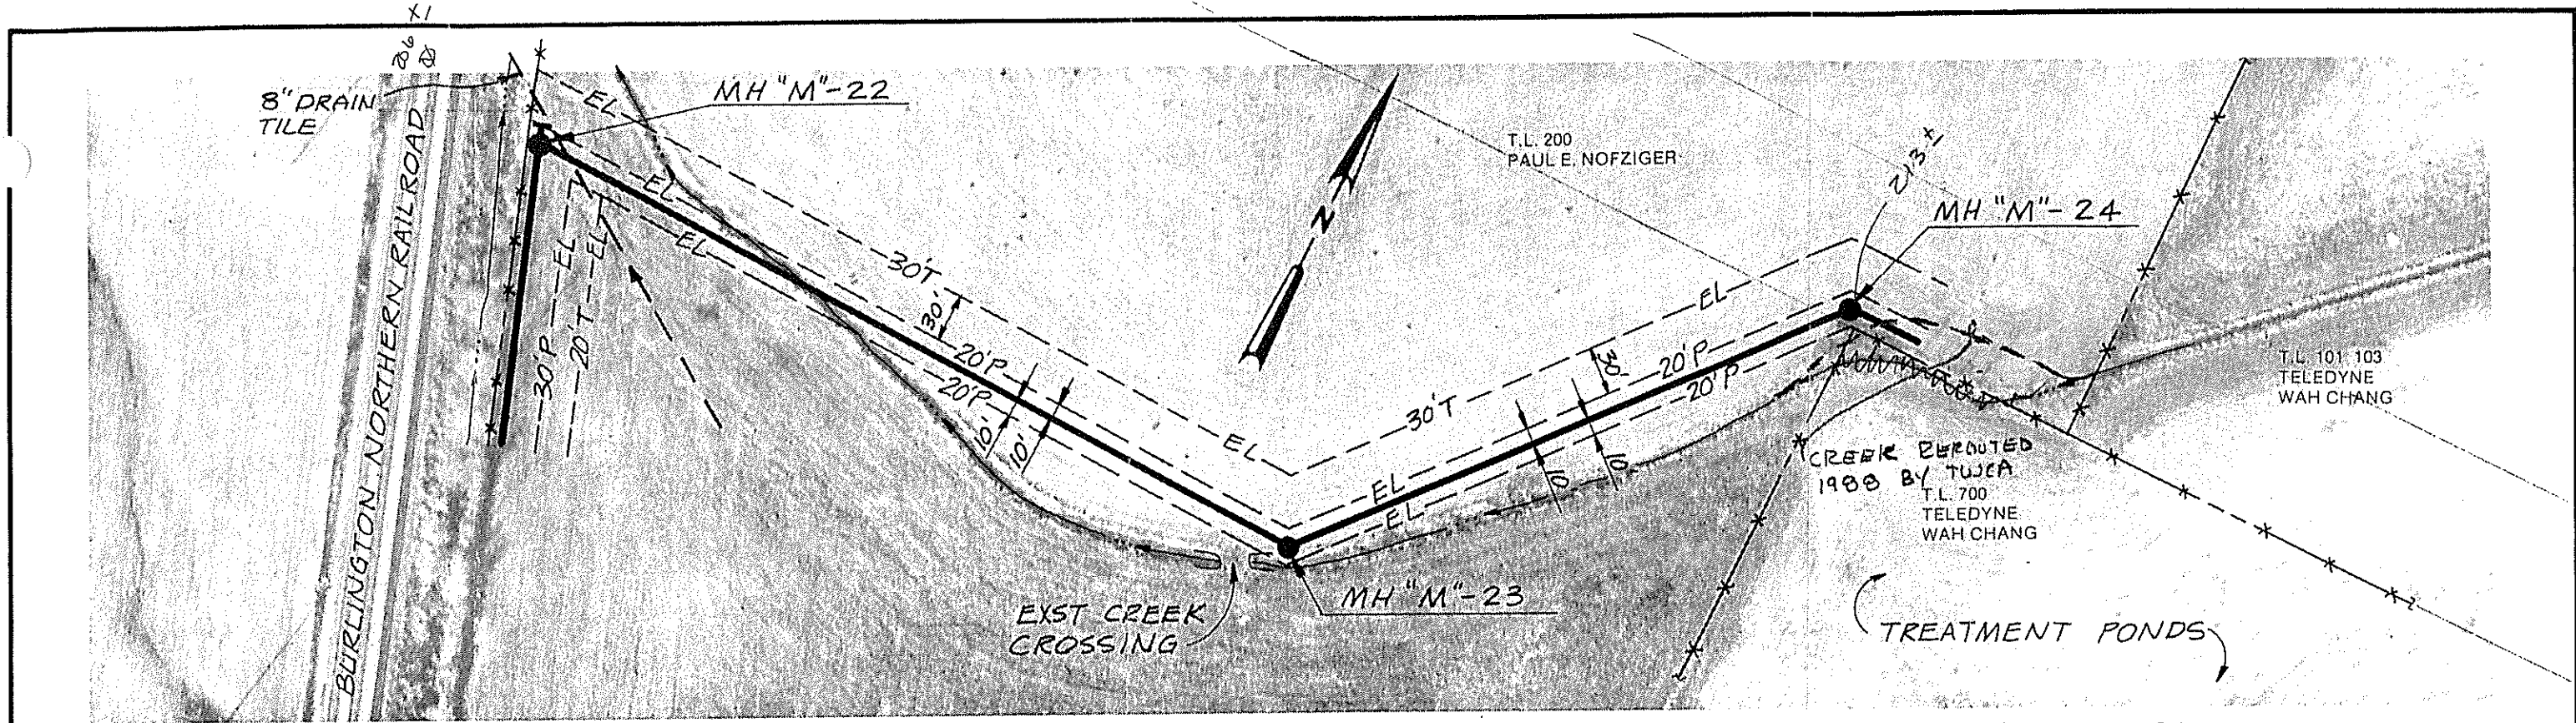

MH "M"-22
 14+20
 I.N. 204.75 21" EAST
 I.N. 205.25 12" STUB NORTH
 O.N. 204.65 21" SOUTH
 G.N.D. 210.4± COVER EL. 213.4±

MH "M"-23
 19+54
 I.N. 205.49
 O.N. 205.39
 G.N.D. 211.3± COVER EL. 214.3±

MH "M"-24
 23+44
 I.N. 206.06
 O.N. 205.96
 G.N.D. 212.9± COVER EL. 215.9±

SCALE:
 1" = 100' HORIZ
 1" = 10' VERT.





CH2M HILL	DES. CRS	11/82	RECORD DWG	JLM	BY	APPD.
	DR. CRS					
	CHK. D.I.C					
	APPD. DAC					

SANITARY SEWAGE COLLECTION SYSTEM
 CONTRACT NO. 2

CITY OF MILLERSBURG
 LINN COUNTY, OREGON

MILLERSBURG TRUNK SEWER
 "M" LINE
 PLAN AND PROFILE
 STA 12+00 TO STA 24+00

SHEET 3
 OF 12
 DATE JUNE 82
 DWG. NO. E16089 A1

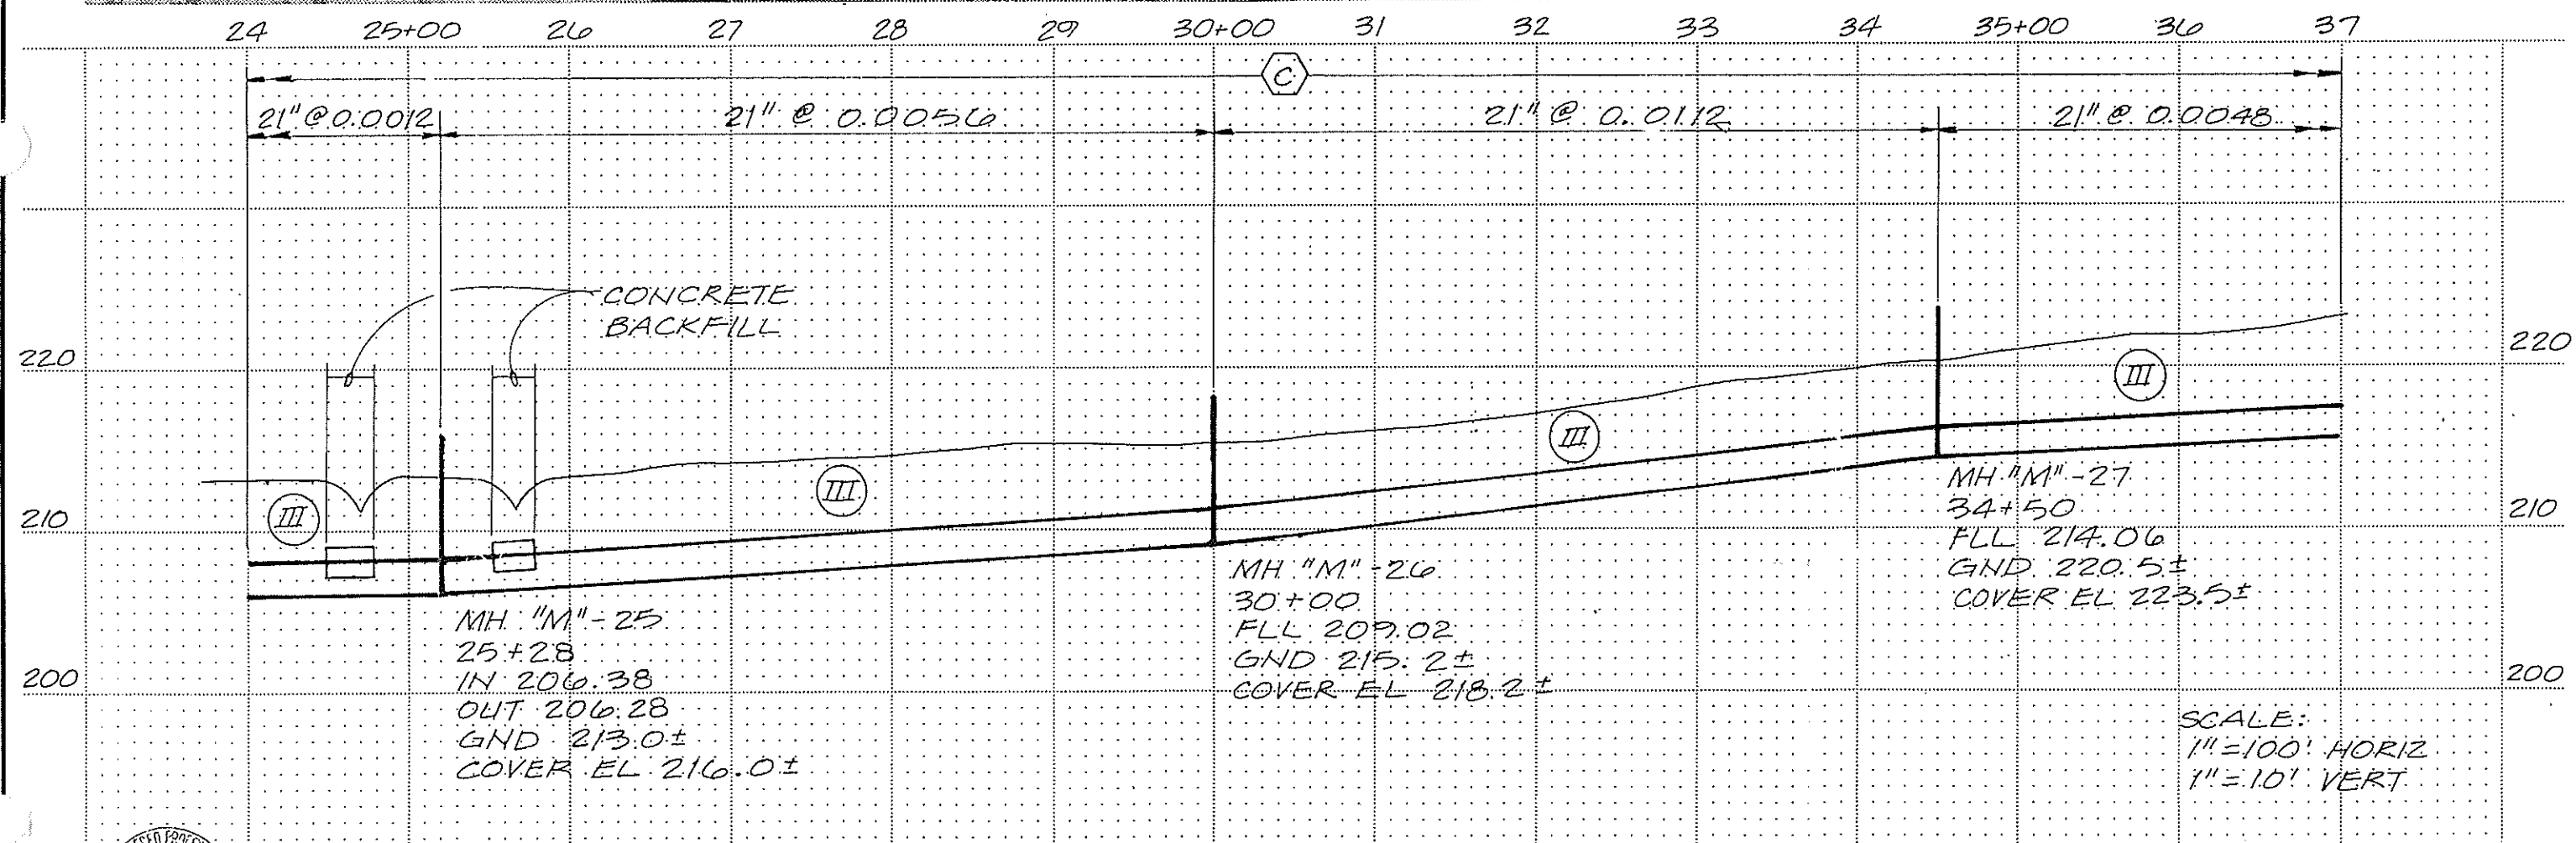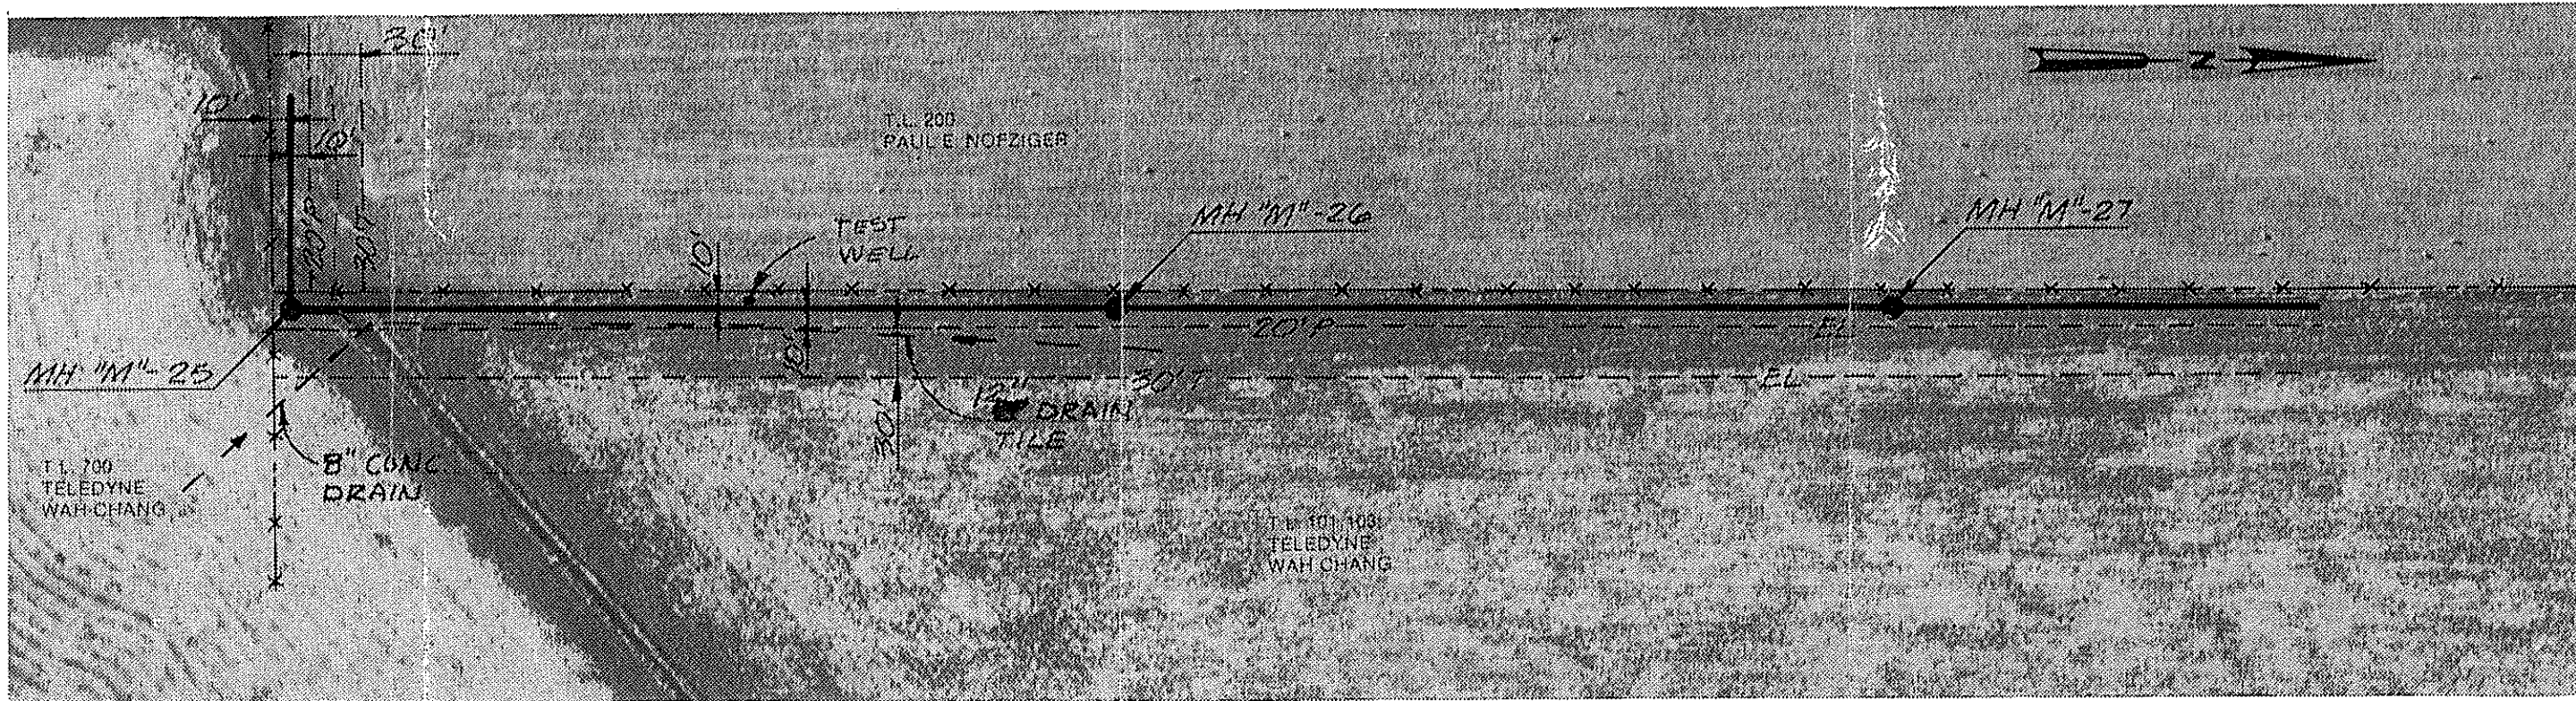




CH2M HILL DES. TAB DR. GPG CHK. DAC APPD. DAC	NO.	DATE	REVISION	BY	APPD.
		11/82	RECORD DWG	JLM	

SANITARY SEWAGE COLLECTION SYSTEM
 CONTRACT NO. 2

CITY OF MILLERSBURG
 LINN COUNTY, OREGON

**MILLERSBURG TRUNK SEWER
 "M" LINE
 PLAN AND PROFILE
 STA 24+00 TO STA 37+00**

SHEET 4
 OF 12
 DATE JUNE 82
 DWG. NO. E16089 A1

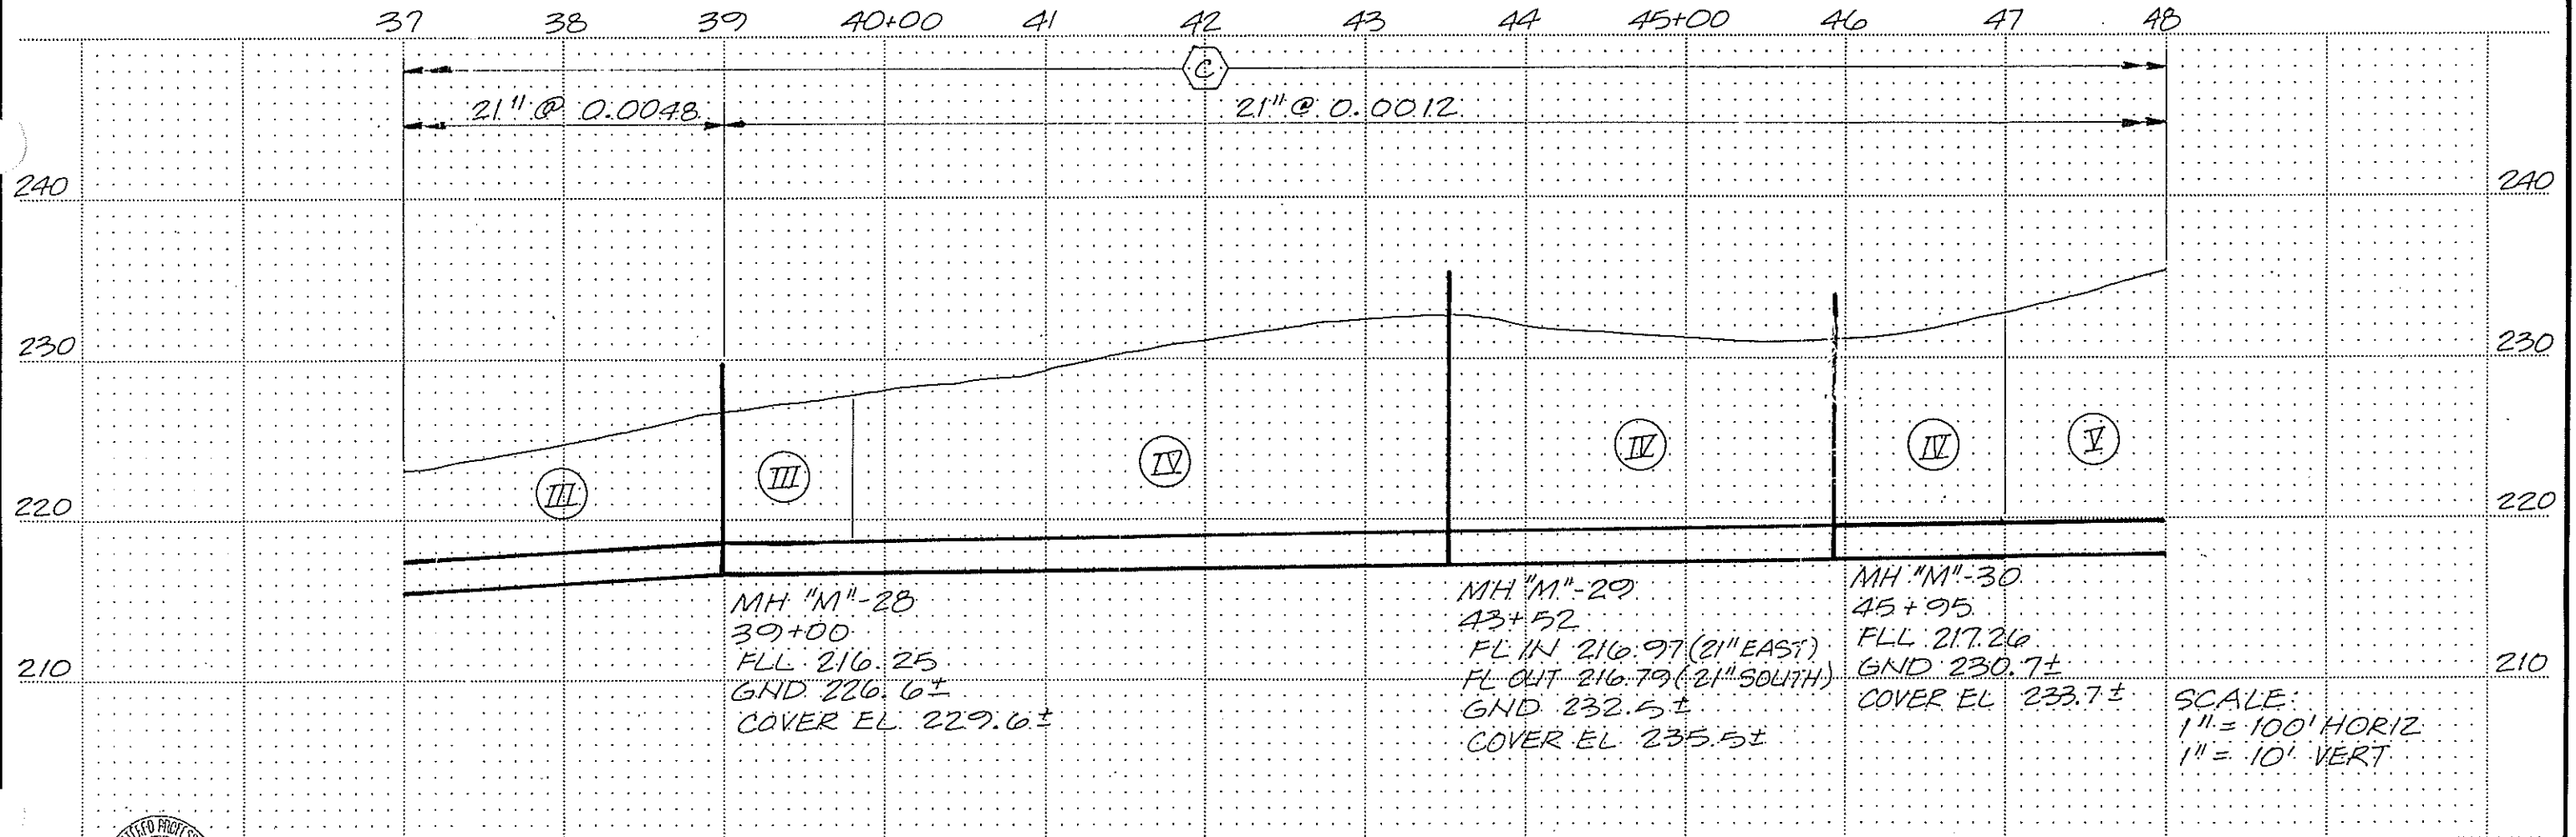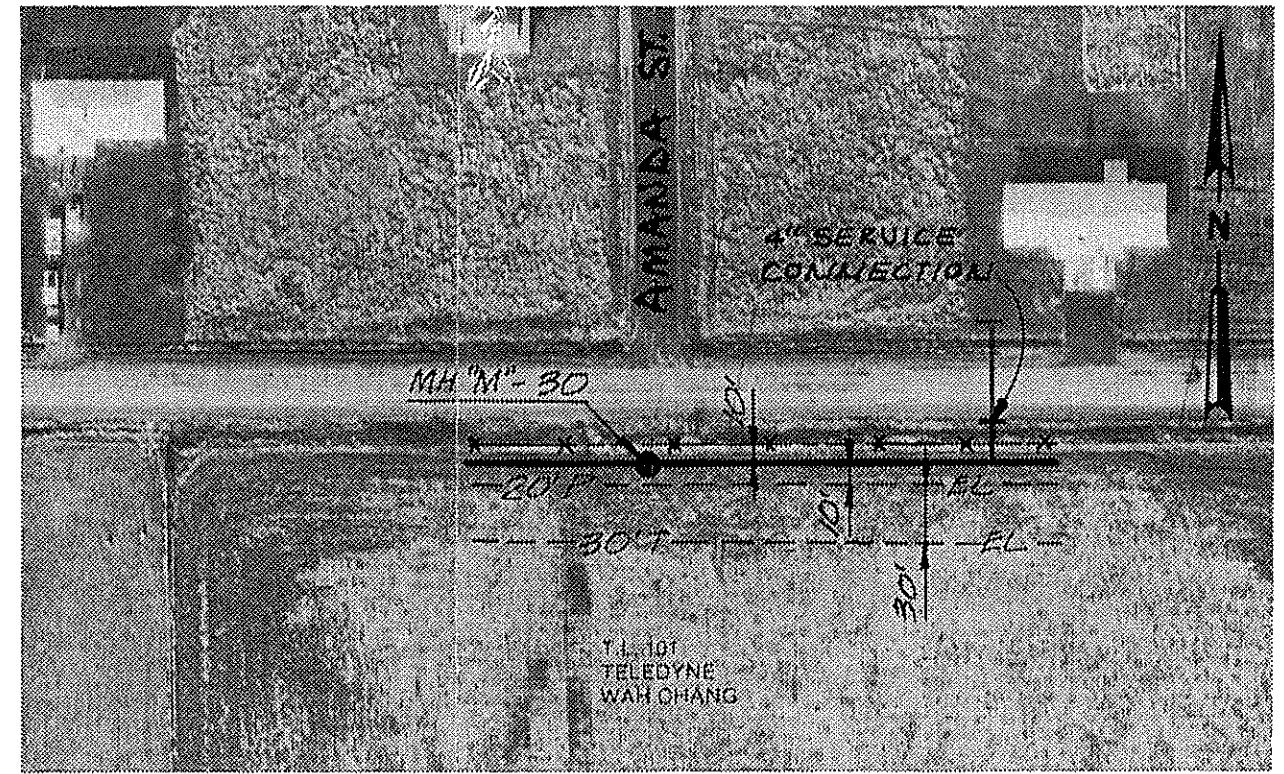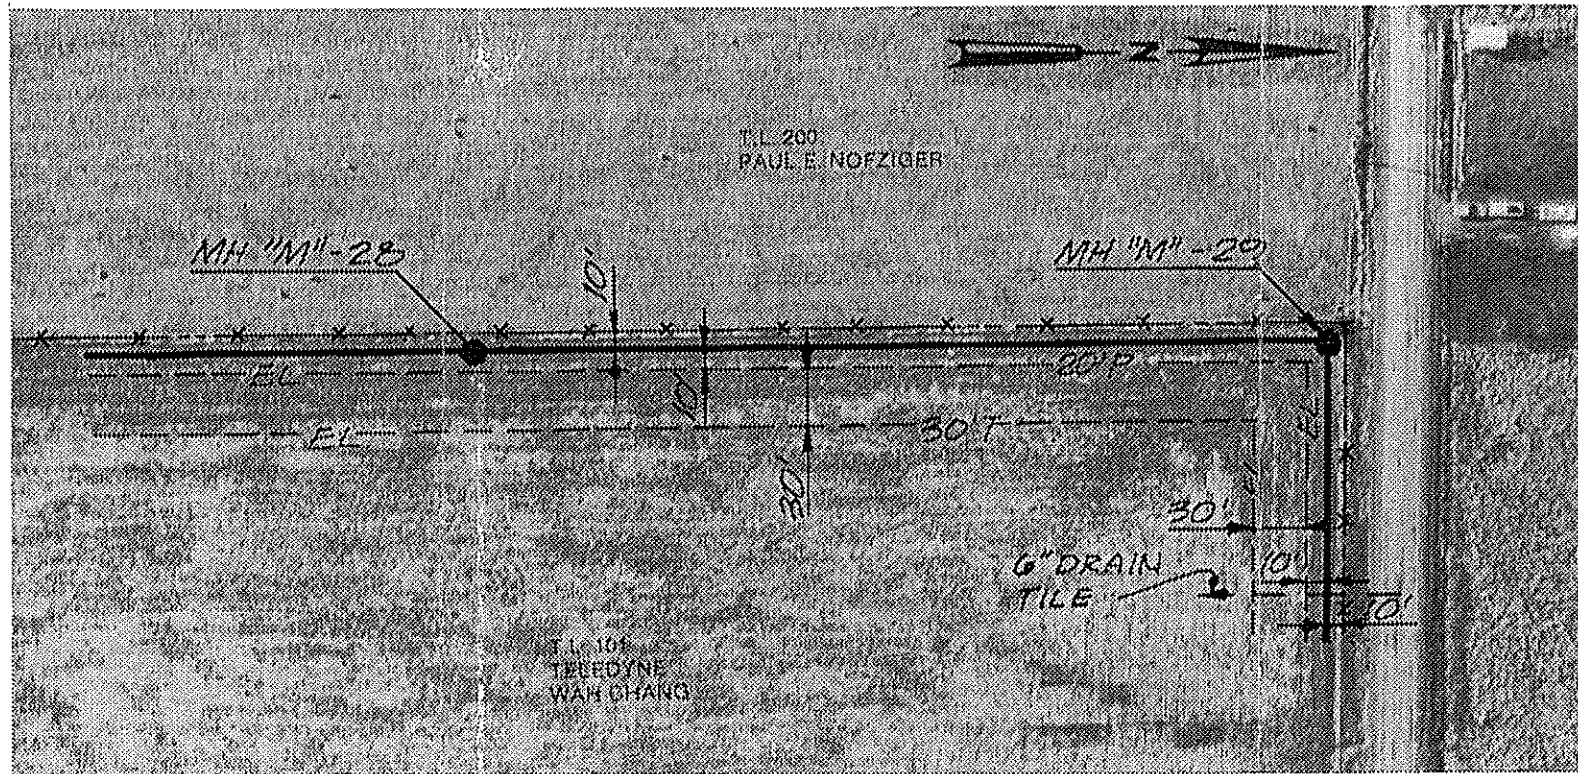


CH2M HILL	DES. <i>TAB</i>	11/82	RECORD DWG	JLM	BY	APPD.
	DR. <i>GPG</i>					
	CHK. <i>DAC</i>					
	APPD. <i>DAC</i>					

SANITARY SEWAGE COLLECTION SYSTEM
CONTRACT NO 2

CITY OF MILLERSBURG
LINN COUNTY, OREGON


MILLERSBURG TRUNK SEWER
"M" LINE
PLAN AND PROFILE
STA 37+00 TO STA 48+00

SHEET 5
OF 12
DATE JUNE 82
DWG. NO. E16089 A1

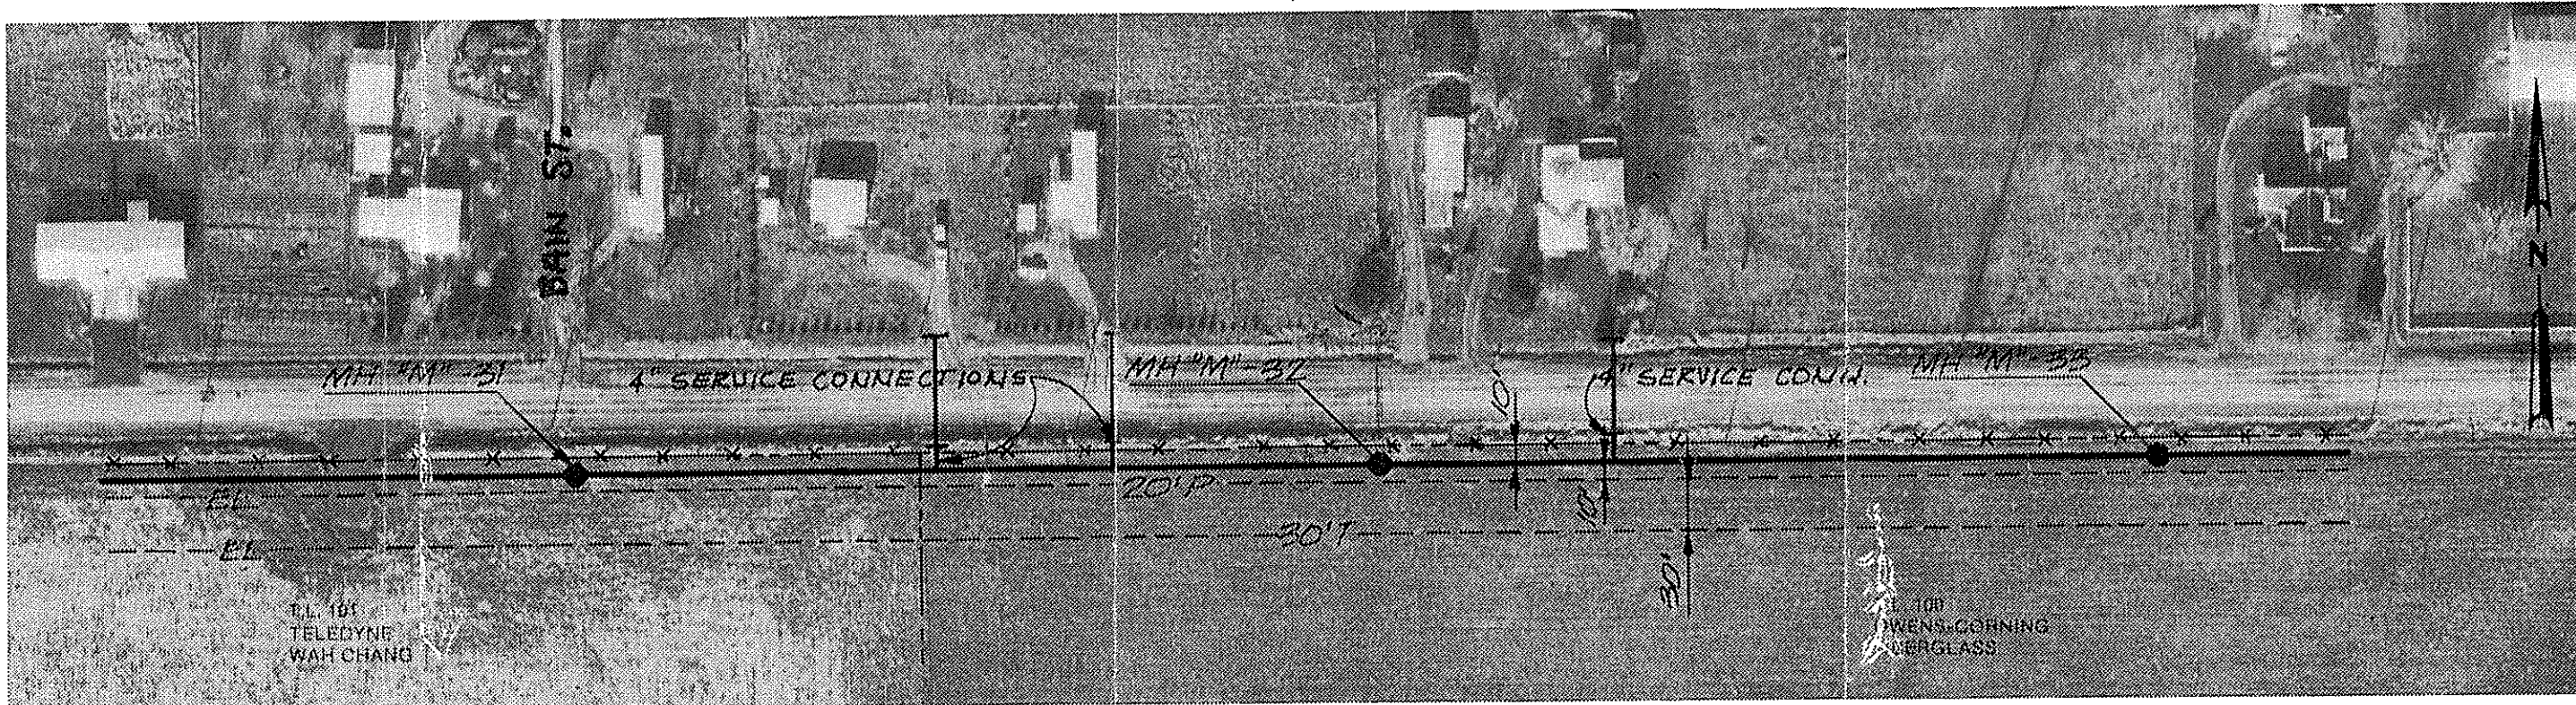

T.L. 101
TELEDYNE
WAH CHANG

T.L. 100
DRENS. CORNING
BERGGLASS

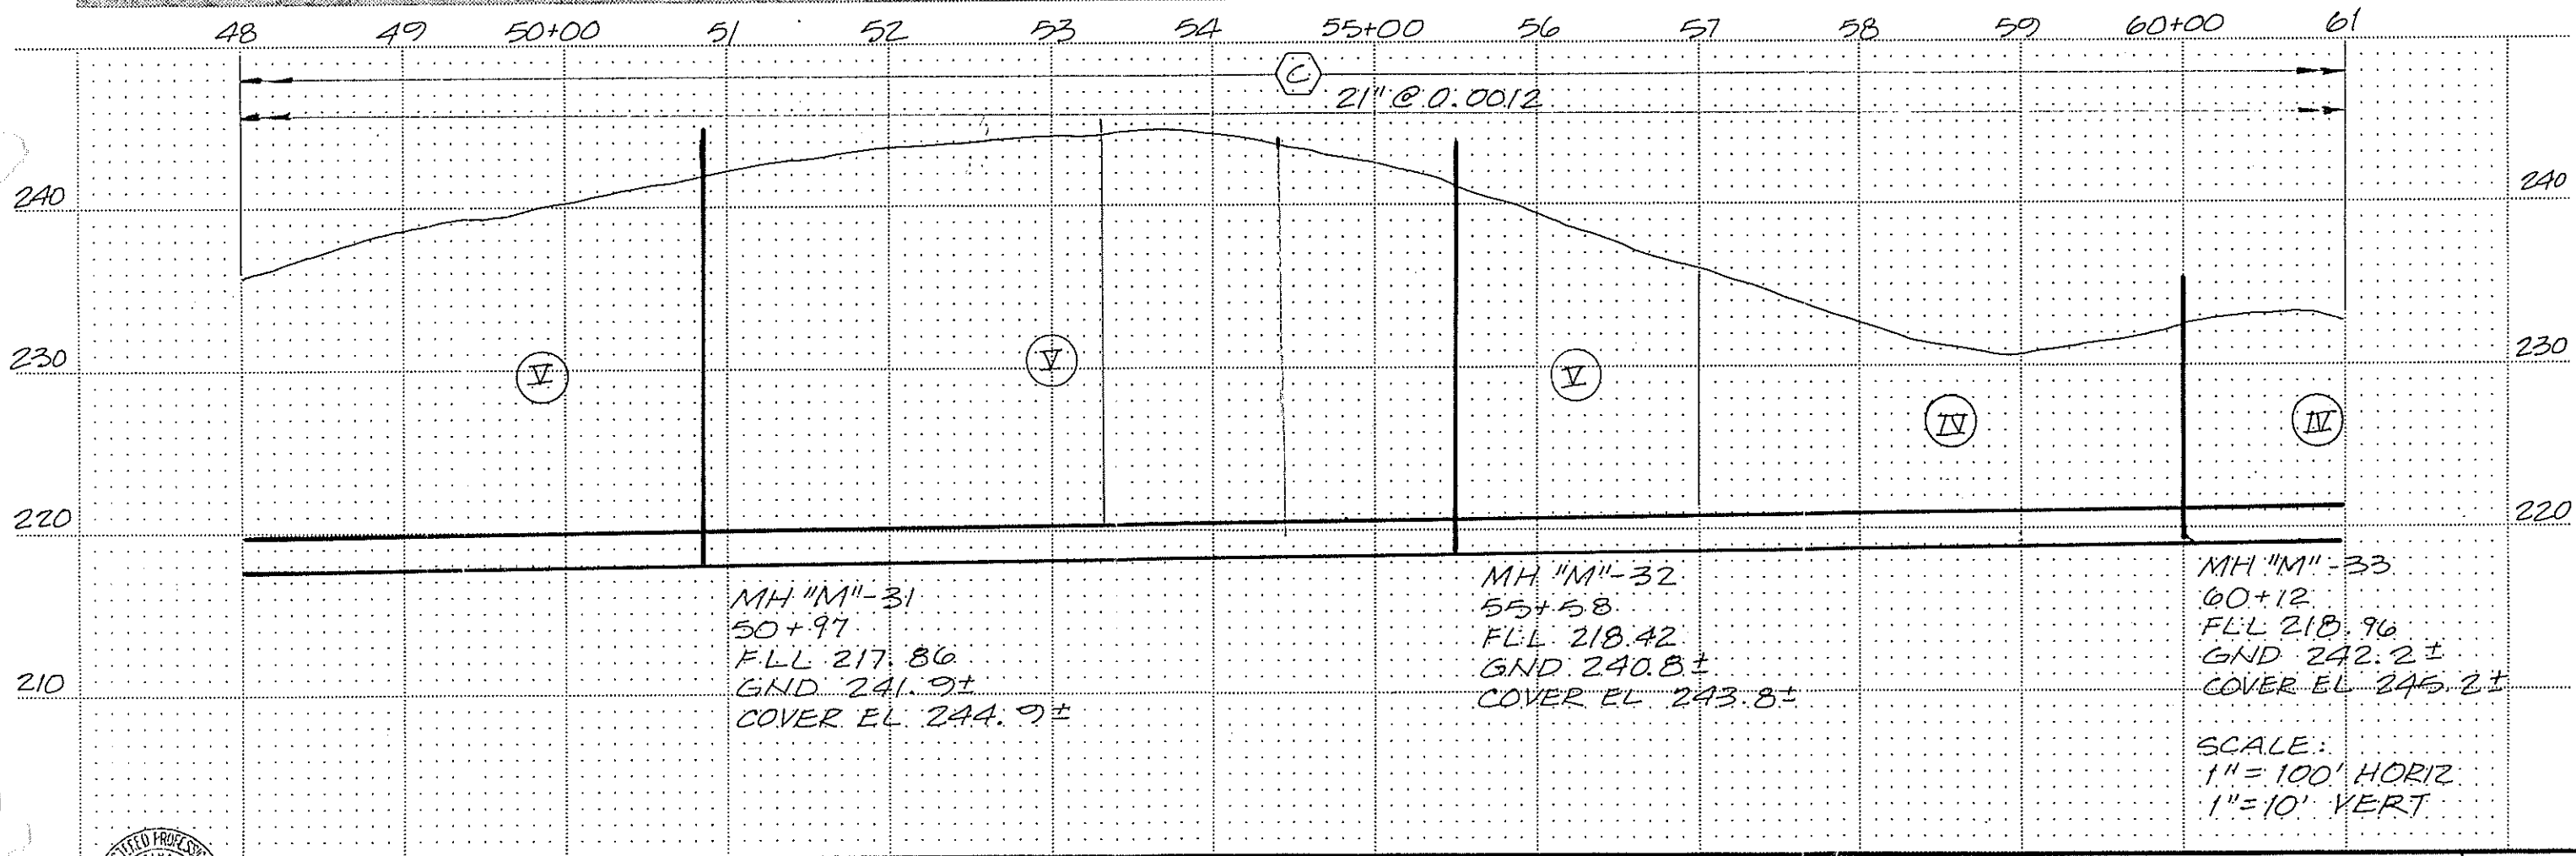



CH2M HILL	DES. TAB	11/82	RECORD DWG	JLM	BY	APPD.
	DR. GPG					
	CHK. DAC	NO.	DATE	REVISION		
	APPD. DAC					

SANITARY SEWAGE COLLECTION SYSTEM
CONTRACT NO. 2

CITY OF MILLERSBURG
LINN COUNTY, OREGON

MILLERSBURG TRUNK SEWER
"M" LINE
PLAN AND PROFILE
STA 48+00 TO STA 61+00

SHEET 6
OF
DATE JUNE 82
DWG. E16089 A1

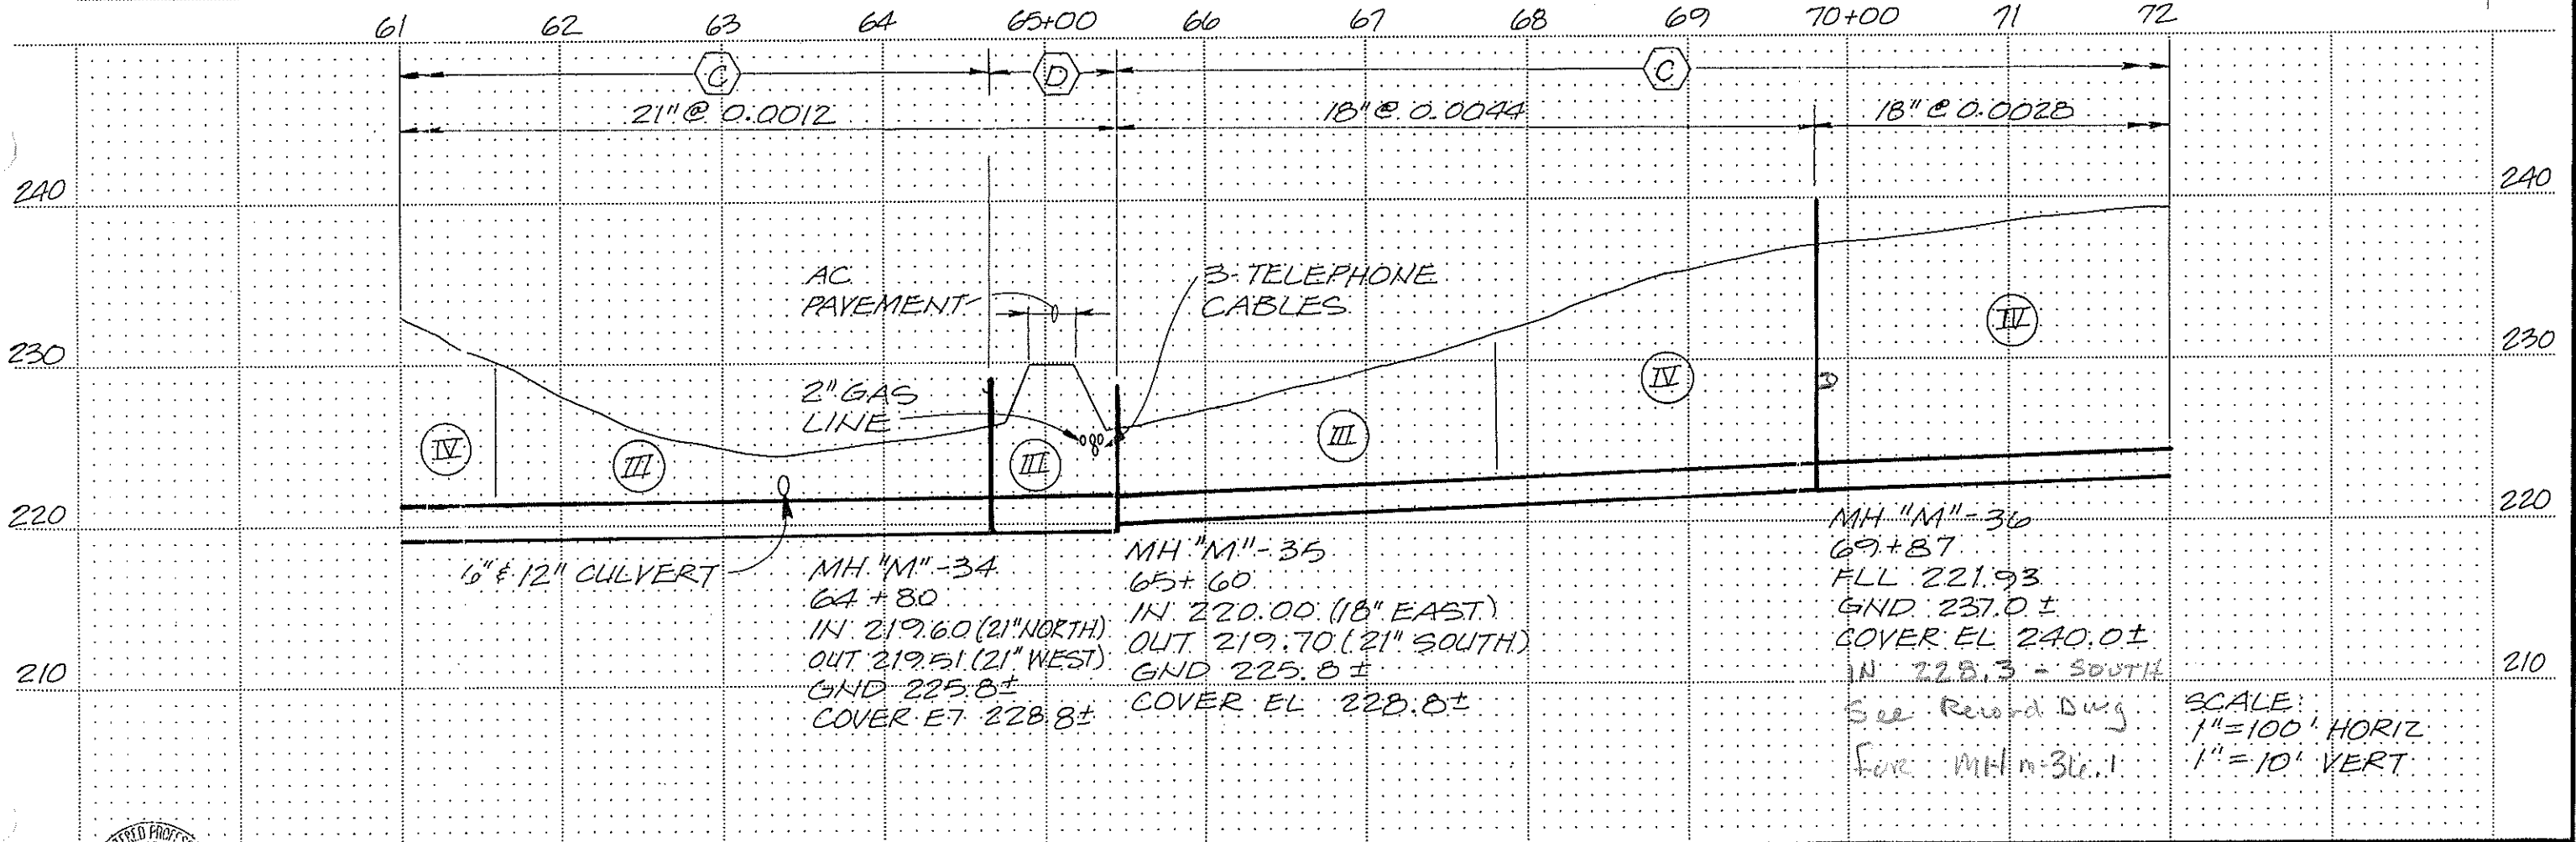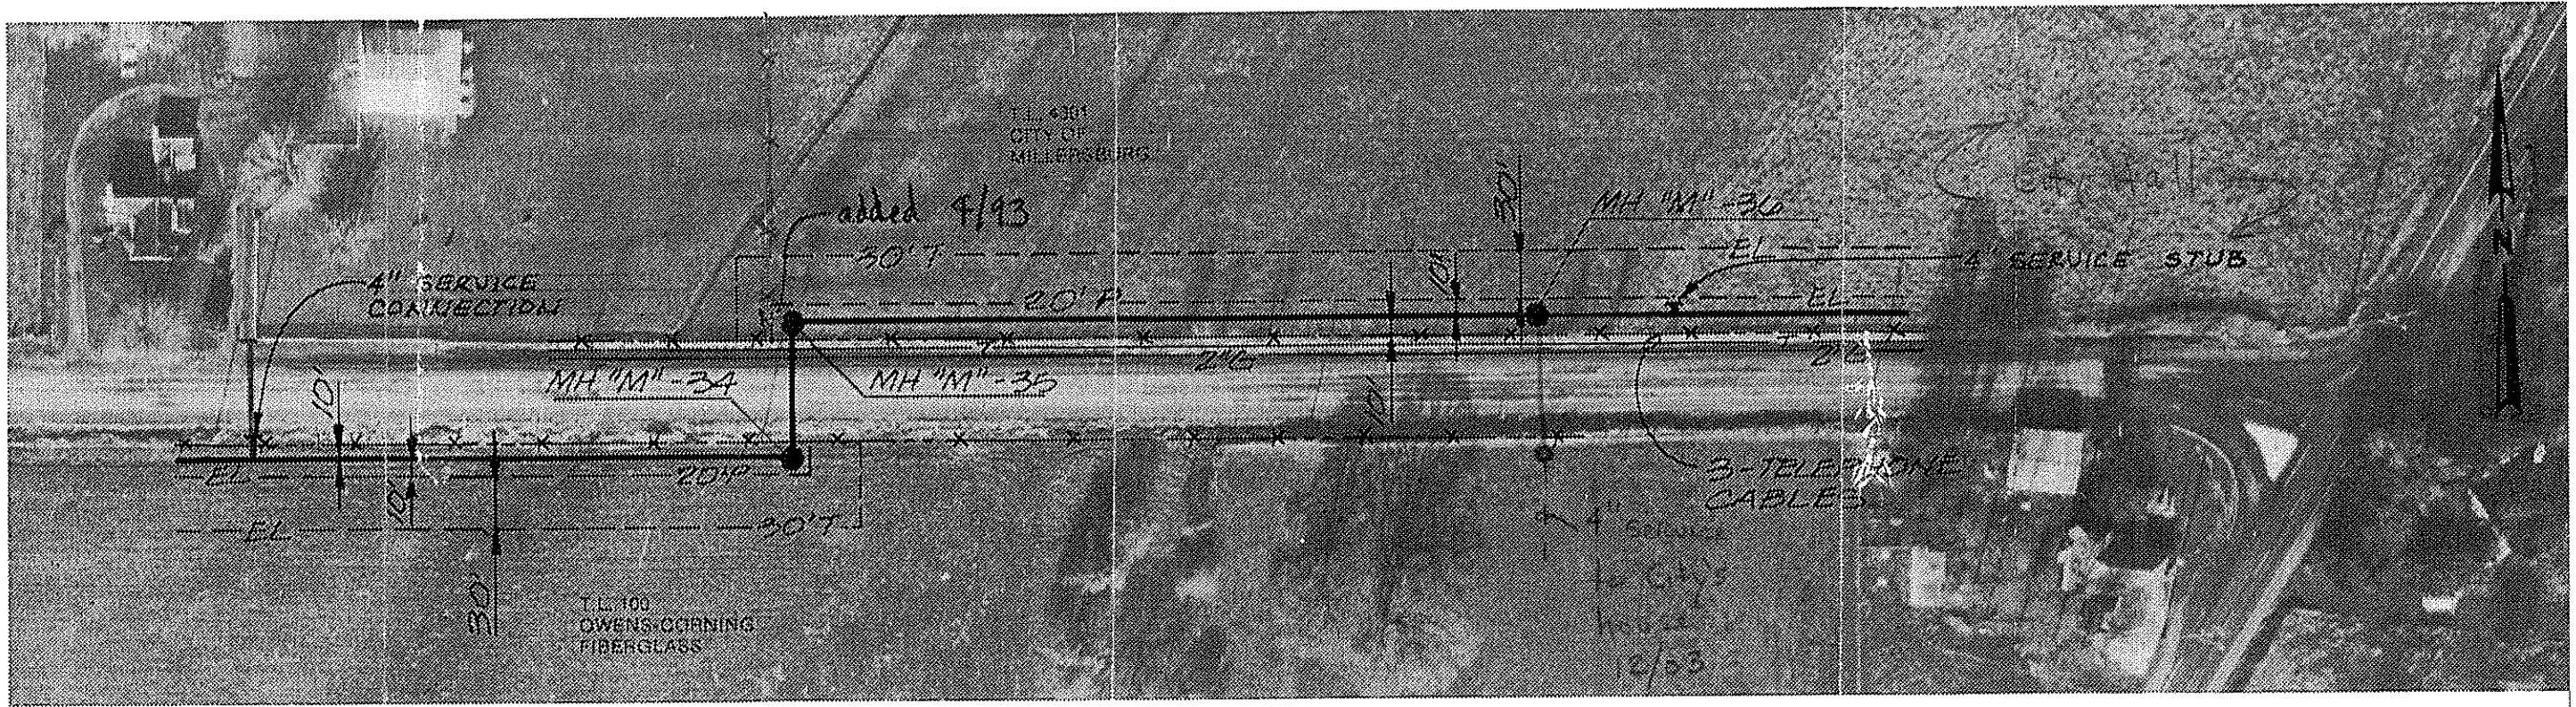

MH "M"-34
 64+80
 IN. 219.60 (21" NORTH)
 OUT. 219.51 (21" WEST)
 GND. 225.8 ±
 COVER EL. 228.8 ±

MH "M"-35
 65+60
 IN. 220.00 (18" EAST)
 OUT. 219.70 (21" SOUTH)
 GND. 225.8 ±
 COVER EL. 228.8 ±

MH "M"-36
 69+87
 FLL 221.93
 GND. 237.0 ±
 COVER EL. 240.0 ±
 IN. 228.3 - SOUTH
 See Record Dwg
 For: MH "M"-36.1

SCALE:
 1" = 100' HORIZ
 1" = 10' VERT





CH2M HILL DES. TAB DR. GPG CHK. DAC APPD. DAC	NO.	DATE	REVISION	BY	APPD.
		11/82	RECORD DWG	JLM	

SANITARY SEWAGE COLLECTION SYSTEM
 CONTRACT NO 2

CITY OF MILLERSBURG
 LINN COUNTY, OREGON

MILLERSBURG TRUNK SEWER
 "M" LINE
 PLAN AND PROFILE
 STA 6+00 TO STA 72+00


SHEET 7
 OF 12
 DATE JUNE 82
 DWG. NO. E16089 A1

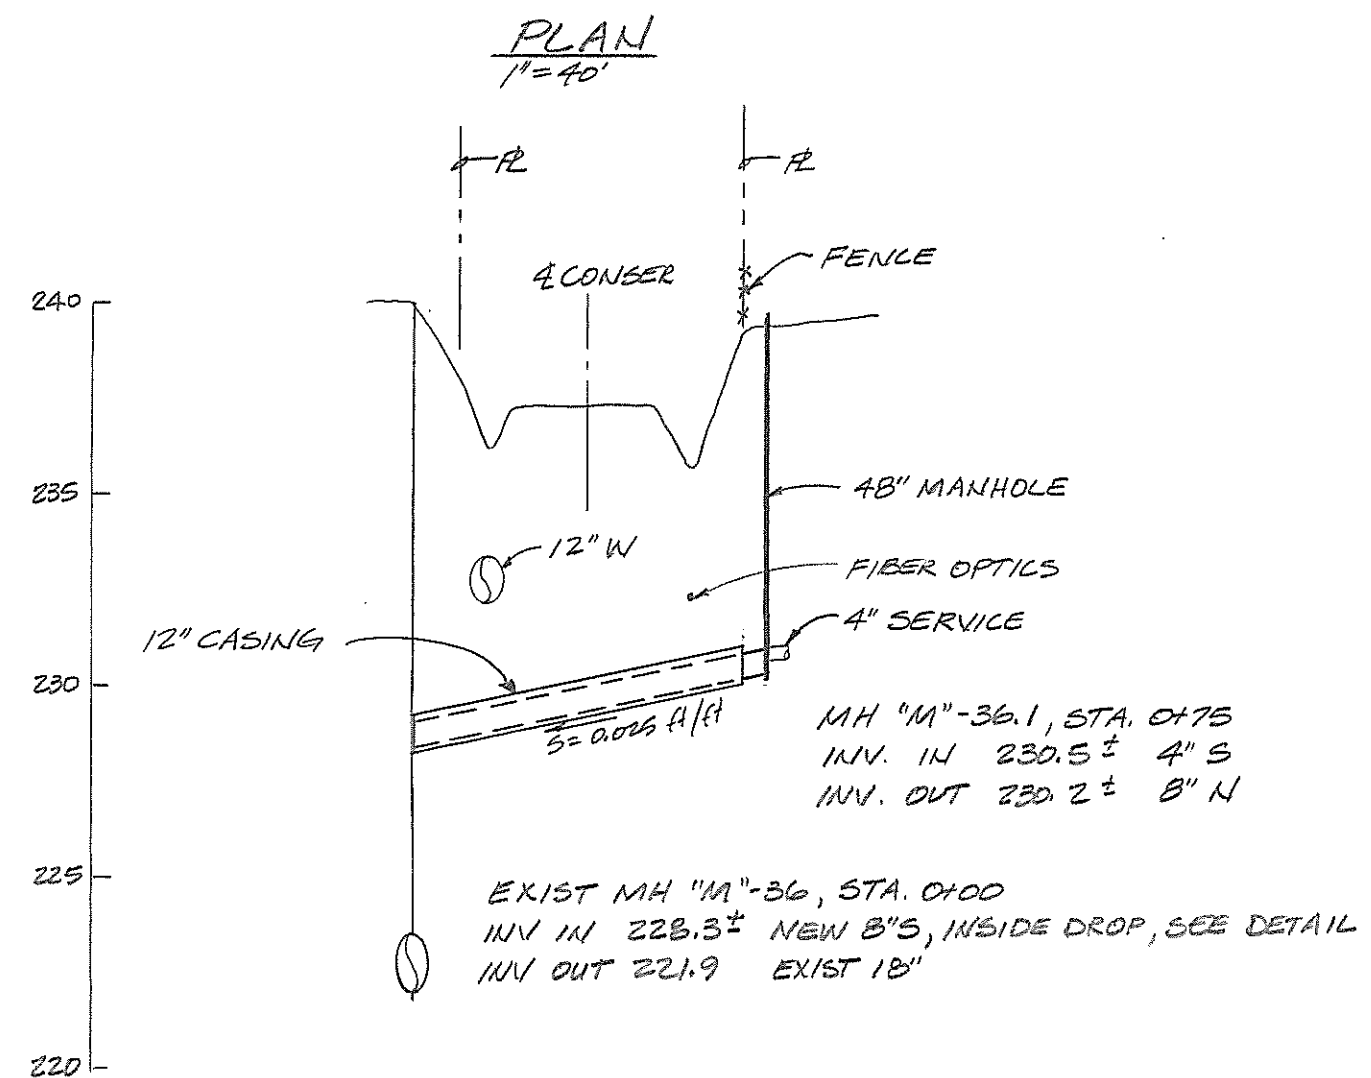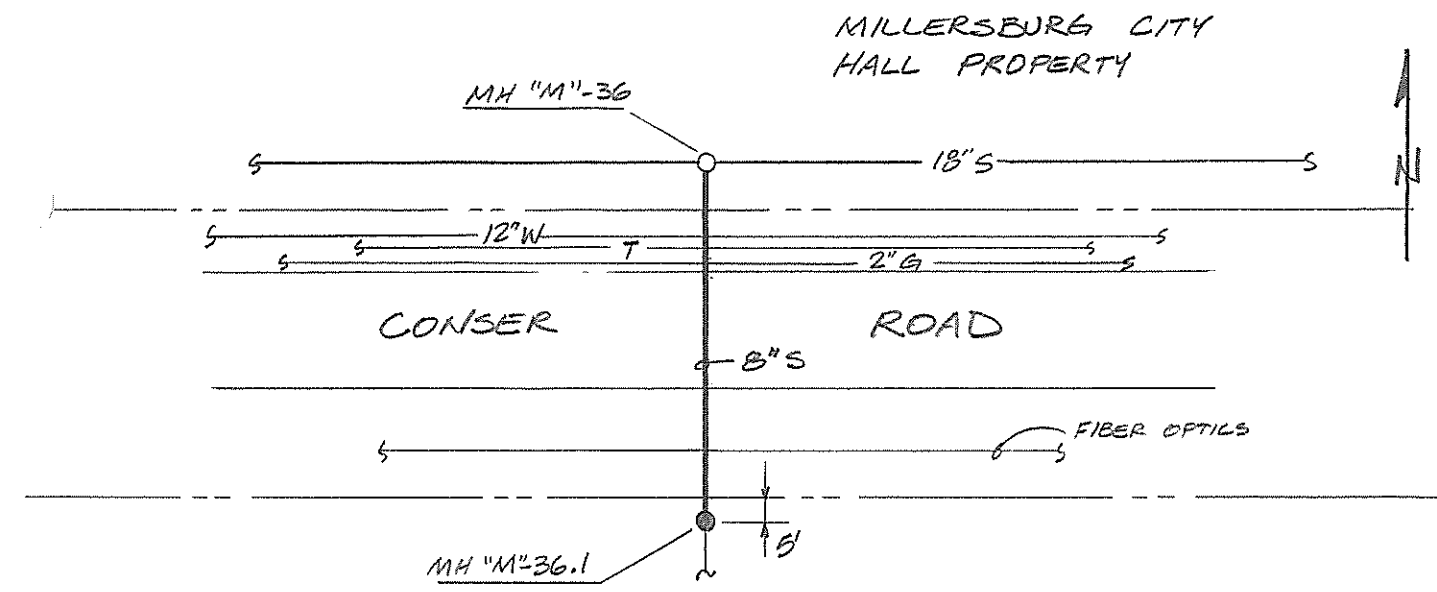



PROFILE
1" = 40' HORIZ
1" = 5' VERT

**CONSER ROAD
CROSSING**
 CITY OF MILLERSBURG
 MILLERSBURG, OREGON

RECORD DRAWING, DEC. 2003

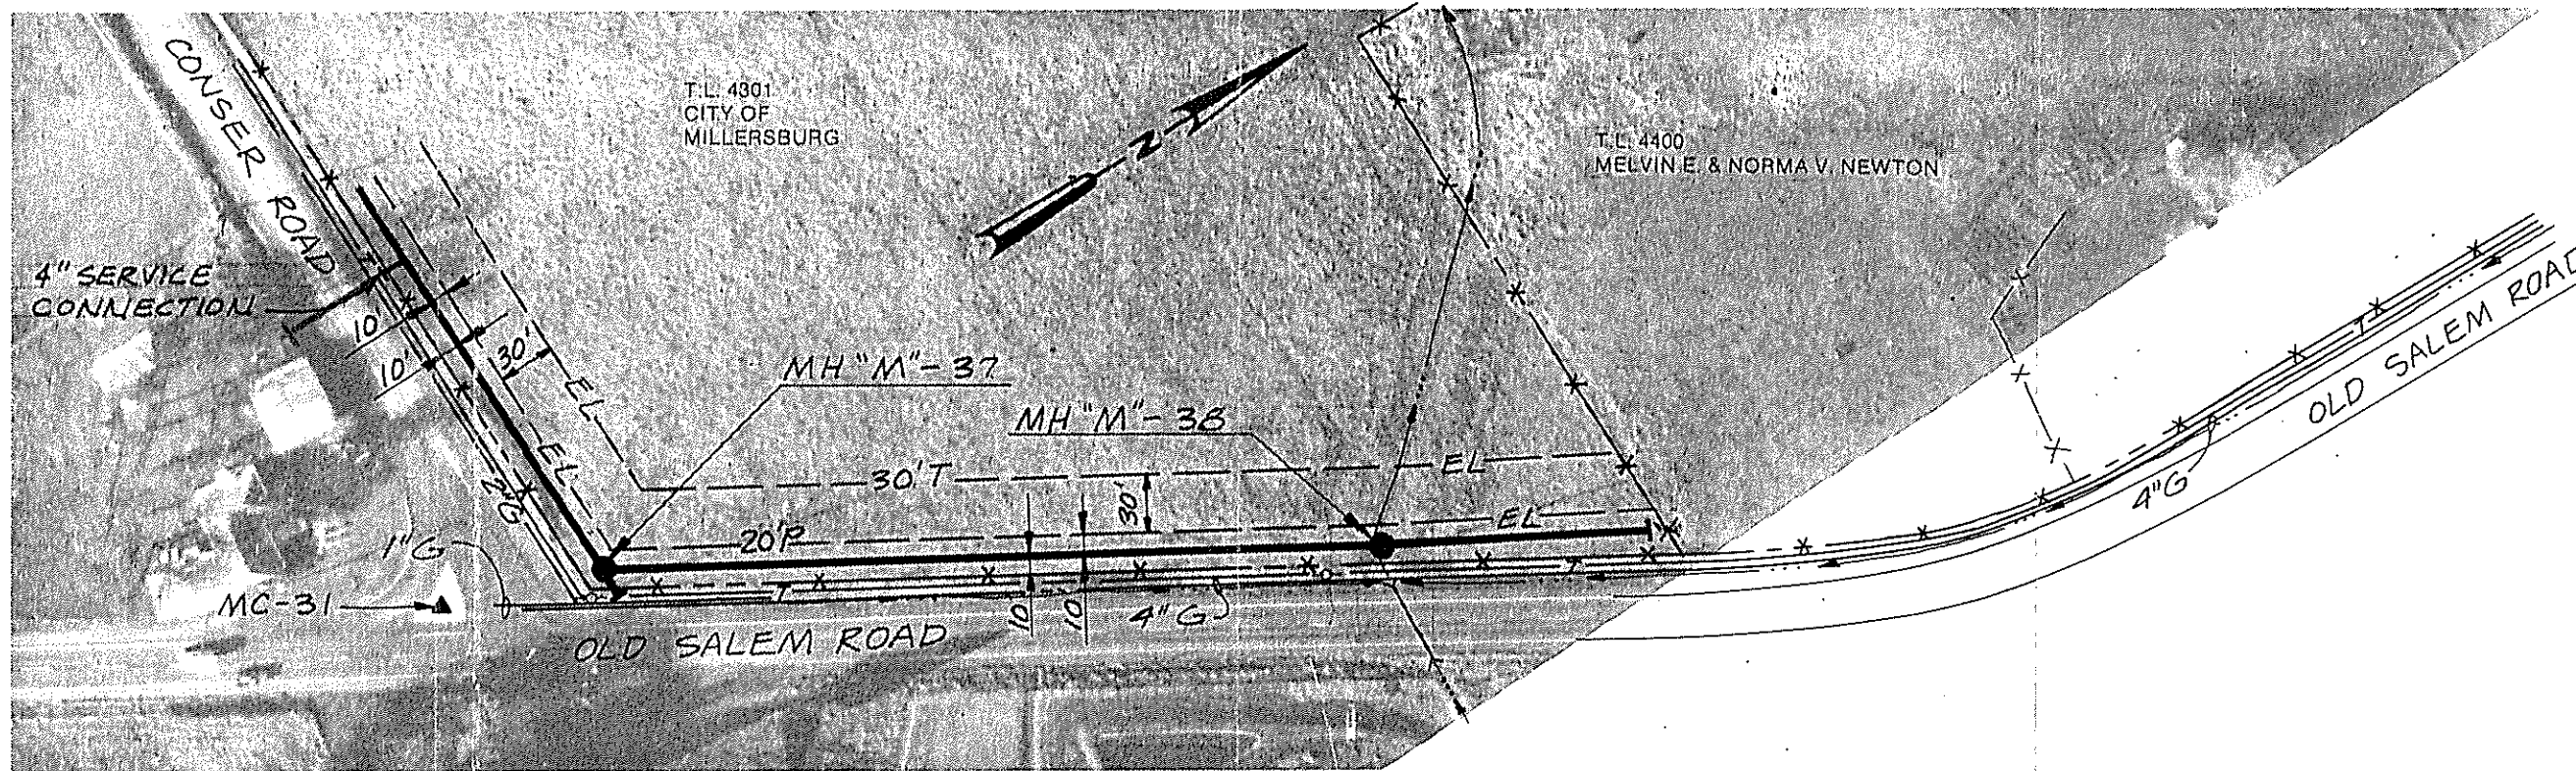

72 73 74 75+00 76 77 78 79 80+00

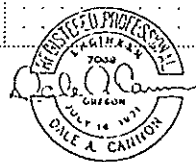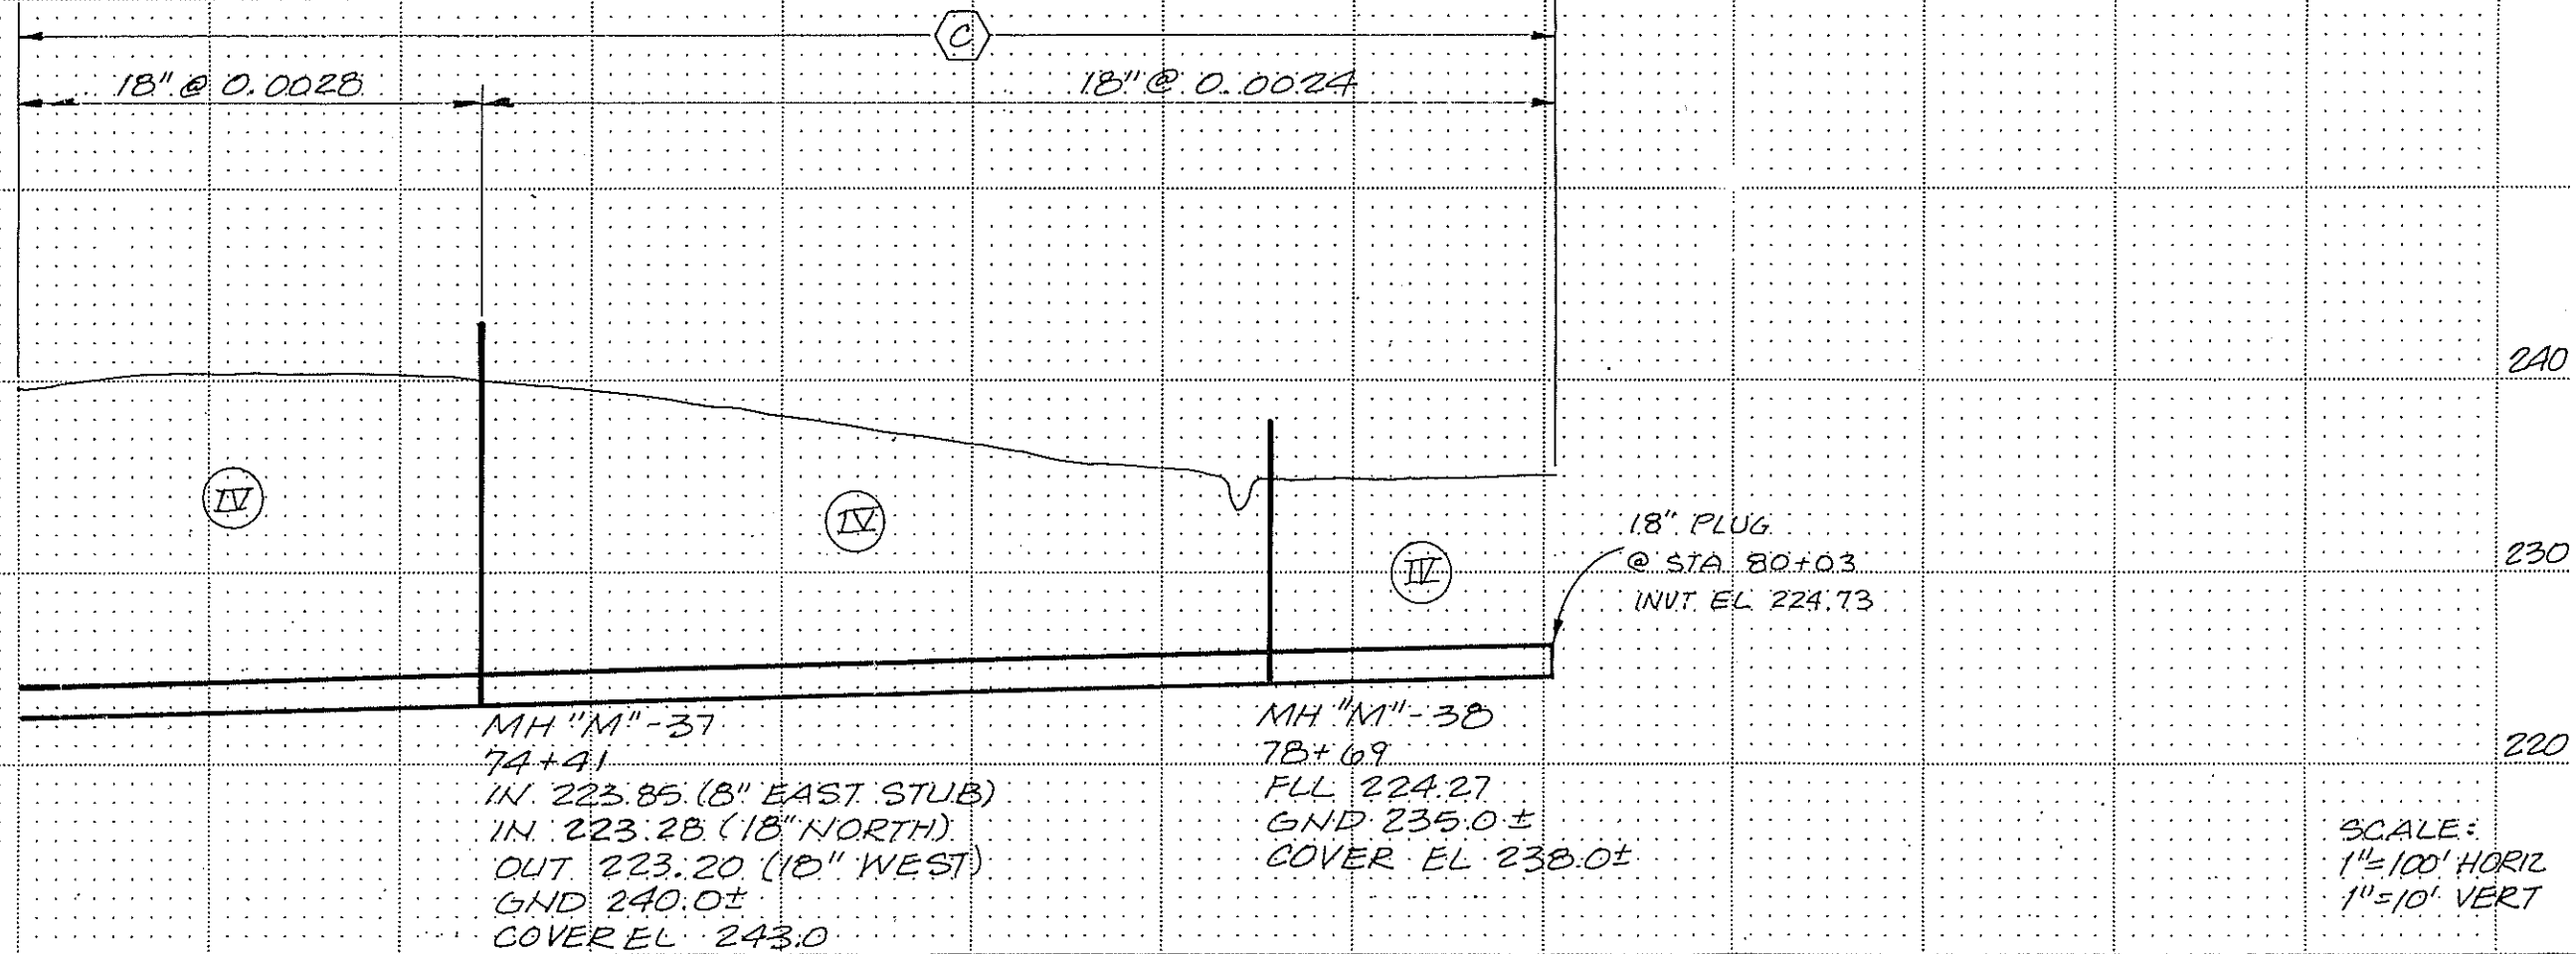

CH2M HILL	DES. CR3	11/82	RECORD DWG	JLM	BY	APPD.
	DR. CR3					
	CHK. DAC					
	APPD. DAC					
NO.	DATE	REVISION				


SANITARY SEWAGE COLLECTION SYSTEM
CONTRACT NO 2

CITY OF MILLERSBURG
LINN COUNTY, OREGON

MILLERSBURG TRUNK SEWER
"M" LINE
PLAN AND PROFILE
STA 72+00 TO STA 80+03

SHEET 8
OF 12
DATE JUNE 82
DWG. NO. E16089 A1


4. City of Millersburg Sanitary Sewer Collection System Contract 3

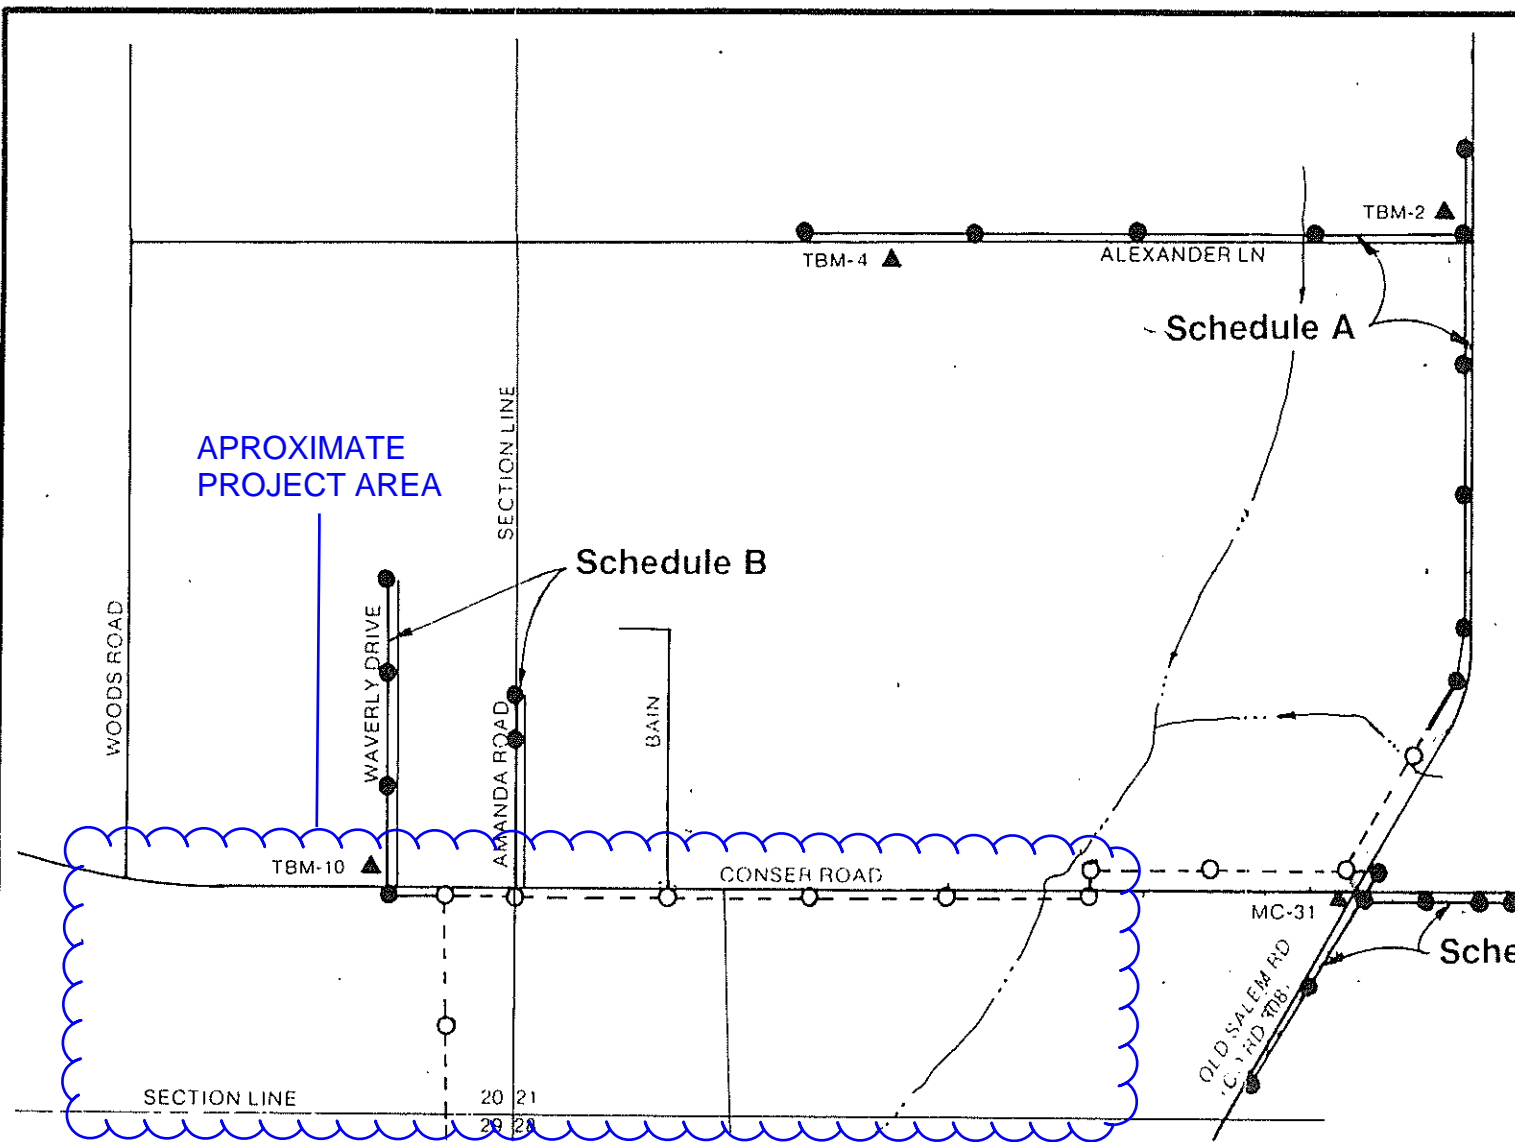

- ### LEGEND
- NEW**
- MH "M" 6 MANHOLE DESIGNATION
 - GRAVITY SEWER WITH MANHOLE
 - BACKFILL CLASSIFICATION
 - 8" P.O. 0.04 SIZE AND SLOPE OF PIPE (8" PIPE AT 0.0040 FT/FT)
 - IV ASTM C-76, CLASS III OR IV OR ASTM C-14, CLASS 2 OR 3 AS NOTED
- EXISTING**
- SANITARY SEWER WITH MANHOLE
 - STORM SEWER WITH CATCH BASIN AND MANHOLE
 - 12" IRR IRRIGATION PIPELINE
 - 8" W-W WATER PIPELINE WITH FIRE HYDRANT AND VALVE
 - 2" G GAS PIPELINE
 - P UNDERGROUND POWER CABLE
 - T UNDERGROUND TELEPHONE CABLE
 - TV UNDERGROUND TELEVISION CABLE
 - 12" CMP CULVERT (SIZE AND TYPE INDICATED)

- GENERAL**
- RIGHT-OF-WAY AND OR PROPERTY LINE
 - T L 4400 TAX LOT NUMBER
 - EL EASEMENT LINE
 - 20 P WIDTH OF PERMANENT EASEMENT
 - 30 T WIDTH OF TEMPORARY EASEMENT
 - BM-1 BENCH MARK LOCATION AND NUMBER
 - DITCH SHOWING DIRECTION OF FLOW

- ABBREVIATIONS LEGEND**
- EL ELEVATION
 - FLL FLOW LINE LEVEL
 - GND GROUND
 - IF INVERT ELEVATION
 - MH MANHOLE

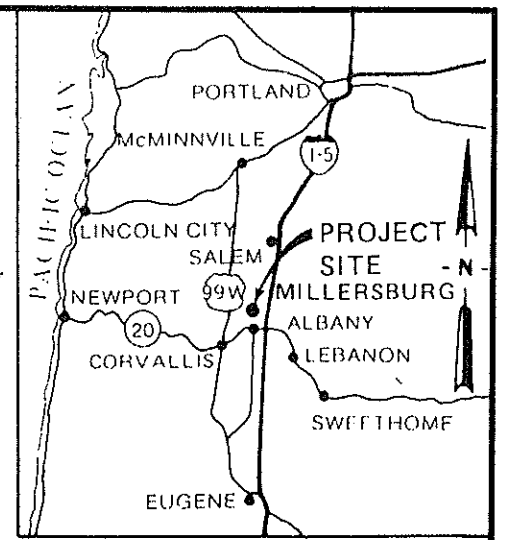

VICINITY MAP

BENCHMARK DESCRIPTION

TBM NO.	USC & GS ELEVATION	DESCRIPTION AND LOCATION
MC-31	242.36	NAIL AND SHINER IN CENTER OF RAISED ISLAND OF OLD SALEM ROAD AND CONSER ROAD
TBM-2	236.81	RAILROAD SPIKE IN SOUTH SIDE OF POWER POLE AT THE NORTHWEST CORNER OF THE INTERSECTION AT OLD SALEM ROAD AND ALEXANDER LANE
TBM-4	249.60	RAILROAD SPIKE IN NORTH SIDE OF POWER POLE AT SOUTH SIDE OF ALEXANDER LANE, TOP OF RISE IN FRONT OF PARK, 0.3 MILES WEST OF OLD SALEM ROAD
TBM-10	238.85	RAILROAD SPIKE IN EAST SIDE OF POWER POLE AT THE NORTHWEST CORNER OF THE INTERSECTION OF CONSER ROAD AND WAVERLY DRIVE

INDEX TO DRAWINGS

SHEET NO.	TITLE
MILLERSBURG TRUNK SEWER "M" LINE	SCHEDULE A
2	PLAN AND PROFILE - STA 0+00 TO STA 8+00
3	PLAN AND PROFILE - STA 8+00 TO STA 20+00
MILLERSBURG SEWER "MG" LINE	SCHEDULE A
4	PLAN AND PROFILE - STA 0+00 TO STA 13+00
5	PLAN AND PROFILE - STA 13+00 TO STA 17+50
MILLERSBURG SEWER "MC" LINE	SCHEDULE B
6	PLAN AND PROFILE - STA 0+00 TO STA 12+70
MILLERSBURG SEWER "MD" LINE	SCHEDULE B
7	PLAN AND PROFILE - STA 0+00 TO STA 6+81
MILLERSBURG SEWER "MF" LINE	SCHEDULE B
8	PLAN AND PROFILE - STA 0+00 TO STA 3+93
MILLERSBURG SEWER "MFA" LINE	SCHEDULE B
9	PLAN AND PROFILE - STA 0+00 TO STA 12+75
MISCELLANEOUS DETAILS	SCHEDULE A & B
10	MANHOLE DETAILS
11	MANHOLE DETAILS
12	PIPELINE, TRENCH AND SURFACING DETAILS
13	SERVICE CONNECTION DETAILS

LOCATION MAP



NTS

TOWNSHIP 10 SOUTH
RANGE 3 WEST
WILLAMETTE MERIDIAN





DES	TMG				
DR	JLM				
CHK	DAC	12/83	RECORD DWG.	JLM	
APPD	TMG	NO	DATE	REVISION	BY APPD

SANITARY SEWAGE COLLECTION SYSTEM
SCHEDULE A & B CONTRACT NO 3


CITY OF MILLERSBURG
LINN COUNTY, OREGON

VICINITY MAP; LOCATION MAP,
BENCHMARK DESCRIPTIONS
INDEX TO DRAWINGS AND LEGEND

SHEET	1
OF	13
DATE	DEC 82
DWG. NO.	E16523 A1

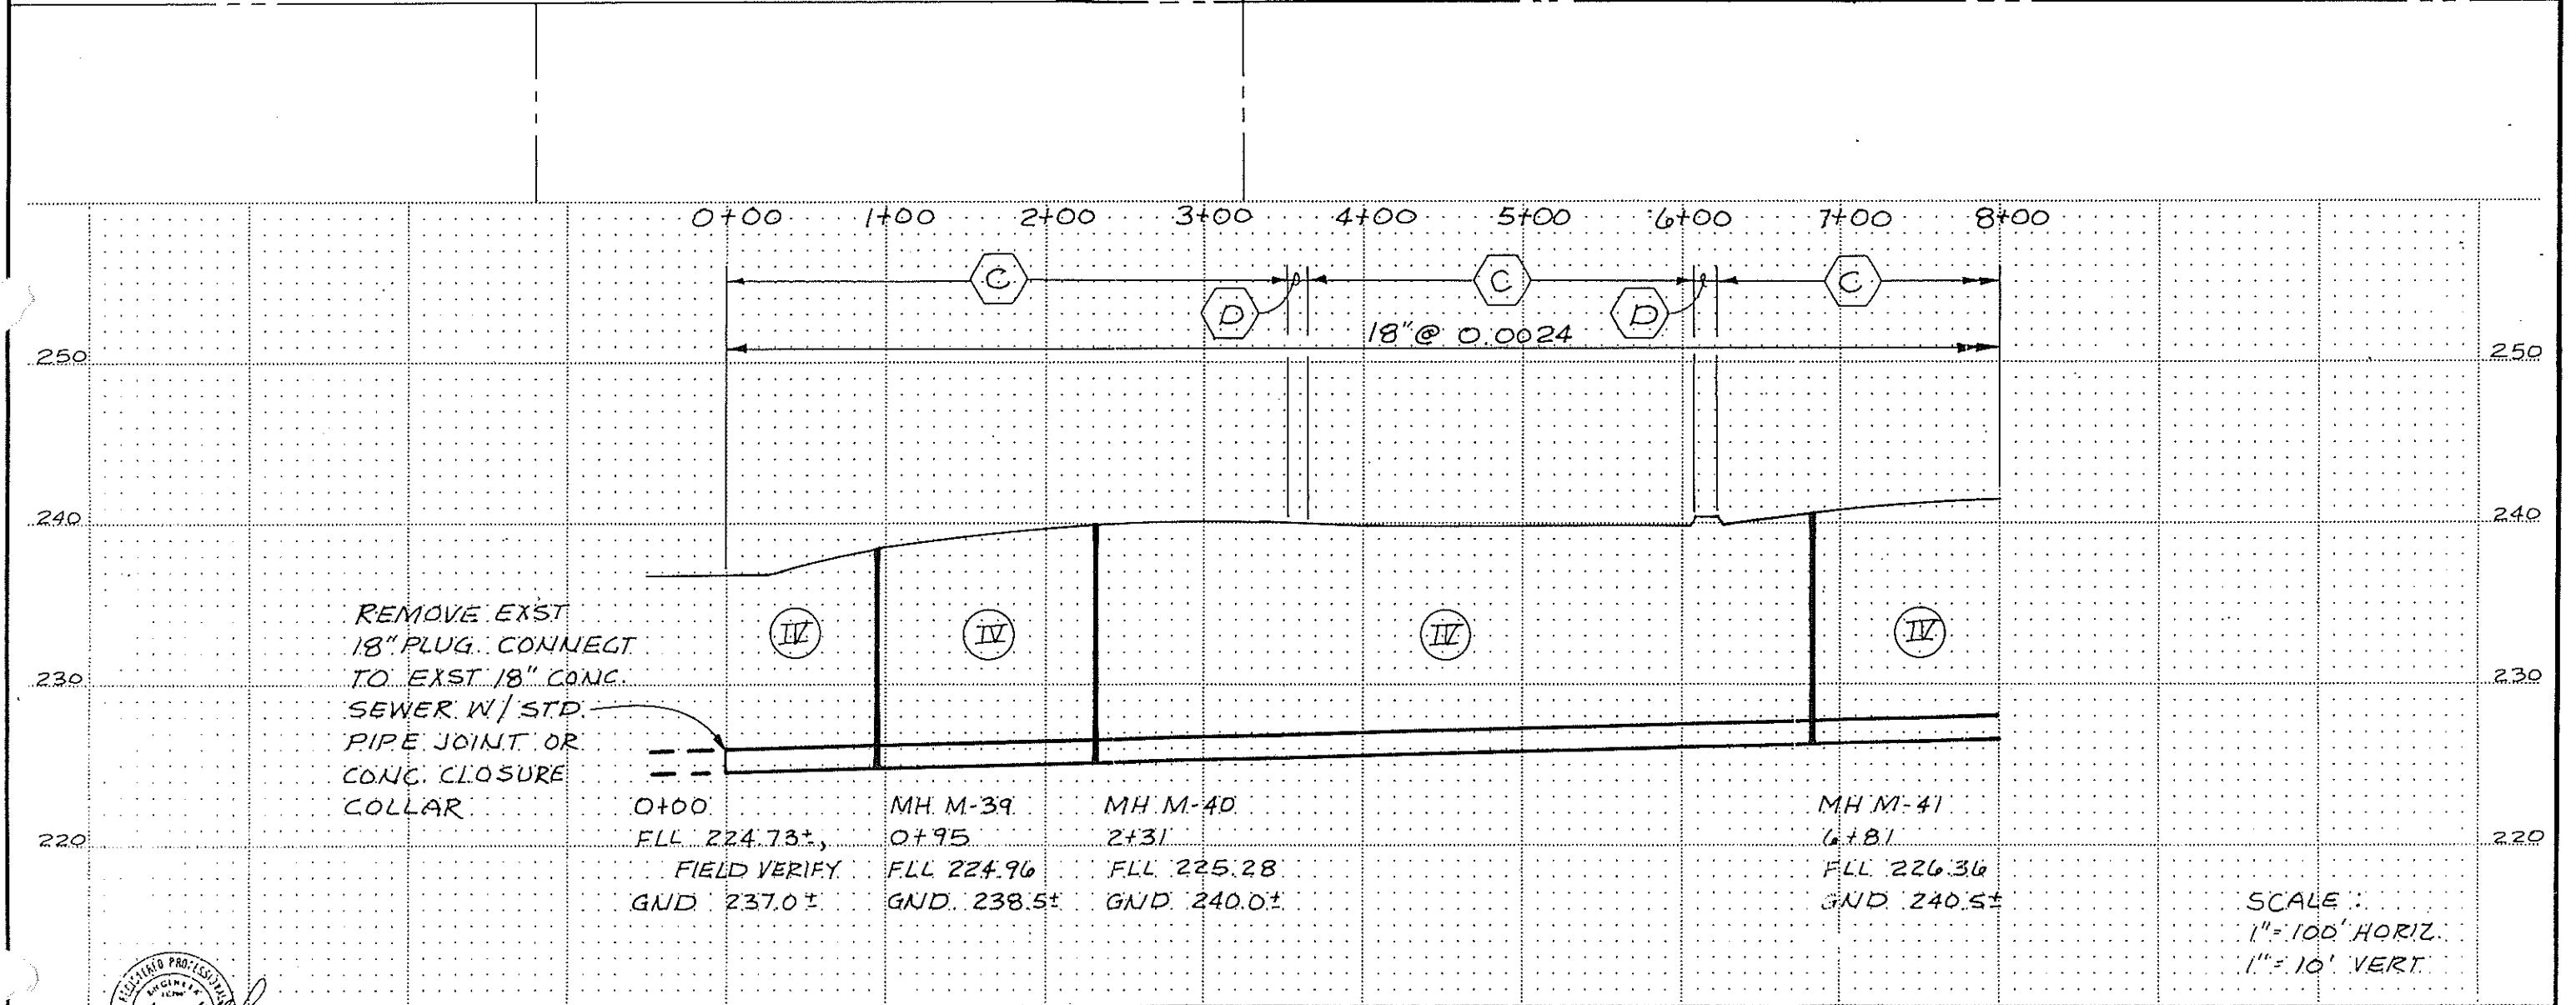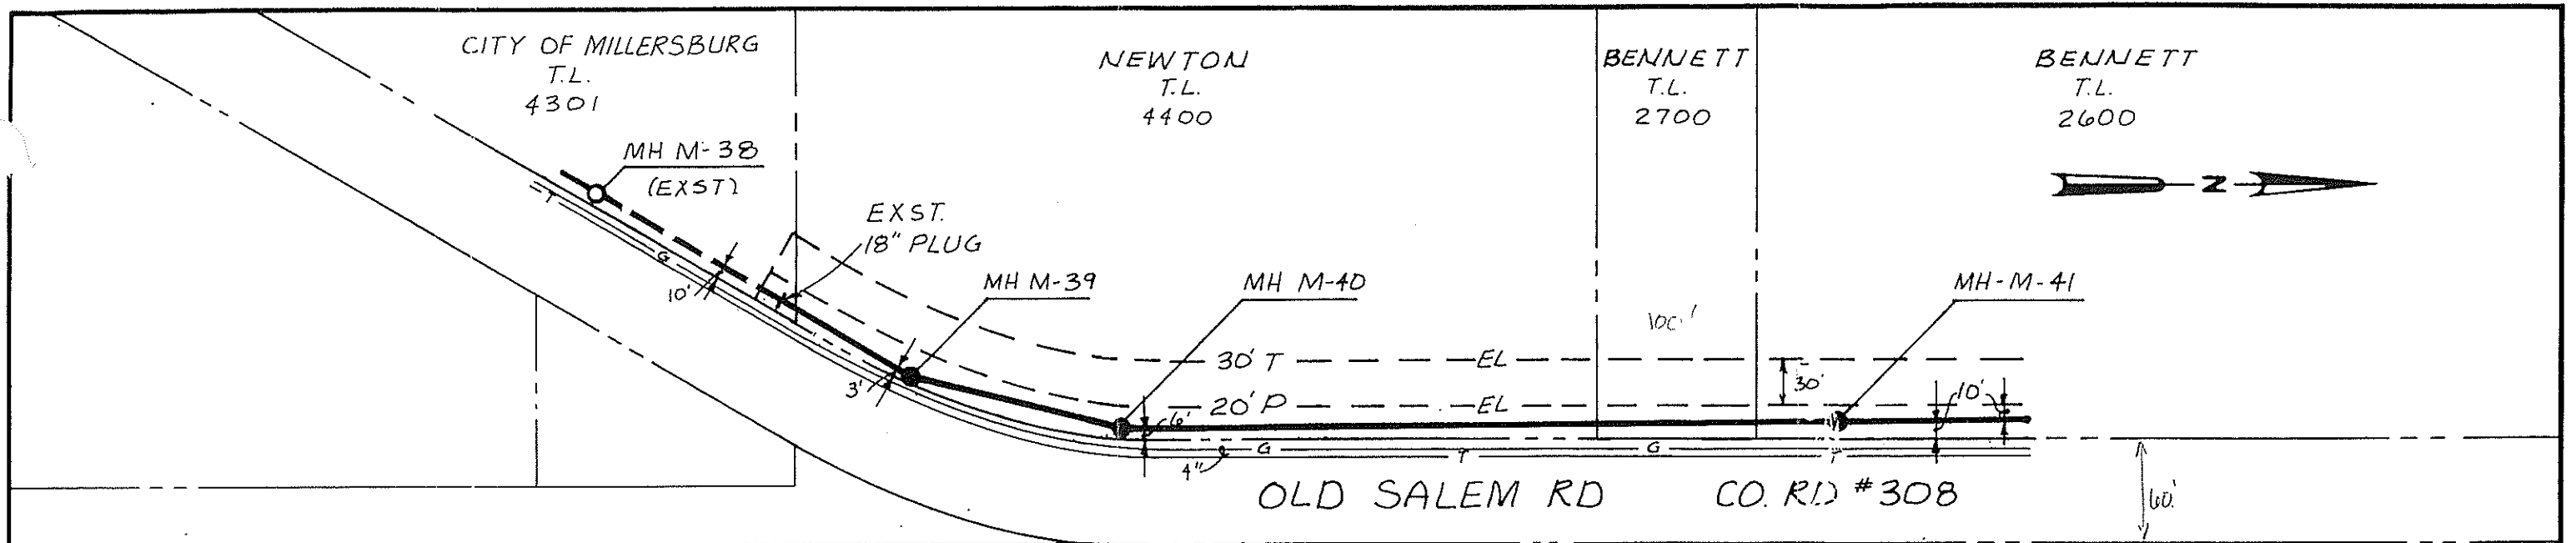

CH2M HILL DES. JLM DR. JLM CHK. DAC APPD. TMG	NO.	DATE	REVISION	BY	APPD.	SANITARY SEWAGE COLLECTION SYSTEM SCHEDULE A CONTRACT NO 3	CITY OF MILLERSBURG LINN COUNTY, OREGON	MILLERSBURG TRUNK SEWER "M" LINE PLAN AND PROFILE STA 0+00 TO STA 8+00	SHEET 2
	12/83		RECORD DWG	JLM					OF 1.3
								DATE DEC 82	DWG. E16523 A1

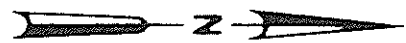

BENNETT
T.L.
2600



CASTILLO
T.L.
2900

ALEXANDER LN.


1" HEYNE
T.L.
2300

CURL
T.L.
2200

CURL
T.L.
2100

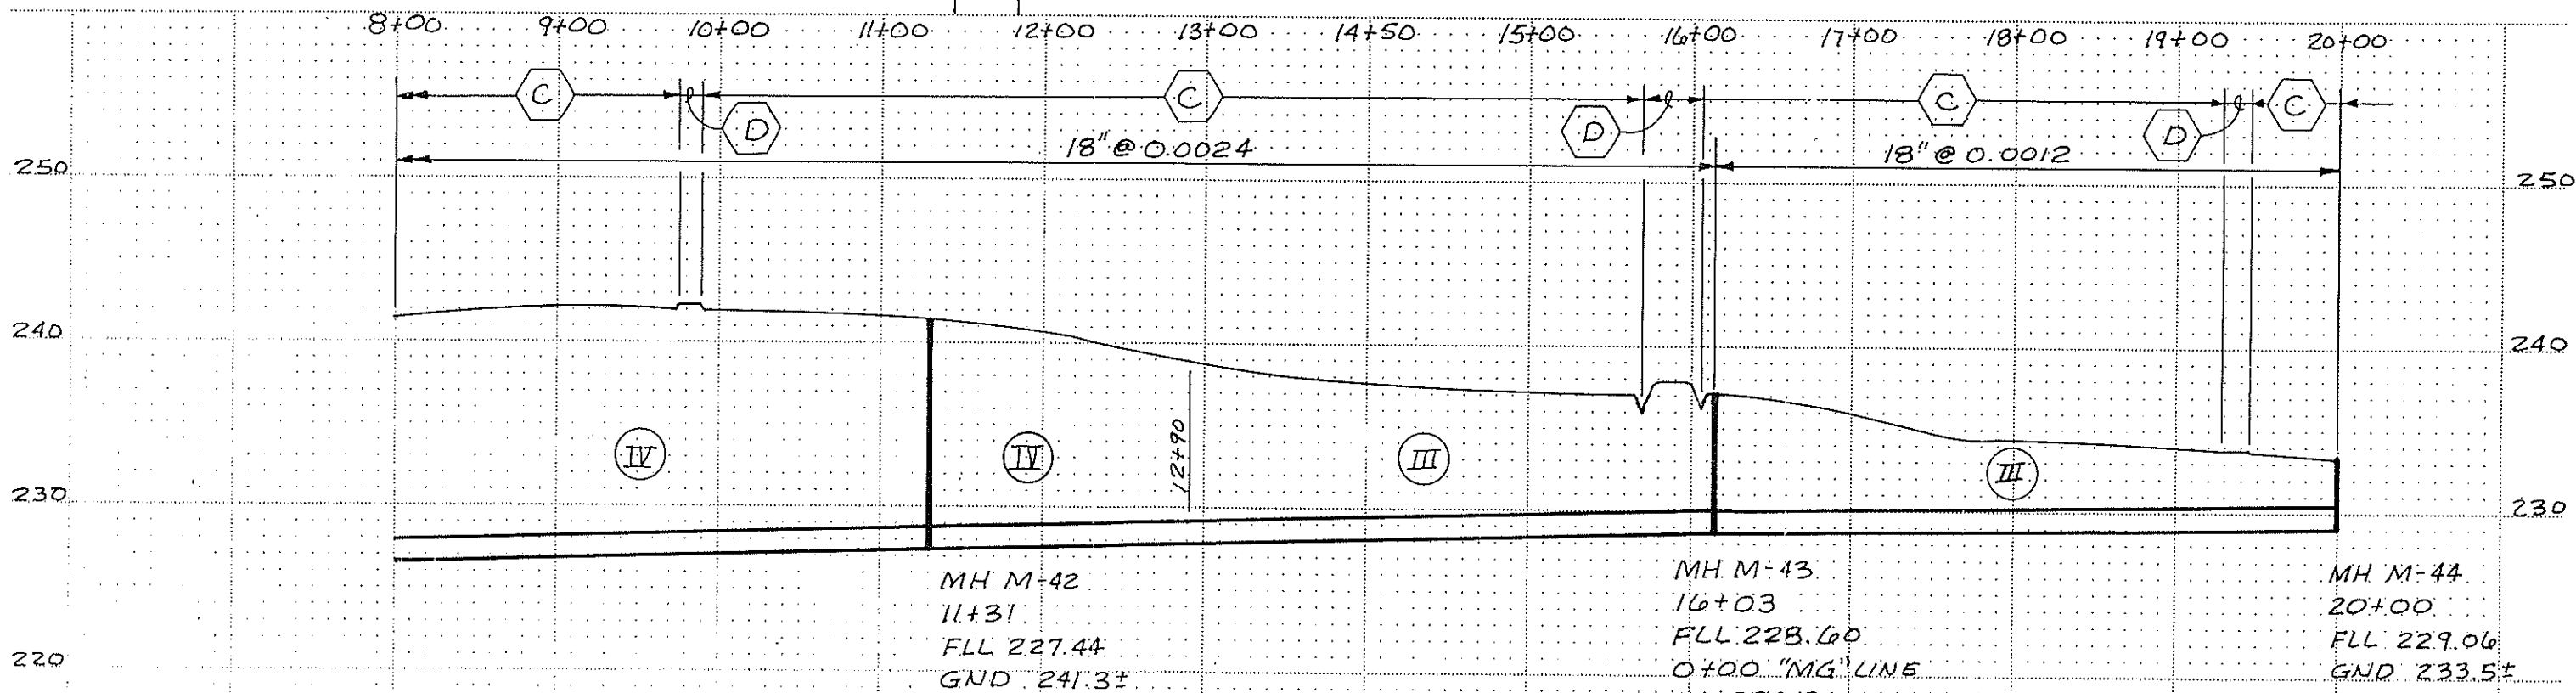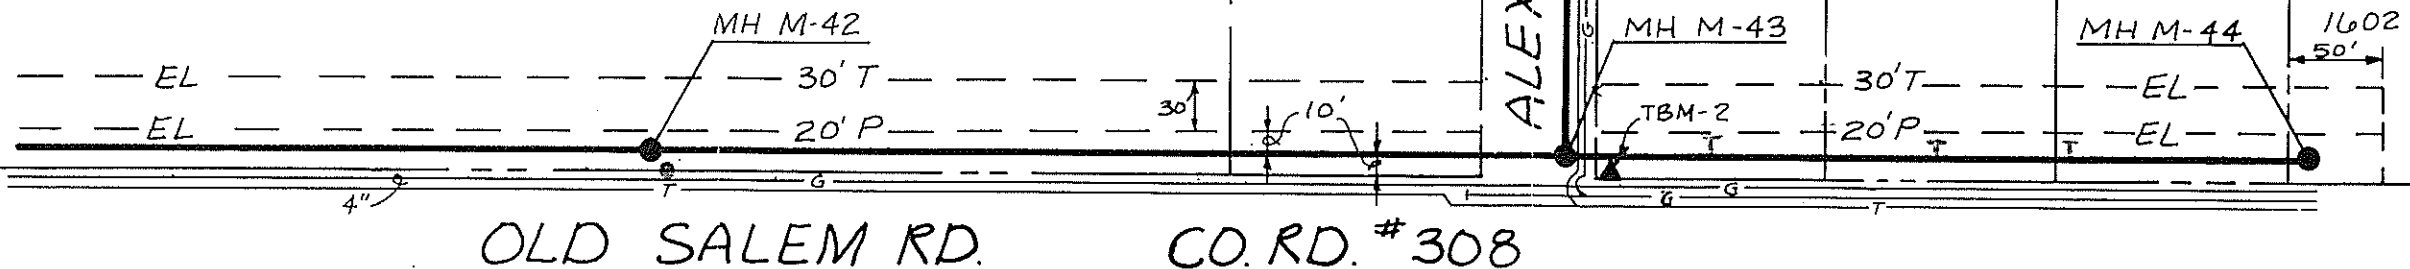

SCALE
1" = 100' HORIZ.
1" = 10' VERT.

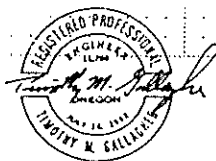



CH2M HILL	DES. JLM	12/83	RECORD DWG	JLM	APPD.
	DIR. JLM				
	CHK. DAC				
	APPD. TMG				
	NO.	DATE	REVISION	BY	APPD.

SANITARY SEWAGE COLLECTION SYSTEM
SCHEDULE A CONTRACT NO. 3

CITY OF MILLERSBURG
LINN COUNTY, OREGON

MILLERSBURG TRUNK SEWER
"M" LINE
PLAN AND PROFILE
STA 8+00 TO STA 20+00



SHEET 3
OF 13
DATE DEC 82
DWG. NO. E16523 A1

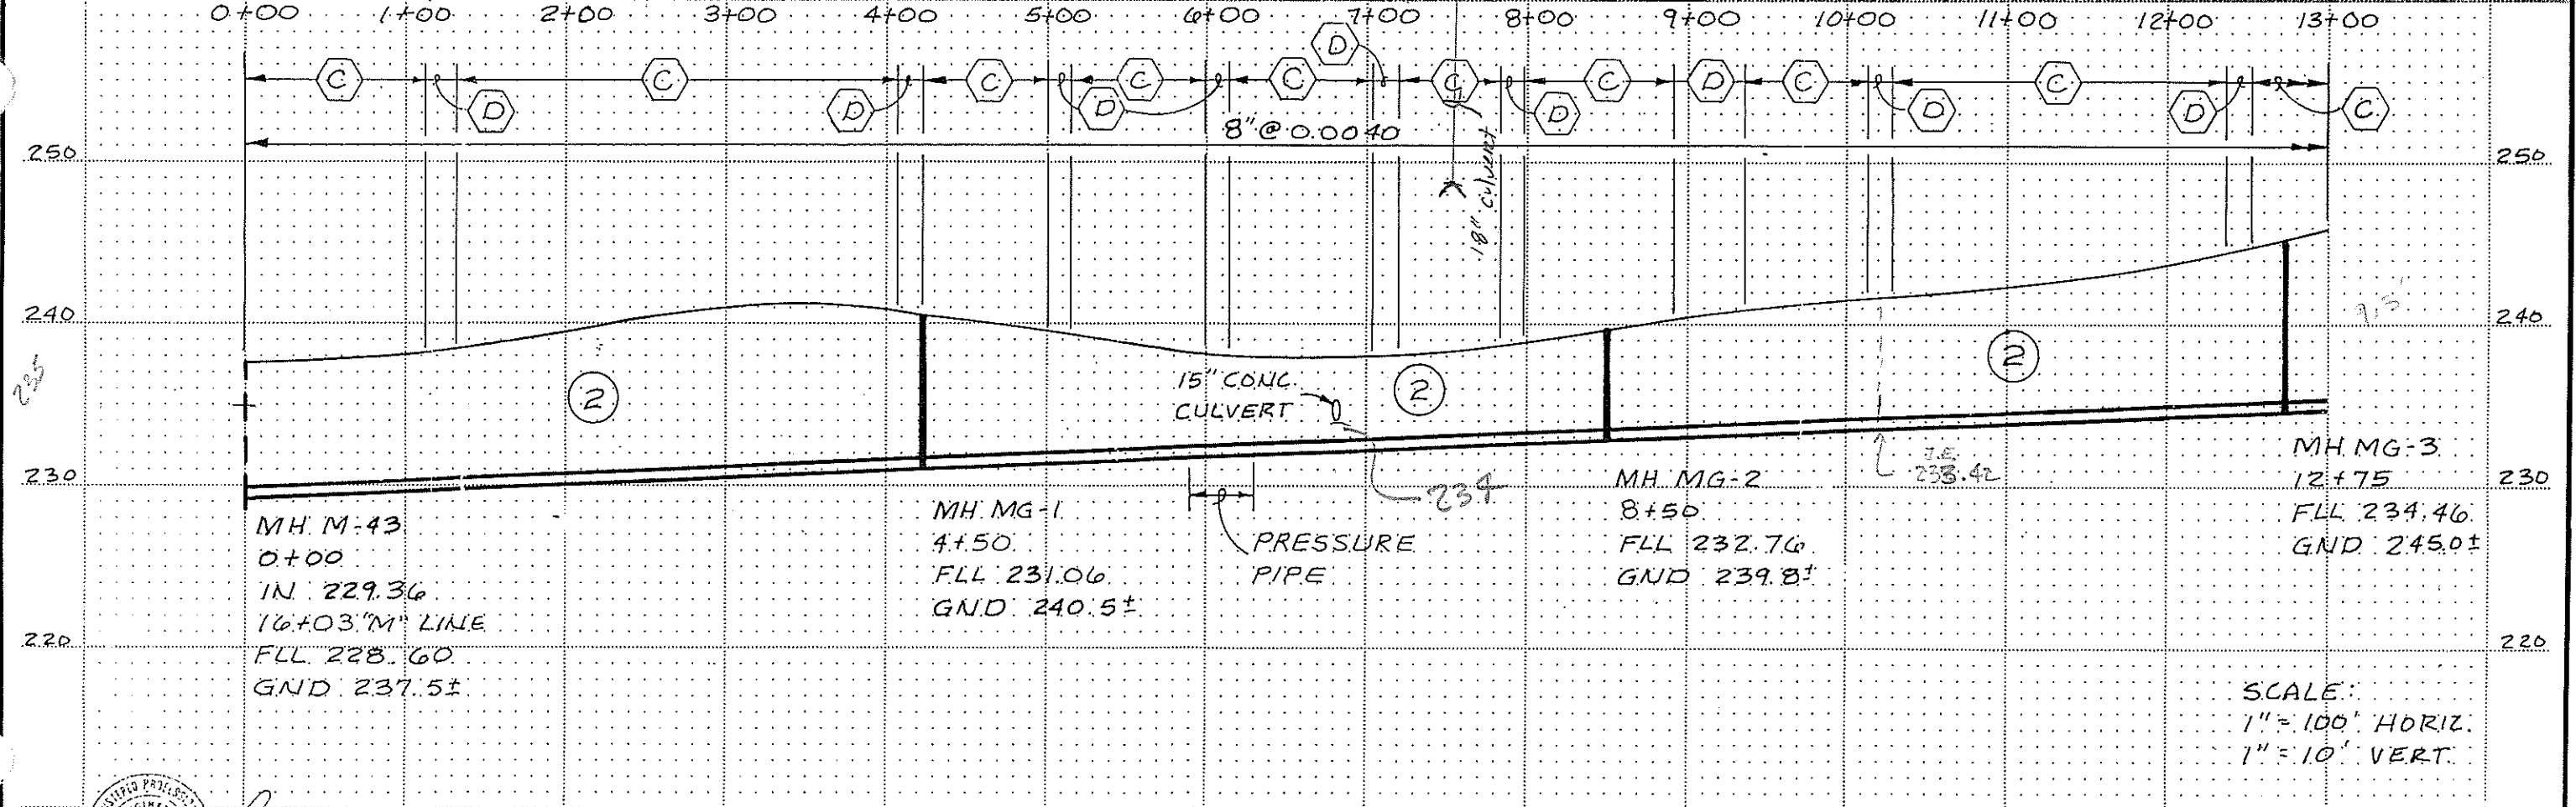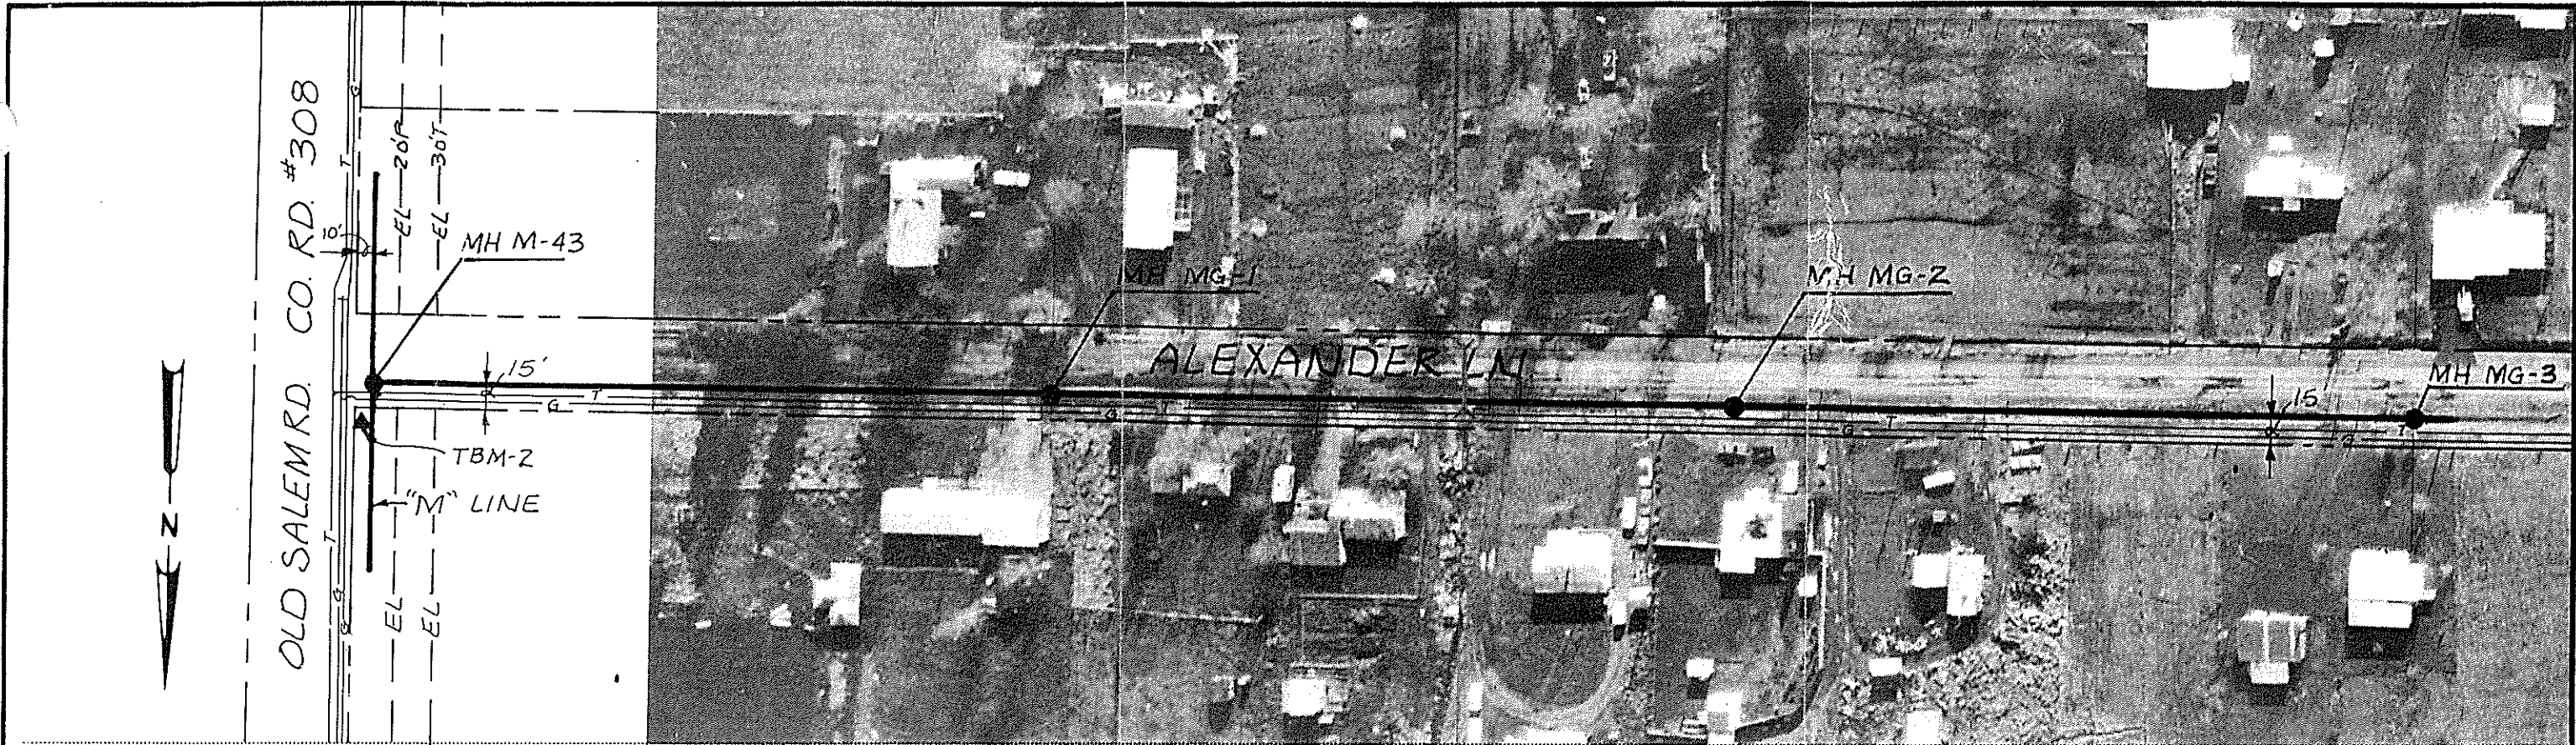

SCALE:
 1" = 100' HORIZ.
 1" = 10' VERT.



CH2M HILL DES. JLM DR. JLM CHK. DAG APPD. TIMG	NO.	DATE	REVISION	BY	APPD.	SANITARY SEWAGE COLLECTION SYSTEM SCHEDULE A CONTRACT NO 3	CITY OF MILLERSBURG LINN COUNTY, OREGON	MILLERSBURG SEWER "MG" LINE PLAN AND PROFILE STA 0+00 TO STA 13+00	SHEET 4
	12/83	RECORD DWG	JLM		OF 11				
					DATE DEC 82				
					DWG. NO. E16523 A1				

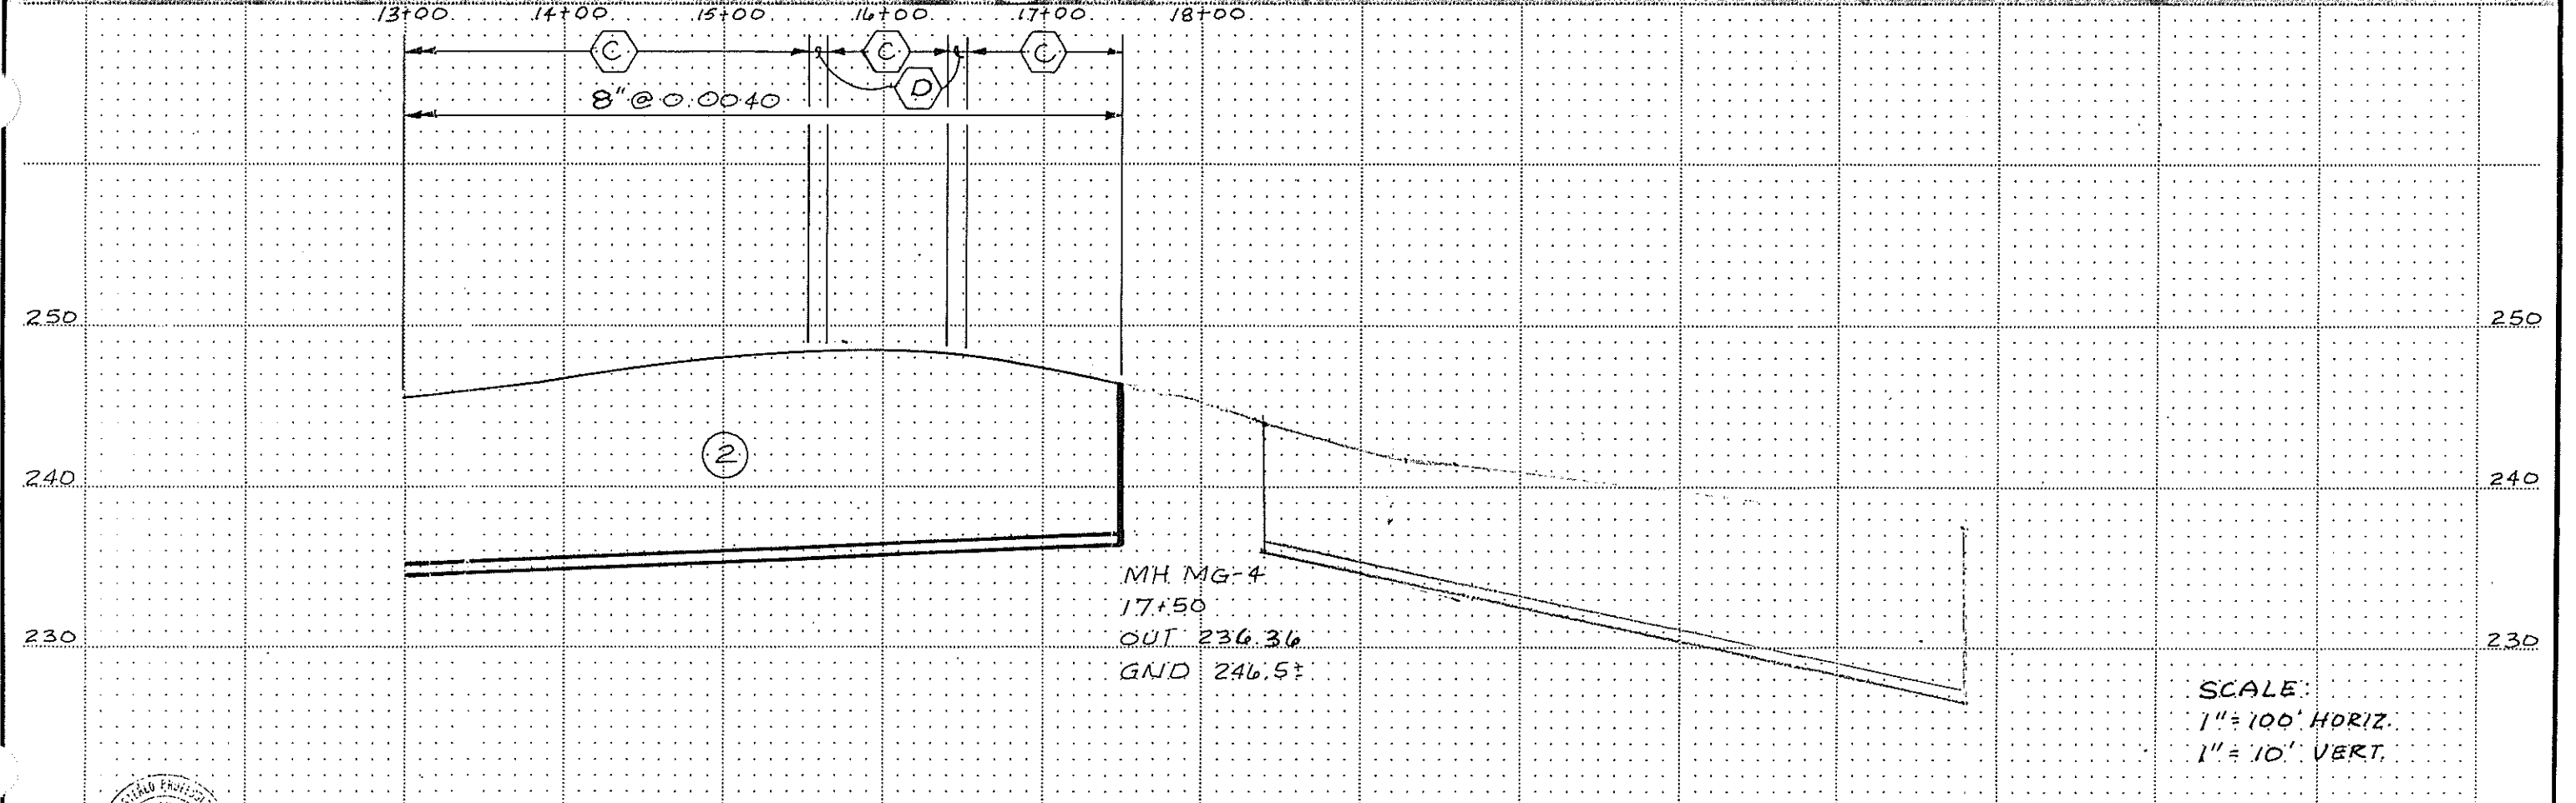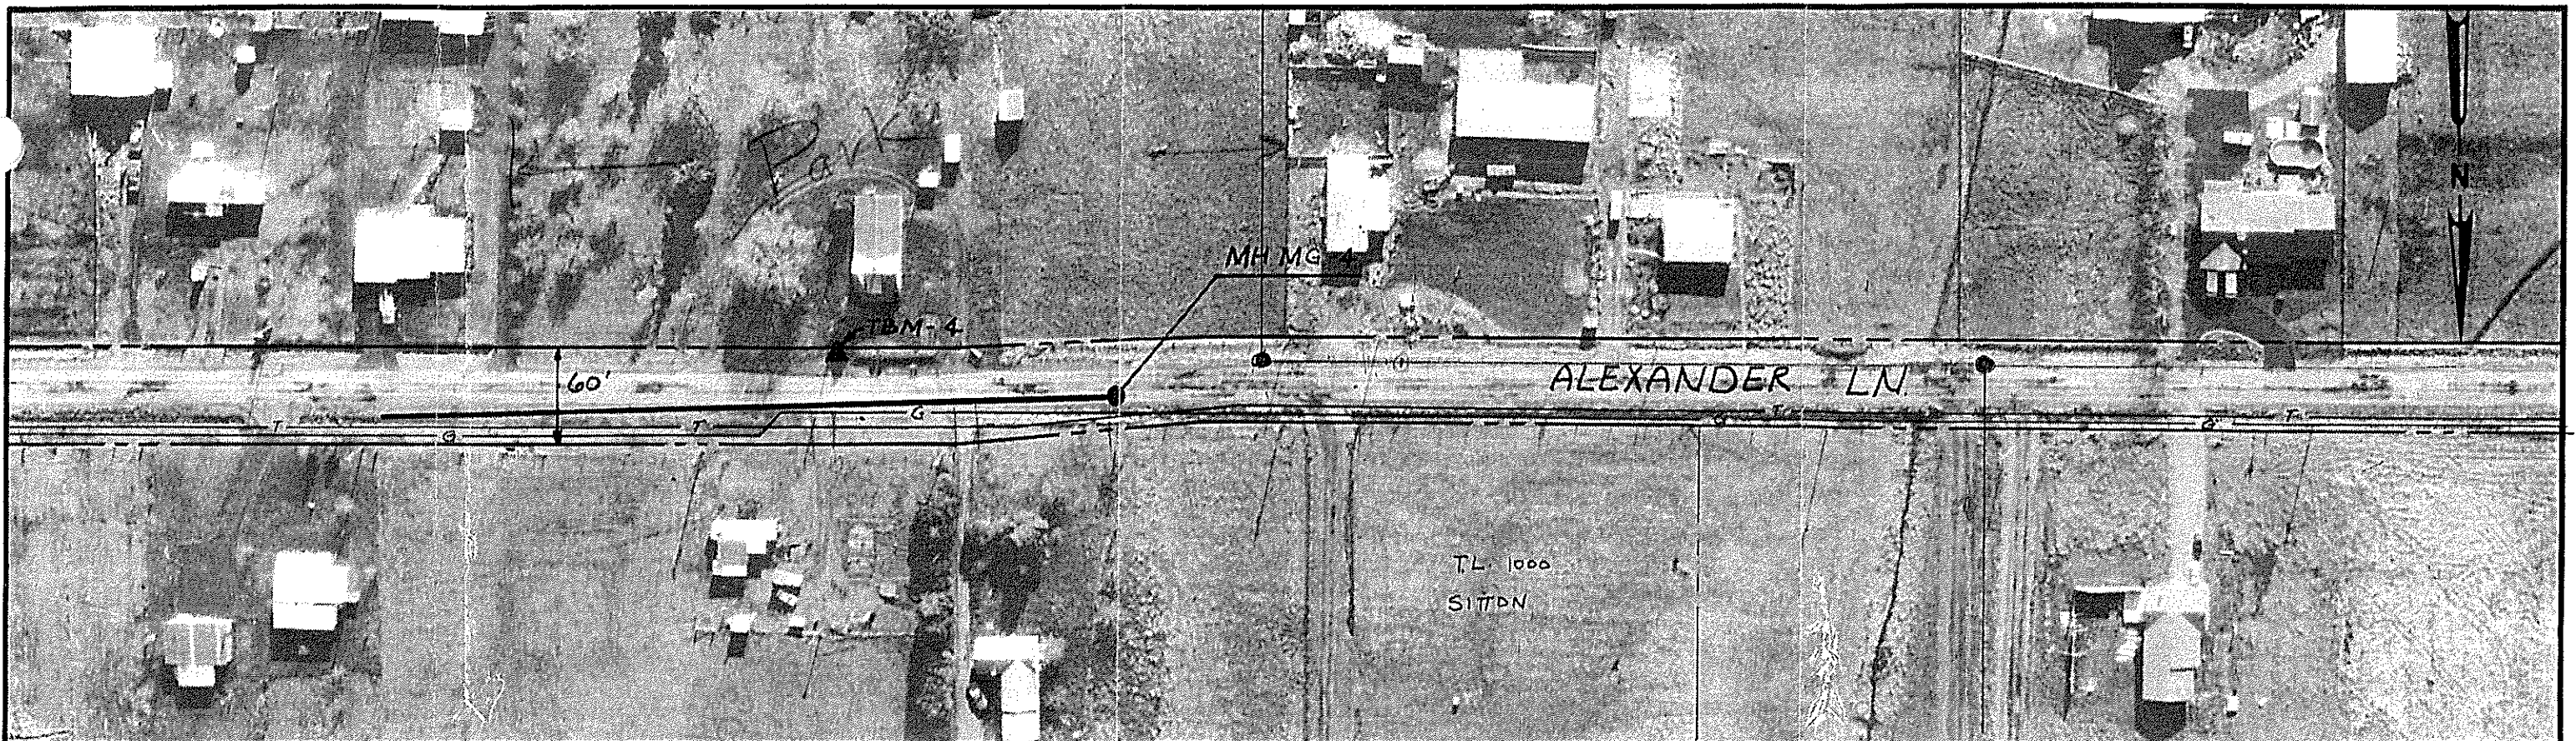


CH2M HILL	DES. <i>JLM</i>	12/83 RECORD DWG	<i>JLM</i>		
	DR. <i>JLM</i>				
	CHK. <i>DAC</i>				
	APPD. <i>TMG</i>				
	NO.	DATE	REVISION	BY	APPD.

SANITARY SEWAGE COLLECTION SYSTEM
 SCHEDULE A CONTRACT NO 3

CITY OF MILLERSBURG
 LINN COUNTY, OREGON

MILLERSBURG SEWER
 "MG" LINE
 PLAN AND PROFILE
 STA 13+00 TO STA 17+50

SHEET 5
 OF 13
 DATE DEC 82
 DWG. NO. E16523 A1

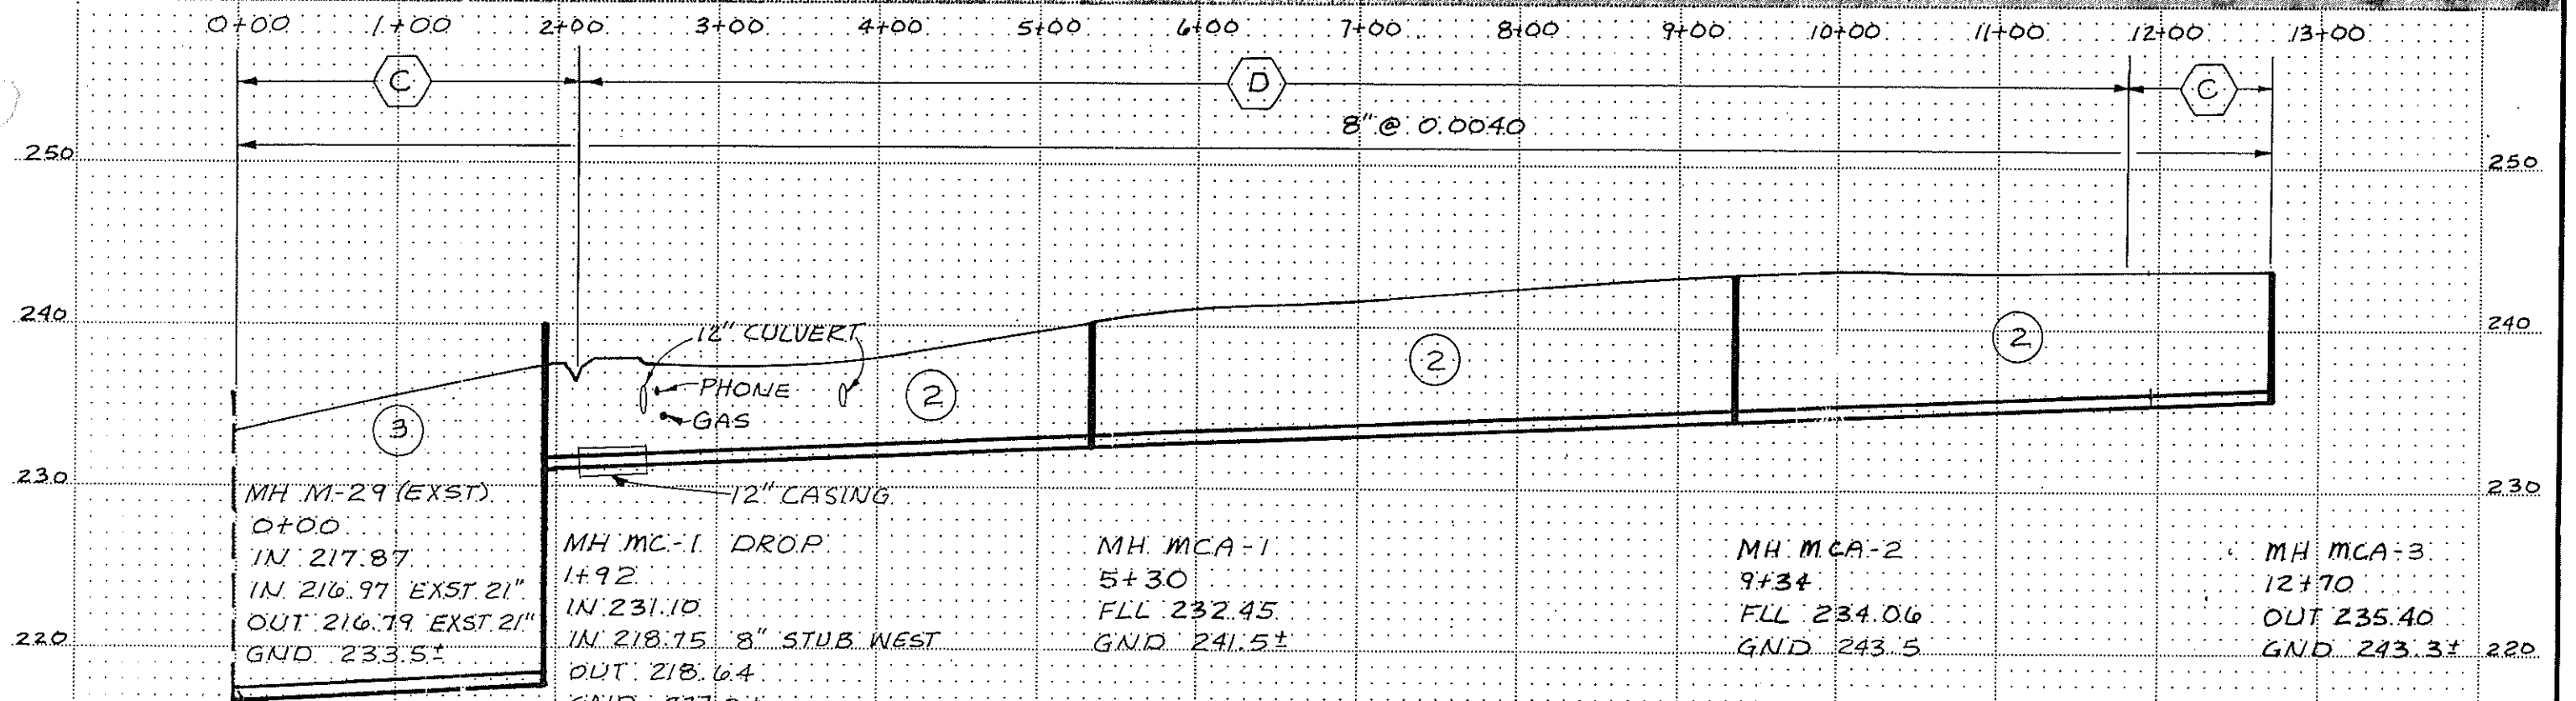

MH M-29 (EXST)
 0+00
 IN. 217.87
 IN. 216.97 EXST. 21"
 OUT. 216.79 EXST. 21"
 GND. 233.5±
 BREAK INTO EXST.
 MH AND GROUT
 IN. NEW 8" PIPE

MH MC-1 DROP
 1+92
 IN. 231.10
 IN. 218.15 8" STUB WEST
 OUT. 218.64
 GND. 237.0±
 COVER 240.0±

MH MCA-1
 5+30
 FLL 232.45
 GND 241.5±



MH MCA-2
 9+34
 FLL 234.06
 GND 243.5

MH MCA-3
 12+70
 OUT 235.40
 GND 243.3±

SCALE:
 1" = 100' HORIZ.
 1" = 10' VERT.



CH2M HILL	DES. JLM	12/83	RECORD DWG	JLM	BY	APPD.
	DR. JLM					
	CHK. DAC					
	APPD. TMG					
	NO.	DATE	REVISION			

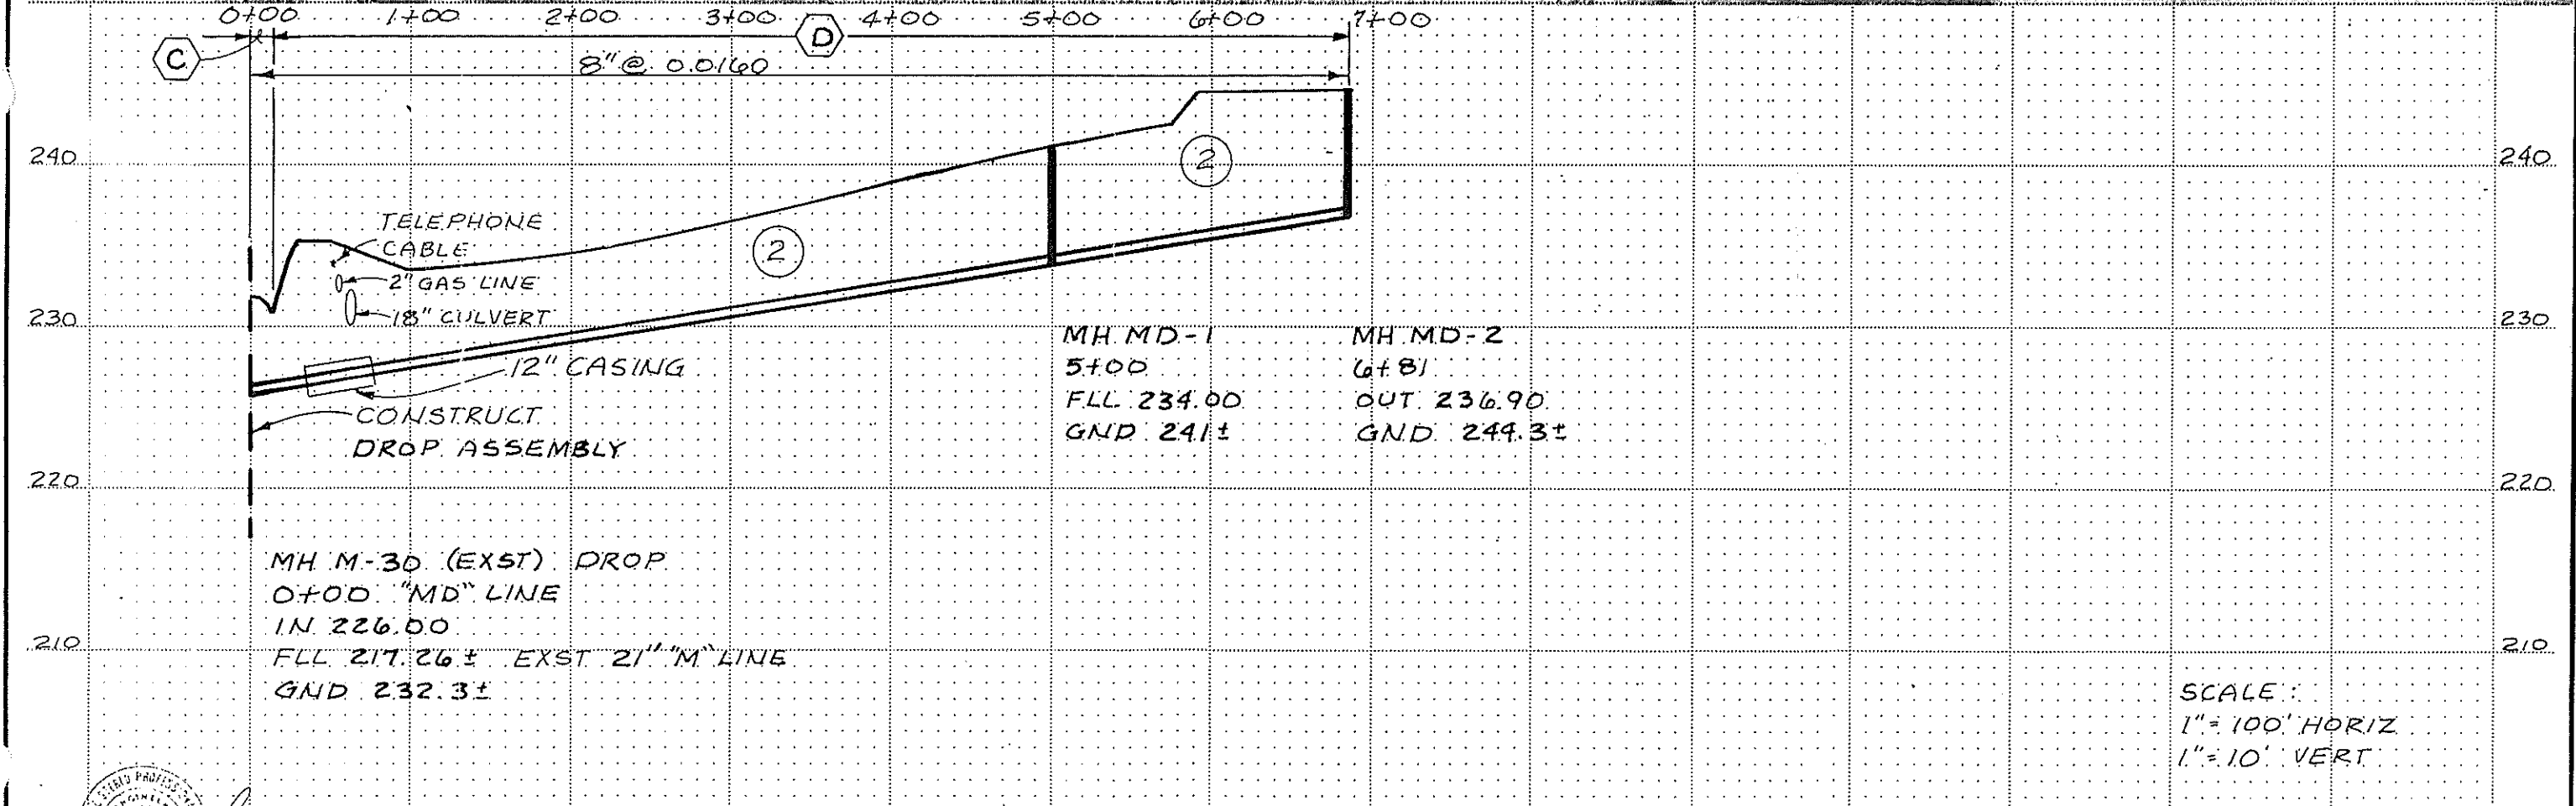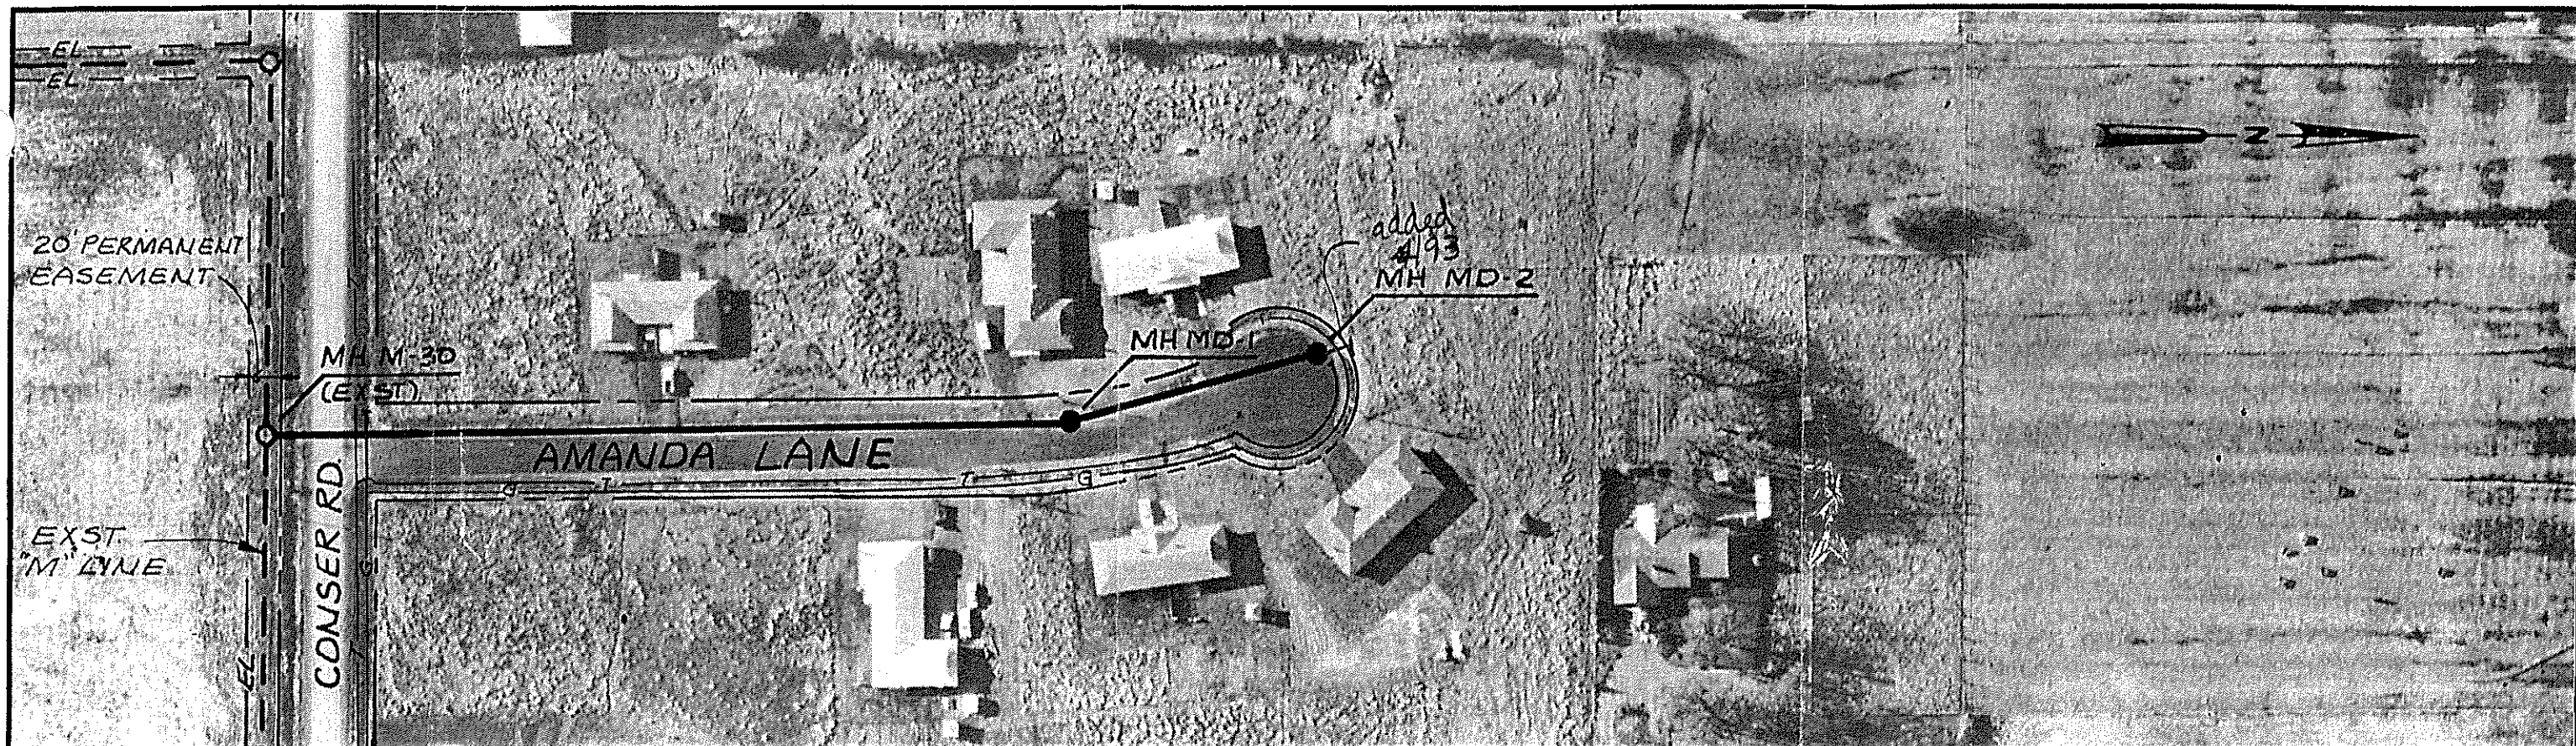



MH M-30 (EXST) DROP
 0+00 "MD" LINE
 IN. 226.00
 FLL 217.26± EXST 21" "M" LINE
 GND 232.3±

MH MD-1	MH MD-2
5+00	6+81
FLL 234.00	OUT. 236.90
GND 241±	GND 244.3±

SCALE:
 1" = 100' HORIZ
 1" = 10' VERT



CH2M HILL DES. JLM DR. JLM CHK. DAC APPD. TMG	12/83	RECORD DWG	JLM	SANITARY SEWAGE COLLECTION SYSTEM SCHEDULE B CONTRACT NO 3	CITY OF MILLERSBURG LINN COUNTY, OREGON	MILLERSBURG SEWER "MD" LINE PLAN AND PROFILE STA 0+00 TO STA 6+81	SHEET 7			
	NO.	DATE	REVISION				BY	APPD.	OF 11	
									DATE DEC 82	DWG. NO. E16523 A1

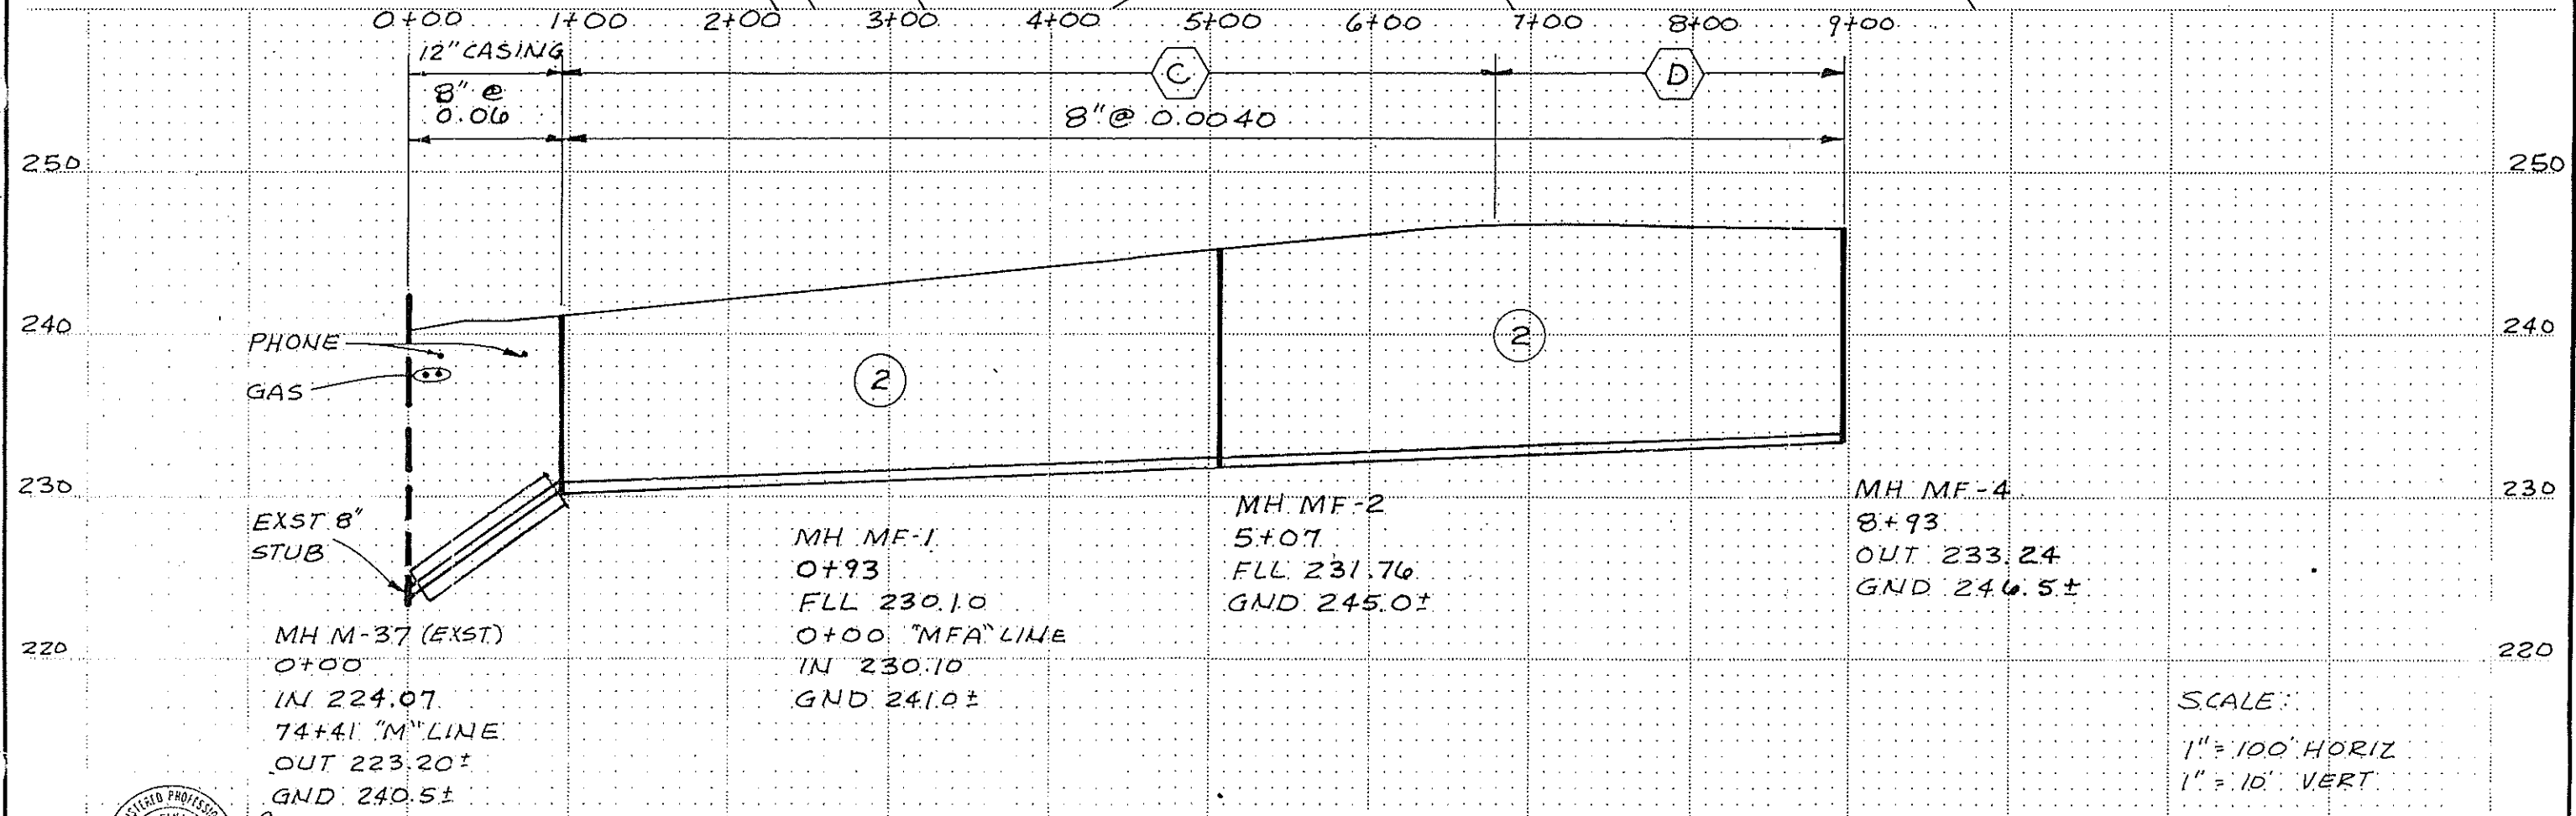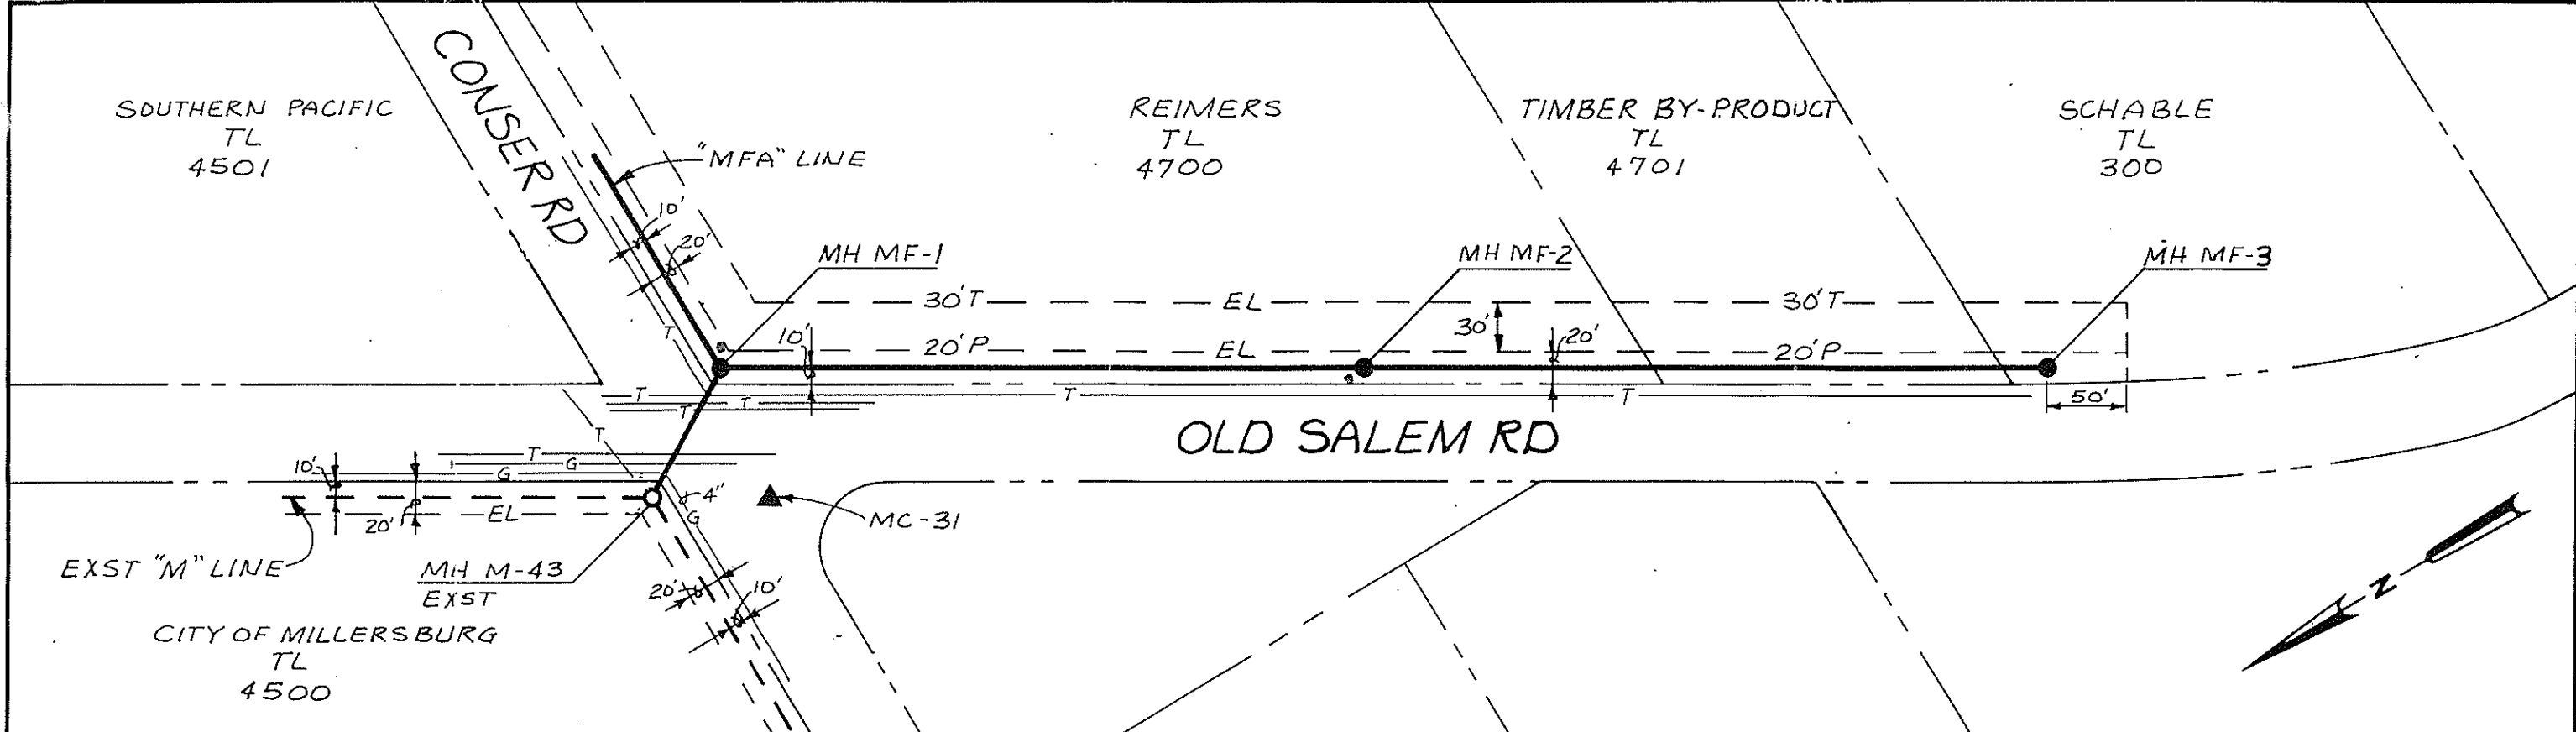

MH M-37 (EXST.)
 0+00
 IN 224.07
 74+41 "M" LINE
 OUT 223.20±
 GND. 240.5±

MH MF-1
 0+93
 FLL 230.10
 0+00 "MFA" LINE
 IN 230.10
 GND. 241.0±



MH MF-2
 5+07
 FLL 231.76
 GND. 245.0±

MH MF-4
 8+93
 OUT 233.24
 GND. 246.5±

SCALE:
 1" = 100' HORIZ
 1" = 10' VERT



CH2M HILL DES. JLM DR. JLM CHK. DAC APPD. TMG	12/83 NO. DATE	RECORD DWG. REVISION	JLM BY APPD	SANITARY SEWAGE COLLECTION SYSTEM SCHEDULE B CONTRACT NO. 3	CITY OF MILLERSBURG LINN COUNTY, OREGON	MILLERSBURG SEWER "MF" LINE PLAN AND PROFILE STA 0+00 TO STA 8+93	SHEET 8 OF 13 DATE DEC 82 DWG. NO. E16523 A1
	MILLERSBURG SEWER "MF" LINE PLAN AND PROFILE STA 0+00 TO STA 8+93						

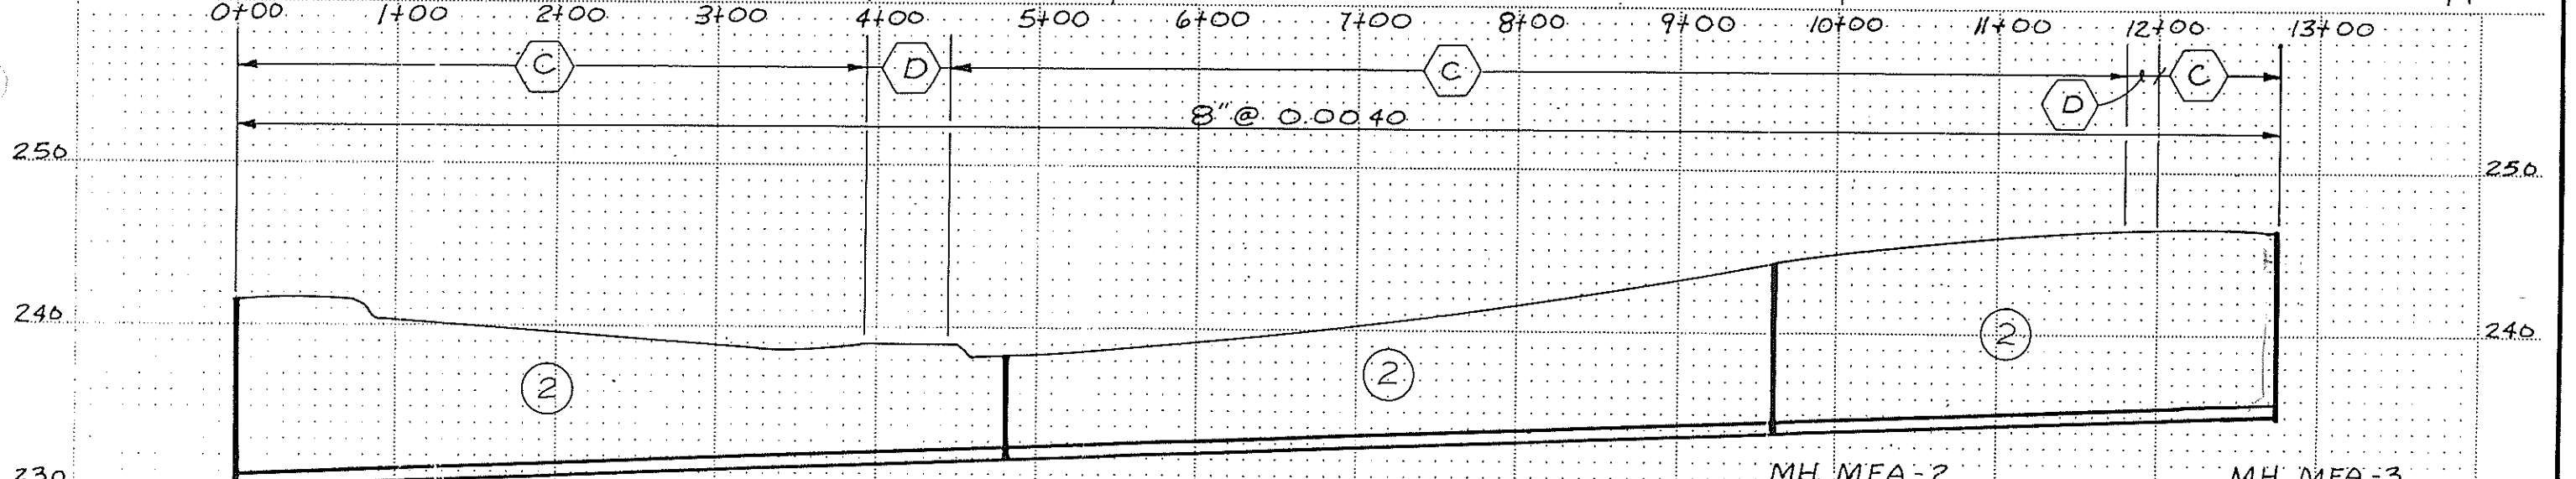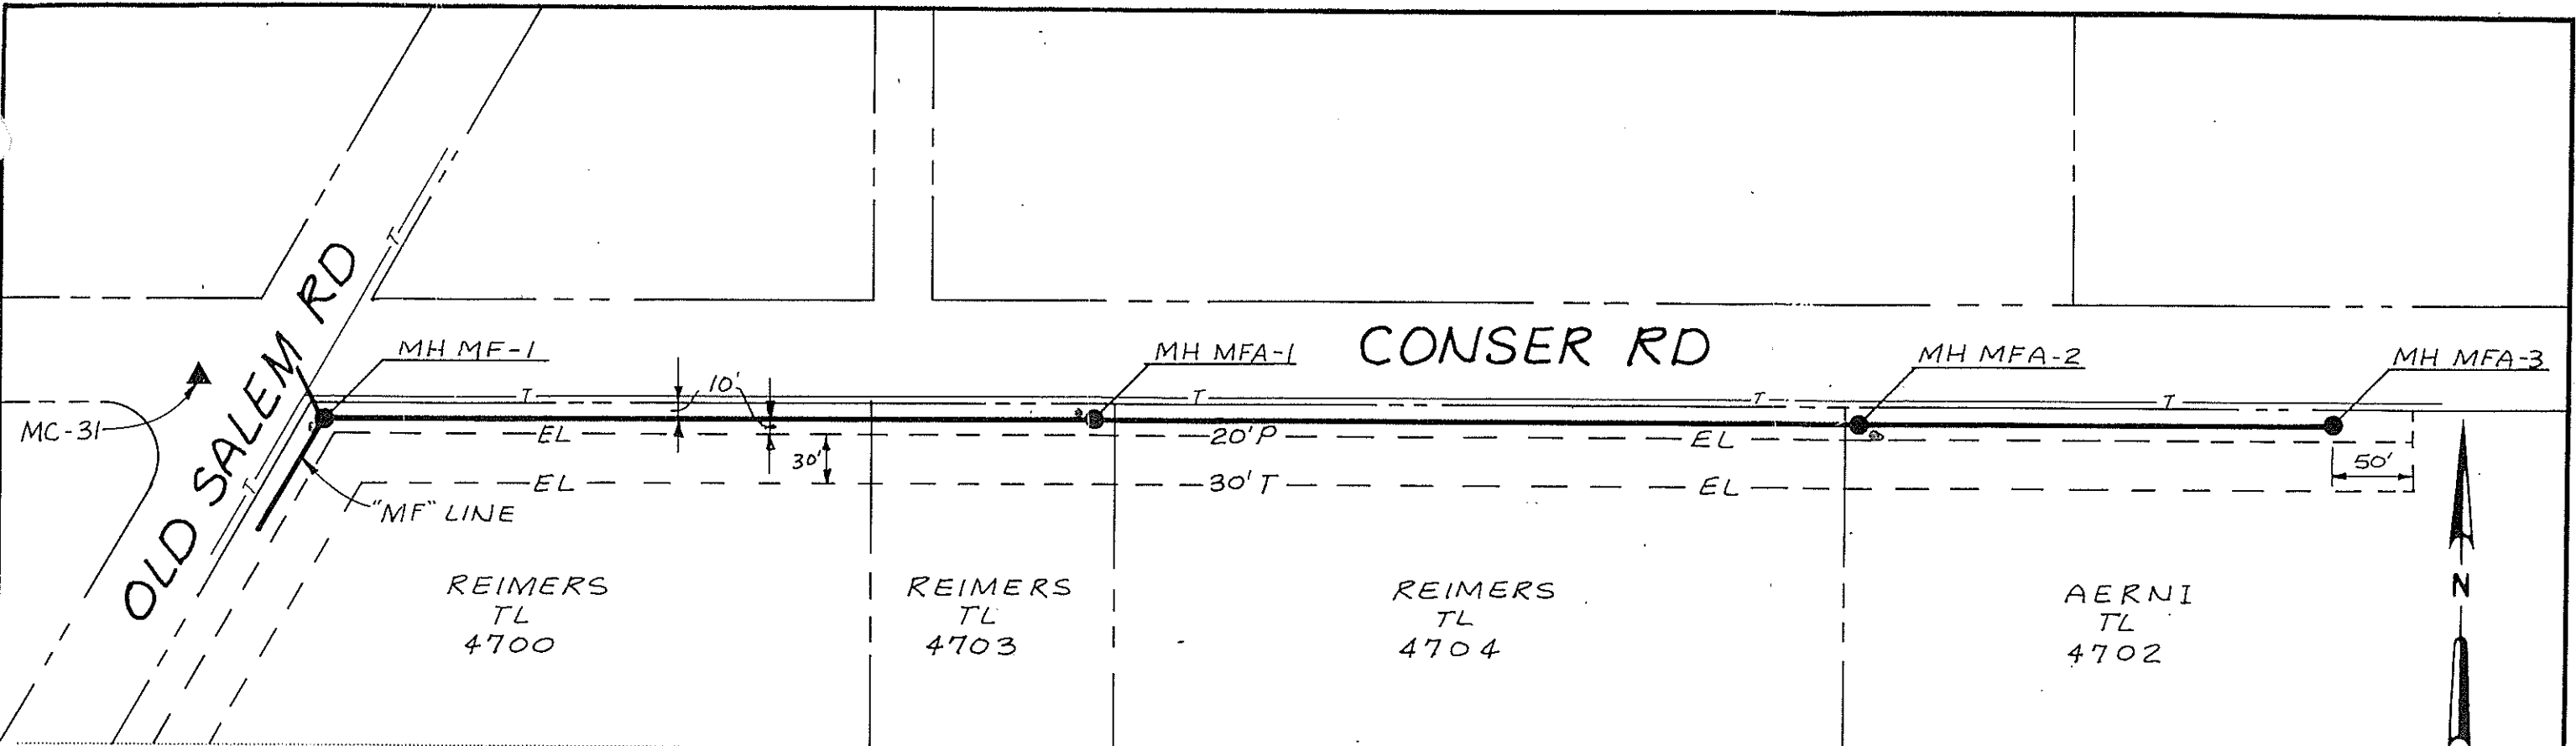

MH MF-1
 0+00
 IN 230.10
 0+93 "MF" LINE
 FLL 230.00
 GND 240.00

MH MFA-1
 4+80
 FLL 232.02
 GND 238.0±

MH MFA-2
 9+50
 FLL 233.90
 GND 244±

MH MFA-3
 12+75
 OUT 235.20
 GND 246±

SCALE:
 1" = 100' HORIZ
 1" = 10' VERT



CH2M HILL	DES. JLM	12/83	RECORD DWG.	JLM	BY	APPD.
	DR. JLM					
	CHK. DAC					
	APPD. TMG					
NO.	DATE	REVISION				


SANITARY SEWAGE COLLECTION SYSTEM
 SCHEDULE B
 CONTRACT NO. 3

CITY OF MILLERSBURG
 LINN COUNTY, OREGON

MILLERSBURG SEWER
 "MFA" LINE
 PLAN AND PROFILE
 STA 0+00 TO STA 12+50

SHEET 9
 OF 13
 DATE DEC 82
 DWG. E16523 A1

5. City of Millersburg Sanitary Sewer Collection System Contract 4

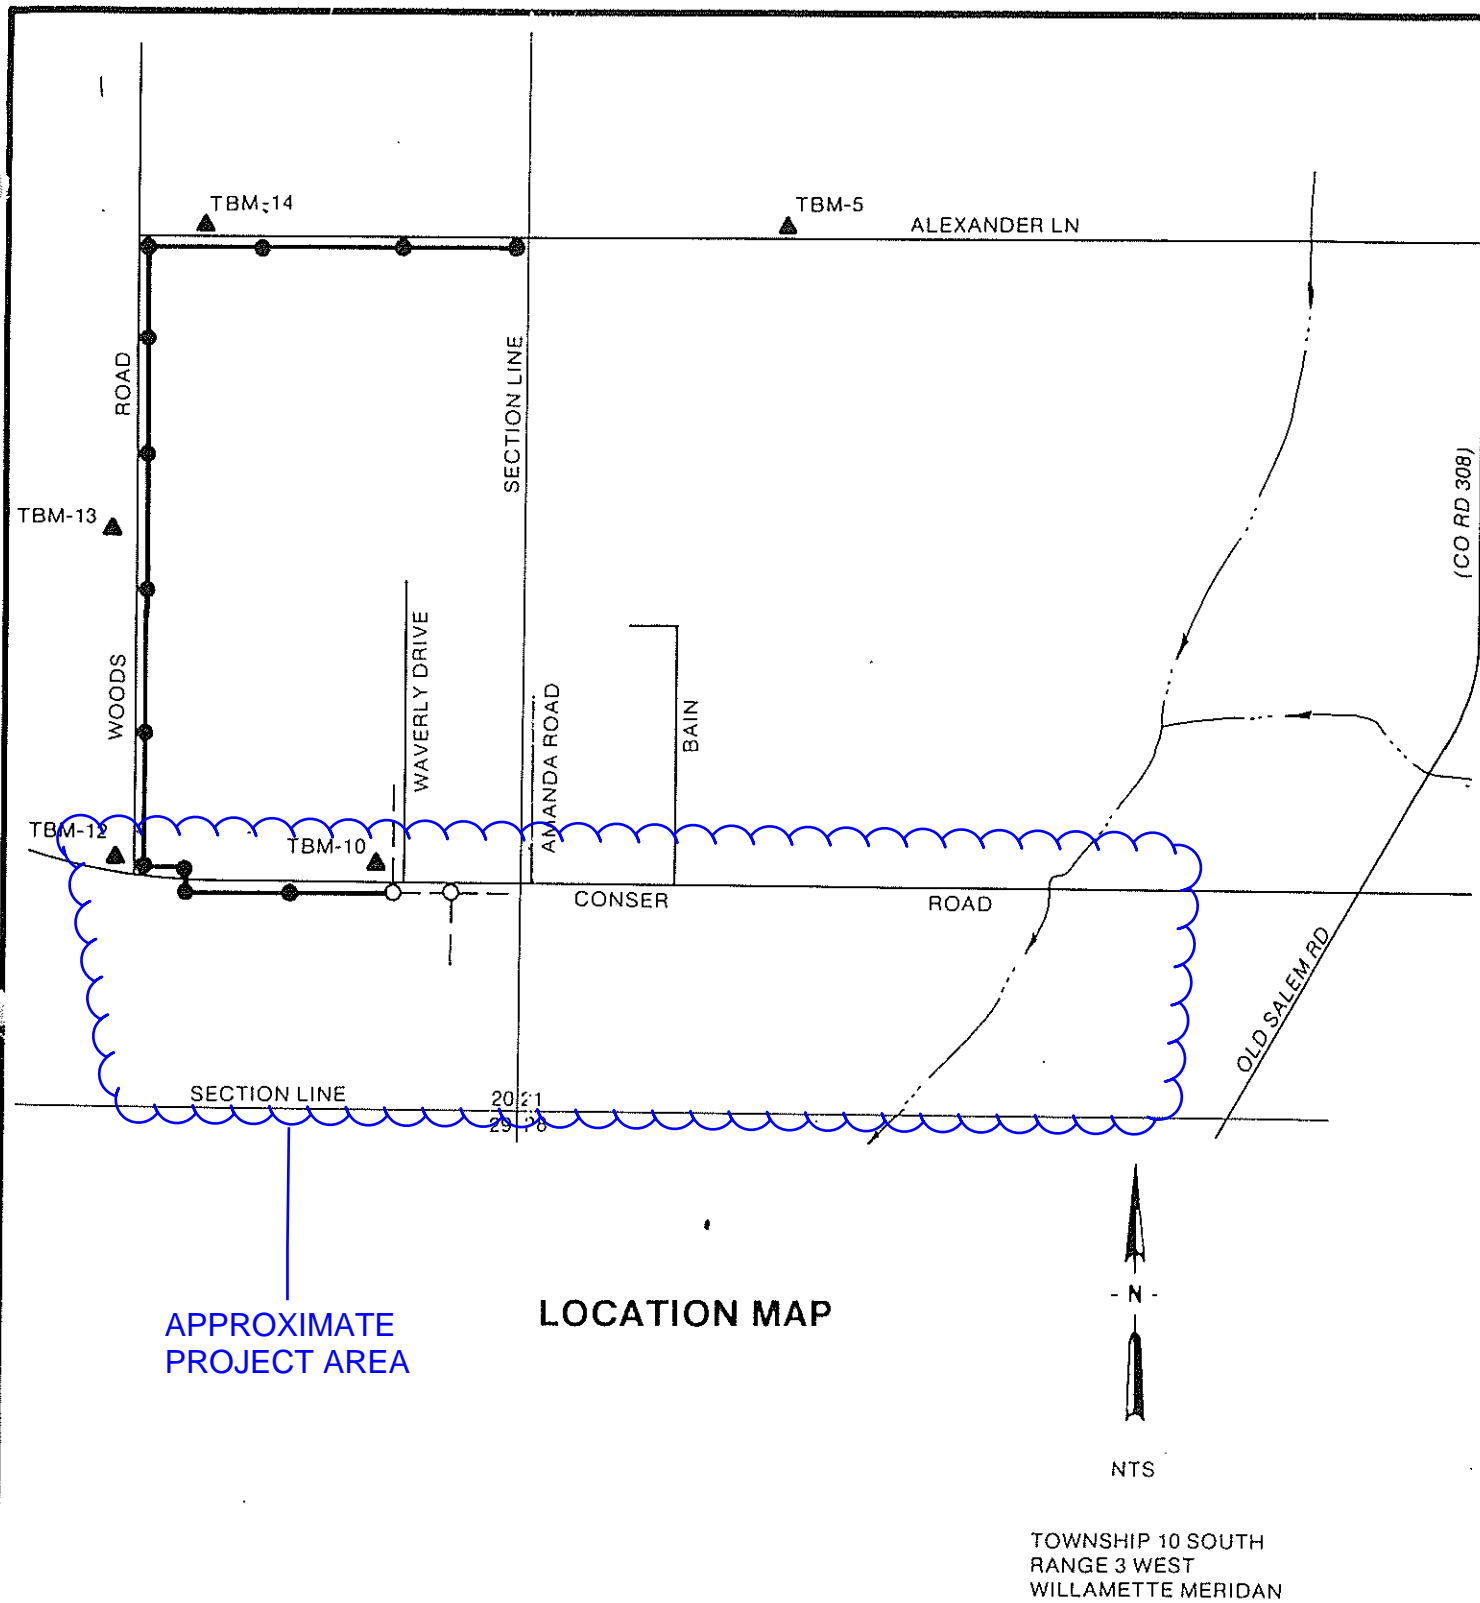


APPROXIMATE PROJECT AREA

LOCATION MAP

TOWNSHIP 10 SOUTH
RANGE 3 WEST
WILLAMETTE MERIDIAN

LEGEND

- NEW**
- MH "M"-6 MANHOLE DESIGNATION
 - GRAVITY SEWER WITH MANHOLE
 - BACKFILL CLASSIFICATION
 - 8" @ 0.004 SIZE AND SLOPE OF PIPE (8" PIPE AT 0.0040 FT/FT)
 - (IV) ASTM C-76, CLASS III OR IV OR ASTM C-14, CLASS 2 OR 3 AS NOTED
- EXISTING**
- SANITARY SEWER WITH MANHOLE
 - STORM SEWER WITH CATCH BASIN AND MANHOLE
 - 12" IRR IRRIGATION PIPELINE
 - 8" W-W WATER PIPELINE WITH FIRE HYDRANT AND VALVE
 - 2" G GAS PIPELINE
 - P UNDERGROUND POWER CABLE
 - T UNDERGROUND TELEPHONE CABLE
 - TV UNDERGROUND TELEVISION CABLE
 - 12" CMP CULVERT (SIZE AND TYPE INDICATED)
 - FENCE LINE
 - UTILITY POLE WITH GUY ANCHOR
- GENERAL**
- RIGHT-OF-WAY AND/OR PROPERTY LINE
 - T.L. 4400 TAX LOT NUMBER
 - EL EASEMENT LINE
 - 20P WIDTH OF PERMANENT EASEMENT
 - 30T WIDTH OF TEMPORARY EASEMENT
 - BM-1 BENCHMARK LOCATION AND NUMBER
 - DITCH SHOWING DIRECTION OF FLOW

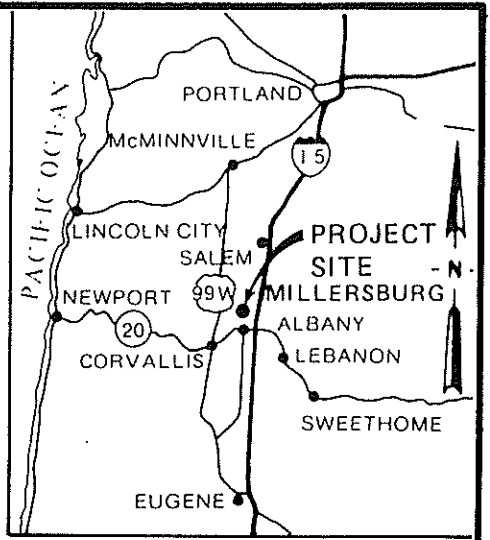

VICINITY MAP

BENCHMARK DESCRIPTION

TBM NO.	USC&GS ELEVATION	DESCRIPTION AND LOCATION
TBM-5	236.07	RAILROAD SPIKE IN NORTH SIDE OF POWER POLE (PP&L #211503); 45' NORTH OF CENTERLINE ALEXANDER LANE AND 2090' EAST OF THE INTERSECTION OF WOODS ROAD AND ALEXANDER LANE
TBM-10	238.85	RAILROAD SPIKE IN EAST SIDE OF POWER POLE AT THE NORTHWEST CORNER OF THE INTERSECTION OF CONSER ROAD AND WAVERLY DRIVE
TBM-12	240.84	RAILROAD SPIKE IN NORTHEAST SIDE OF POWER POLE (PP&L #207100) AT THE NORTHWEST CORNER OF THE INTERSECTION OF CONSER ROAD AND WOODS ROAD
TBM-13	234.79	RAILROAD SPIKE IN SOUTH SIDE OF POWER POLE (PP&L #207302) ON WEST SIDE OF WOODS ROAD, 1040' FEET NORTH OF THE INTERSECTION OF CONSER ROAD AND WOODS ROAD
TBM-14	238.12	RAILROAD SPIKE IN SOUTH SIDE OF POWER POLE (PP&L #207501) ON NORTH SIDE OF WOODS ROAD, 210' FEET EAST OF THE INTERSECTION OF WOODS ROAD AND ALEXANDER LANE

INDEX TO DRAWINGS

SHEET NO.	TITLE
1	VICINITY MAP; LOCATION MAP; BENCHMARK DESCRIPTIONS; INDEX TO DRAWINGS AND LEGEND
2	MILLERSBURG SEWER "MC" LINE PLAN AND PROFILE - STA 0+00 TO STA 13+70
3	MILLERSBURG SEWER "MC" LINE PLAN AND PROFILE - STA 13+70 TO STA 27+50
4	MILLERSBURG SEWER "MC" LINE PLAN AND PROFILE - STA 27+50 TO STA 41+50
5	MILLERSBURG SEWER "MC" LINE PLAN AND PROFILE - STA 41+50 TO STA 42+80
6	MANHOLE DETAILS
7	MANHOLE AND SERVICE CONNECTION DETAILS
8	PIPELINE TRENCH AND SURFACING DETAILS

ABBREVIATIONS LEGEND

- EL ELEVATION
- ELL FLOW LINE LEVEL
- GN GROUND
- IE INVERT ELEVATION
- MH MANHOLE






DES	EGS				
DR	EGS				
CHK	TMG	12/83	RECORD DWG	JLM	
APPD	DA				

SANITARY SEWAGE COLLECTION SYSTEM
CONTRACT NO. 4

CITY OF MILLERSBURG
LINN COUNTY, OREGON

VICINITY MAP; LOCATION MAP;
BENCHMARK DESCRIPTIONS; INDEX
TO DRAWINGS AND LEGEND

SHEET	1
OF	8
DATE	JULY 83
DWG. NO.	E17195.A1

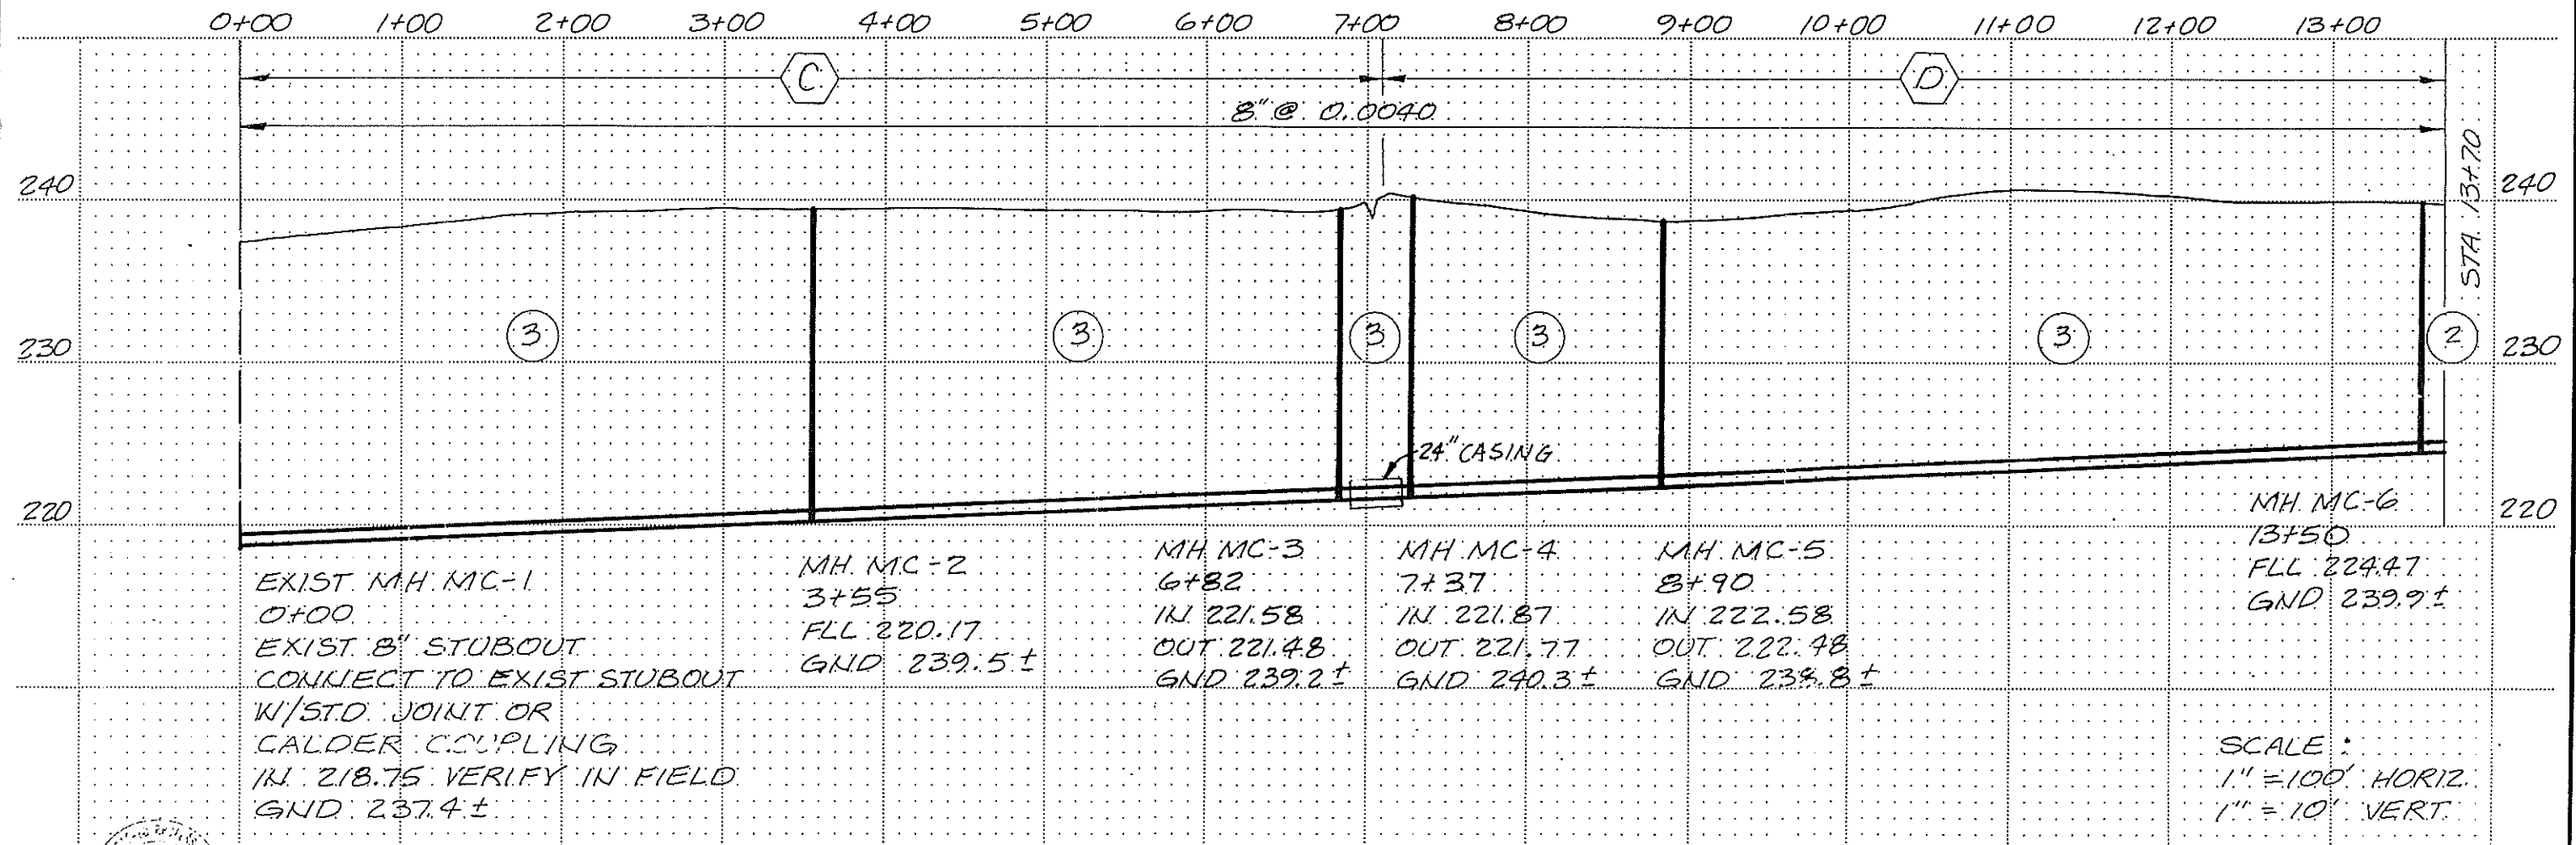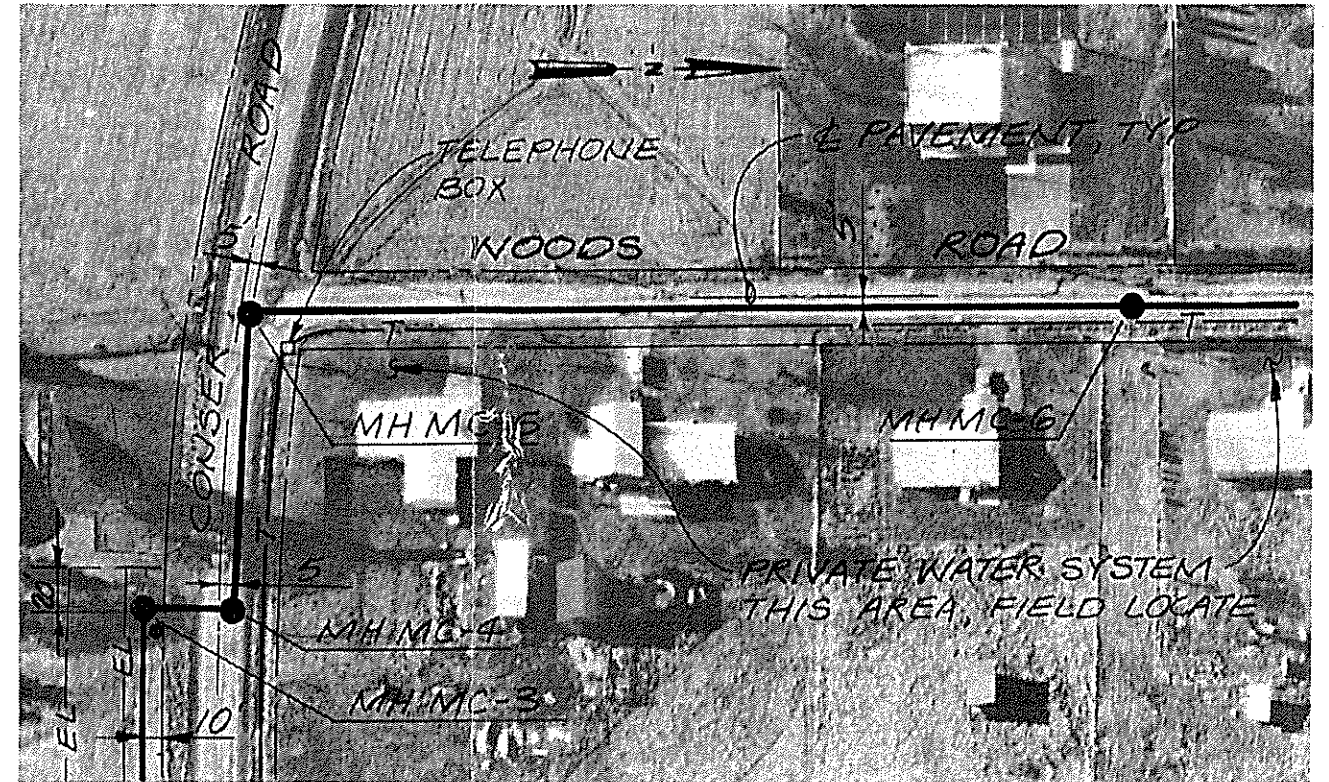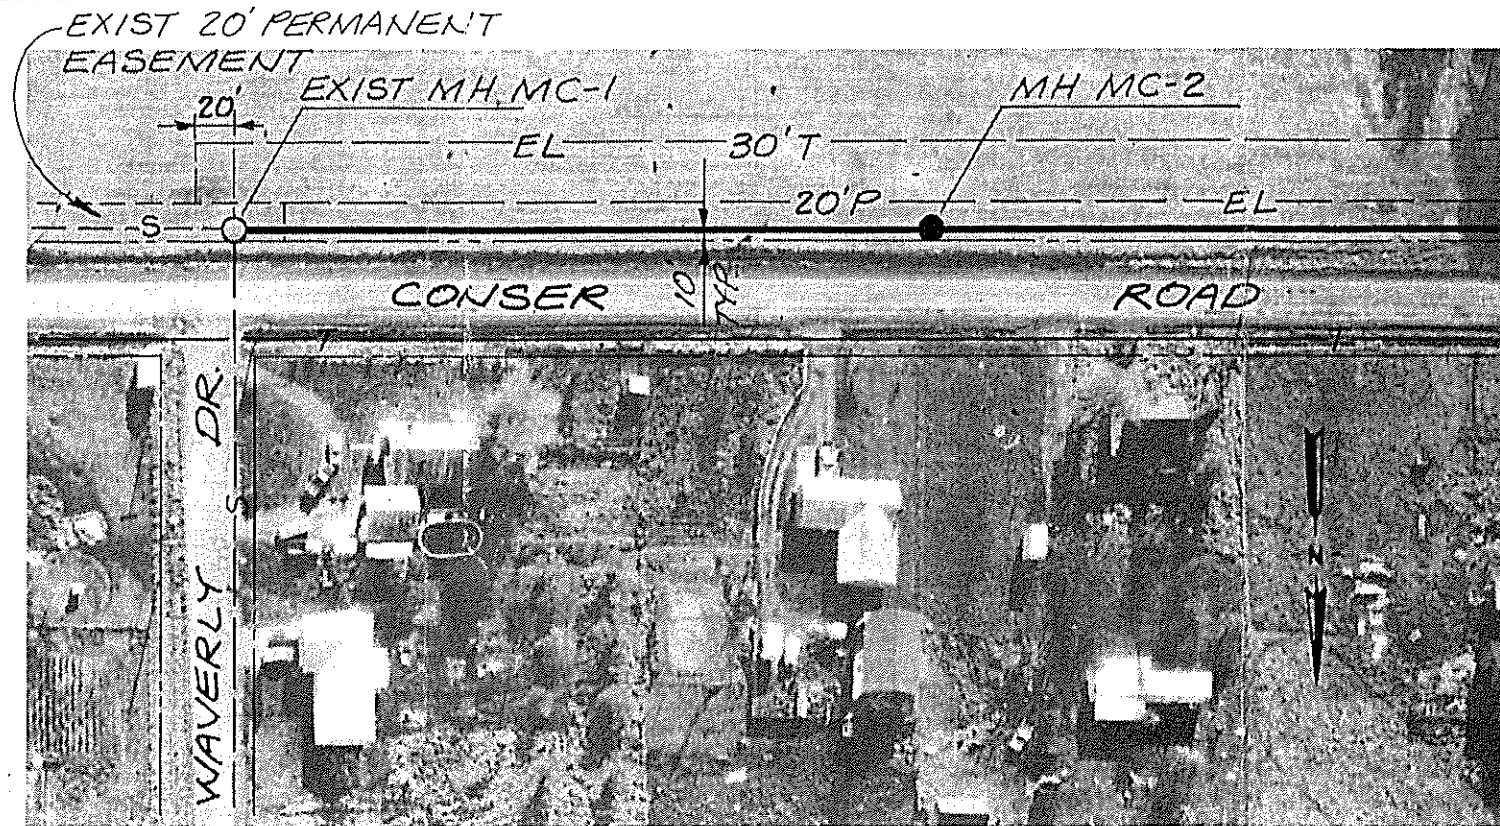



DES. GGS	12/83	RECORD DWG	BY JLM	APPD.
DR. GGS				
CHK. TMG				
APPD. DAC				

SANITARY SEWAGE COLLECTION SYSTEM
CONTRACT NO 4

CITY OF MILLERSBURG
LINN COUNTY, OREGON

MILLERSBURG SEWER "MC" LINE
PLAN AND PROFILE
STA 0+00 TO STA 13+70

SHEET	2
OF	8
DATE	JULY 83
DWG. NO.	E17195 A1

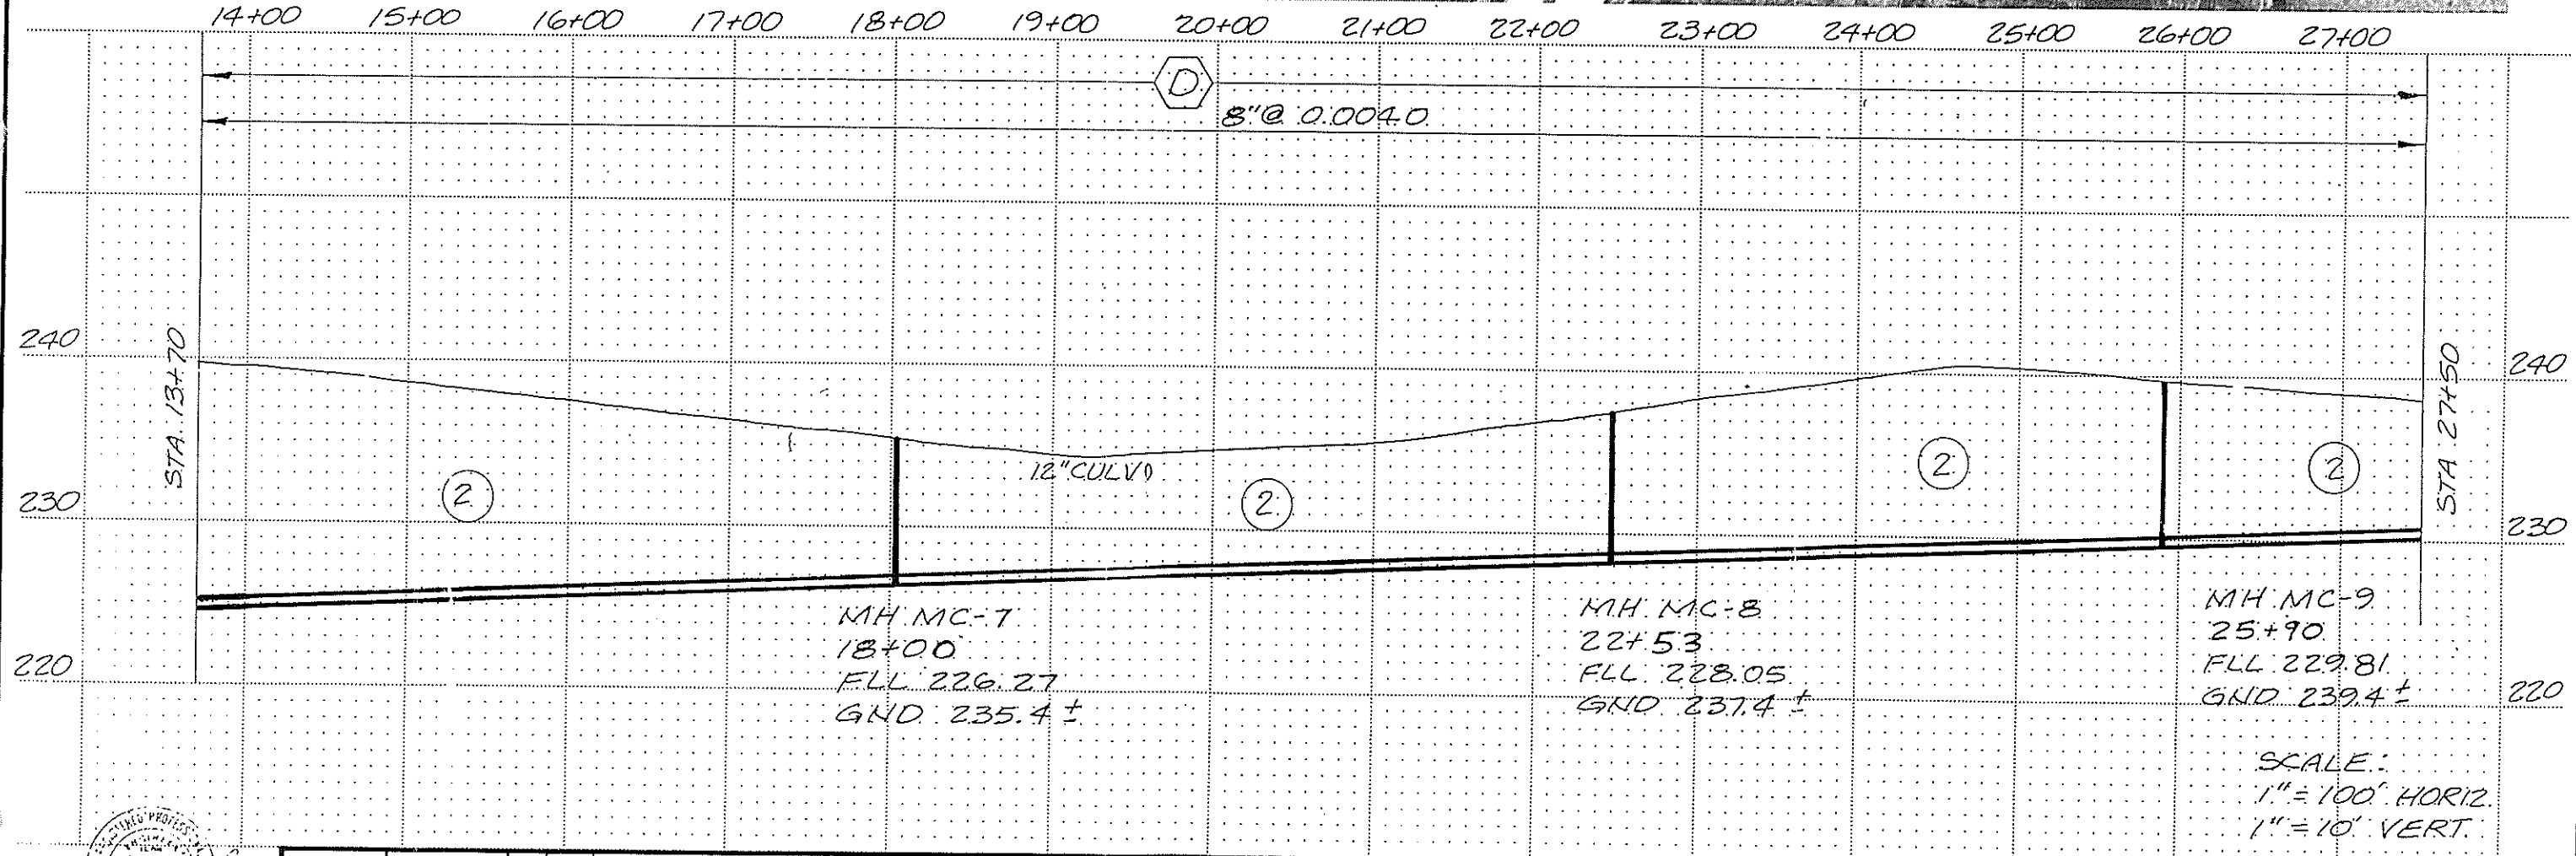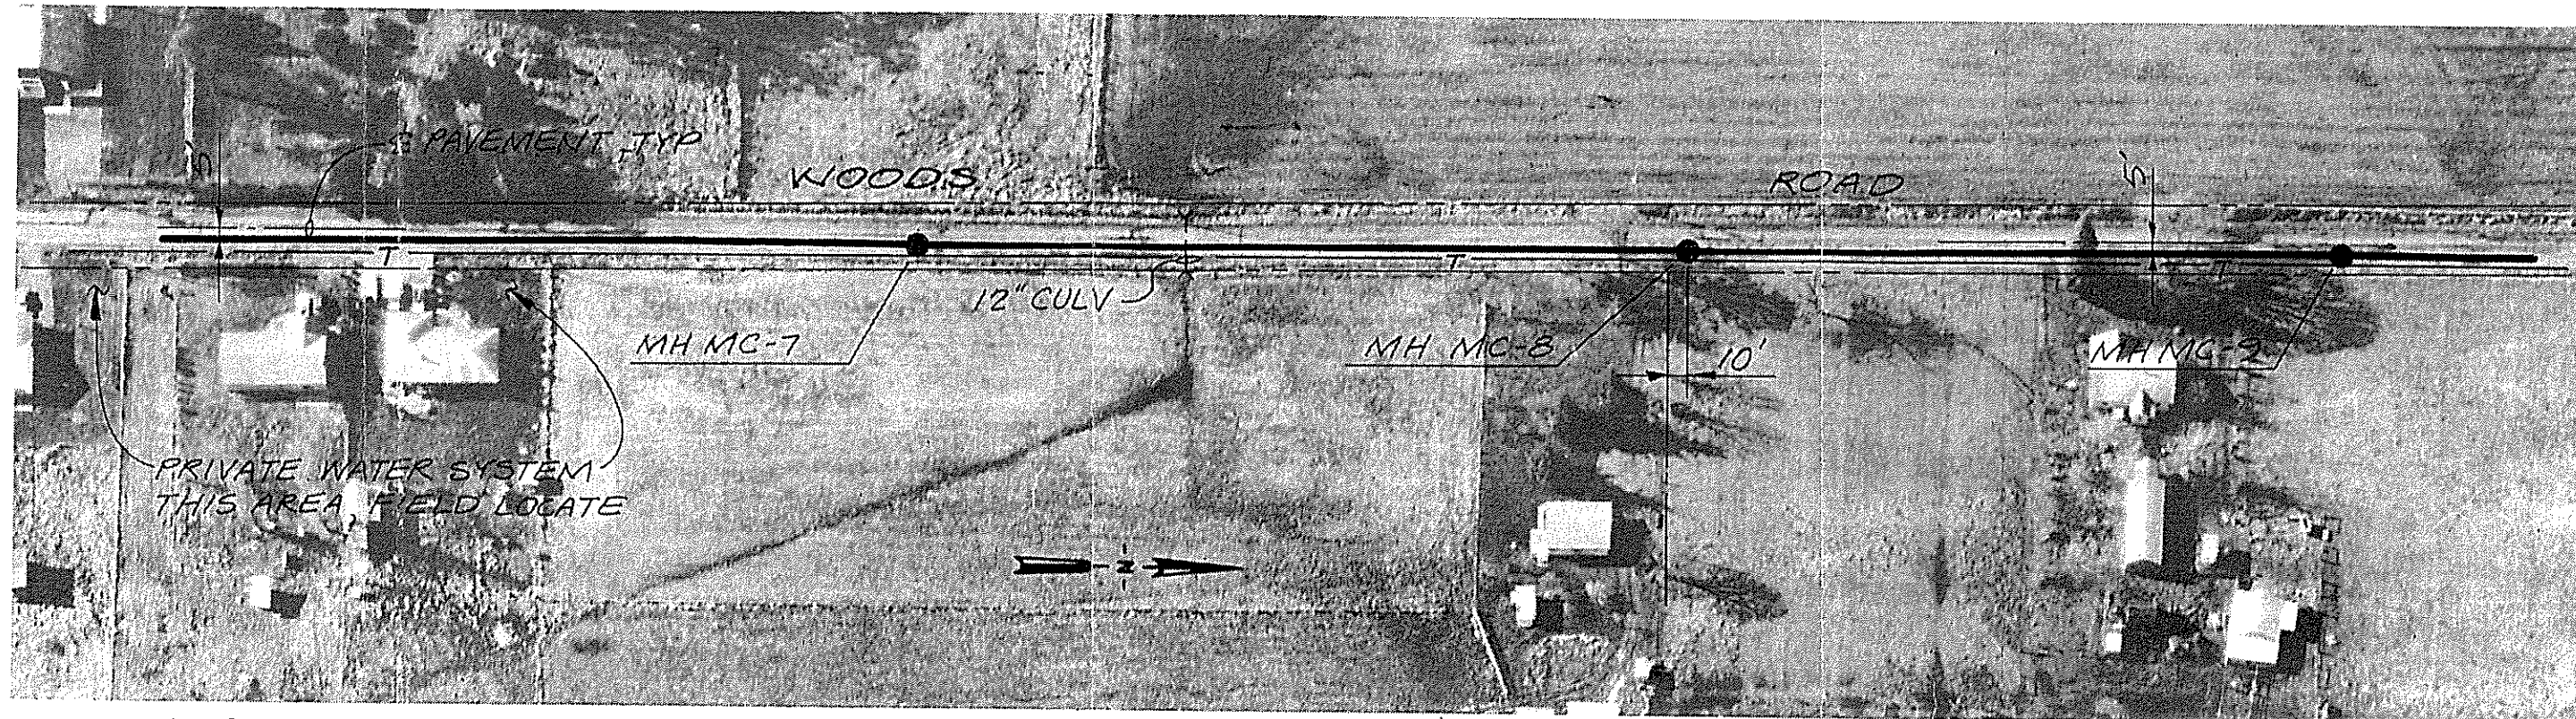

MH MC-7
18+00
FLL 226.27
GND 235.4 ±

MH MC-8
22+53
FLL 228.05
GND 237.4 ±

MH MC-9
25+90
FLL 229.81
GND 239.4 ±

SCALE:
1" = 100' HORIZ
1" = 10' VERT.




DES. GGS				
DR. GGS				
CHK. TMG	12/83	RECORD DWG.	JLM	
APPD. DAC	NO.	DATE	BY	APPD.

SANITARY SEWAGE COLLECTION SYSTEM
CONTRACT NO 4


CITY OF MILLERSBURG
LINN COUNTY, OREGON

MILLERSBURG SEWER "MC" LINE
PLAN AND PROFILE
STA 13+70 TO STA 27+50

SHEET 3
OF 8
DATE JULY 83
DWG. E17195 A1
NO.

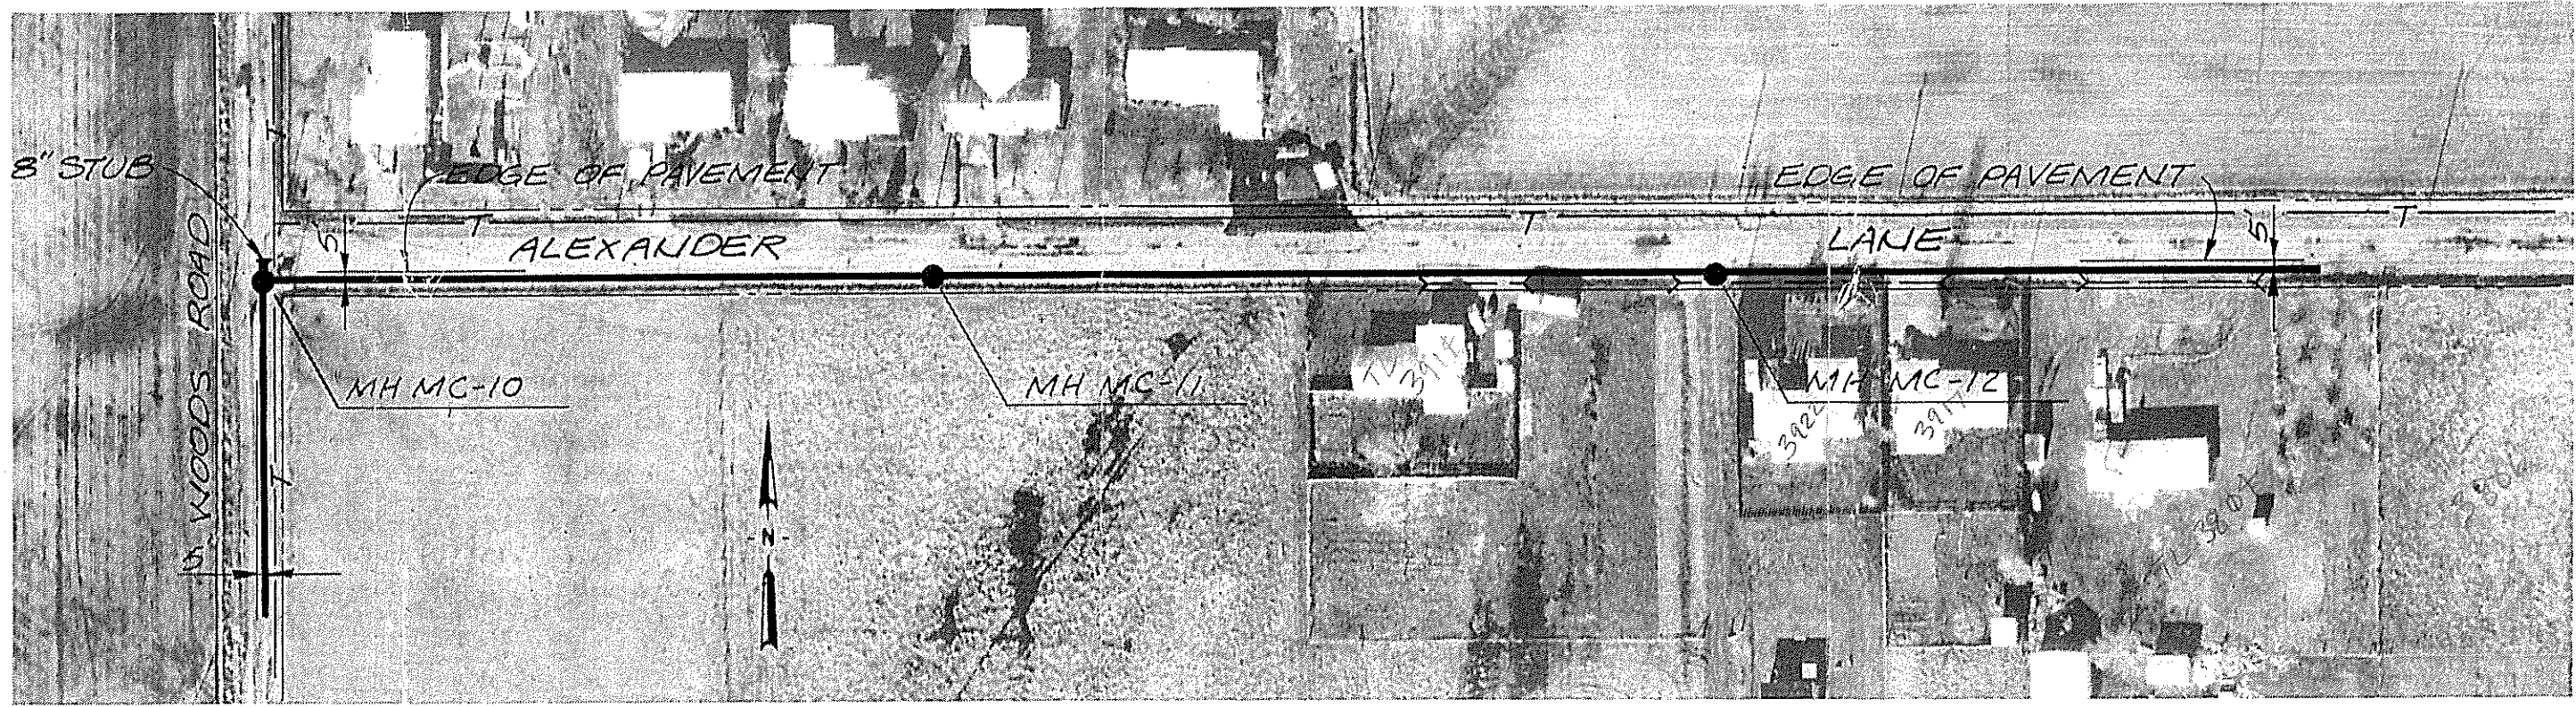

28+00 29+00 30+00 31+00 32+00 33+00 34+00 35+00 36+00 37+00 38+00 39+00 40+00 41+00

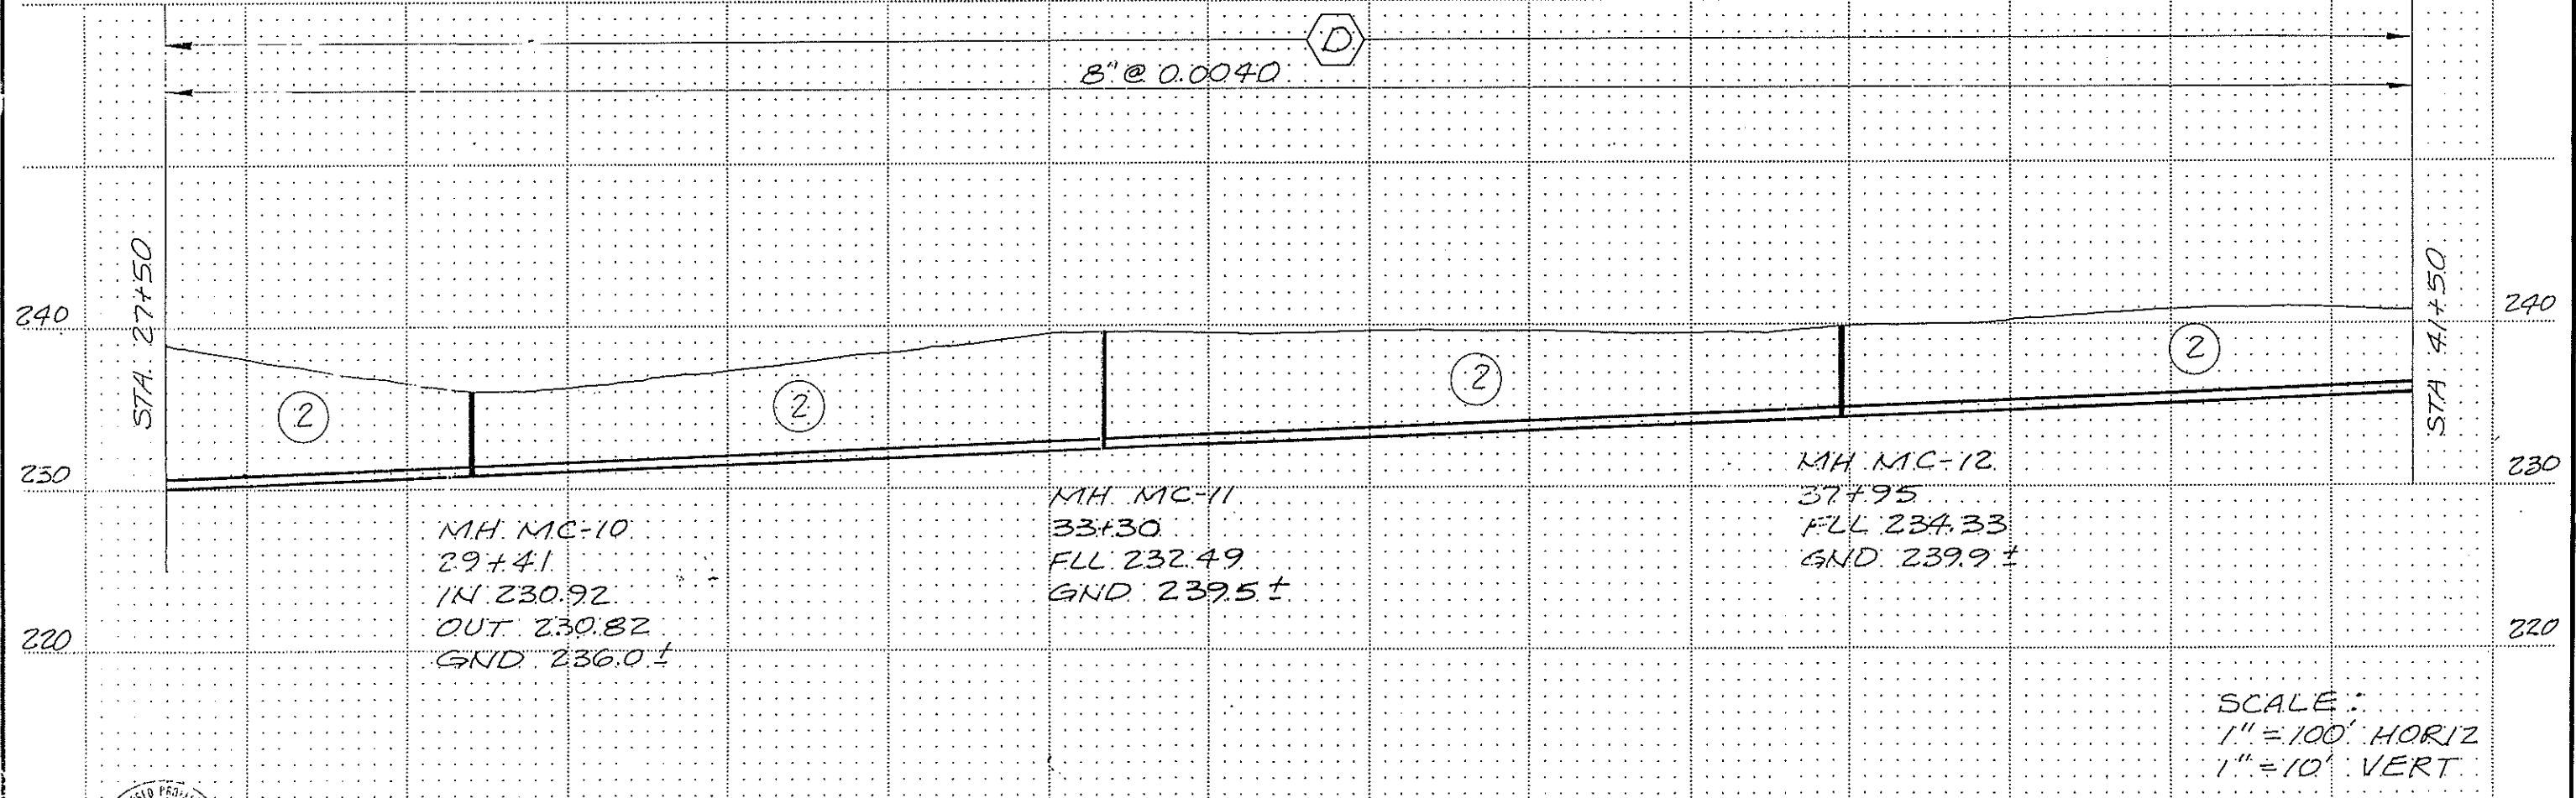



	DES. GGS	NO.	DATE	REVISION	BY	APPD.			
	DR. GGS								
	CHK. TMG						12/83	RECORD DWG	JLM
	APPD. DAC								

SANITARY SEWAGE COLLECTION SYSTEM
CONTRACT NO 4


CITY OF MILLERSBURG
LINN COUNTY, OREGON

MILLERSBURG SEWER "MC" LINE
PLAN AND PROFILE
STA 27+50 TO STA 41+50

SHEET	4
OF	6
DATE	JULY 83
DWG. NO.	E17195 A1

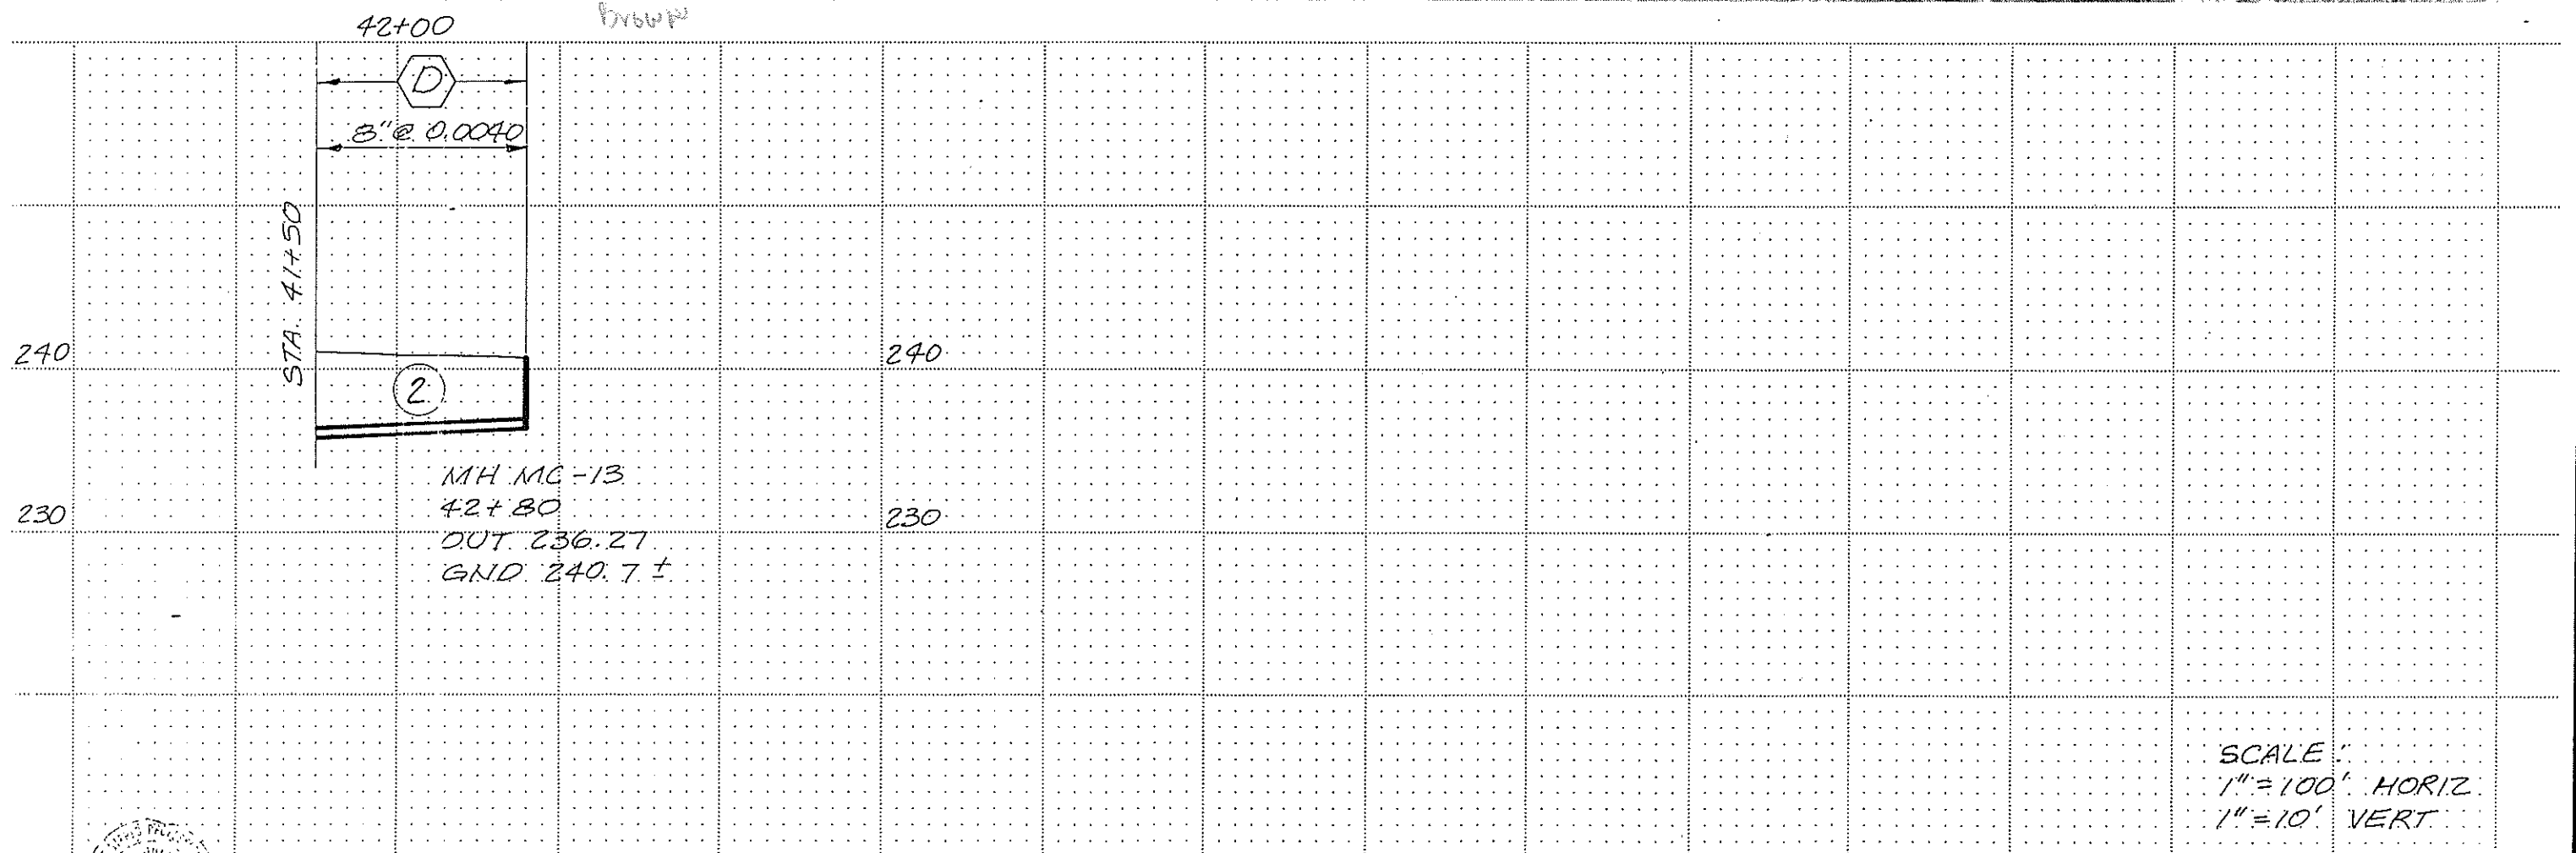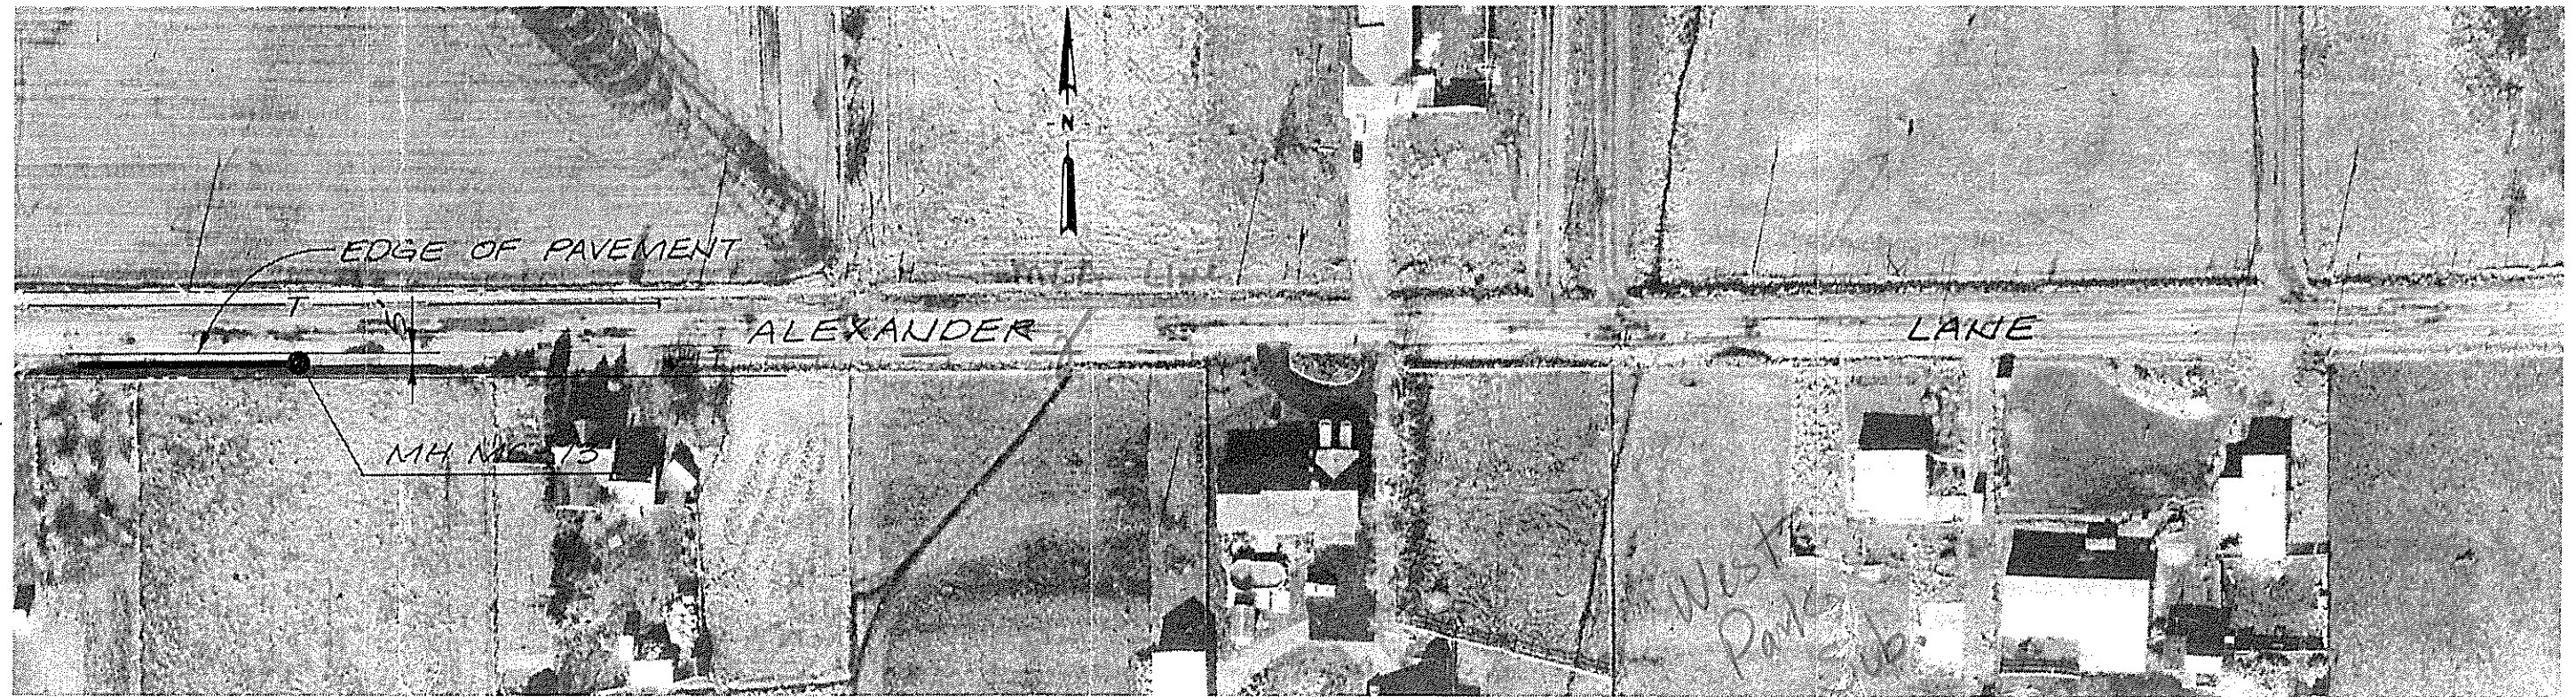

SCALE :
 1" = 100' HORIZ.
 1" = 10' VERT.

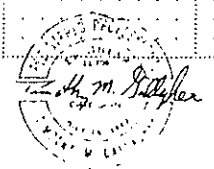

CH2M HILL	OES. EGS	12/83 RECORD DWG	JUN
	DR. EGS		
	CHK. T.M.G.		
	APPD. DAC		
	NO. DATE	REVISION	BY APPD.

SANITARY SEWAGE COLLECTION SYSTEM
 CONTRACT NO 4



CITY OF MILLERSBURG
 LINN COUNTY OREGON

MILLERSBURG SEWER "MC" LINE
 PLAN AND PROFILE
 STA 41+50 TO STA 42+80

SHEET	5
OF	8
DATE	JULY 83
DWG. NO.	E17195 A1

6. Drain Tile Figure with Streets Added

- 4 in 51303.24 ft
- 6 in 3741.24 ft
- 8 in 971.06 ft

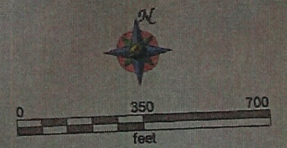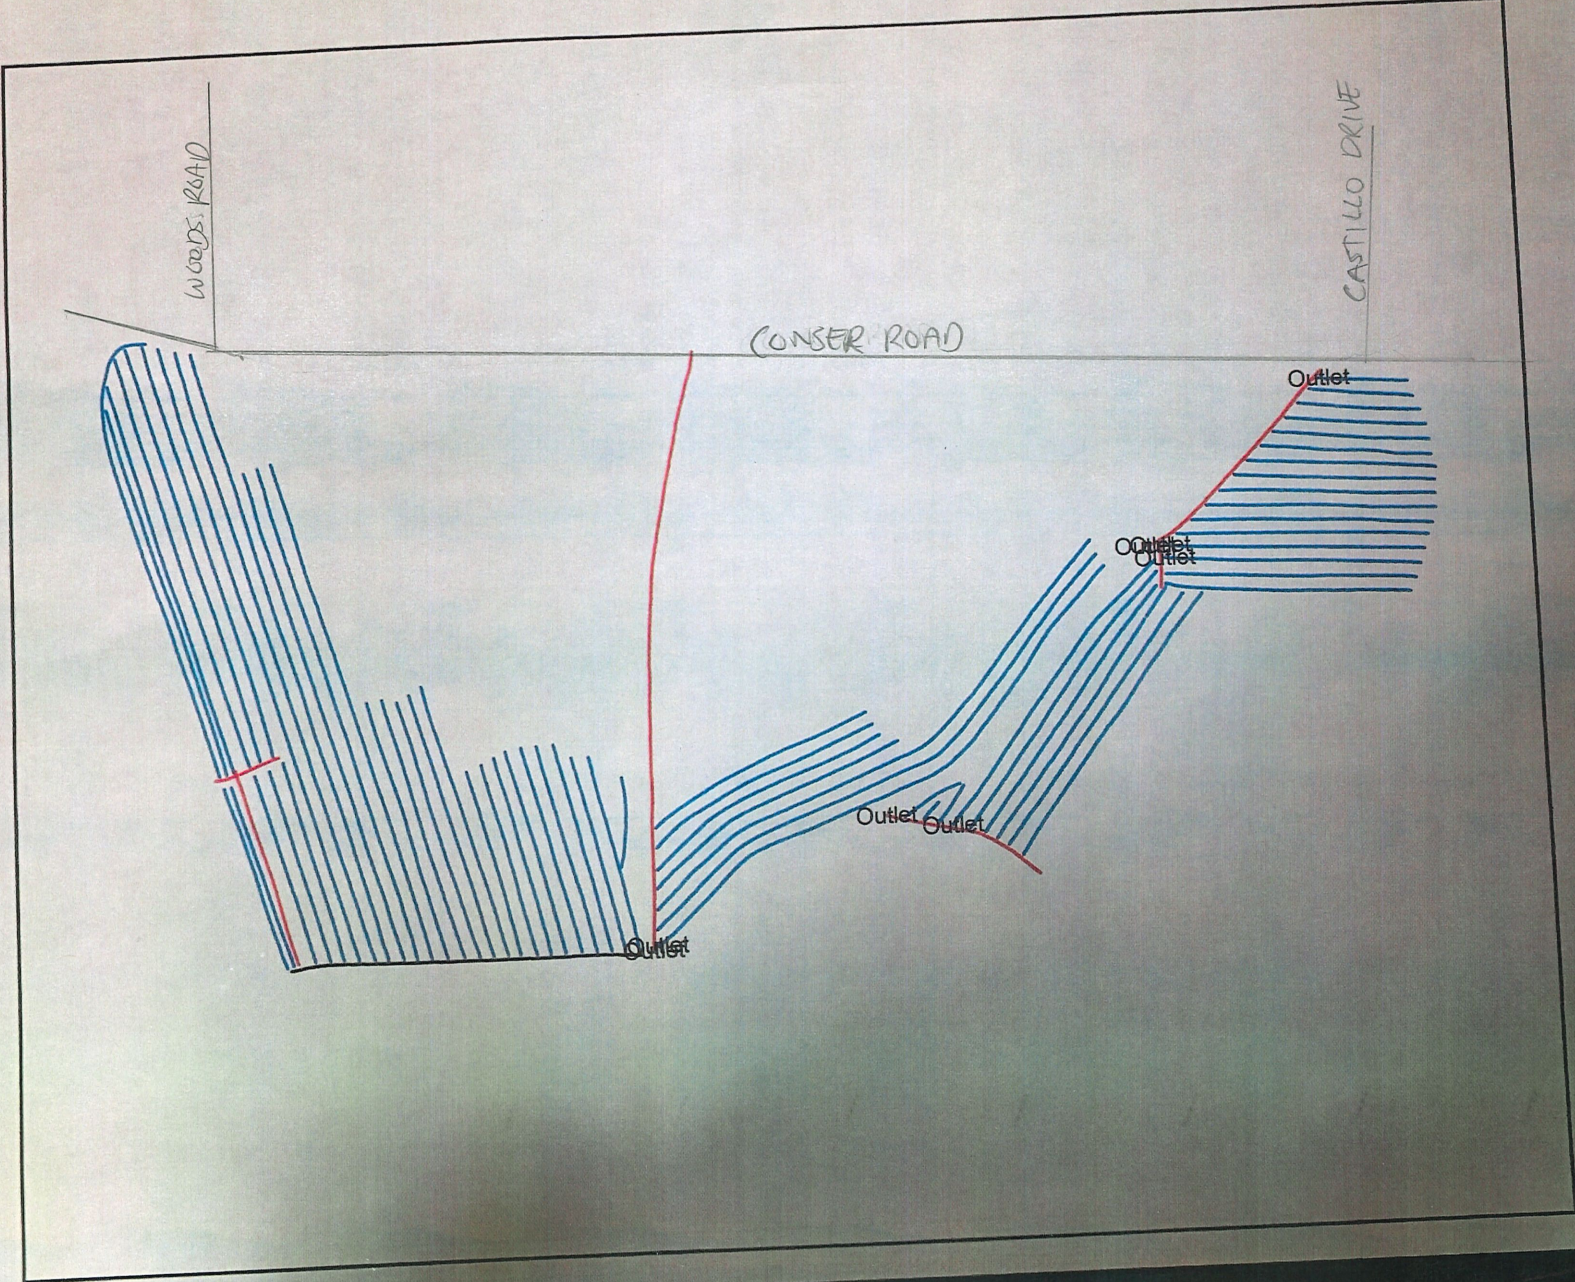

7. Millersburg Fire Station 15 Conformed Civil Drawings



CONCEPTUAL RENDERING


Station 15 Millersburg Fire

3215 Transition Parkway NE
Albany, OR 97321

CONFORM SET
4/2/21

Soderstrom
Architects

VICINITY MAP:

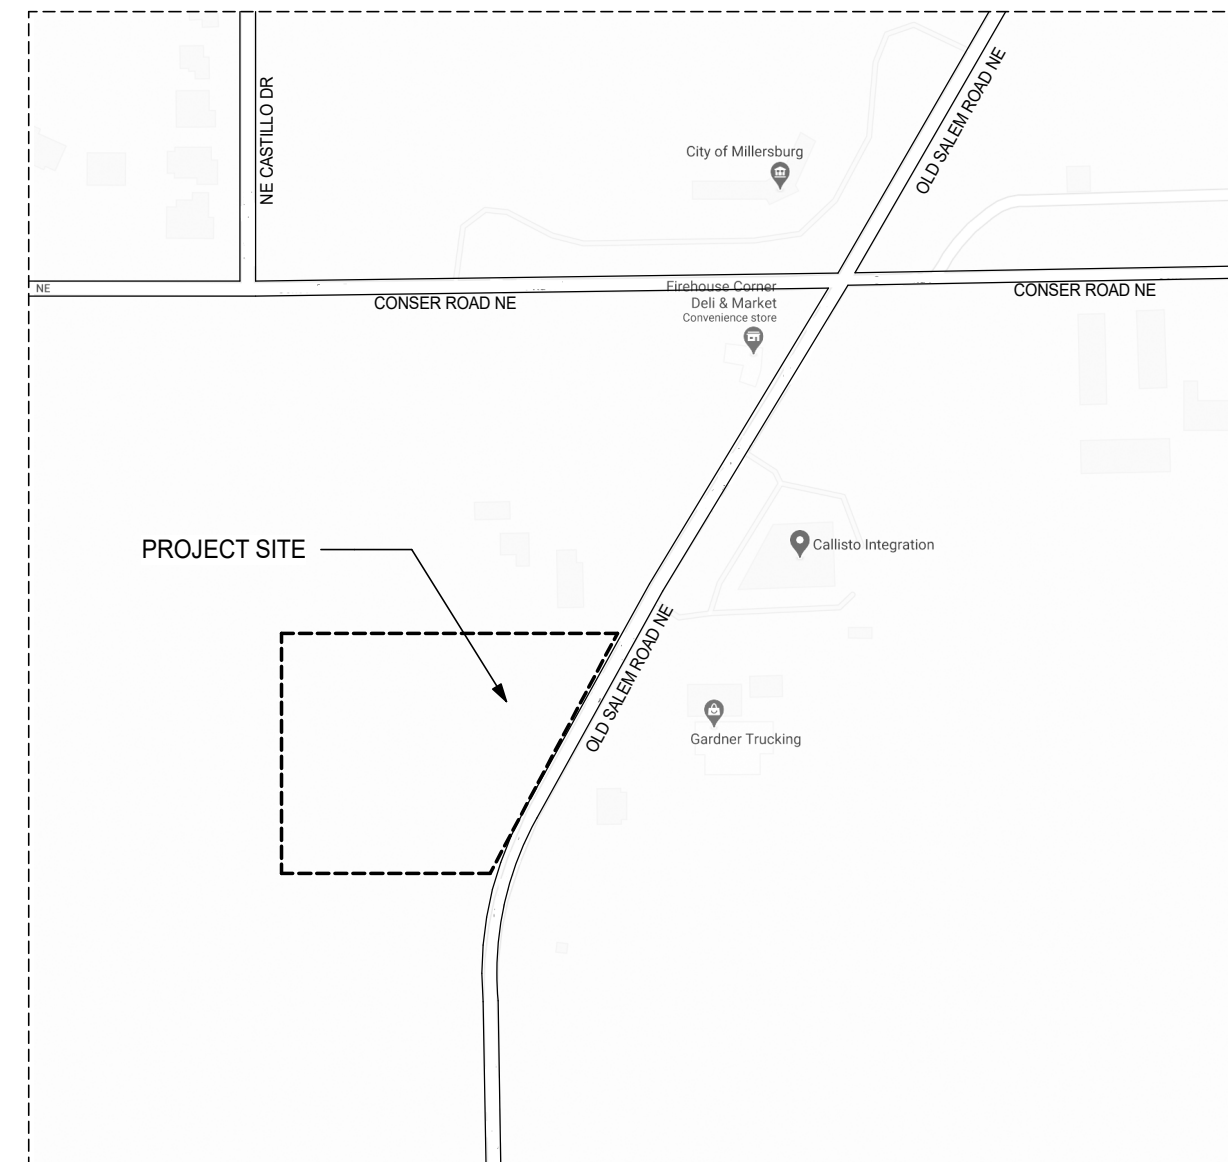

Station 15

PROJECT ADDRESS:

3215 Transition Parkway NE
Albany, OR 97321

PROJECT SUMMARY:

CONSTRUCTION OF A NEW SINGLE-STORY FIRE STATION WITH ROOM FOR 5 APPARATUS AND DORMATORIES FOR SIX ALONG WITH A COMMUNITY MEETING ROOM.

PROJECT TEAM

OWNER

CITY OF MILLERSBURG
cityofmillersburg.org
4222 NE Old Salem Road
Millersburg, OR 97321
(458) 233-6300
Kevin Kreitman, City Manager
Janelle Booth, Assistant City Manager

CIVIL ENGINEER

CROW ENGINEERING
www.crowengineering.com
9925 SW Nimbus Ave, Suite 110
Beaverton, OR 97008
(503) 213-2013
Joe Kurth, PE, Vice President/Director of Engineering

ARCHITECT

SODERSTROM ARCHITECTS, LTD.
www.sdra.com
1200 NW Natio Parkway, Suite 410
Portland, OR 97209
(503) 228-5617
Fax: (503) 273-8584
Dan VanCalcar, Principal
Erica Jankowski, Project Manager/Architect

LANDSCAPE ARCHITECT

SODERSTROM ARCHITECTS, LTD.
www.sdra.com
1200 NW Natio Parkway, Suite 410
Portland, OR 97209
(503) 228-5617
Fax: (503) 273-8584
Laurence Ferar, PLA

STRUCTURAL ENGINEER

CROW ENGINEERING
www.crowengineering.com
9925 SW Nimbus Ave, Suite 110
Beaverton, OR 97008
(503) 213-2013
Joe Kurth, PE, Vice President/Director of Engineering

MECHANICAL / ELECTRICAL / PLUMBING ENGINEERS

CORBIN CONSULTING ENGINEERS
www.corbinengineering.com
1905 NW 169th PL, Suite 121
Beaverton, OR 97006
(503) 645-0176
Mike Machinski, Project Principal

DEFERRED SUBMITTALS

REFER TO SPECIFICATION SECTION 01 3000 AND 01 4000 FOR BIDDER DESIGN REQUIREMENTS FOR BOTH AHJ REVIEW ITEMS AND NON-AHJ DEFERRED ITEMS. SUBMITTAL DOCUMENTS FOR AHJ DEFERRED SUBMITAL ITEMS SHALL BE SUBMITTED TO THE ARCHITECT OF RECORD BY THE GENERAL CONTRACTOR. ARCHITECT AND APPROPRIATE ENGINEER OF RECORD SHALL REVIEW AND RETURN. THE GENERAL CONTRACTOR SHALL THEN FORWARD AHJ SUBMITTAL ITEMS TO THE BUILDING OFFICAL FOR AHJ APPROVAL WITH A NOTATION INDICATING THAT THE DEFERRED SUBMITTAL DOCUMENTS HAVE BEEN REVIEWED AND THAT THEY HAVE BEEN FOUND IN GENERAL CONFORMANCE WITH THE DESIGN OF THE BUILDING. THE AHJ DEFERRED SUBMITAL ITEMS SHALL NOT BE INSTALLED UNTIL THEIR DESIGN AND SUBMITAL DOCUMENTS HAVE BEEN APPROVED BY THE BUILDING OFFICIAL.

AUTHORITY HAVING JURISDICTION (AHJ) DEFFERRED SUBMITTAL ITEMS:

- PRECAST ARCHITECTURAL CONCRETE AND ATTACHMENTS, DIVISION 03
- FIRE SPRINKLER SYSTEM, DIVISION 21
- FIRE ALARM, DIVISION 28
- STRUCTURAL ENGINEERING FOR MECHANICAL SYSTEM SEISMIC RESTRAINTS
- STRUCTURAL ENGINEERING FOR OPEN WEB JOISTS, DIVISION 6
- LANDSCAPE IRRIGATION DESIGN

SEE SPECIFICATION SECTION 01 4000 SUBMITTAL REQUIREMENTS FOR NON-AHJ BIDDER DESIGNED/ENGINEERED ITEMS.

SHEET INDEX

01 - GENERAL

G0.01	COVER SHEET
G1.01	PROJECT INFO
G2.01	NOTES, SYMBOLS, LEGENDS, AND ABBREVIATIONS
G2.02	ACCESSIBILITY DETAILS
G3.01	FIRE LIFE SAFETY PLANS
FD1.00	FIRE ACCESS PLAN

03 - ARCHITECTURAL

A0.01	EXTERIOR ASSEMBLIES
A0.11	INTERIOR ASSEMBLIES
A0.12	INTERIOR ASSEMBLIES
A0.21	INTERIOR ASSEMBLIES
A1.01	ARCHITECTURAL SITE PLAN
A2.01	OVERALL FLOOR PLAN
A2.02	LIVING QUARTERS FLOOR PLAN
A2.03	OVERALL ROOF PLAN
A2.04	MEZZANINE PLAN
A3.01	EXTERIOR ELEVATIONS
A3.02	EXTERIOR ELEVATIONS
A3.11	OVERALL BUILDING SECTIONS
A3.21	EXTERIOR WALL SECTIONS
A3.22	EXTERIOR WALL SECTIONS
A3.23	EXTERIOR WALL SECTIONS
A3.24	EXTERIOR WALL SECTIONS
A3.25	INTERIOR WALL SECTIONS
A4.01	ENLARGED KITCHEN PLANS AND ELEVATIONS
A4.02	ENLARGED MEETING ROOM PLAN AND ELEVATIONS
A4.03	ENLARGED RESTROOM PLANS AND ELEVATIONS
A4.04	SCREENING ENCLOSURES
A4.05	LIFE JACKET KIOSK
A5.01	INTERIOR ELEVATIONS
A5.02	INTERIOR ELEVATIONS
A5.03	INTERIOR ELEVATIONS
A6.01	OVERALL REFLECTED CEILING PLAN
A7.01	VERTICAL CIRCULATION
A8.01	DOOR SCHEDULE AND FRAME TYPES
A8.02	EXTERIOR OPENING TYPES
A8.11	EXTERIOR WALL DETAILS
A8.12	EXTERIOR OPENING DETAILS
A8.13	EXTERIOR OPENING DETAILS
A8.14	ENTRY DETAILS
A8.20	ROOF DETAILS
A8.50	EXTERIOR SIGNAGE
A8.51	SITE DETAILS
A9.01	INTERIOR DETAILS - GENERAL
A9.21	INTERIOR DETAILS - CEILINGS
A9.22	INTERIOR DETAILS - CEILINGS
A9.31	INTERIOR DETAILS - CASEWORK
A9.32	INTERIOR DETAILS - CASEWORK
EQ1.01	EQUIPMENT SCHEDULE

04 - INTERIORS

I2.01	FINISH SUMMARY / SCHEDULE
I9.01	INTERIOR FINISH DETAILS

05 - STRUCTURAL

S0.10	STRUCTURAL NOTES & SCHEDULES
S0.11	STRUCTURAL NOTES & SCHEDULES
S0.20	SPECIAL INSPECTION REQUIREMENTS
S1.01	FOUNDATION PLAN
S2.01	SHEAR WALL PLAN
S3.00	ROOF PLANS A AND D
S3.01	ROOF PLANS B AND C
S3.02	MEZZANINE AND DORM FRAMING PLANS
S3.03	ENLARGED ROOF CORNER PLANS
S3.25	SNOW LOAD DRIFT PLAN
S3.50	FRAMING ELEVATIONS
S3.51	FRAMING ELEVATIONS
S3.52	FRAMING ELEVATIONS
S3.53	FRAMING ELEVATIONS
S4.03	FOUNDATION DETAILS
S4.04	FOUNDATION DETAILS
S4.06	FOUNDATION DETAILS
S5.01	FRAMING DETAILS
S5.02	FRAMING DETAILS

S5.03	FRAMING DETAILS
S5.04	FRAMING DETAILS
S5.05	FRAMING DETAILS
S5.06	FRAMING DETAILS

06 - CIVIL

C0.10	GENERAL NOTES
C0.20	EXISTING CONDITIONS AND DEMOLITION PLAN
C1.00	SITE PLAN
C1.10	NORTH SITE PLAN ENLARGEMENT
C1.20	SOUTH SITE PLAN ENLARGEMENT
C2.00	GRADING PLAN
C2.10	NORTH SITE GRADING PLAN ENLARGEMENT
C2.20	SOUTH SITE GRADING PLAN ENLARGEMENT
C2.30	SOUTH ROW GRADING PLAN
C2.40	WEST ROW GRADING PLAN
C3.00	SITE UTILITY PLAN
C3.10	SOUTH ROW UTILITY PLAN AND PROFILE
C3.20	WEST ROW UTILITY PLAN AND PROFILE
C3.30	NORTH SANITARY SEWER PLAN AND PROFILE
C3.40	SOUTH ROW STORM PLAN AND PROFILE
C3.50	WEST ROW STORM PLAN AND PROFILE
C3.60	WEST STORM OUTFALL PLAN AND PROFILE
C4.00	DETAILS
C4.10	DETAILS
C4.20	DETAILS
C4.30	STANDARD DETAILS
C4.40	STANDARD DETAILS
C4.50	STANDARD DETAILS
C4.60	STANDARD DETAILS
C4.70	STANDARD DETAILS

07 - LANDSCAPE

L0.01	LANDSCAPING SITE PLAN
L0.02	LANDSCAPING COURTYARD PLAN
L0.03	POND & SWALE PLAN

08 - MECHANICAL

M0.01	MECHANICAL LEGEND, ABBREVIATIONS, & GENERAL
M1.01	MECHANICAL GROUND FLOOR PLAN
M5.01	MECHANICAL DETAILS
M5.02	MECHANICAL DETAILS
M6.01	MECHANICAL SCHEDULES
M6.02	MECHANICAL SCHEDULES

09 - PLUMBING

P0.01	PLUMBING/PIPING LEGEND, ABBREVIATIONS, & GENERAL NOTES
P1.01	PLUMBING BELOW GRADE FLOOR PLAN
P1.02	PLUMBING GROUND FLOOR PLAN
P5.01	PLUMBING DETAILS
P6.01	PLUMBING SCHEDULES

10 - ELECTRICAL

E0.01	ELECTRICAL LEGEND, ABBREVIATIONS, & GENERAL NOTES
E1.01	ELECTRICAL SITE PLAN
E1.02	ELECTRICAL POWER GROUND FLOOR PLAN - WEST
E4.01	ENLARGED ELECTRICAL PLAN
E5.01	ELECTRICAL DETAILS
E5.02	ELECTRICAL DETAILS
E6.01	ELECTRICAL ONE-LINE DIAGRAM AND GROUNDING RISER DIAGRAMS
E6.02	ELECTRICAL SCHEDULES
E6.03	ELECTRICAL TAP OUT SYSTEM INTERCONNECTION DIAGRAM
EL1.01	ELECTRICAL SITE LIGHTING PLAN
EL1.02	ELECTRICAL LIGHTING GROUND FLOOR PLAN - WEST
EL1.03	ELECTRICAL LIGHTING CONTROLS PLAN
EV1.01	ELECTRICAL LOW VOLTAGE GROUND FLOOR PLAN - WEST

1200 NW Naito Parkway, Suite 410
Portland, OR 97209

T 503-228-5617
F 503-227-8584

sdra.com




Project

Consultant

Revisions

No.	Description	Date
1	Pre-Bid Revisions	2/3/21

Stamp

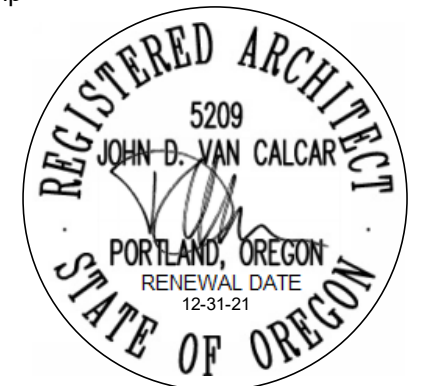

Issuance

CONFORM SET

Date

4/2/21

Project Number

20006

Drawing Title

PROJECT INFO

Sheet No

G1.01

PROJECT NOTES

- CONSTRUCTION SHALL BE IN CONFORMANCE WITH THE CURRENT EDITION OF THE CITY OF ALBANY STANDARD CONSTRUCTION SPECIFICATIONS (AS ADOPTED BY THE CITY OF MILLERSBURG), THE PROJECT SPECIFICATIONS, CONSTRUCTIONS DRAWINGS, AND THESE SPECIAL PROVISIONS. IN SITUATIONS WHERE SPECIFICATION REQUIREMENTS DIFFER, THE MORE STRINGENT REQUIREMENT SHALL APPLY.
- THE CONSTRUCTION CONTRACT IS FOR THE CONSTRUCTION OF A COMPLETE AND FULLY FUNCTIONING INSTALLATION. THESE DOCUMENTS DESCRIBE THE DESIGN INTENT AND SPECIFIC REQUIREMENTS OF THE INSTALLATION. THESE DOCUMENTS DO NOT INTEND TO SHOW EVERY ITEM REQUIRED TO CONSTRUCT THE WORK. ITEMS SUCH AS FASTENERS, CONNECTORS, FILLERS, MISCELLANEOUS CLOSURE ELEMENTS, ANCILLARY CONTROL WIRING AND POWER WHERE REQUIRED FOR THE CONTROL OR OPERATION OF THE PROVIDED EQUIPMENT ARE NOT ALWAYS SHOWN BUT ARE CONSIDERED INCLUDED IN THE SCOPE OF THE WORK. IT IS THE RESPONSIBILITY OF THE CONTRACTOR TO PROVIDE A FULLY FUNCTIONING INSTALLATION WHICH MEETS THE DESIGN INTENT, INCLUDING THE SPECIFIC REQUIREMENTS INCLUDED IN THESE DOCUMENTS.
- ALL ITEMS IN THESE DOCUMENTS ARE NEW UNLESS OTHERWISE NOTED.
- THESE DOCUMENTS DESCRIBE A SINGLE CONSTRUCTION CONTRACT. THE USE OF SUBCONTRACTORS IS THE ELECTION OF THE CONTRACTOR. THESE DOCUMENTS DO NOT INTEND TO DIVIDE THE WORK AMONG THE CONTRACTOR'S SUBCONTRACTORS. WHERE THE DOCUMENTS IDENTIFY WORK WHICH IS "NOT IN MECHANICAL WORK" OR "NOT IN ELECTRICAL WORK" IT MEANS THAT WORK IS NOT FURTHER DESCRIBED OR SPECIFIED IN THE MECHANICAL OR ELECTRICAL DRAWINGS OR SPECIFICATIONS. IT DOES NOT PRECLUDE THE CONTRACTOR FROM DELEGATING THE WORK TO THE ENTITIES OF HIS ELECTION. IN ADDITION THE DIVISION OF THE CONTRACT DOCUMENTS INTO ARCHITECTURAL, STRUCTURAL, MECHANICAL, ELECTRICAL AND OTHER DESIGN DISCIPLINES NEITHER DIVIDES THE WORK FOR THOSE DISCIPLINES AS SHOWN ONLY IN THOSE DRAWINGS OR SPECIFICATIONS.
- ITEMS INDICATED IN THIS SET NOTED "BY OWNER" ARE NOT IN THE CONTRACT (N.I.C.)
- UNLESS OTHERWISE NOTED, IT IS THE RESPONSIBILITY OF THE GENERAL CONTRACTOR AND THE SUBCONTRACTORS TO REVIEW ALL DRAWINGS, PROJECT MANUAL, ADDENDA, ETC. IN ORDER TO ASSURE THE COORDINATION OF ALL WORK AFFECTING EACH TRADE. FAILURE TO REVIEW AND COORDINATE ALL CONTRACT DOCUMENTS BY THE GENERAL CONTRACTOR WITH ALL THE SUBCONTRACTORS FOR APPLICABLE ITEMS OF THE WORK SHALL NOT RELIEVE THE RESPONSIBLE PARTY FROM PERFORMING ALL WORK SO REQUIRED AS PART OF THE CONTRACT.
- UNLESS OTHERWISE NOTED, THE PROJECT MANUAL, WHICH INCLUDES THE GENERAL CONDITIONS, SUPPLEMENTAL CONDITIONS, AND TECHNICAL SPECIFICATIONS, AND THE DRAWINGS ARE COMPLEMENTARY AND TOGETHER DESCRIBE THE PROJECT REQUIREMENTS. WHERE THERE ARE DISCREPANCIES BETWEEN THE PROJECT MANUAL AND THE DRAWINGS, THE CONTRACTOR SHALL ADVISE THE ARCHITECT AND REQUEST A CLARIFICATION. THE ORDER OF PRECEDENCE BETWEEN THE DRAWINGS AND THE PROJECT MANUAL IS AS DEFINED IN THE PROJECT MANUAL.
- UNLESS OTHERWISE NOTED, THE CONTRACTOR SHALL LAYOUT AND SEQUENCE THE INSTALLATION OF THE WORK SO THAT THE DIFFERENT SYSTEMS DO NOT OBSTRUCT THE INSTALLATION OF SUCCESSIVE WORK. IN GENERAL, SYSTEMS INSTALLED FIRST SHOULD BE KEPT AS HIGH AND TIGHT TO STRUCTURE AS POSSIBLE TO LEAVE SPACE AVAILABLE FOR SYSTEMS WHICH FOLLOW.
- REFER TO THE PROJECT MANUAL FOR SPECIFICATIONS, GENERAL INFORMATION, PRODUCTS AND EXECUTION REQUIREMENTS. REQUIREMENTS OF THE SPECIFICATIONS APPLY TO ALL ASPECTS OF THE WORK AND ARE INCLUDED AS ADDITIONAL INFORMATION FOR EACH ITEM SPECIFIED. IF DISCREPANCIES EXISTS BETWEEN THE SPECIFICATIONS AND DRAWINGS, THE MORE STRINGENT REQUIREMENTS SHALL PREVAIL. THE GENERAL CONTRACTOR SHALL NOTIFY THE OWNER'S REPRESENTATIVES OF ANY DISCREPANCIES.
- THE DRAWINGS SHALL NOT BE SCALED. THE GENERAL CONTRACTOR SHALL REFER TO THE DIMENSIONS INDICATED OR THE ACTUAL SIZES OF CONSTRUCTION ITEMS. WHERE NO DIMENSIONS OR METHOD OF DETERMINING A LOCATION IS GIVEN, VERIFY CORRECT DIMENSIONS OR LOCATION WITH THE OWNER'S REPRESENTATIVE PRIOR TO INSTALLATION.
- THE DRAWINGS AND REFERENCED DETAILS HAVE BEEN DIMENSIONED IN ORDER TO ESTABLISH THE CONTROL AND GUIDELINES FOR FIELD LAYOUT. WHERE A DISCREPANCY EXISTS BETWEEN THE DRAWING AND THE DETAIL THE CONTRACTOR SHALL NOTIFY THE OWNER'S REPRESENTATIVE FOR CLARIFICATION PRIOR TO INSTALLATION.
- DIMENSIONS ARE TO FACE OF STUD UNLESS OTHERWISE NOTED.
- WHERE DIMENSIONS ARE NOTED TO BE VERIFIED IN THE FIELD (V/F) THE DIMENSION SHOWN IS THE DESIGN BASIS, BUT MAY DIFFER FROM ACTUAL CONDITIONS. CONTRACTOR SHALL VERIFY THESE DIMENSIONS WHILE LAYING OUT THE WORK AND REPORT ANY DISCREPANCIES BETWEEN THE DESIGN BASIS AND ACTUAL DIMENSIONS TO THE OWNER'S REPRESENTATIVE PRIOR TO PROCEEDING WITH THE WORK. WHERE DIMENSIONS ARE NOTED "+/-" FIELD DIMENSIONS MAY VARY FROM THE NOTED DIMENSIONS BY MINOR AMOUNTS. IF THE CONTRACTOR IDENTIFIES DIMENSIONS IN THE FIELD THAT DIFFER BY MORE THAN 1" FROM THE +/- DIMENSIONS INDICTED IN THE DRAWINGS, THE CONTRACTOR SHOULD CONFIRM DIFFERENTIAL WITH ARCHITECTS.
- INTERIOR DETAILS ARE KEYED TO THE PLANS AT TYPICAL LOCATIONS. TYPICAL DETAILS APPLY TO ALL LOCATIONS WHICH ARE SIMILAR BUT ARE NOT OTHERWISE DETAILED. THE CONTRACTOR AND SUBCONTRACTORS ARE RESPONSIBLE TO COORDINATE THE LOCATION OF TYPICAL DETAILS AND INSTALL THE WORK INDICATED. IF DISCREPANCIES EXIST OR QUALIFICATION IS REQUIRED, THE CONTRACTOR SHALL NOTIFY THE OWNER'S REPRESENTATIVE FOR CLARIFICATION PRIOR TO PROCEEDING.
- INTERIOR FINISHES ARE KEYED TO THE DRAWINGS AT TYPICAL LOCATIONS. THE FINISHES APPLY TO ALL LOCATIONS WHICH ARE SIMILAR BUT ARE NOT OTHERWISE DETAILED. CONTRACTOR AND SUBCONTRACTORS ARE RESPONSIBLE TO COORDINATE THE LOCATION ALL TYPICAL DETAILS AND INSTALL THE WORK INDICATED. IF DISCREPANCIES EXIST OR QUALIFICATION IS REQUIRED, THE CONTRACTOR SHALL NOTIFY THE OWNER'S REPRESENTATIVE FOR CLARIFICATION PRIOR TO PROCEEDING.
- ABBREVIATIONS ON THIS SHEET APPLY TO THE ENTIRE SET UNLESS OTHERWISE NOTED.
- WALL FIRE RATING INDICATIONS ON THE FLOOR PLANS SHOW EXTENT OF FIRE RATED PARTITION. FIRE RATING IN A PARTITION SHALL CONTINUE OVER DOOR OR WINDOW OPENING WHETHER OR NOT THEY APPEAR IN PLAN.
- IT IS THE GENERAL CONTRACTOR'S RESPONSIBILITY TO VERIFY SIZE AND INVERT ELEVATION OF OPENINGS / SLEEVES THROUGH CONCRETE AND MASONRY WALLS AND CONCRETE FOUNDATION WALLS. OPENINGS / SLEEVES ARE NOT LIMITED TO THOSE SHOWN ON STRUCTURAL DRAWING SHEETS.
- IT IS THE RESPONSIBILITY OF THE GENERAL CONTRACTOR TO COORDINATE AND MAKE PROVISIONS FOR ALL PIPE / CONDUIT SLEEVES THROUGH CONCRETE WALLS.
- ELEVATIONS ARE TO TOP OF CONCRETE OR OTHER HARD SURFACE MATERIAL.
- DETAILS ARE INTENDED TO SHOW METHOD AND MANNER OF ACCOMPLISHING THE WORK. MINOR MODIFICATIONS MAY BE REQUIRED TO SUIT JOB DIMENSIONS OR CONDITIONS AND SHALL BE INCLUDED AS PART OF THE WORK.
- THE CONTRACTOR SHALL VERIFY ALL DIMENSIONS, ELEVATIONS AND EXISTING CONDITIONS AT THE SITE BEFORE COMMENCING WORK AND REPORT ANY DISCREPANCIES TO THE ARCHITECT PRIOR TO START OF THE WORK. IN CASE OF CONFLICT BETWEEN ARCHITECTURAL AND CONSULTANTS DRAWINGS, THE ARCHITECT WILL DETERMINE THE CORRECT INTENTION OF THE WORK.
- THE BUILDING SHALL BE PROVIDED WITH A FULL SPRINKLER SYSTEM COMPLYING WITH APPLICABLE CODES OF THE AUTHORITY HAVING JURISDICTION.
- NOTES AND DETAILS ON DRAWINGS SHALL TAKE PRECEDENCE OVER GENERAL NOTES, SYMBOLS, AND TYPICAL DETAILS. SPECIFIC NOTES ON DETAILS APPLY TO SIMILAR CONDITIONS UNLESS NOTED OTHERWISE (UNO / UON).
- WHERE FIRE RATED OPENING PROTECTION IS REQUIRED, THE FIRE DOORS AND SMOKE AND DRAFT CONTROL ASSEMBLIES INSTALLED IN CORRIDOR OPENINGS SHALL BE TESTED AND LABELED IN ACCORDANCE WITH OSSC CURRENT EDITION SECTION 714. IN ACCORDANCE WITH THE REQUIREMENTS OF THE LISTED ASSEMBLY, THE MANUFACTURER'S INSTALLATION INSTRUCTIONS SHALL BE PROVIDED WITH EACH ASSEMBLY FOR INSTALLATION AND FOR REVIEW BY THE INSPECTION AUTHORITY.

ABBREVIATIONS

#	POUND OR NUMBER	FA	FIRE ALARM	PAR	PARAPET
A/C	AIR CONDITIONING	FAF	FLUID APPLIED FLOORING	PERF	PERFORATE(D)
AV	AUDIO VISUAL	FD	FLOOR DRAIN, FIRE DAMPER	PJT	PANEL JOINT
AB	ANCHOR BOLT	FE(C)	FIRE EXTINGUISHER (CABINET)	PLAM	PLASTIC LAMINATE
AC	ASPHALTIC CONCRETE	FF	FINISH FLOOR	PLATF	PLATFORM
ACM	ALUMINUM COMPOSITE METAL	FFE	FURNISHINGS FIXTURES AND EQUIPMENT	PNL	PANEL
ACT	ACOUSTICAL CEILING TILE	FGL	FIBERGLASS	PNT	PAINT
AD	AREA DRAIN	FHC	FIRE HOSE CABINET	PSF	POUNDS PER SQUARE FOOT
ADD	ADDENDUM	FHMS	FLATHEAD MACHINE SCREW	PSI	POUNDS PER SQUARE INCH
ADH	ADHESIVE	FHW	FLATHEAD WOOD SCREW	PT	PRESSURE TREATED, POINT DISPENSER
ADJ	ADJUSTABLE, ADJACENT	FL	FLOOR	PTD	PARTIAL
AFF	ABOVE FINISH FLOOR	FLASHG	FLASHING	PTN	PARTION
AGG	AGGREGATE	FLCO	FLOOR CLEANOUT	PVC	POLYVINYL CHLORIDE
AHJ	AUTHORITY HAVING JURISDICTION	FLR	FLOOR(ING)	PWD	PLYWOOD
AL(UM)	ALUMINUM	FLS	FIRE LIFE SAFETY	QT	QUARRY TILE
ALT	ALTERNATE	FLUOR	FLUORESCENT	RA	RETURN AIR
ANOD	ANODIZED	FND(N)	FOUNDATION	RAD	RADIUS
AP	ACCESS / ACOUSTIC PANEL	FOC	FACE OF CONCRETE	RB	RESILIENT BASE
APPROX	APPROXIMATE	FOF	FACE OF FINISH	RCP	REFLECTED CEILING PLAN
ARCH	ARCHITECT(URAL)	FOS	FACE OF STEEL/STUD	RD	ROOF DRAIN
AUTO	AUTOMATIC	FP	FIREPROOFING	REF(R)	REFER(ENCE), REFRIGERATOR
BATT	BATT INSULATION	FR	FRAME(D), FRAMING	REIN(F)	REINFORCE(D), REINFORCING
BD	BOARD	FS	FULL SIZE, FLAME SPREAD	REQ(D)	REQUIRED
BIT	BITUMINOUS	FT	FIRE TREATED	REV	REVISION(S), REVISED
BLDG	BUILDING	FTG	FOOTING	RH	RIGHT HAND
BLKG	BLOCKING	GA	GAUGE	RM	ROOM
BM	BENCH MARK	GALV	GALVANIZED	RND	ROUND
BO	BOTTOM OF	GB	GRAB BAR, GYPSUM BOARD	RO	ROUGH OPENING
BOL	BOLLARD	GL	GLASS, GLAZING, GRIDLINE	S	SOUTH
BOT	BOTTOM	GWB	GYPSUM WALL BOARD	SA	SUPPLY AIR
BR(N)Z	BRONZE	GYP (BD)	GYPSUM (BOARD)	SAM	SELF-ADHERED MEMBRANE
BSMT	BASEMENT	HB	HOSE BIB	SC	SOLID CORE
CAB	CABINET	HBD	HARDBOARD	SCHED	SCHEDULE
CB	CATCH BASIN	HC	HOLLOW CORE	SEC(T)	SECTION
CCTV	CLOSED CIRCUIT TV	HD	HEAVY DUTY	SIM	SIMILAR
CEM	CEMENT	HDR	HEADER	SL	SLEEVE
CF	CUBIC FOOT	HDW(R)	HARDWARE	SPEC(S)	SPECIFICATION(S)
CG	CORNER GUARD	HM	HOLLOW METAL	SQ	SQUARE
CI	CONTINUOUS INSULATION	HOR(I)Z	HORIZONTAL	SS	STAINLESS STEEL
CJ(T)	CONTROL JOINT	HR	HOUR	STD	STANDARD
CL	CENTERLINE	HT	HEIGHT	STL	STEEL
CLG	CEILING	HTG	HEATING	STRUCT	STRUCTURAL
CLR	CLEAR(ANCE)	HVAC	HEATING, VENTILATION, AND AIR CONDITIONING	SUPP	SUPPLEMENT, SUPPLY
CMU	CONCRETE MASONRY UNIT	HWD	HARDWOOD	SUSP	SUSPENDED
COL	COLUMN	ID	INSIDE DIAMETER	SV	SHEET VINYL
CONC	CONCRETE	INCL	INCLUDE(D), INCLUDING	TB, TCKBD	TACKBOARD
CONST	CONSTRUCTION	INS(UL)	INSULATE(D), INSULATION	TEL	TELEPHONE
CONT	CONTINUE, CONTINUOUS	INT	INTERIOR	TEMP	TEMPERED, TEMPERATURE
COORD	COORDINATE	JAN(T)	JANITOR	TG, T&G	TONGUE AND GROOVE
CPT	CARPET	JC	JANITOR'S CLOSET	TO	TOP OF
CRS	COURSE	JT	JOINT	TOC	TOP OF CURB, TOP OF CONCRETE
CS	COUNTERSINK	KO	KNOCK-OUT	TOF	TOP OF FRAMING
CSMT	CASEMENT	LAM	LAMINATE(D)	TOP	TOP OF PARAPET
CT	CERAMIC TILE	LAV	LAVATORY	TOPL	TOP OF PLATE
CTR	CENTER	LH	LEFT HAND	TOR	TOP OF ROOF
CUST	CUSTODIAL	LW	LIGHTWEIGHT	TOS	TOP OF STEEL
CX	CONNECTION	MAX	MAXIMUM	TOW	TOP OF WALL
CY	CUBIC YARD	MB	MACHINE BOLT, MARKER BOARD	TS	TUBE STEEL
DEM(O)	DEMOLISH, DEMOLITION	MECH	MECHANICAL	TYP	TYPICAL
DEP	DEPRESSED	MEZZ	MEZZANINE	U/C	UNDERCOUNTER
DF	DRAINING FOUNTAIN	MFR	MANUFACTURE(R)	UNO, UNO	UNLESS NOTED OTHERWISE
DIA	DIAMETER	MGR	MANAGER	VB	VAPOR BARRIER
DIAG	DIAGONAL	MH	MANHOLE	VCT	VINYL COMPOSITION TILE
DIM	DIMENSION	MIN	MINIMUM	VERT	VERTICAL
DISP	DISPENSER	MISC	MISCELLANEOUS	VEST	VESTIBULE
DIV	DIVISION	MO	MASONRY OPENING	VFY	VERIFY
DL	DEAD LOAD	MOD	MODULAR	VIF	VERIFY IN FIELD
DMT	DEMOUNTABLE	MP	METAL PANEL	W	WEST
DN	DOWN	MRGB	MOISTURE RESISTANT GYPSUM WALL BOARD	W/	WITH
DR	DOOR	MTL	METAL	W/O	WITHOUT
DS	DOWNSPOUT	MULL	MULLION	WC	WATER CLOSET
DTL	DETAIL	MWP	MEMBRANE WATERPROOFING	WD	WOOD
DWG(S)	DRAWING(S)	N	NORTH	WP	WATERPROOF(ING)
DWR	DRAWER	NAT	NATURAL	WS	WATERSTOP
E	EAST	NIC	NOT IN CONTRACT	WWF	WELDED WIRE FABRIC
EA	EACH	NOM	NOMINAL	XPS	EXTRUDED POLYSTYRENE
EB	EXPANSION BOLT	NTS	NOT TO SCALE	YD	YARD
EJ	EXPANSION JOINT	OA	OVERALL	±	PLUS OR MINUS
EL, ELEV	ELEVATION	OC	ON CENTER	ø	DIAMETER
ELEC	ELECTRIC(AL)	OD	OUTSIDE DIAMETER		
EMER(G)	EMERGENCY	OH	OVERHEAD		
ENCL	ENCLOSURE(URE)	OPG	OPENING		
EOS	EDGE OF SLAB	OPP	OPPOSITE		
EP	ELECTRICAL PANEL BOARD	OVHD	OVERHEAD		
EPDM	ETHYLENE PROPYLENE DIENEMONOMER				
EQ	EQUAL				
EQUIP	EQUIPMENT				
EST	ESTIMATE				
EXH	EXHAUST				
EXIST(E)	EXISTING				
EXP	EXPOSED, EXPANSION				
EXT	EXTERIOR				

SYMBOLS LEGEND

1 A101 BUILDING SECTION MARK
1=SECTION NO.
A101= SHEET NO.

1 A101 WALL SECTION MARK
1=SECTION NO.
A101= SHEET NO.

1 A101 EXTERIOR ELEVATION MARK
1=SECTION NO.
A101= SHEET NO.

4 A101 2 3 INTERIOR ELEVATION MARK FILLED
1=SECTION NO.
A101= SHEET NO.

1 A101 DETAIL SECTION MARK
1=SECTION NO.
A101= SHEET NO.

1 A101 ENLARGED VIEW MARK
1=SECTION NO.
A101= SHEET NO.

XXXR X XX PARTITION MARK
(REF. PARTITION TYPES)

A1001 DOOR TAG

AA INTERIOR WINDOW MARK

AA EXTERIOR WINDOW MARK

NORTH NORTH ARROW

NAME ELEVATION LEVEL MARK

B.5 GRID HEAD

0000 KEYNOTE - REFER TO LEGEND ON SHEET

99 REVISION CLOUD AND MARK

0 4' 8' 16' GRAPHIC SCALE

ALIGN ALIGN DISCONTINUOUS PLANES

BA36XX CASEWORK TAG (INTERIOR ELEVATIONS)

MATERIALS LEGEND

	BRICK (PLAN/SECTION)		UNDISTURBED EARTH
	BRICK (ELEVATION)		DISTURBED EARTH
	STUCCO		STEEL
	RIGID INSULATION		GYPSUM BOARD
	SPRAY INSULATION		DRAINAGE FILL
	CONCRETE MASONRY		PLYWOOD
	CONCRETE		BLANKET OR LOOSE FILL INSULATION



Project

Consultant

Revisions

No.	Description	Date
-----	-------------	------

Stamp



Issuance

CONFORM SET

Date

4/2/21

Project Number

20006

Drawing Title

NOTES, SYMBOLS, LEGENDS, AND ABBREVIATIONS

Sheet No

G2.01




Project

Consultant

Revisions

No.	Description	Date
2	Addendum #2	3/2/21

Stamp

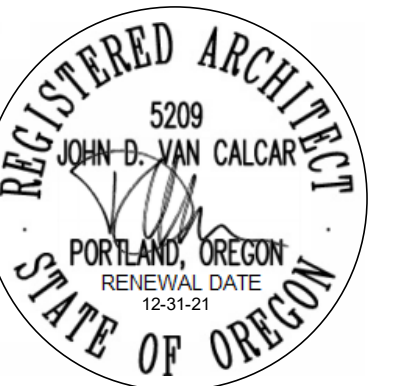

Issuance

CONFORM SET

Date

4/2/21

Project Number

20006

Drawing Title


**ARCHITECTURAL
SITE PLAN**

Sheet No

A1.01

SHEET NOTES


1. ARCHITECTURAL SITE PLAN SHOWN FOR REFERENCE ONLY. REFER TO CIVIL AND LANDSCAPE DRAWINGS FOR SPECIFIC SITE INFORMATION.
2. SEE SHEET A8.50 FOR SIGNAGE DETAILS

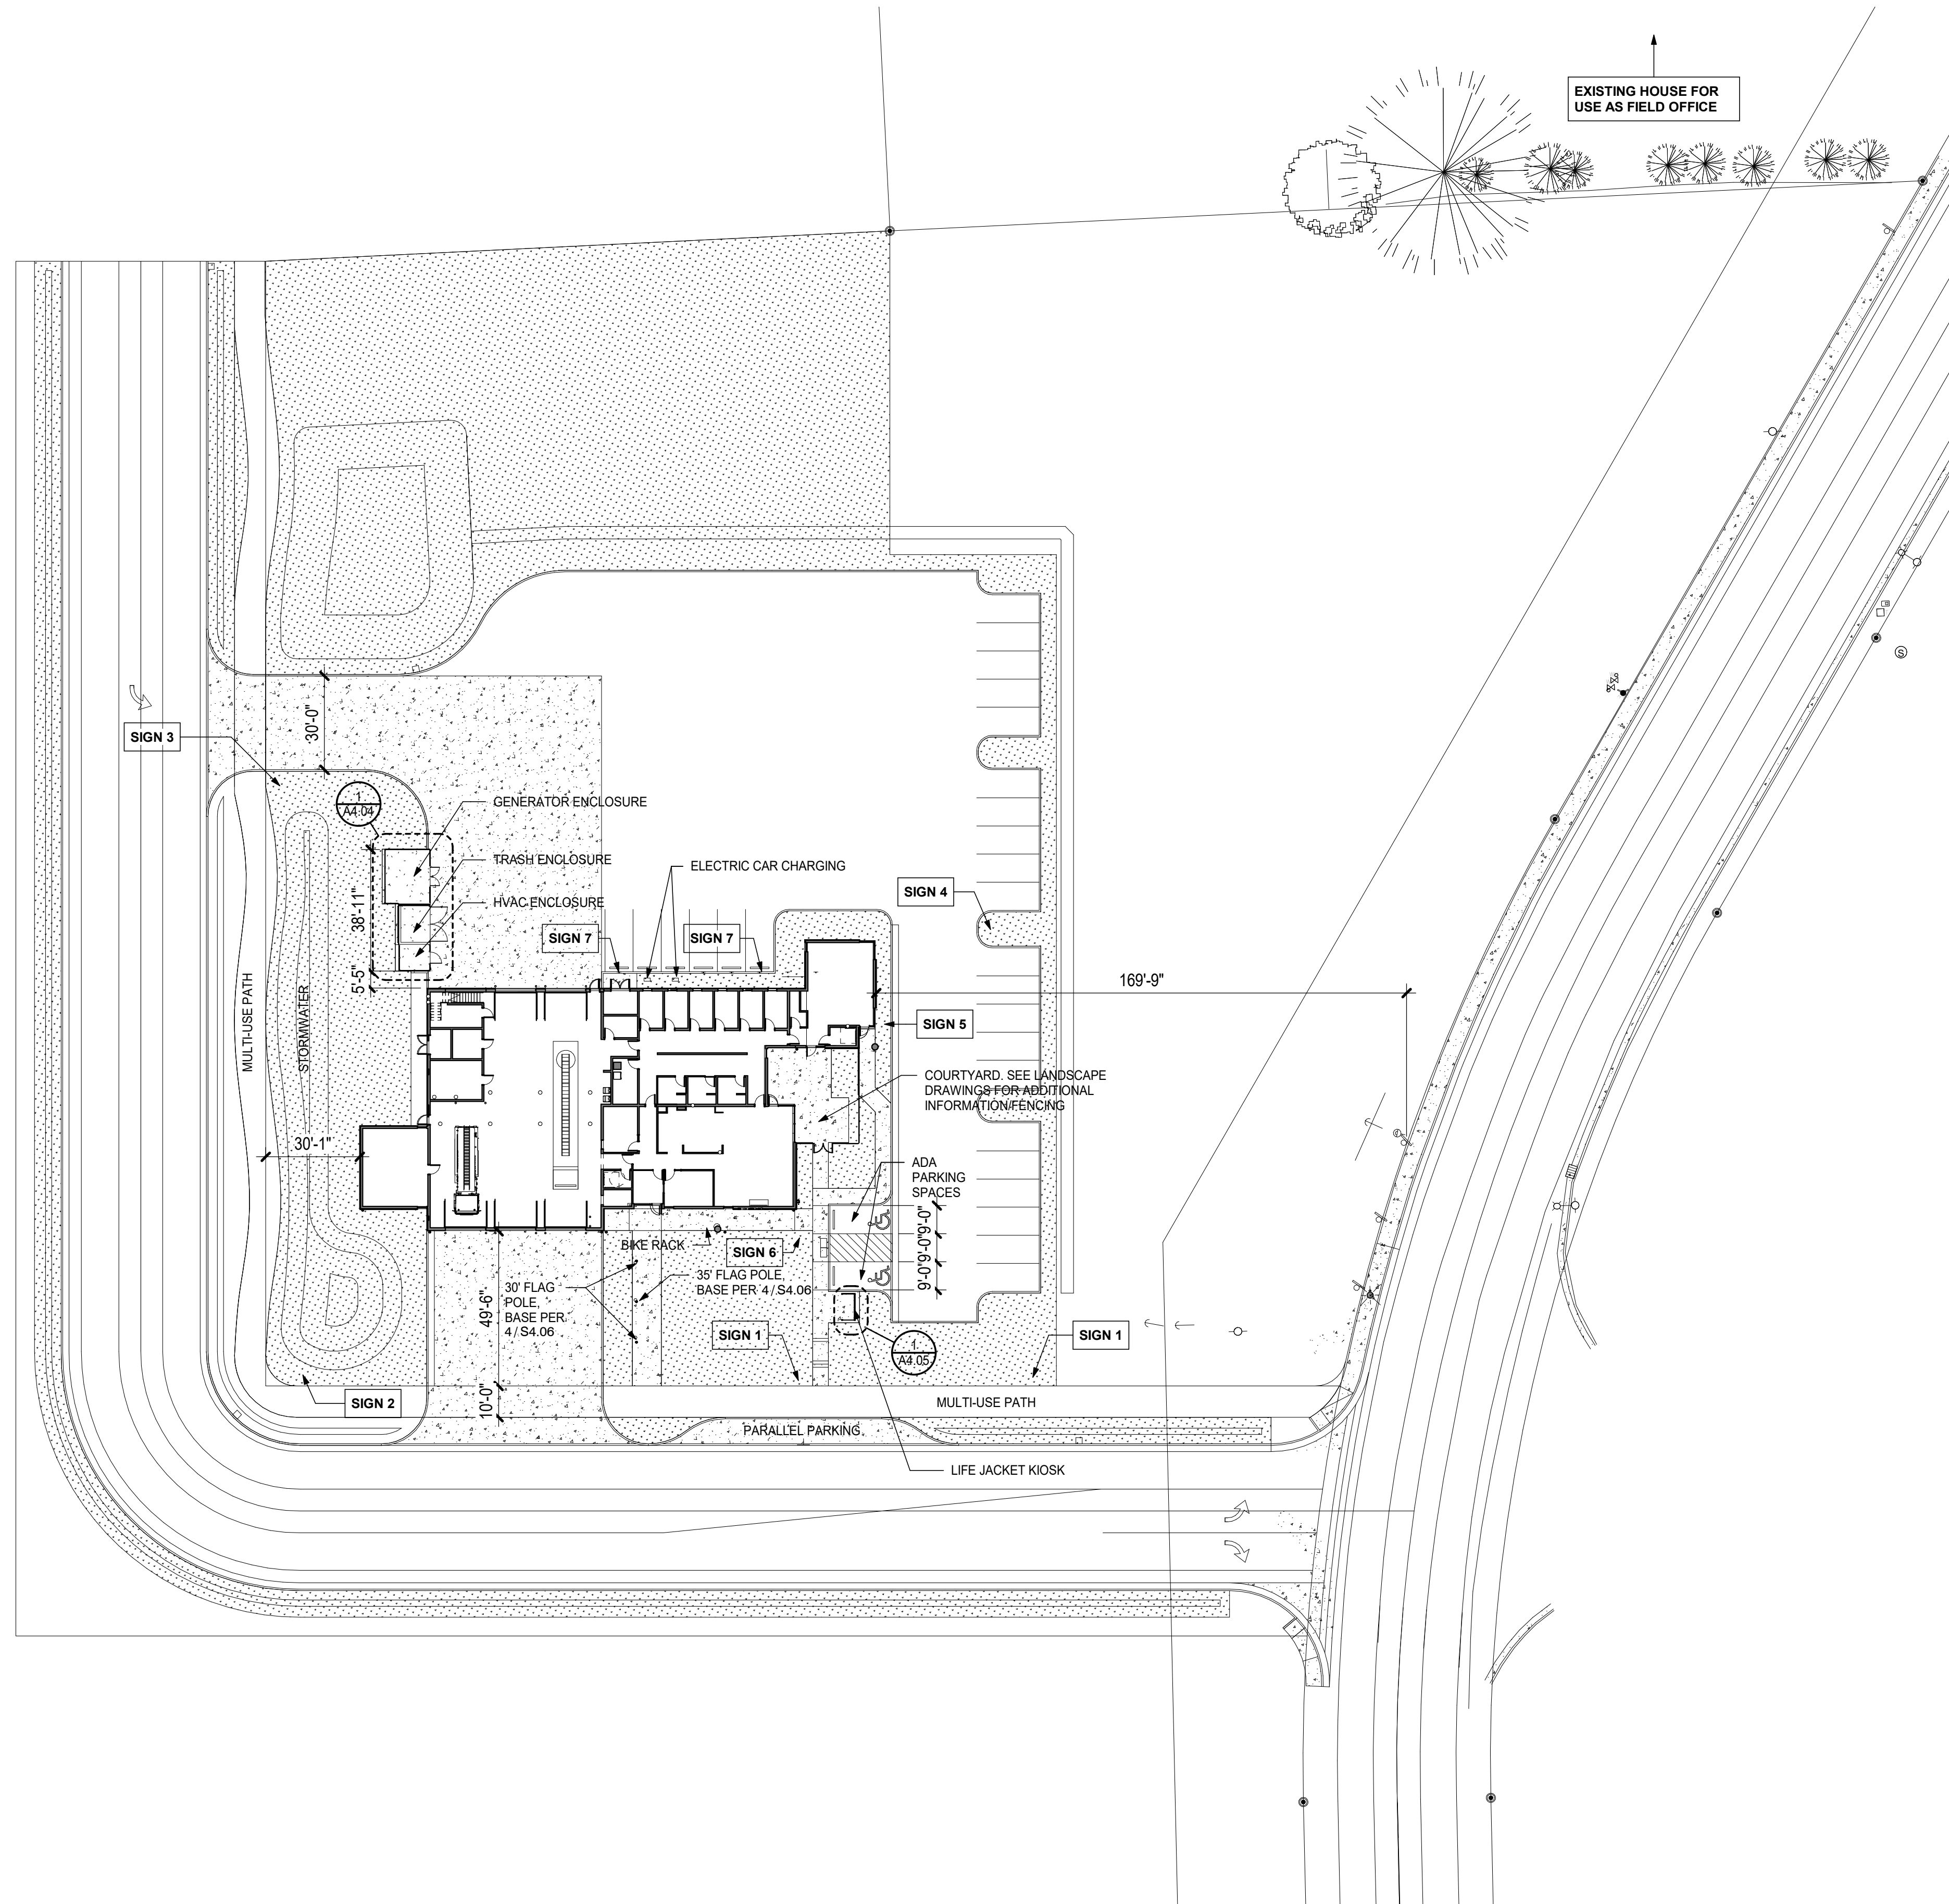

1 OVERALL SITE PLAN
1/32" = 1'-0"



Revisions	No.	Description	Date
	1	Pre-Bid Revisions	2/3/21

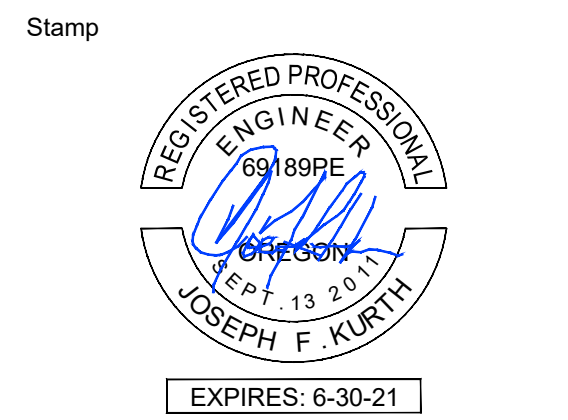

Issuance
CONFORM SET

Date
4/2/21

Project Number
20335

Drawing Title

GENERAL NOTES

Sheet No
C0.10

MASTER CIVIL LEGEND:

LEGENDS ON INDIVIDUAL SHEETS GOVERN OVER THE ITEMS IN THE LEGEND LISTED BELOW

DEMO	EXISTING	NEW	
			CONCRETE
			DEFERRED PAVING
			GRAVEL PAVING
			HMAC PAVING - STANDARD
			HMAC PAVING - HEAVY
			LANDSCAPING
			RIP RAP
			STORMWATER POND
			CONVEYANCE SWALE
			EASEMENT - PER PLAN
			FENCING
			FIBER
			DATA, LOW VOLTAGE
			GRADE BREAK
			IRRIGATION
			NATURAL GAS / PROPANE
			POWER - BURIED
			POWER - OVERHEAD
			PROPERTY LINE
			SANITARY SEWER - GRAVITY
			STORM FOUNDATION DRAIN
			STORM SEWER - PRIVATE
			STORM SEWER - PRIVATE HIDDEN
			STORM SEWER - PUBLIC
			SURFACE CONTOUR - MAJOR (5 FT)
			SURFACE CONTOUR - MINOR (1 FT)
			TELEPHONE - BURIED
			WATER - POTABLE
			WATER - FIRE
			GRADE SPOT ELEVATION
			CONTROL MAGNAIL/PK NAIL
			CATCH BASIN
			BEEHIVE OVERFLOW
			ATRIUM DRAIN
			ROOF DRAIN CONNECTION POINT
			STORM DRAIN CLEANOUT
			STORM DRAIN MANHOLE
			SANITARY SEWER CLEANOUT
			SANITARY SEWER MANHOLE
			FIRE DEPARTMENT CONNECTION
			HYDRANT
			WATER VALVE
			WATER METER
			POWER POLE
			GUY WIRE
			POWER POLE WITH LIGHT
			POWER VAULT
			ON-SITE LIGHTING
			NATURAL GAS MARKER
			GAS VALVE
			GAS METER
			PHONE MANHOLE
			PHONE RISER
			BOLLARD PROTECTION
			CONCRETE CURB STOP
			DECIDUOUS TREE
			CONIFEROUS TREE
			SIGN (SHAPE VARIES)
			HANDICAP PARKING SYMBOL
			DIRECTIONAL ARROWS

ABBREVIATIONS:

AC	ASPHALT
APWA	AMERICAN PUBLIC WORKS ASSOCIATION
ASTM	AMERICAN STANDARD TEST METHOD
BOC	BOTTOM OF CURB
BOS	BOTTOM OF STAIR
CMP	CORRUGATED METAL PIPE
CONC	CONCRETE
DWG	DRAWING
(E)	EXISTING
EG	EXISTING GRADE
FG	FINISHED GRADE
GC	GENERAL CONTRACTOR
GRD	GROUND
GRVL	GRAVEL
HDPE	HIGH-DENSITY POLYETHYLENE
IE	INVERT ELEVATION
MAX	MAXIMUM
MIN	MINIMUM
NGVD	NORTH GEODETIC VERTICAL DATUM
REQD	REQUIRED
ROW	RIGHT-OF-WAY
STD	STANDARD
T/base	TOP OF BASEROCK LAYER
T/sub	TOP OF SUBGRADE LAYER
TBC	TOP BACK OF CURB
TOS	TOP OF STAIR
TYP	TYPICAL

SITE PREPARATION NOTES:

CLEARING & GRUBBING -

- REFER TO STRUCTURAL (FOUNDATION) PLANS FOR SPECIFIC SOIL EXCAVATION & BACKFILL REQUIREMENTS WITHIN BUILDING FOOTPRINT(S).
- ALL AREAS BELOW ROADWAYS, PARKING AND WALKWAYS SHALL BE CLEARED AND GRUBBED OF ALL PAVEMENT, FOREIGN MATTER, DEBRIS, ORGANIC AND DISTURBED MATERIAL, U.N.O. STRIPPING DEPTHS ACROSS THE SITE WILL VARY DEPENDING ON LOCATION AND PAVEMENT SECTION REQUIREMENTS. ALL EXPOSED MATERIAL SHALL BE MOISTURE CONDITIONED TO WITHIN 2% OF OPTIMUM.
- ALL CLEARED AND GRUBBED MATERIAL SHALL BE REMOVED FROM SITE. GC SHALL COORDINATE AN APPROVED DISPOSAL LOCATION.
- ALL AREAS WITH ABANDONED UTILITY LINES, STORM DRAINS, UNDERGROUND TANKS, ETC. WHICH PROVIDE VOID SPACE BENEATH THE SURFACE SHALL BE LOCATED AND REMOVED PRIOR TO SITE GRADING.
- ALL HOLES, DEPRESSIONS, AND UNDISTURBED NATIVE MATERIAL SHALL BE CLEARED OF ALL LOOSE AND ORGANIC MATERIAL THEN BACKFILLED AND COMPACTED WITH APPROVED STRUCTURAL FILL.
- AFTER CLEARING THE ABOVE MENTIONED AREAS, ALL EXPOSED SUB-GRADE SHALL BE PROOF ROLLED WITH A DUMP TRUCK FULLY LOADED WITH ROCK. SOILS SHALL BE REMOVED AND RE-COMPACTED OR REPLACED WITH IMPORTED APPROVED STRUCTURAL FILL IF THEY DO NOT DEMONSTRATE A FIRM, UNYIELDING CONDITION. GEOTECHNICAL ENGINEER SHALL APPROVE SUB-GRADE SURFACE PRIOR TO STRUCTURAL FILL IMPORT EXPLAINED BELOW.

STRUCTURAL FILL PLACEMENT & COMPACTION -

- APPROVED STRUCTURAL FILL SHALL BE PLACED BENEATH AREAS RECEIVING ASPHALT AND/OR CONCRETE PAVEMENT.
- STRUCTURAL FILL SHALL BE APPROVED BY GEOTECHNICAL ENGINEER PER THE REPORT RECOMMENDATIONS AND CITY OF MILLERSBURG SPECIFICATIONS. ALL FILL SHALL BE FREE OF ORGANIC AND EXPANSIVE CLAY MATERIAL.
- PLACEMENT LIFTS TO BE DETERMINED BY GEOTECHNICAL ENGINEER BASED ON MATERIAL PROPERTIES OF STRUCTURAL FILL CHOSEN AND TYPE OF COMPACTION EQUIPMENT USED. BASE ROCK PLACEMENT LIFTS SHALL NOT EXCEED 8". EACH LIFT SHALL BE NEARLY EQUAL IN THICKNESS AND COMPACTED TO A MINIMUM OF 95% OF ASTM D 1557. FILLS SHALL BE PLACED AT OR SLIGHTLY ABOVE THEIR OPTIMUM MOISTURE CONTENT.
- ALL UTILITY TRENCH BACK FILL SHALL CONFORM TO CURRENT JURISDICTIONAL PUBLIC WORKS SPECIFICATIONS FOR CONSTRUCTION AND THE PROJECT GEOTECHNICAL INVESTIGATION REPORT. CONTACT CIVIL ENGINEER OF RECORD IN THE EVENT OF A CONFLICT.
- IN ADDITION TO THE ABOVE, ALL SITE PREPARATION AND SUBSURFACE WORK SHALL CONFORM TO THE PROJECT GEOTECHNICAL INVESTIGATION REPORT AS PREPARED BY PBS ENGINEERING AND ENVIRONMENTAL, INC.

EROSION CONTROL NOTE:

THE 1200C PLAN SHEETS FOR THIS SITE CONTAIN AN EROSION AND SEDIMENT CONTROL PLAN THAT MUST BE IMPLEMENTED AT THE START OF THIS PROJECT. THE INFORMATION CONTAINED WITHIN THE REFERENCED PLAN SHEETS SHALL BE CONSIDERED A MINIMUM AND SHALL BE MODIFIED AS REQUIRED BY THE CONTRACTOR & CITY INSPECTOR, TO CONTAIN ALL SEDIMENT ON SITE. SPECIAL ATTENTION SHALL BE TAKEN AT ALL EXISTING STORM DRAIN CATCH BASINS AND STORM DRAIN CHANNELS AS TO ELIMINATE ANY SEDIMENT TRANSFER INTO THE EXISTING STORM DRAIN SYSTEM.

AN ALL WEATHER ROCK SURFACE SHALL BE PROVIDED AT ALL CONSTRUCTION SITE ENTRANCES. GC MAY ELECT TO USE (E) GRAVEL PAVING, AC PAVING, ETC. (IF ACCEPTABLE TO CITY INSPECTOR). ALL CONSTRUCTION SHALL BE MAINTAINED WITHIN THE DEVELOPMENT LIMITS OF THIS PHASE. REFER TO EROSION CONTROL SHEET FOR ADDITIONAL INFORMATION.

UTILITY STATEMENT:

EXISTING UNDERGROUND UTILITIES ILLUSTRATED IN THESE PLANS HAVE BEEN LOCATED BY A UTILITY LOCATE COMPANY. LAYOUT INDICATED IS NOT TO BE RELIED ON AS BEING EXACT OR COMPLETE. ALL LINES WITHIN PROJECTED WORK ZONE SHALL BE FIELD VERIFIED AS REQ'D PRIOR TO CONSTRUCTION.


GENERAL CIVIL NOTES:

- ALL WORK & MATERIALS SHALL CONFORM TO THE 2017 OREGON PLUMBING SPECIALTY CODE & ALL APPLICABLE STATE, CITY, AND COUNTY REGULATIONS AND STANDARDS. CONTACT ENGINEER FOR DIRECTIVE IN THE EVENT OF CONFLICTING STANDARDS.
- CONSTRUCTION SHALL BE IN CONFORMANCE WITH THE CURRENT EDITION OF THE CITY OF ALBANY STANDARD CONSTRUCTION SPECIFICATIONS (AS ADOPTED BY THE CITY OF MILLERSBURG), THE PROJECT SPECIFICATIONS, CONSTRUCTIONS DRAWINGS, AND THESE SPECIAL PROVISIONS. IN SITUATIONS WHERE SPECIFICATION REQUIREMENTS DIFFER, THE MORE STRINGENT REQUIREMENT SHALL APPLY.
- ALL WORK WITHIN THE PUBLIC RIGHT-OF-WAY SHALL BE COORDINATED WITH THE GOVERNING AGENCY'S INSPECTOR AND SHALL CONFORM TO THAT AGENCY'S CURRENT ENGINEERING STANDARD SPECIFICATIONS & DETAILS.
- THE GENERAL CONTRACTOR AND ALL THEIR AFFILIATES SHALL VERIFY ALL DIMENSIONS, ELEVATIONS & LOCATIONS PRIOR TO CONSTRUCTION. NOTIFY ENGINEER OF ANY DISCREPANCIES.
- EXISTING SITE SURVEY PROVIDED BY S&F LAND SERVICES, DATED MAY 7, 2020. ELEVATIONS ARE BASED ON NGVD GPS TIES TO LINN COUNTY SURVEY BENCHMARKS 93192, 93014, AND 93012. HORIZONTAL DATUM BASED IN THE OREGON NORTH STATE PLAN COORDINATE SYSTEM NAD 83 (2011).
- ALL GRADE SURVEYING AND HORIZONTAL LAYOUT SHALL BE THE RESPONSIBILITY OF THE CONTRACTOR & SHALL BE PERFORMED BY A LICENSED LAND SURVEYOR. COORDINATE WITH ENGINEER PRIOR TO CONSTRUCTION.
- ALL EXISTING SITE UTILITIES IDENTIFIED ON THIS PLAN ARE NOT INTENDED TO BE EXACT OR COMPLETE. IT SHALL BE THE RESPONSIBILITY OF THE CONTRACTOR TO IDENTIFY ALL UTILITIES AND PROTECT AS REQUIRED DURING THE COURSE OF CONSTRUCTION.
- CONTRACTOR SHALL NOTIFY ALL APPLICABLE REGULATORY AGENCIES AND UTILITY COMPANIES 48 hrs PRIOR TO BEGINNING WORK.
- ALL SITE EXCAVATION, TRENCH BACK FILL, PARKING LOT SUB-GRADE, FLAT WORK SUB-GRADE, COMPACTION REQUIREMENTS, ETC. SHALL BE AS NOTED IN THE SITE PREPARATION NOTES AND/OR THE GEOTECHNICAL REPORT.
- ALL NON-DRIVEABLE SITE CONCRETE SHALL BE $f_c = 3500$ psi @ 28 DAYS, 6% ENTRAINED AIR, 4" SLUMP (U.N.O.). ALL DRIVEABLE SITE CONCRETE AND CONCRETE WITHIN THE PUBLIC R.O.W. SHALL BE $f_c = 4000$ psi PER THE CITY OF ALBANY STANDARD CONSTRUCTION SPECS.
- ALL UTILITY SERVICES SHALL BE INSTALLED PER THE RESPECTIVE UTILITY CODES & STANDARDS.
- WATER MAINS WITHIN THE PUBLIC R.O.W. SHALL HAVE A MINIMUM COVER OF 36". ALL OTHER UTILITIES SHALL HAVE A MINIMUM COVER OF 30" UNLESS OTHERWISE SPECIFIED.
- ALL SERVICES SHALL BE ADEQUATELY MARKED AS REQ'D AS TO IDENTIFY THE SIZE, TYPE, & DEPTH OF THE SERVICE.
- ALL SERVICES SHALL BE PLUGGED AS REQ'D TO ADEQUATELY ENSURE THAT NO FOREIGN MATERIALS ENTER THE LINE.
- CONTRACTOR SHALL PROVIDE THE ENGINEER WITH THE SIZE, TYPE, DEPTH OF MAIN, TYPE OF CONNECTION AT MAIN, INSTALLATION DATE, LOCATION & SKETCH OF ALL UTILITY SERVICE INSTALLATIONS.
- CONTRACTOR SHALL OBTAIN ALL APPLICABLE PERMITS PRIOR TO CONSTRUCTION.
- ALL FIRE WATER LINES SHALL BE CLASS 52 DUCTILE IRON PIPE AND ALL DOMESTIC WATER LINES SHALL BE PVC WATER PIPE CONFORMING TO ASTM D 1785 WITH SOLVENT-CEMENTED JOINTS.
- ALL SANITARY SEWER WASTE LINES SHOWN OUTSIDE THE BUILDING SHALL BE PVC SEWER PIPE CONFORMING TO ASTM D 3034 - SDR 35 WITH GASKET JOINTS. SEE MECHANICAL PLANS FOR ALL PIPING REQUIREMENTS WITHIN 5' OF STRUCTURES.
- SANITARY LINES SHALL BE REQ'D TO PASS A LOW PRESSURE AIR TEST OR WATER TEST CONFORMING TO PLUMBING CODE SPECIFICATIONS PRIOR TO FINAL ACCEPTANCE. ALL PARTS OF THE SYSTEM SHALL BE CLEANED PRIOR TO FINAL ACCEPTANCE. THE CONTRACTOR SHALL NOT ALLOW ANY FOREIGN MATERIAL TO ENTER THE EXISTING SYSTEM. THE CONTRACTOR SHALL PROVIDE THE REQ'D PERSONNEL AND MATERIAL TO PERFORM THE ABOVE TESTS. THE CONTRACTOR SHALL PROVIDE THE ENGINEER WITH DOCUMENTATION OF THE ABOVE TESTS.
- STORM COLLECTION SYSTEM DESIGNED FOR WATER TIGHT COMPONENTS.
- ALL STORM PIPE IDENTIFIED AS 'PVC' SHALL BE ASTM D 3034 - SDR 35. ALL ON-SITE STORM PIPE IDENTIFIED AS 'HDPE' SHALL BE HANCOR SURE-LOK F477 -OR- ADVANCED DRAINAGE SYSTEMS N-12. SEE PLAN SET FOR ADDITIONAL INFORMATION.
- ALL STORM COLLECTION SYSTEM CONNECTIONS AND COMPONENTS SHALL CONFORM TO PIPE MANUFACTURER REQUIREMENTS. GC TO COORDINATE STORM SYSTEM LAYOUT W/ ENGINEER AND STORM SYSTEM SUPPLIER. STORM SYSTEM COMPONENT SHOP DRAWINGS SHALL BE PROVIDED FOR ENGINEER'S REVIEW PRIOR TO CONSTRUCTION.
- ALL ON SITE CATCH BASINS SHALL BE AS IDENTIFIED ON PLAN SET. ALL ON-SITE STORM SYSTEM CATCH BASINS SHALL BE PROVIDED WITH A MINIMUM 24" SETTLEMENT SUMP BELOW THE LOWEST PIPE INVERT (U.N.O.) AND A POLLUTION CONTROL HOOD AND TRAP SYSTEM.SEE PLAN SET FOR ADDITIONAL INFORMATION. CURB INLETS IN ROW PER STANDARD SPECS.
- GC SHALL PROVIDE ENGINEER WITH SHOP DRAWING SUBMITTALS ON ALL PRE-CAST MANUFACTURED ITEMS.
- ALL UNDERGROUND PIPING, CONDUIT AND OTHER UTILITIES SHALL BE BEDDED PER CITY OF ALBANY STANDARD DETAILS (OR AS OTHERWISE SPECIFIED BY PIPE MANUFACTURER). NOTIFY ENGINEER IN EVENT OF DISCREPANCIES.
- ALL TEMPORARY PROTECTION AND DIRECTION OF TRAFFIC SHALL BE BY THE CONTRACTOR AND CONFORM WITH BOTH THE MANUAL ON UNIFORM TRAFFIC CONTROL DEVICES AND THE ODOT MANUAL ON SHORT TERM TRAFFIC CONTROL
- ALL LANDSCAPED AREAS SHALL BE AS NOTED ON THE LANDSCAPE PLANS. THE ENGINEER SHALL INSPECT ALL LANDSCAPE PLANTER GRADES PRIOR TO RECEIVING FINAL SURFACE TREATMENT.

DATE 4/2/2021 5:14 PM
 FILE PATH: \\ACTIVE PROJECTS\20335_SODERSTROMARCHITECTS_MILLERSBURG_MILLERSBURGFIRESTATION\CIVIL\3D\PRODUCTION DRAWINGS\C0.0 GENERAL NOTES
 © 2019 CROW ENGINEERING, INC.

1 EXISTING CONDITIONS PLAN

1" = 30'

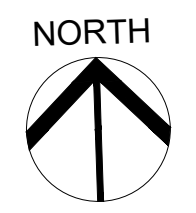

NOTES

- CLEARING AND GRUBBING SHALL BE DONE PER NOTES ON C0.10.
- SEE SEPARATE 1200C PLANS FOR ADDITIONAL EROSION CONTROL MEASURES AND IMPLEMENTATION.

SITE LEGEND

- GRAVEL CONSTRUCTION ENTRANCE
- LIMITS OF DEMOLITION/SAWCUT

KEYNOTES

- 1 REMOVE EXISTING SIDEWALK
- 2 REMOVE EXISTING GAURDRAIL
- 3 REMOVE EXISTING FENCING
- 4 REMOVE EXISTING TREE
- 5 SAWCUT AND REMOVE EXISTING PAVEMENT
- 6 REMOVE EXISTING CURB AND GUTTER
- 7 EROSION CONTROL SILT FENCE
- 8 CONSTRUCTION ENTRANCE
- 9 PROTECT EXISTING SIGN
- 10 PROTECT EXISTING STORM INLET
- 11 PROTECT EXISTING POLE AND GUY WIRES

1200 NW Naito Parkway, Suite 410
Portland, OR 97209

T 503-228-5617
F 503-227-8584

sdra.com

**Millersburg Fire
Station 15**
3215 Transition Parkway
Albany, OR 97321



Project


Consultant

9925 SW Nimbus Ave
Suite 110
Beaverton, OR 97008
T 503-213-2013
F 503-213-2018
crowengineering.com

Revisions

No.	Description	Date
1	Pre-Bid Revisions	2/3/21

Stamp

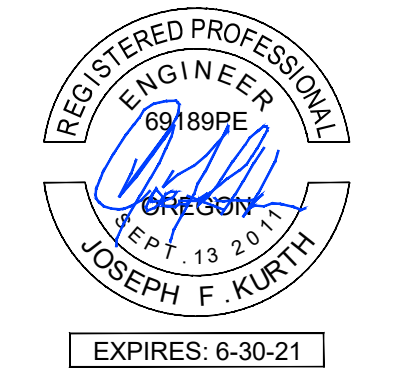

Issuance

CONFORM SET

Date

4/2/21

Project Number

20335

Drawing Title

**EXISTING
CONDITIONS AND
DEMOLITION PLAN**

Sheet No

C0.20



Project


Consultant



Revisions

No.	Description	Date
1	Pre-Bid Revisions	2/3/21

Stamp

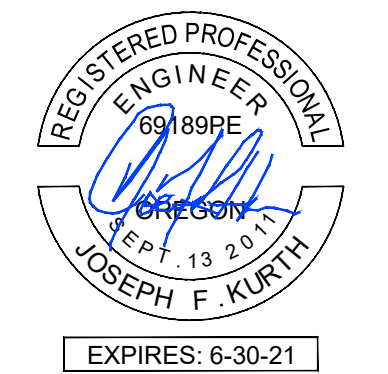

Issuance

CONFORM SET

Date

4/2/21

Project Number

20335

Drawing Title

SITE PLAN

Sheet No

C1.00

GENERAL SITE INFORMATION	
ITEM	DESCRIPTION
LOCATION	OLD SALEM ROAD - MILLERSBURG, OR
LEGAL DESCRIPTION	T 10 S R 03 W SEC 28
PROPERTY ID	
ZONING	PF (PUBLIC FACILITIES ZONE)
LOT SIZE	3.59 ac (PROPERTY LOT)
IMPERVIOUS AREA	47,852 sf
PERVIOUS AREA	108,613 sf

GENERAL BUILDING INFORMATION		
BUILDING	SIZE	HEIGHT
STATION 15	9,935 SQFT	±22'-0"

PARKING REQUIREMENTS			
EMPLOYEES PER SHIFT	6		
TOTAL EMPLOYEES AT SHIFT CHANGE	12		
PARKING REQUIREMENTS PER MILLERSBURG DEVELOPMENT CODE CH. 3.03			
VEHICLE SPACES	MIN. REQUIRED	RATIO	REQUIRED
MUNICIPAL / GOVERNMENT	1 SP PER 2 EMPLOYEES + 1 SPACE PER 800 SQFT	12 EMPLOYEES	19
TOTAL REQUIRED			19
TOTAL PROVIDED			29
BICYCLE STALL	MIN. REQUIRED	RATIO	REQUIRED
	1 PER 20 VEHICLE SPACES		1
TOTAL REQUIRED			1
TOTAL PROVIDED			1



- NOTES**
- ALL PARKING LOT CURB RETURNS SHALL HAVE A 5'-0" RADIUS UNLESS NOTED OTHERWISE.

SITE LEGEND

	CONCRETE PAVING - SEE DETAIL 3/C4.00
	HMAC PAVING - SEE DETAIL 4/C4.00
	HMAC PAVING - HEAVY - SEE DETAIL 2/C4.00
	LANDSCAPING - SEE LANDSCAPING PLANS
	RIP-RAP - SEE DETAIL 7/C4.00

- SITE KEYNOTES**
- FIRE STATION BUILDING. (SEE ARCH PLANS)
 - EMPLOYEE AND COMMUNITY VISITOR PARKING AREA
 - STORMWATER POND (SEE GRADING AND LANDSCAPING PLANS)
 - ONSITE SIDEWALK (SEE DETAIL 4/C4.10)
 - TRASH ENCLOSURE (SEE ARCH PLANS)
 - NOT USED
 - 4" WHITE PAVEMENT STRIPING
 - EV CHARGING PEDESTAL (SEE ELECTRICAL PLANS)
 - FLAG POLES (SEE ARCH AND LANDSCAPING PLANS)
 - GENERATOR AND CONCRETE PAD (SEE ELECTRICAL PLANS)
 - LIFE JACKET STORAGE AREA (SEE ARCH AND LANDSCAPING PLANS)
 - 6"x6"-0 CURBSTOP (TYP.)
 - MECHANICAL PAD (SEE ARCH AND MECH PLANS)
 - PARKING SIGN (TYP.) (SEE ARCH PLANS)
 - UNDERGROUND OIL/WATER SEPARATOR (SEE PLUMBING PLANS)
 - WASH AREA CATCH BASIN (SEE C3.00)
 - STRAIGHT CURB (SEE STANDARD DETAIL 304)
 - MULTI-USE PATH (SEE DETAIL 5/C4.00)
 - PATIO AND FENCE (SEE ARCH AND LANDSCAPING PLANS)
 - TYPICAL CURB AND GUTTER WITH DEPRESSED CURB (SEE STANDARD DETAIL 304)
 - DETECTABLE WARNING (SEE ODOT STANDARD DETAIL RD902)
 - ADA PARKING SIGN AND STRIPING (SEE DETAIL 6/C4.10)
 - TYPICAL CURB AND GUTTER (SEE STANDARD DETAIL 304)
 - STEPS AND HANDRAILS (SEE STANDARD DETAILS RD120, RD770, RD771)
 - CONVEYANCE SWALE (SEE DETAIL 6/C4.10)

- R.O.W. CONSTRUCTION KEYNOTES**
- INTERSECTION AT OLD SALEM ROAD ADA ACCESSIBLE RAMPS AT INTERSECTIONS
 - SIGNAL FOR FIRE VEHICLES ENTERING TRAFFIC ON OLD SALEM RD. (SEE DETAIL 1/C4.20)
 - 80'-0" R.O.W. DEDICATION
 - 46'-0" WIDE ROADWAY SECTION
 - 10'-0" WIDE MULTI-USE AC PAVED PATH
 - CONCRETE DRIVEWAY (SEE MODIFIED STANDARD DETAIL 308)
 - 9'-0" SWALES (SEE DETAIL 5/C4.00 AND STANDARD DETAIL 603A)
 - LEFT TURN LANE
 - 14'-0" MEDIAN AND/OR TURNING / REFUGE LANE
 - 5'-0" WIDE SIDEWALK
 - 6'-0" WIDE BICYCLE LANE
 - STOP SIGN WITH STREET NAME SIGNS ABOVE (SEE STANDARD DETAILS 208 AND 209)
 - BARRICADES WITH GATE (SEE DETAIL 2/C4.20)
 - 1' WIDE STOP BAR (S PER ODOT TM503)
 - STANDARD CROSSWALK (CW PER ODOT TM503)

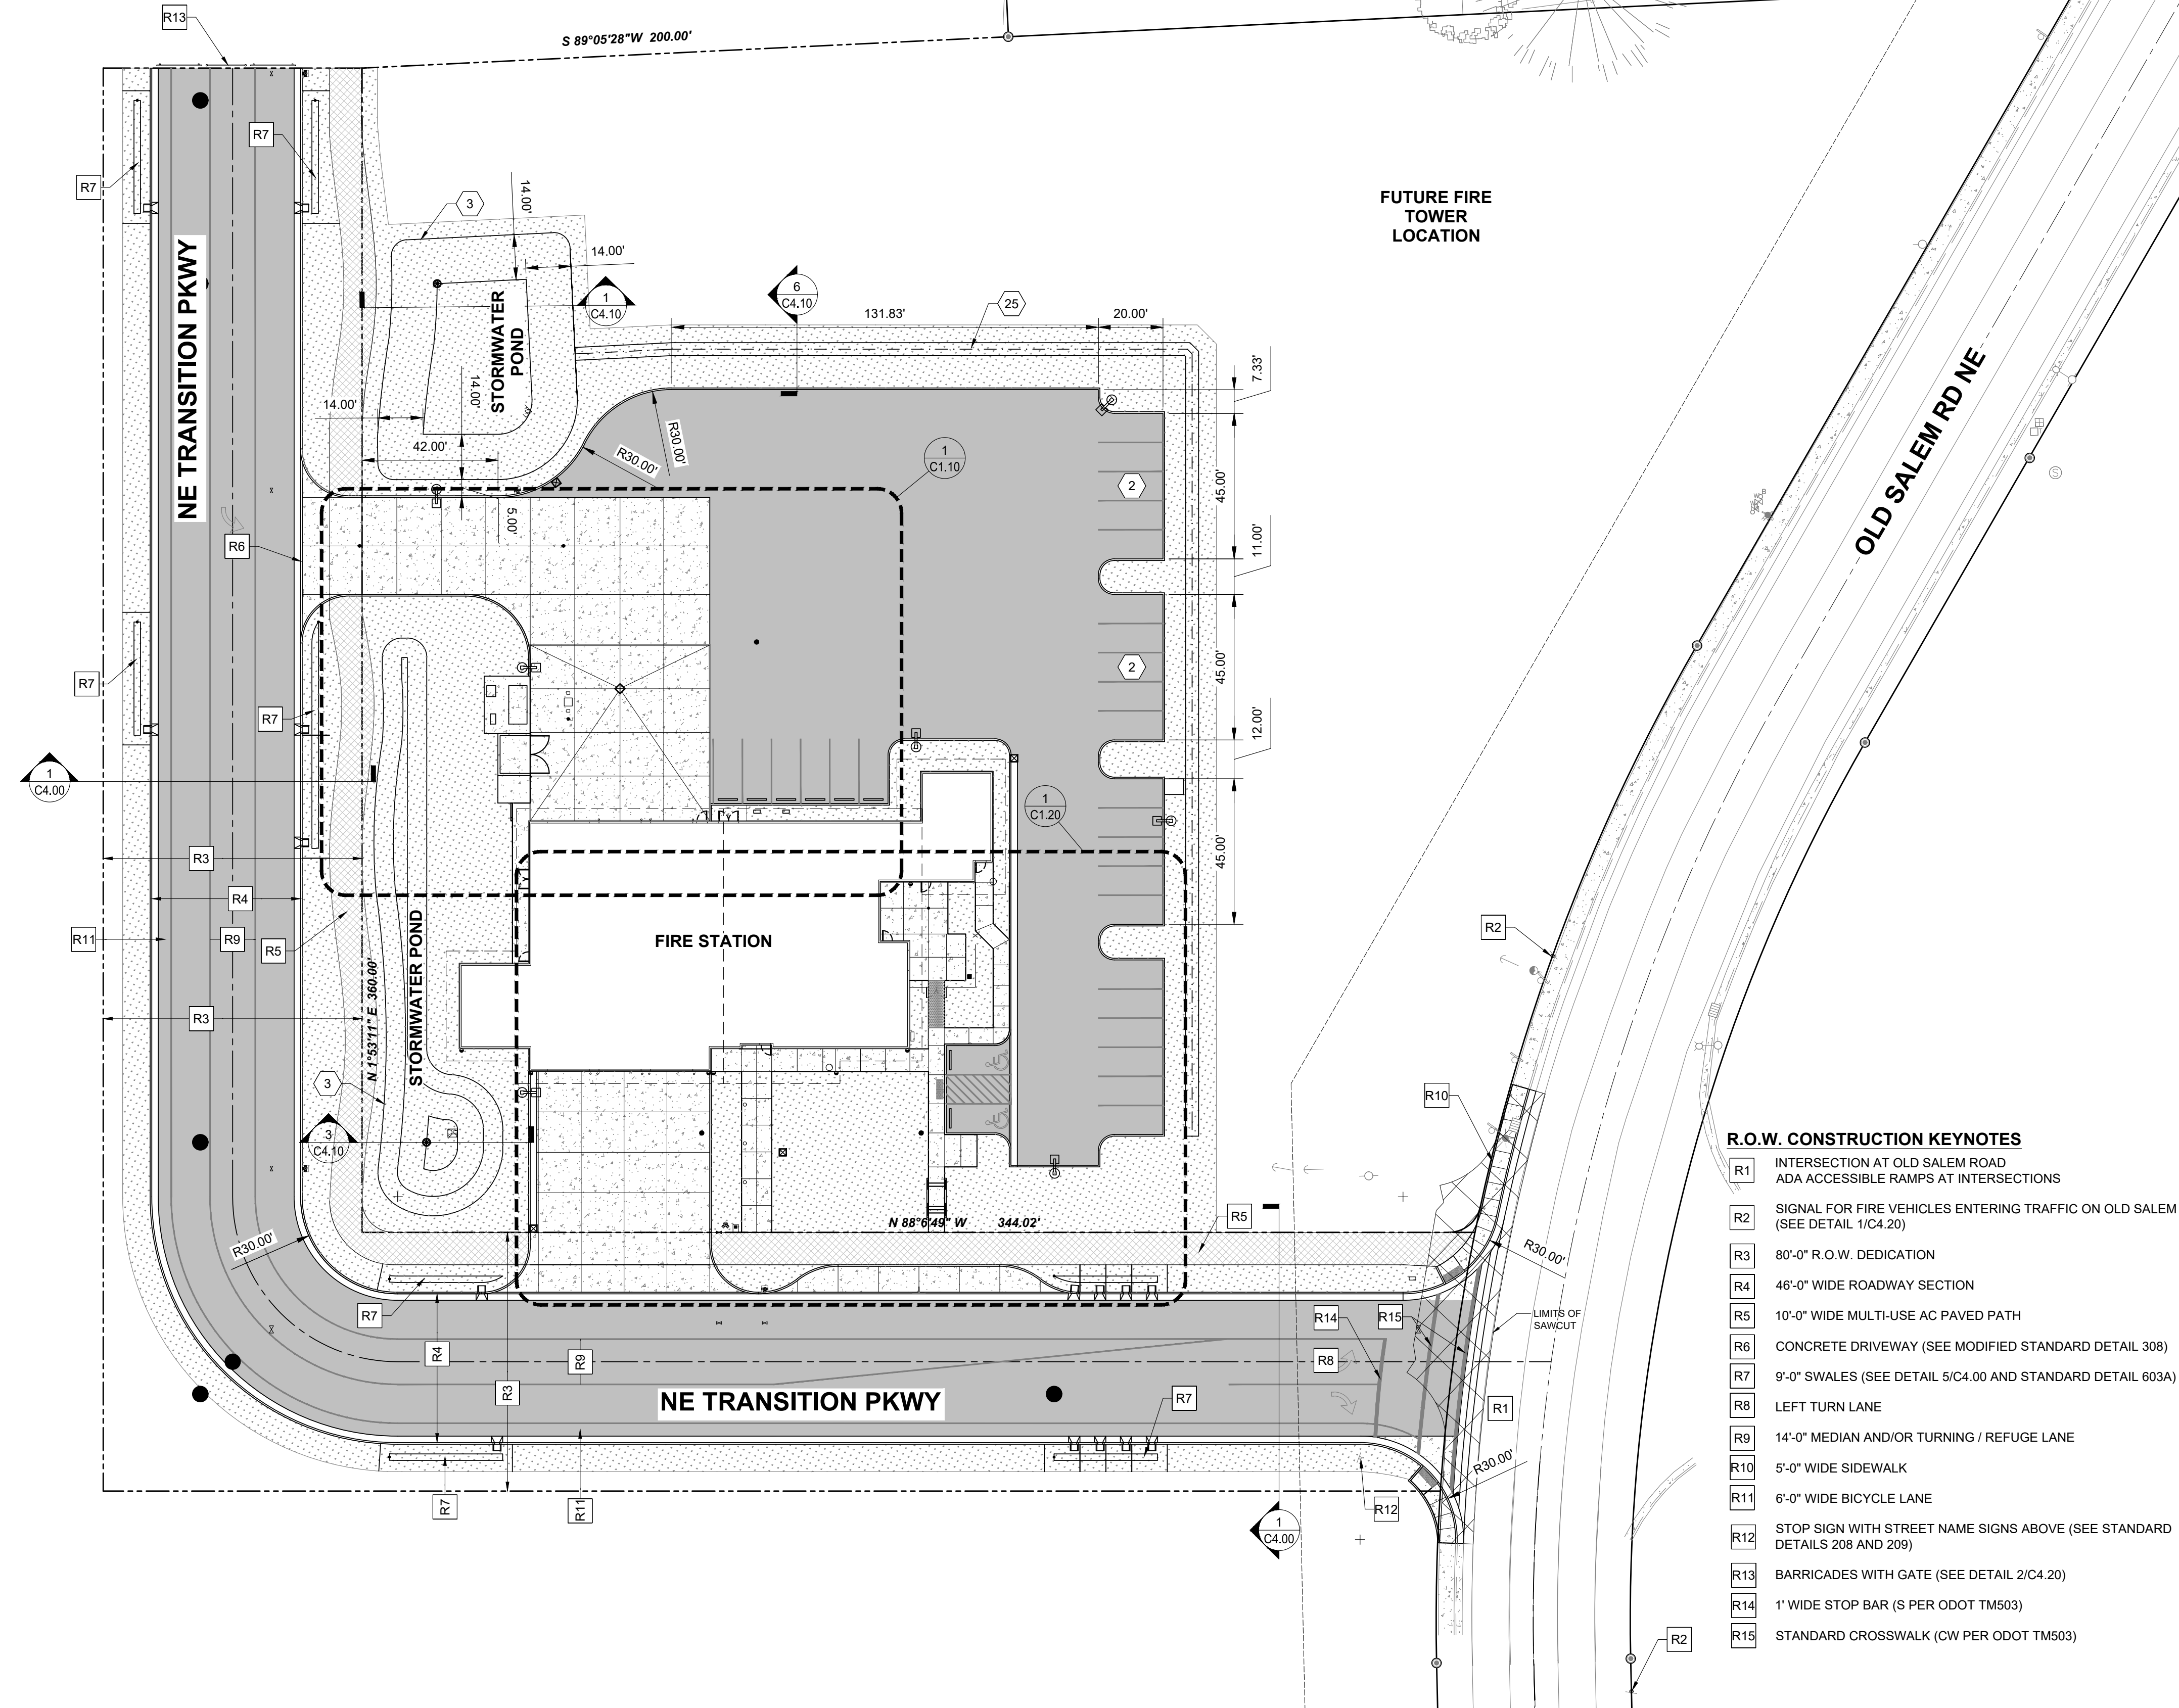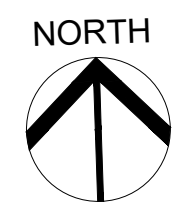


FUTURE FIRE TOWER LOCATION


1 SITE PLAN
1" = 30'

DATE 4/2/2021 4:45 PM FILE PATH: T:\ACTIVE PROJECTS\20335_SODERSTROMARCHITECTS_MILLERSBURG_MILLERSBURGFIRESTATION\C1\3D\PRODUCTION DRAWINGS\C1.0 SITE PLAN © 2019 CROW ENGINEERING, INC.

DATE: 4/2/2021 5:01 PM
 FILE PATH: T:\ACTIVE PROJECTS\20335_SODERSTROMARCHITECTS_MILLERSBURG_MILLERSBURGFIRESTATION\CIVIL\3D\PRODUCTION DRAWINGS\C2.0 GRADING PLAN
 © 2019 CROW ENGINEERING, INC.

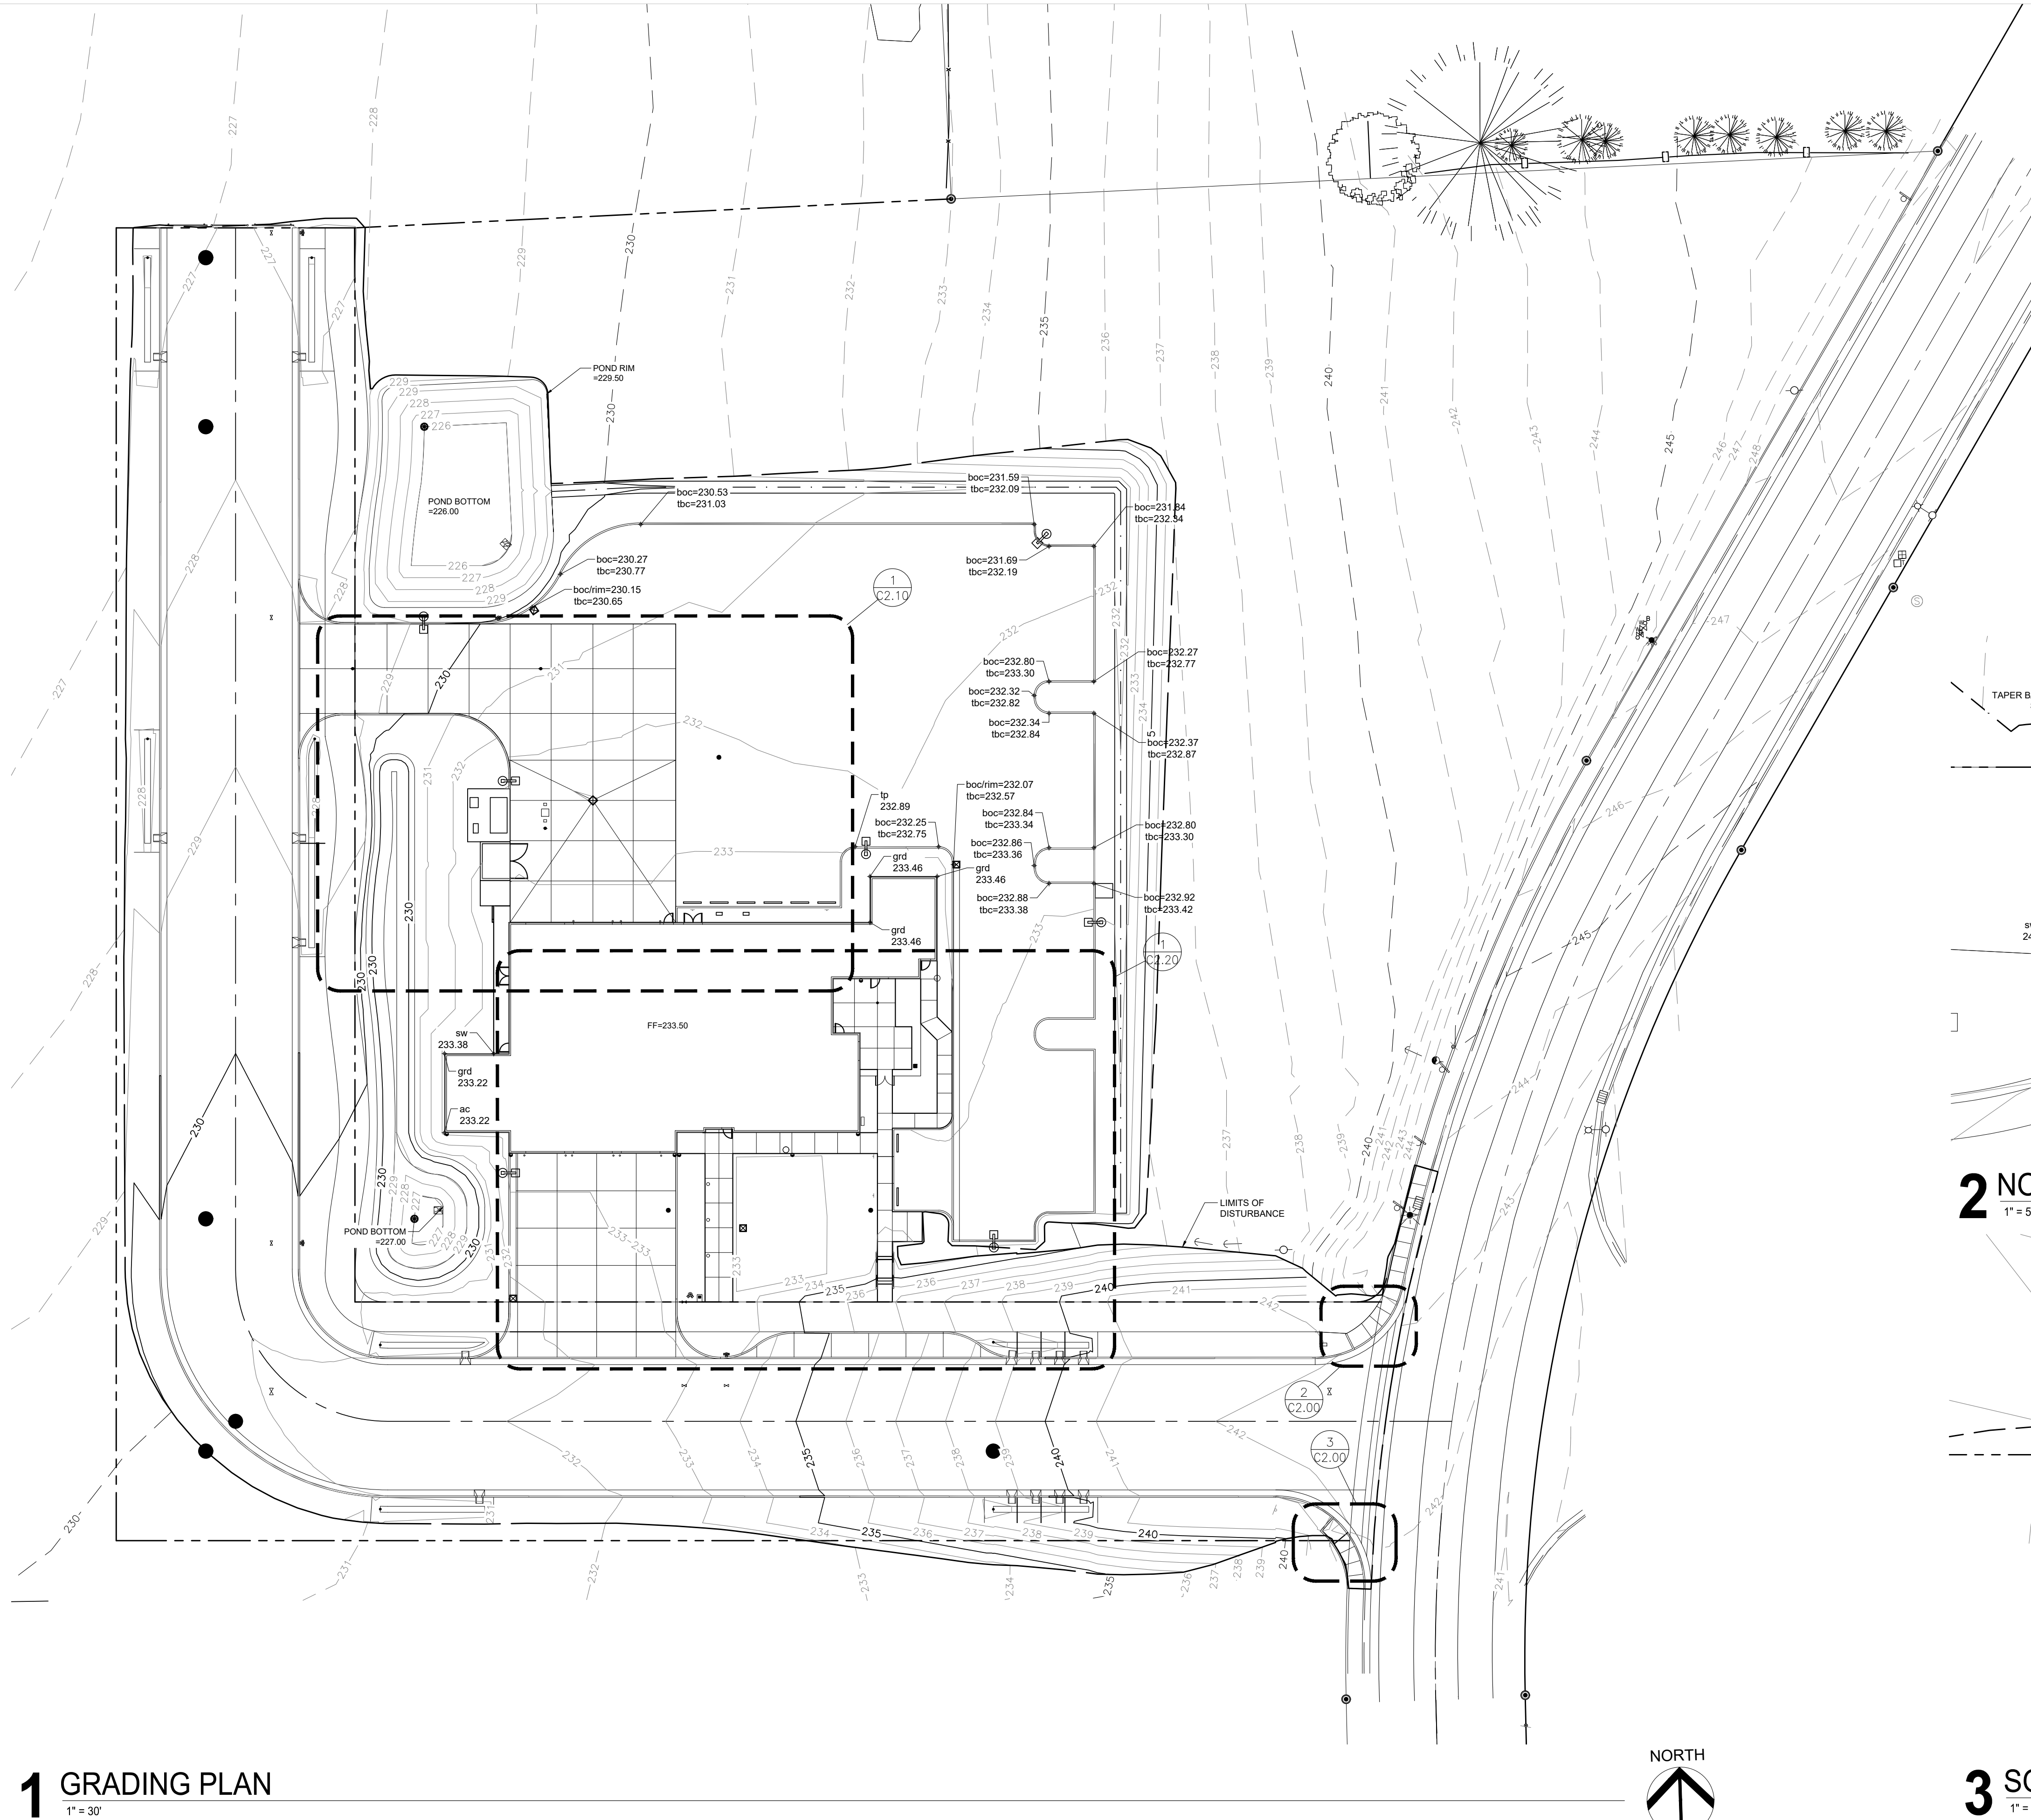


1 GRADING PLAN
 1" = 30'

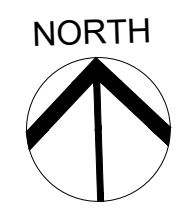


- GRADING GENERAL NOTES:**
- REFER TO GEOTECHNICAL REPORT PREPARED BY PBS ENGINEERING AND ENVIRONMENTAL, INC. AND DATED 8/28/2020 FOR REQUIRED SPECIFICATIONS REGARDING ALL GRADING AND SUBGRADE PREPARATION UNDER ALL ASPHALT, CONCRETE, AND BUILDING PADS
 - GROUND SURFACE WITHIN THE LIMITS OF PROPOSED IMPROVEMENTS SHOULD BE STRIPPED OF ALL ORGANIC MATERIAL AND REMOVED FROM SITE. TOP LAYER OF THIS MATERIAL SHALL BE RETAINED FOR LANDSCAPING AREAS
 - ALL CONTOURS SHOWN IN EXISTING SURVEY AND NEW DEVELOPMENT ARE AT 1 FT INTERVALS
 - EXCAVATION FOR ALL SITE UTILITIES INCLUDING STORM, SEWER, WATER AND POWER NOT SHOWN. SEE UTILITY PLAN AND GEOTECHNICAL REPORT FOR UTILITY TRENCHING AND BEDDING REQUIREMENTS FOR ALL UTILITIES

LEGEND

--- 350 ---	EXISTING GRADE MAJOR CONTOURS (10 FT INTERVALS)
--- 352 ---	EXISTING GRADE MINOR CONTOURS (2 FT INTERVALS)
— 350 —	FINISHED GRADE MAJOR CONTOURS (10 FT INTERVALS)
— 352 —	FINISHED GRADE MINOR CONTOURS (2 FT INTERVALS)
xx	DESCRIPTION (SEE ABBREVIATION LIST)
+ 2XX.XX	SPOT ELEVATION
+ boc=2XX.XX	BOTTOM OF CURB SPOT ELEVATION
+ tbc=2XX.XX	TOP BACK OF CURB SPOT ELEVATION

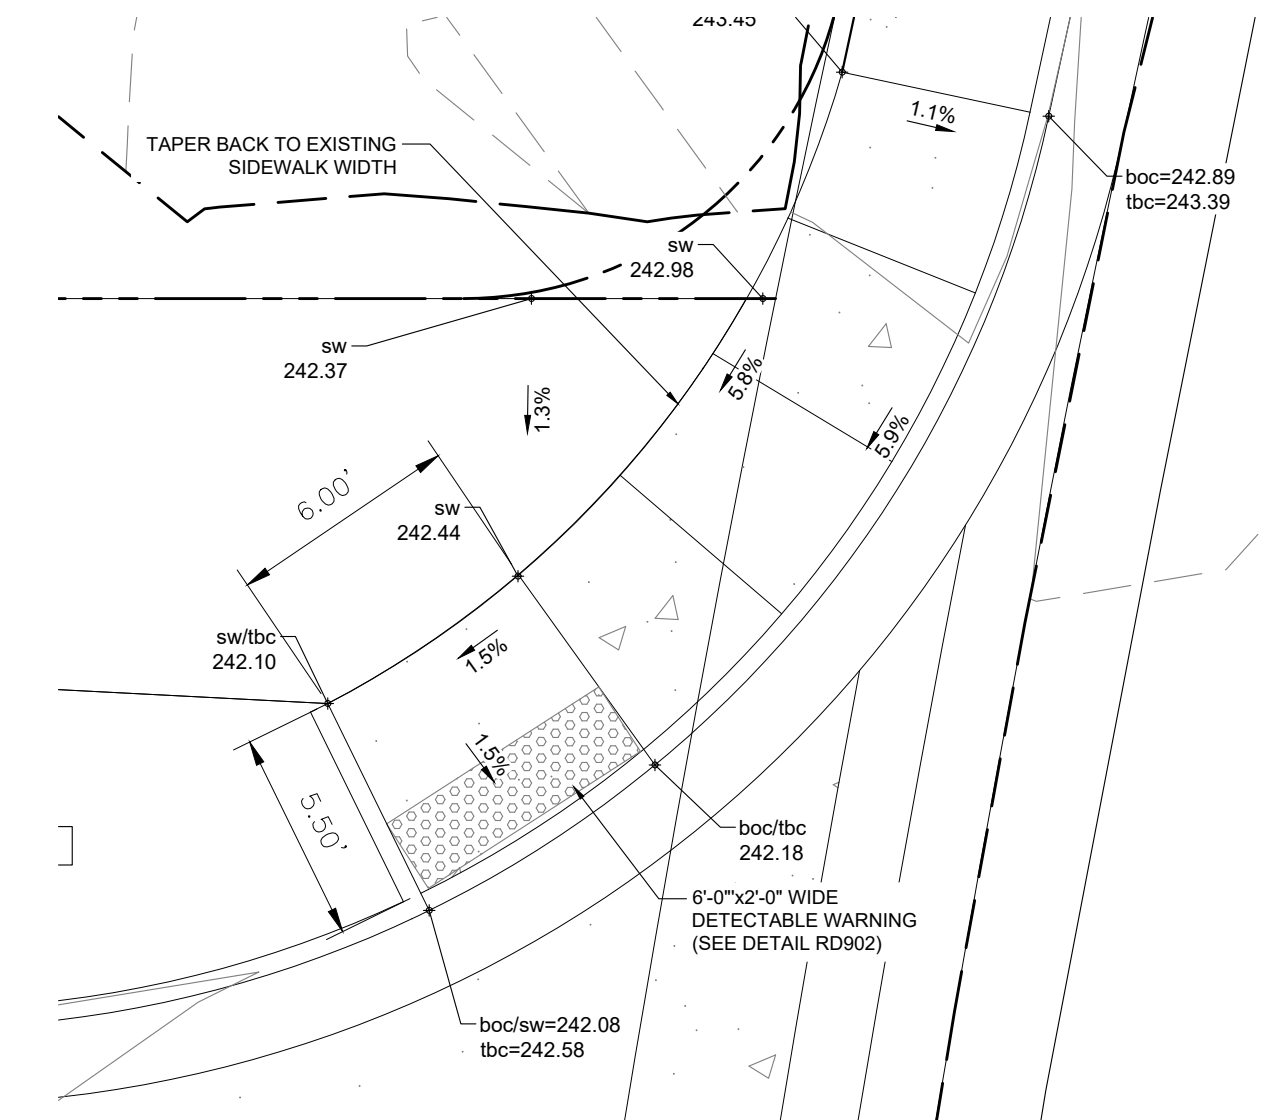

2 NORTH ADA RAMP ENLARGEMENT
 1" = 5'

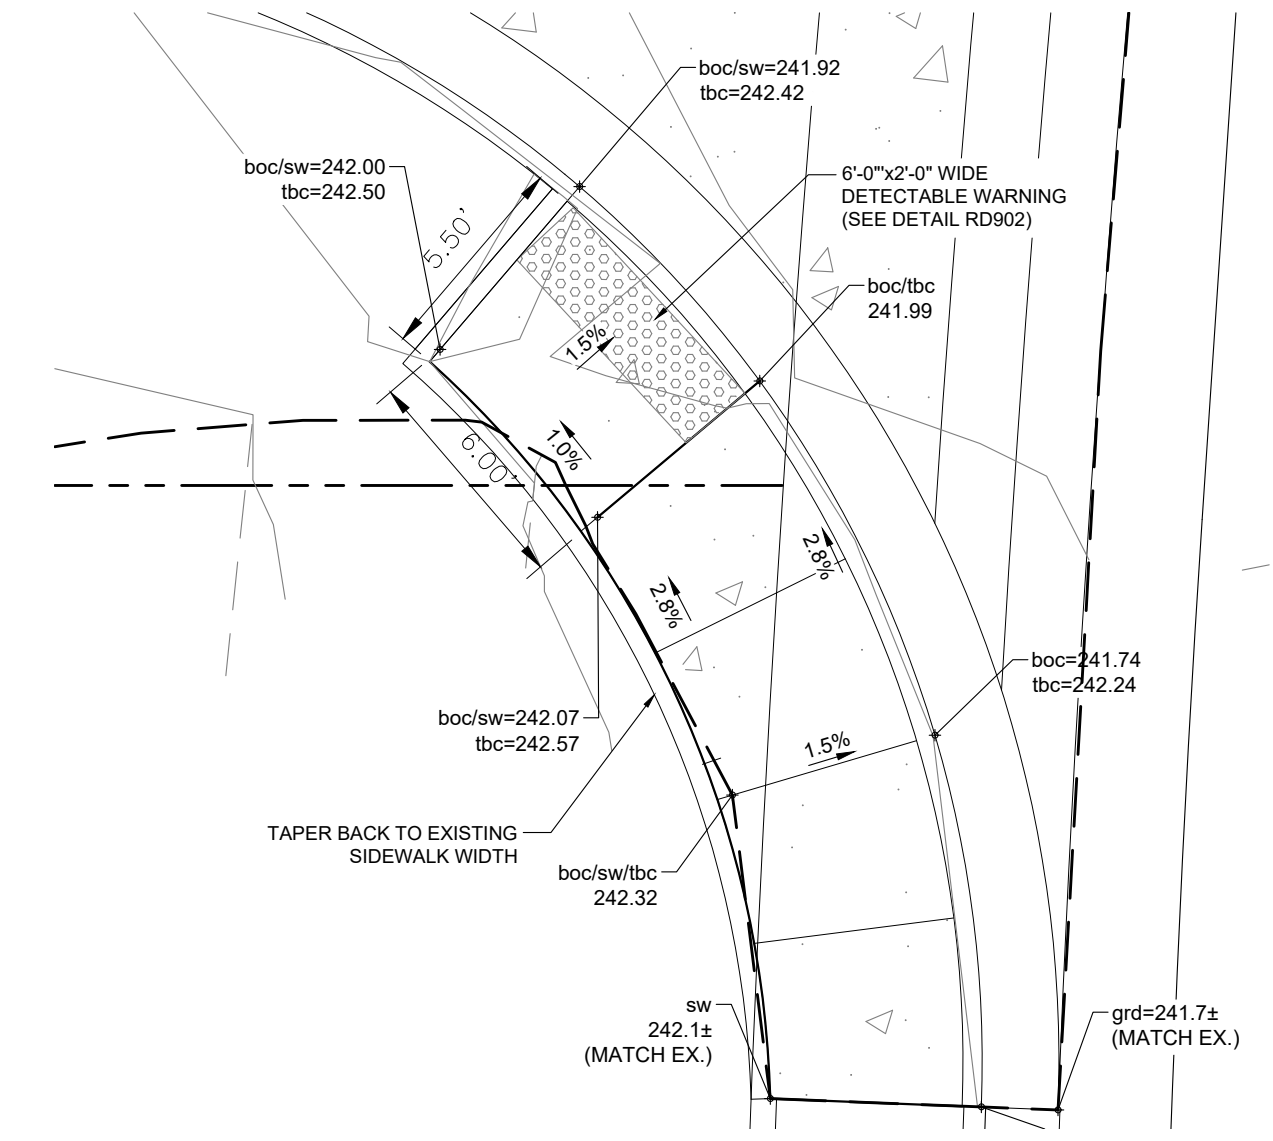


3 SOUTH ADA RAMP ENLARGEMENT
 1" = 5'



Revisions

No.	Description	Date
1	Pre-Bid Revisions	2/3/21
2	Addendum 2	3/2/21

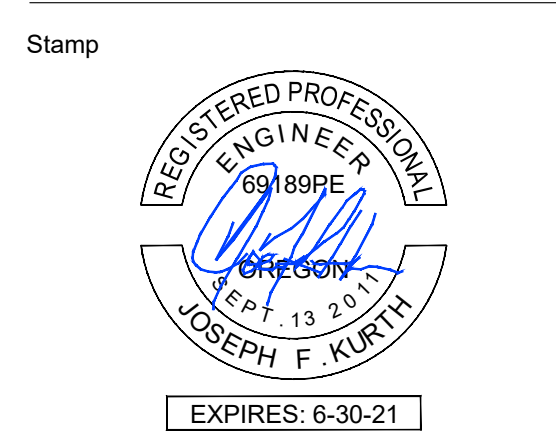

Issuance
CONFORM SET

Date
4/2/21

Project Number
20335

Drawing Title
GRADING PLAN

Sheet No
C2.00

Revisions

No.	Description	Date
1	Pre-Bid Revisions	2/3/21




Issuance
CONFORM SET

Date
4/2/21


Project Number
20335

Drawing Title
**SOUTH ROW
GRADING PLAN**

Sheet No
C2.30

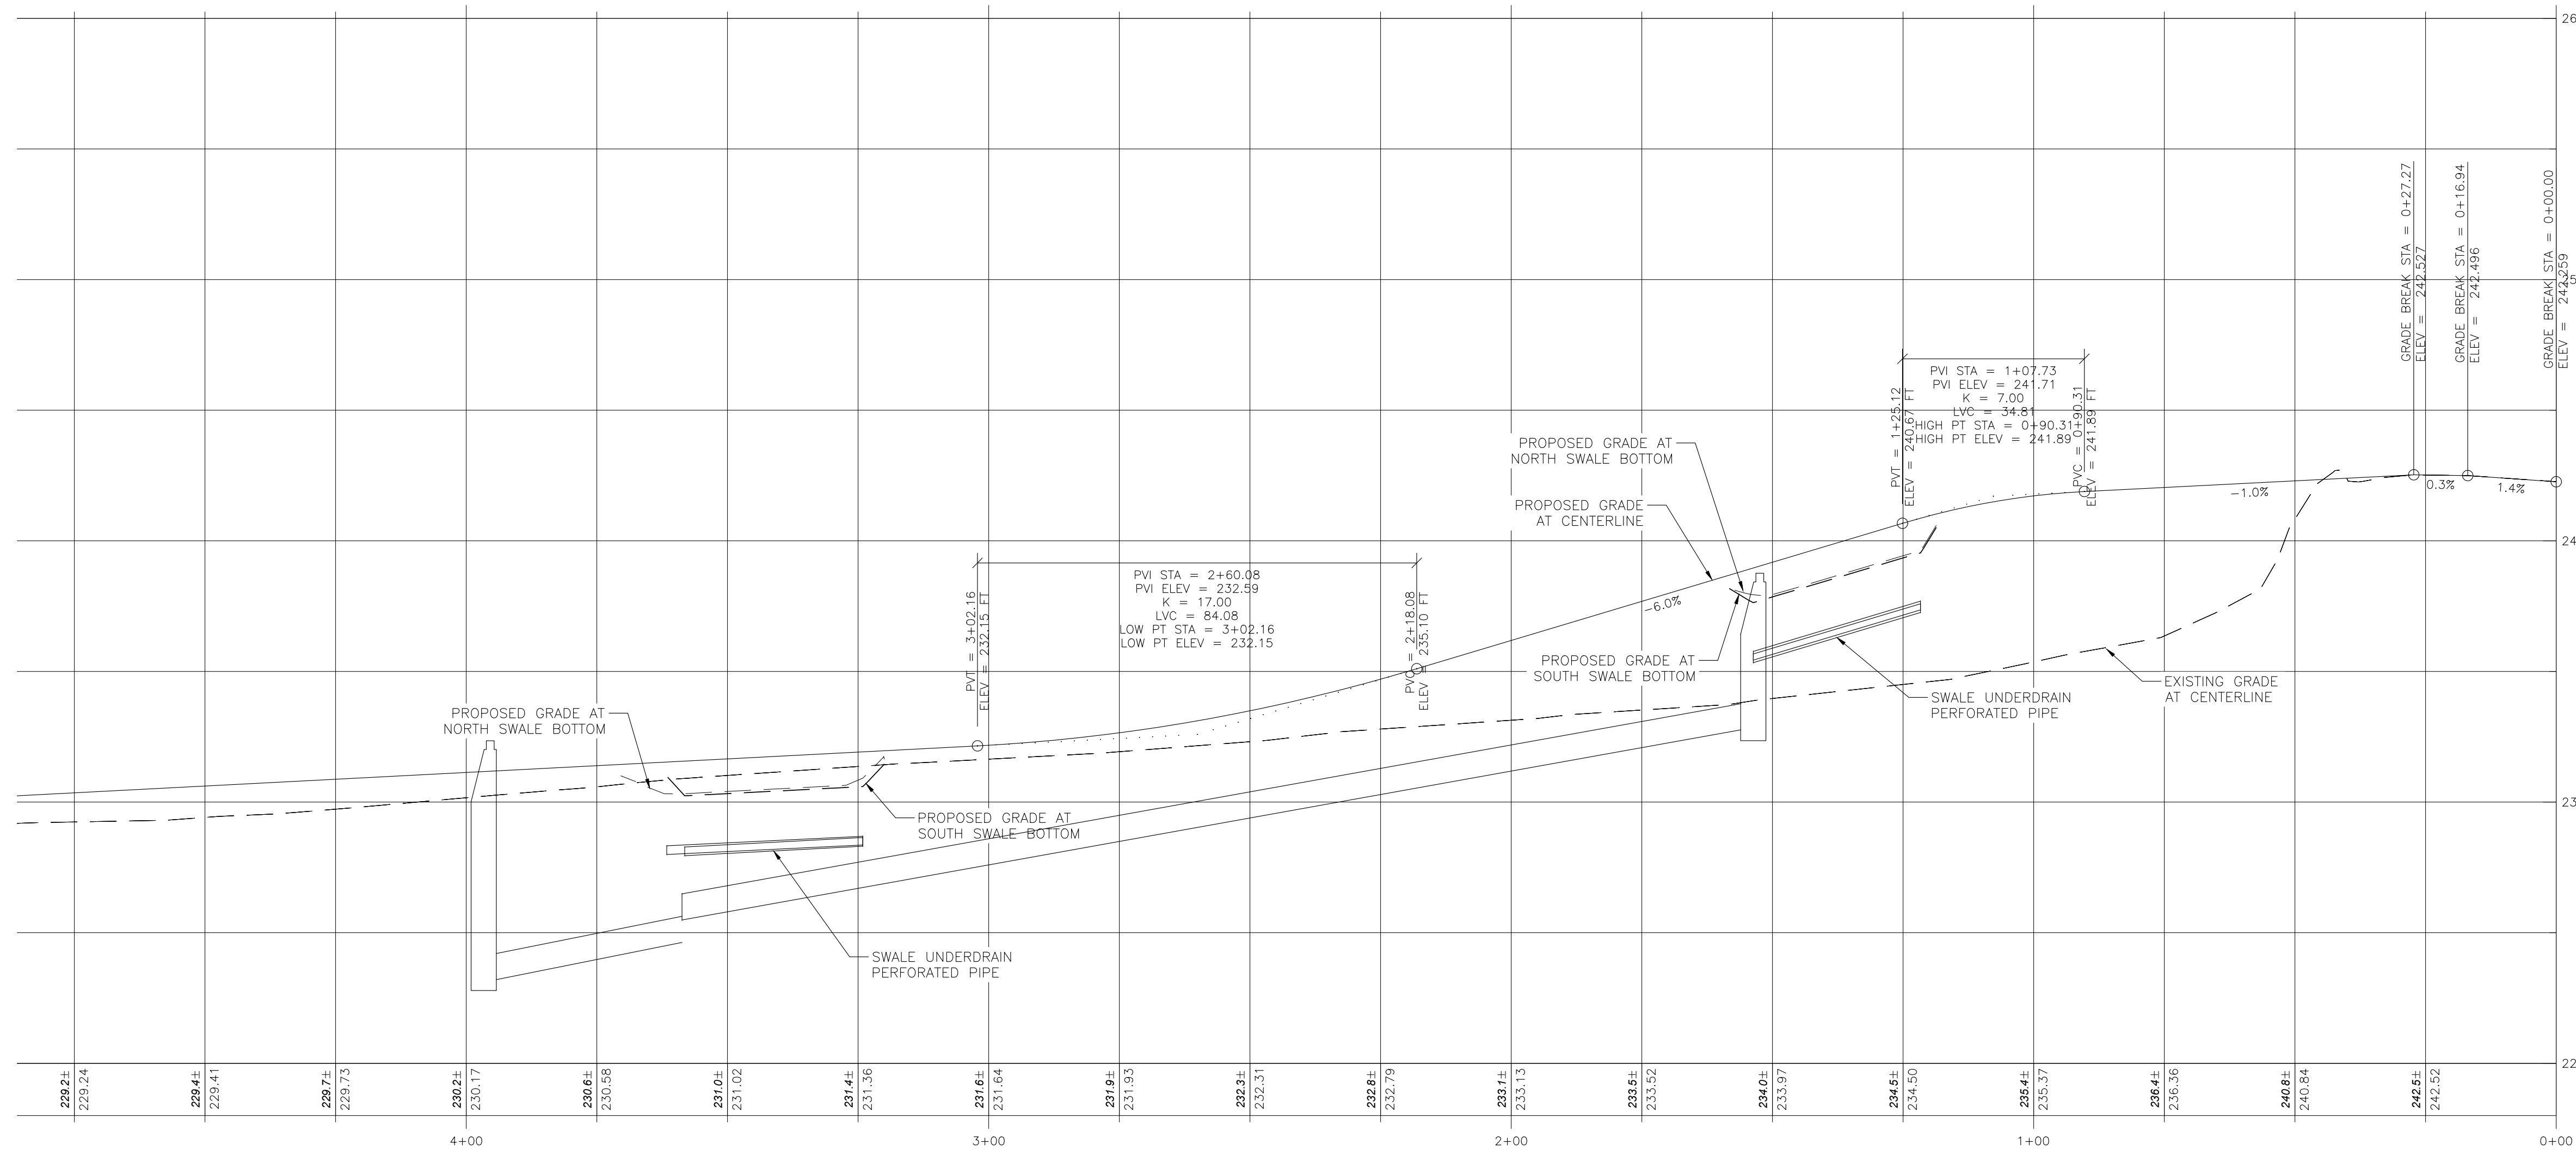


1 SOUTH ROW PROFILE
1" = 20' H, 1" = 4' V

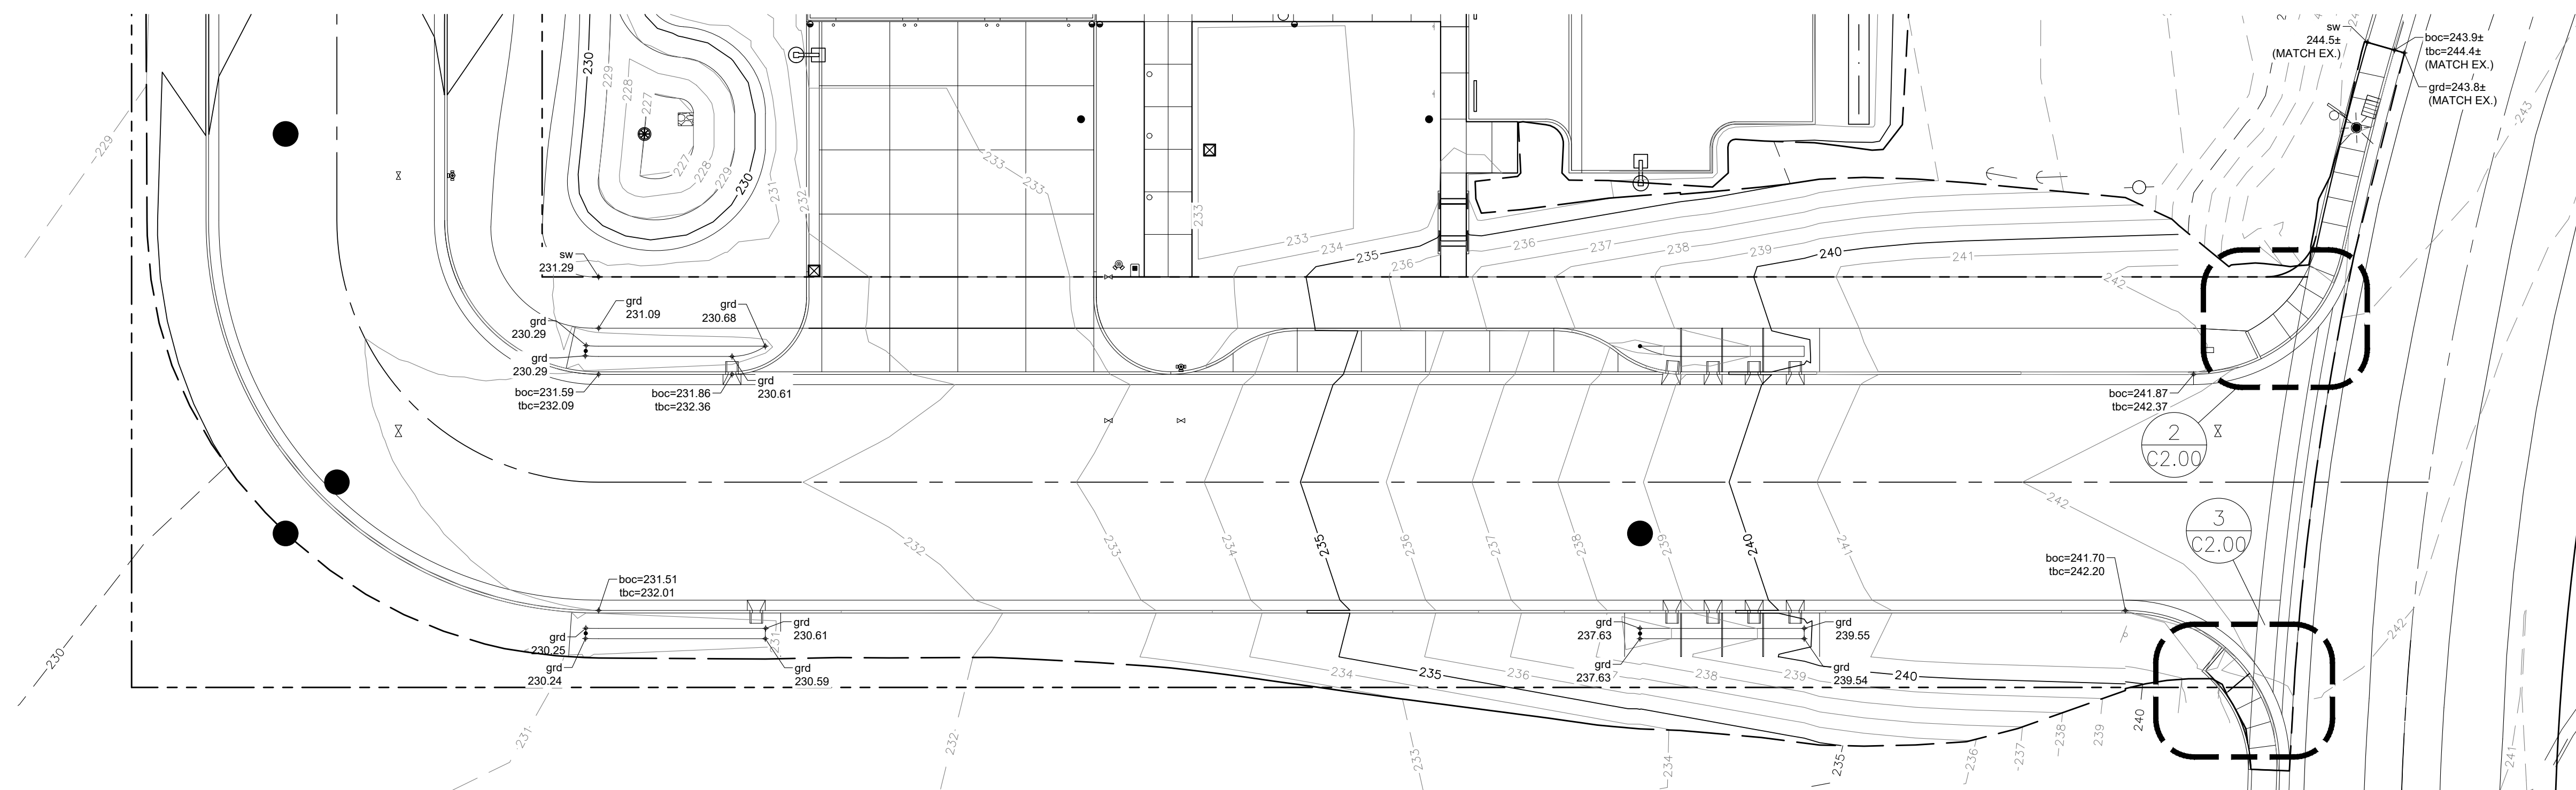

2 SOUTH ROW GRADING PLAN
1" = 20'

No.	Description	Date
1	Pre-Bid Revisions	2/3/21
2	Addendum 2	3/2/21

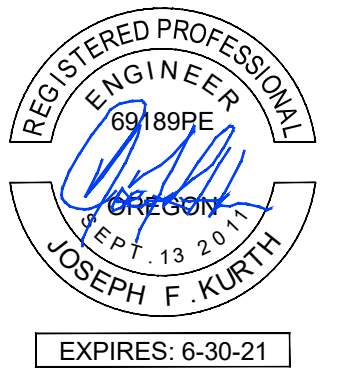


CONFORM SET

Date
4/2/21

Project Number
20335


Drawing Title
WEST ROW GRADING PLAN

Sheet No
C2.40

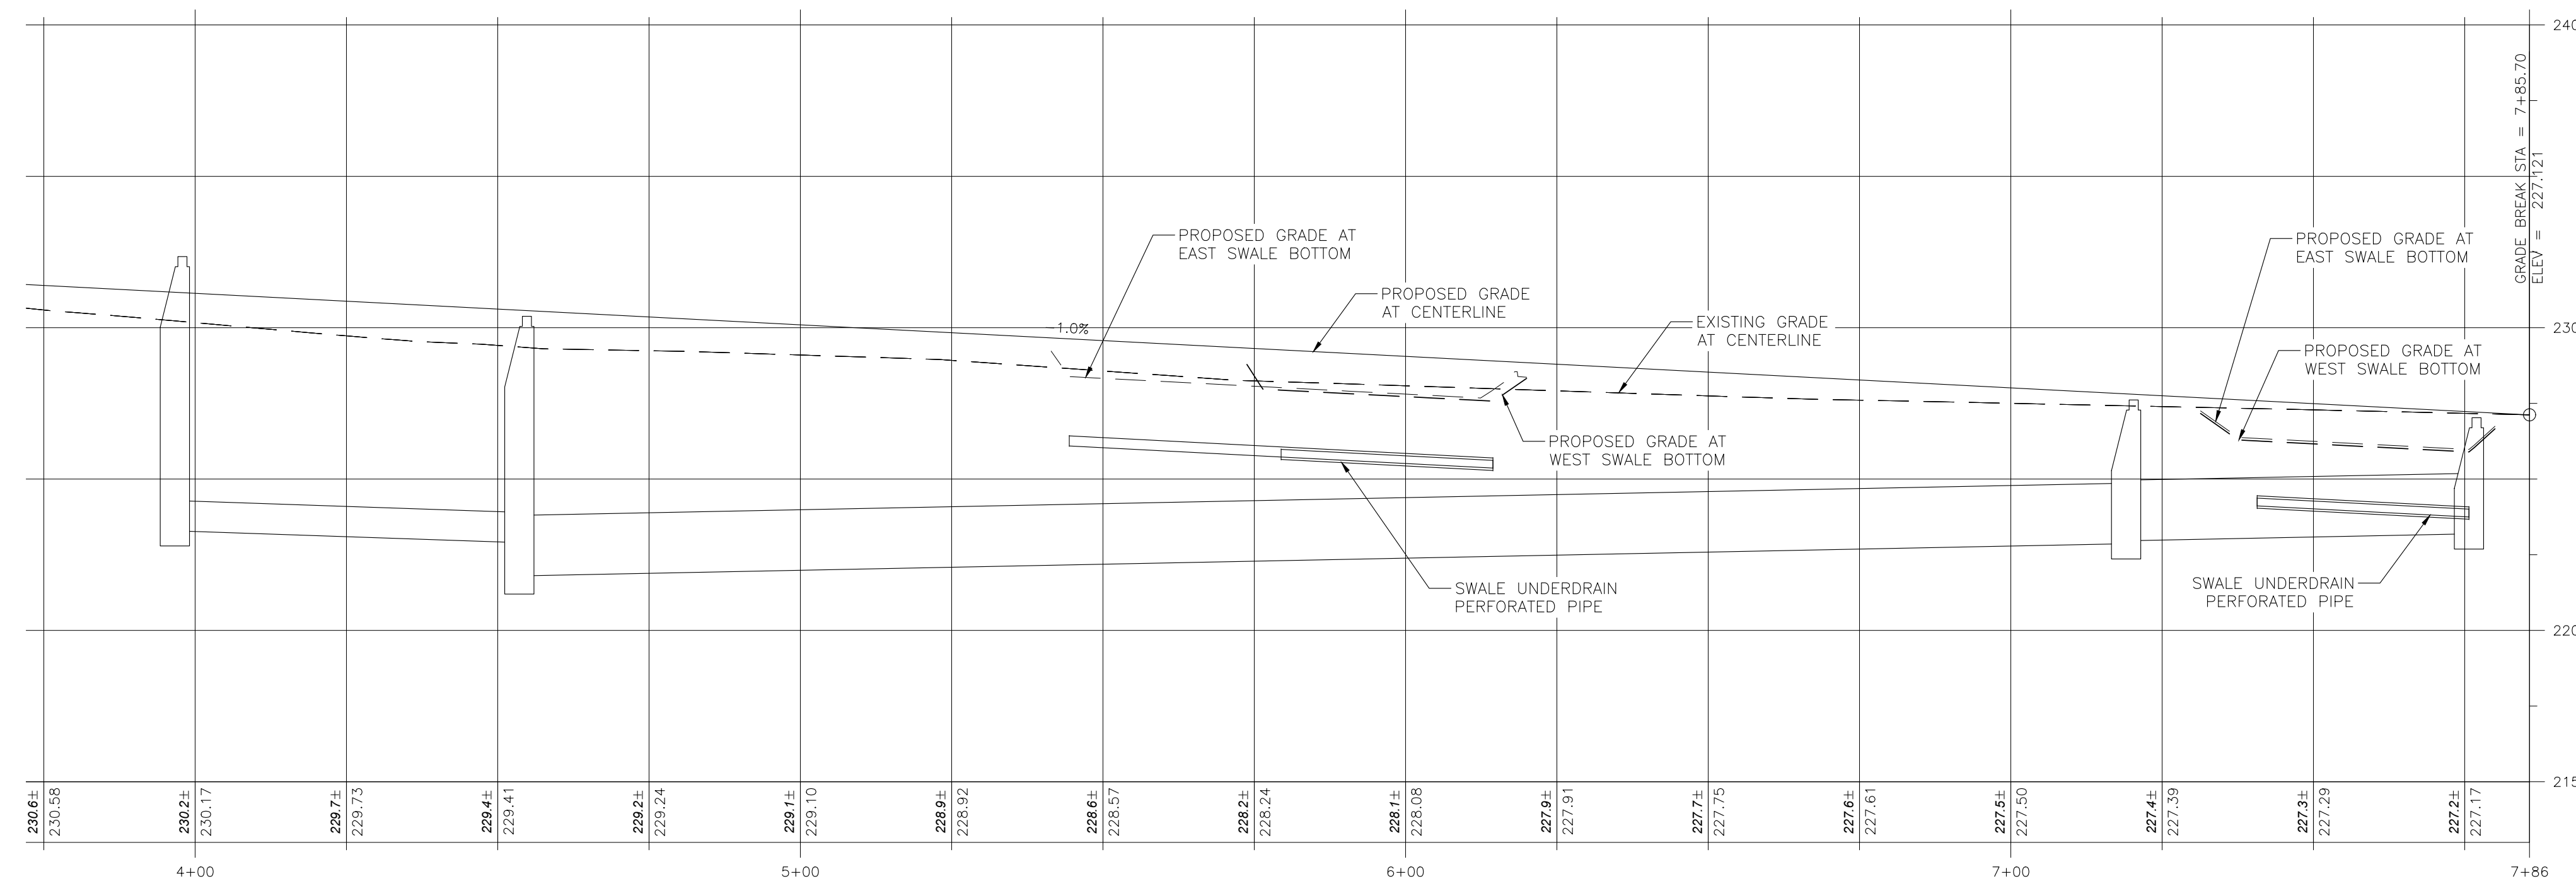

1 WEST ROW PROFILE

1" = 20' H, 1" = 4' V

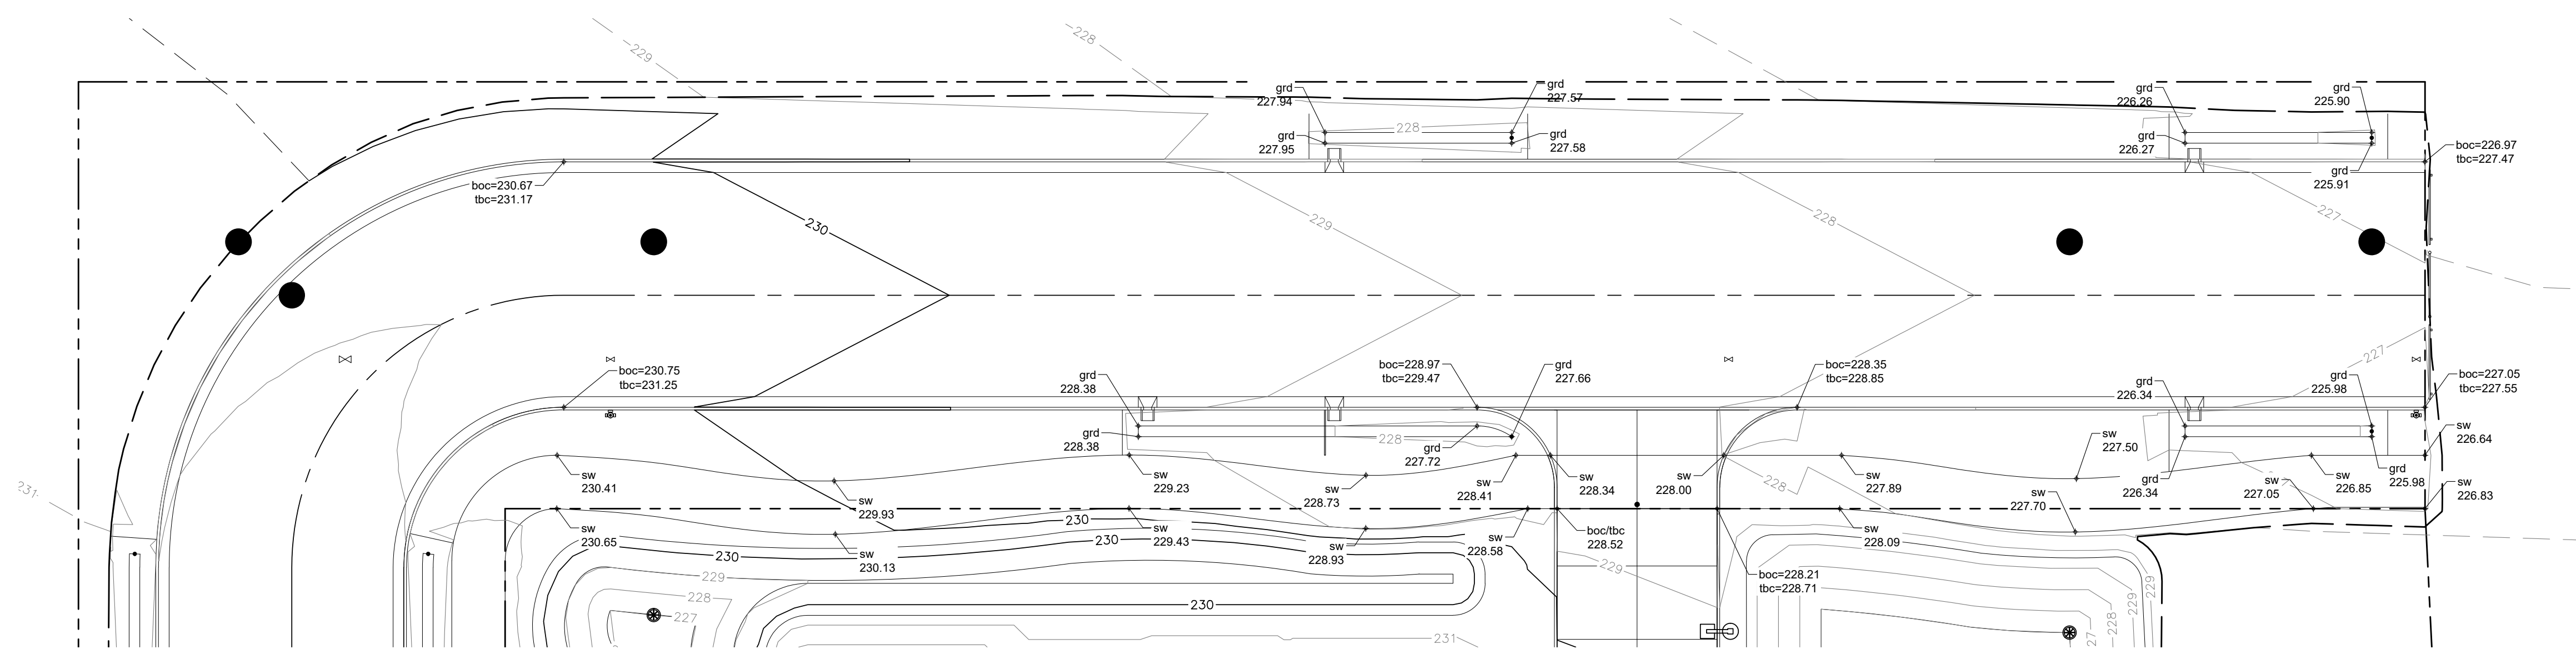

2 WEST ROW GRADING PLAN

1" = 20'



Project


Consultant

9925 SW Nimbus Ave
Suite 110
Beaverton, OR 97008
T 503-213-2013
F 503-213-2018
crowengineering.com

Revisions

No.	Description	Date
1	Pre-Bid Revisions	2/3/21

Stamp

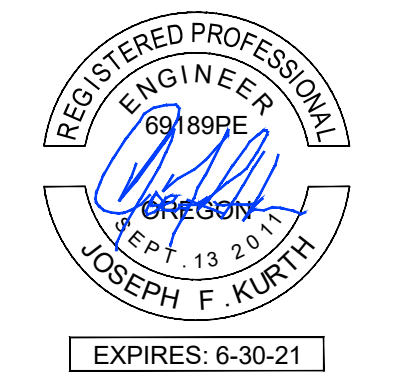

Issuance

CONFORM SET

Date

4/2/21

Project Number


20335

Drawing Title



**SOUTH ROW
UTILITY PLAN AND
PROFILE**

Sheet No


C3.10

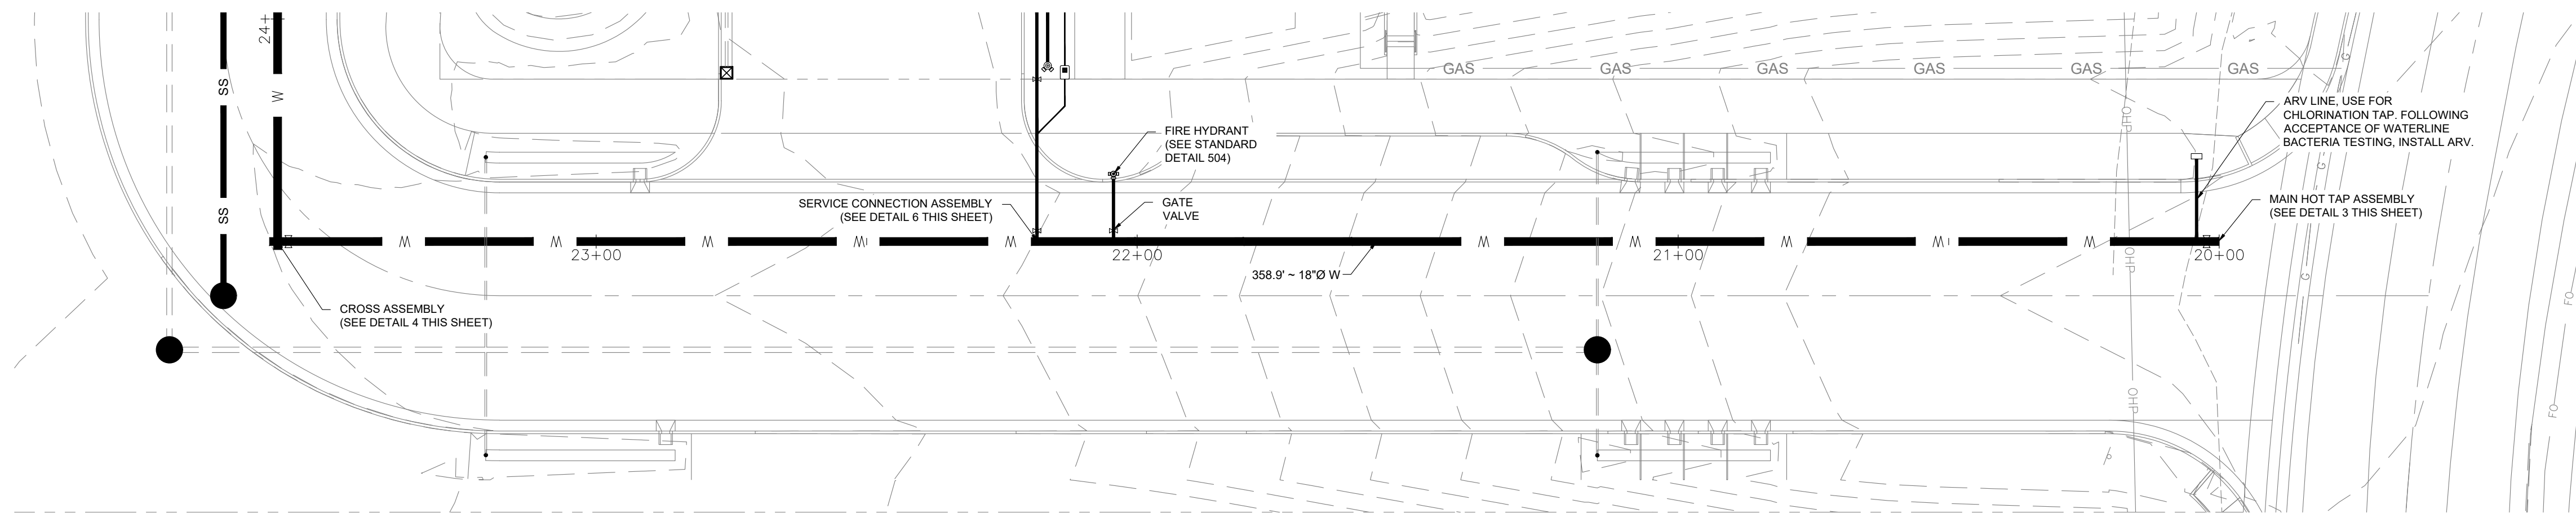

1 SOUTH ROW PUBLIC UTILITY PLAN
1" = 20'

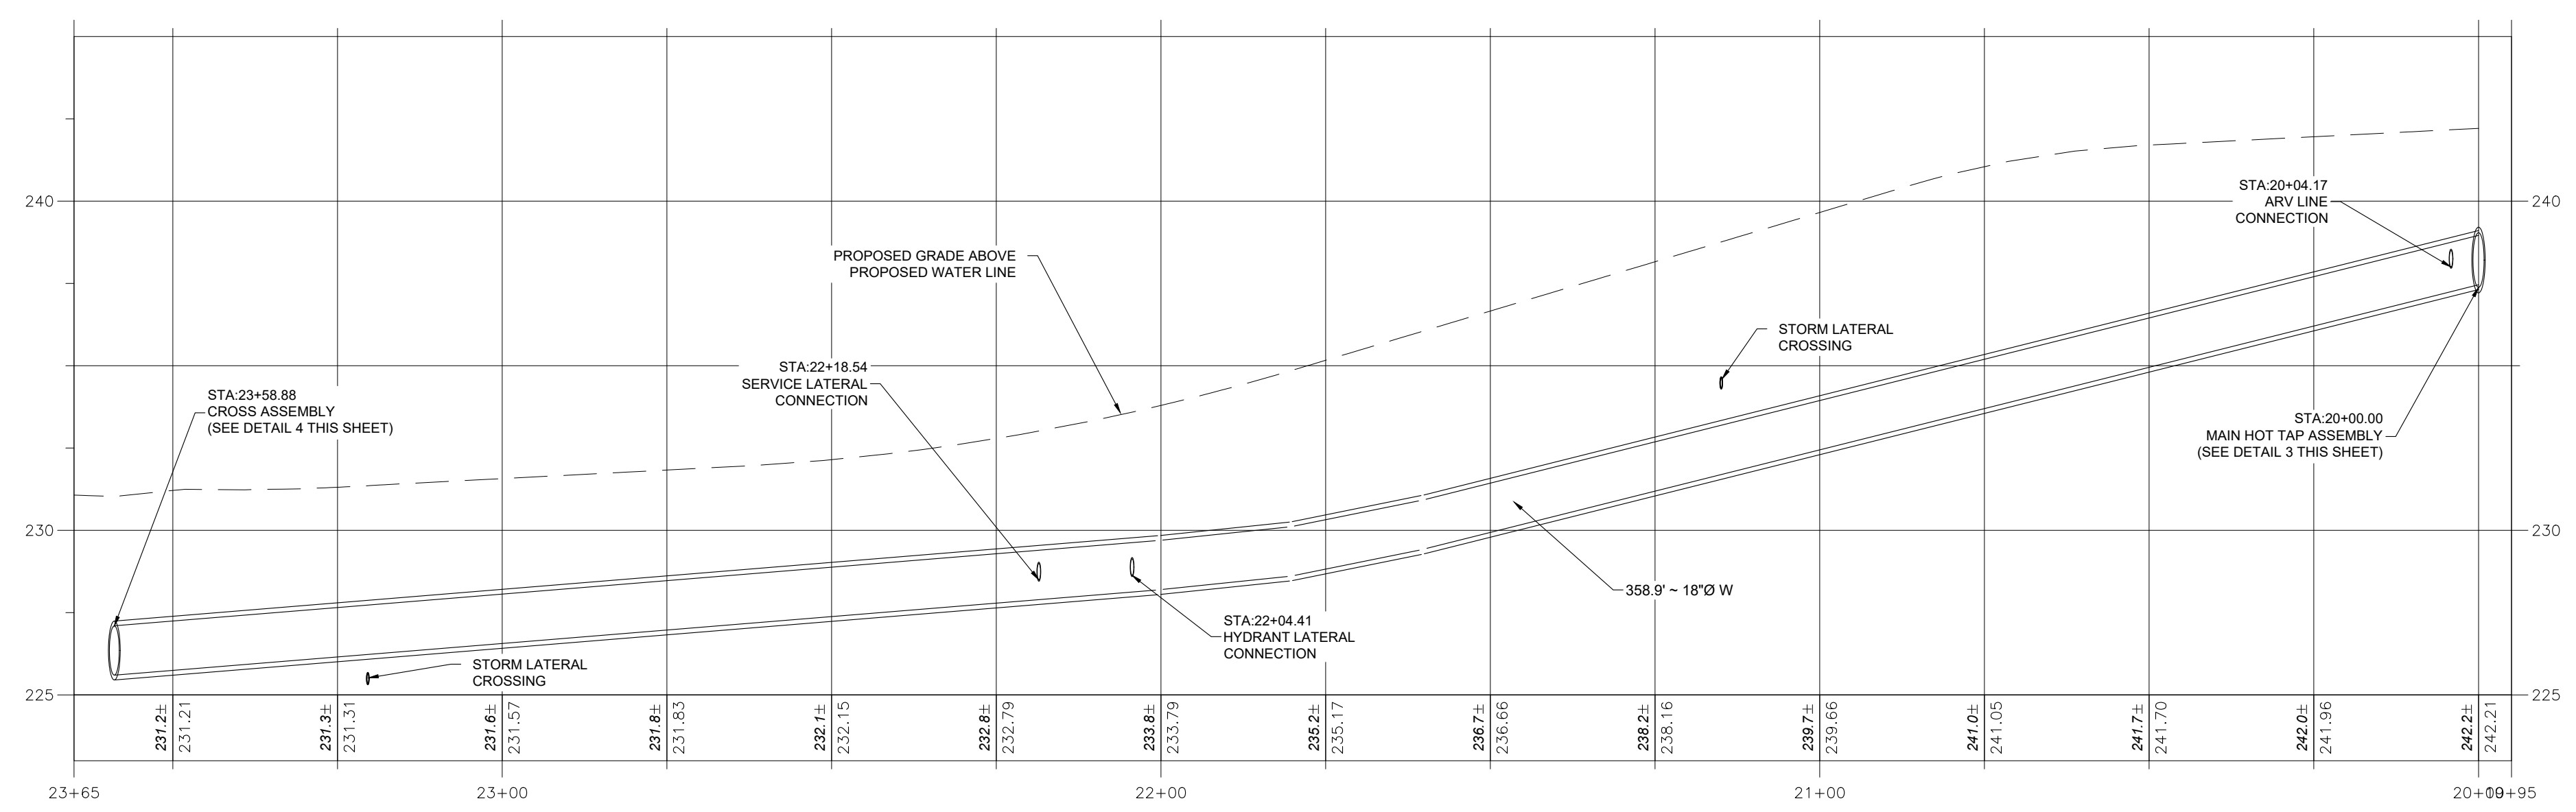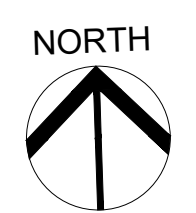


2 SOUTH ROW WATER MAIN PROFILE
1" = 20' H, 1" = 4' V

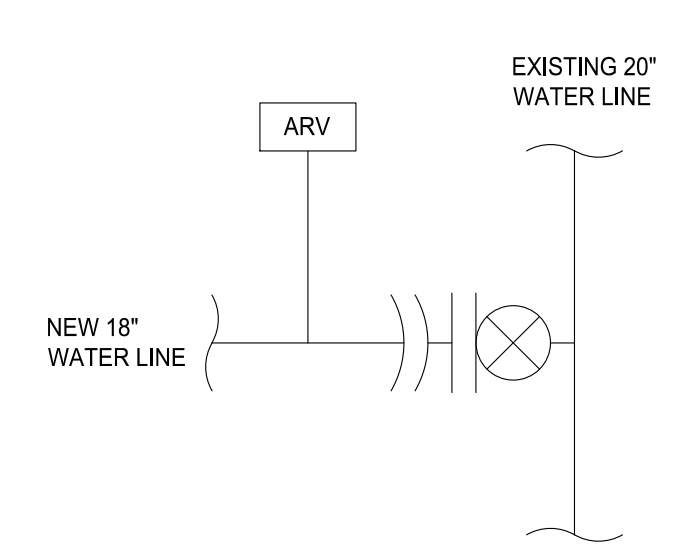


- ASSEMBLY COMPONENTS**
- (1) 18" HOT TAP
 - (1) 18" FLG x MJ ADAPTER WITH RETAINER GLAND
 - (1) ARV ASSEMBLY PER STANDARD DETAIL 509

3 MAIN HOT TAP ASSEMBLY
NTS

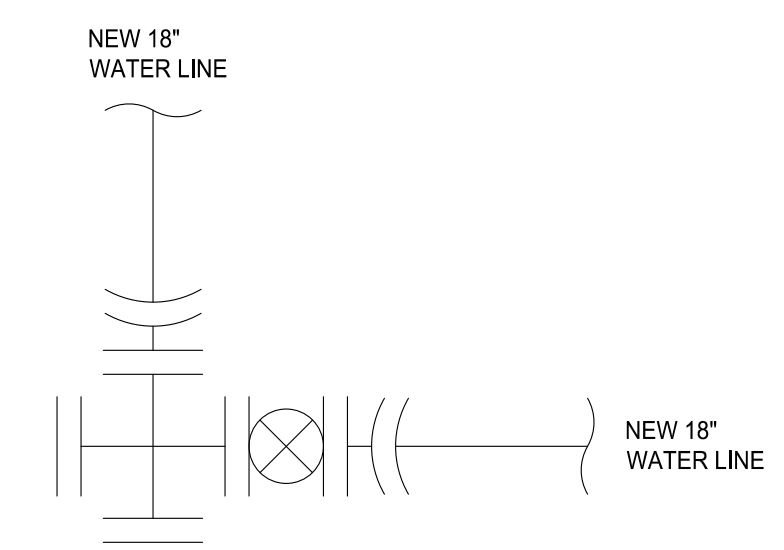


- ASSEMBLY COMPONENTS**
- (1) 18" x 18" ALL FLG CROSS
 - (2) 18" BLIND FLANGE (W&S)
 - (1) 18" FLG BV
 - (2) 18" FLG x MJ ADAPTER WITH RETAINER GLAND

4 CROSS ASSEMBLY
NTS

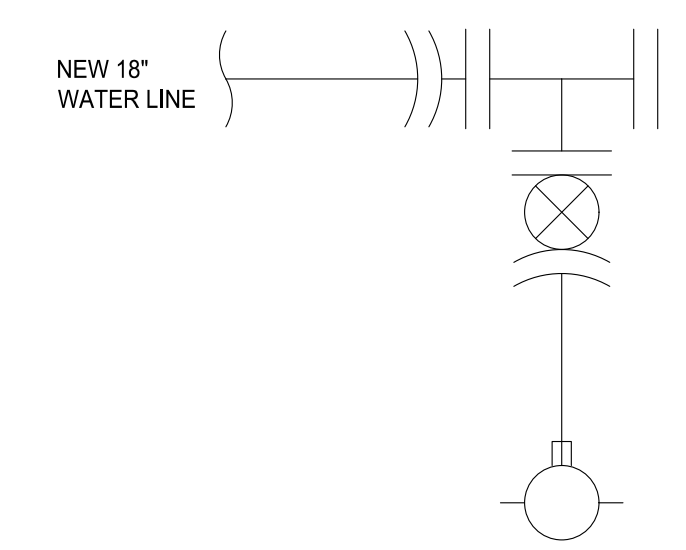

- ASSEMBLY COMPONENTS**
- (1) 18" x 6" ALL FLG TEE
 - (1) 18" BLIND FLANGE
 - (1) 18" FLG x MJ ADAPTER WITH RETAINER GLAND
 - (1) FIRE HYDRANT ASSEMBLY PER STANDARD DETAIL 504

5 END OF LINE ASSEMBLY
NTS

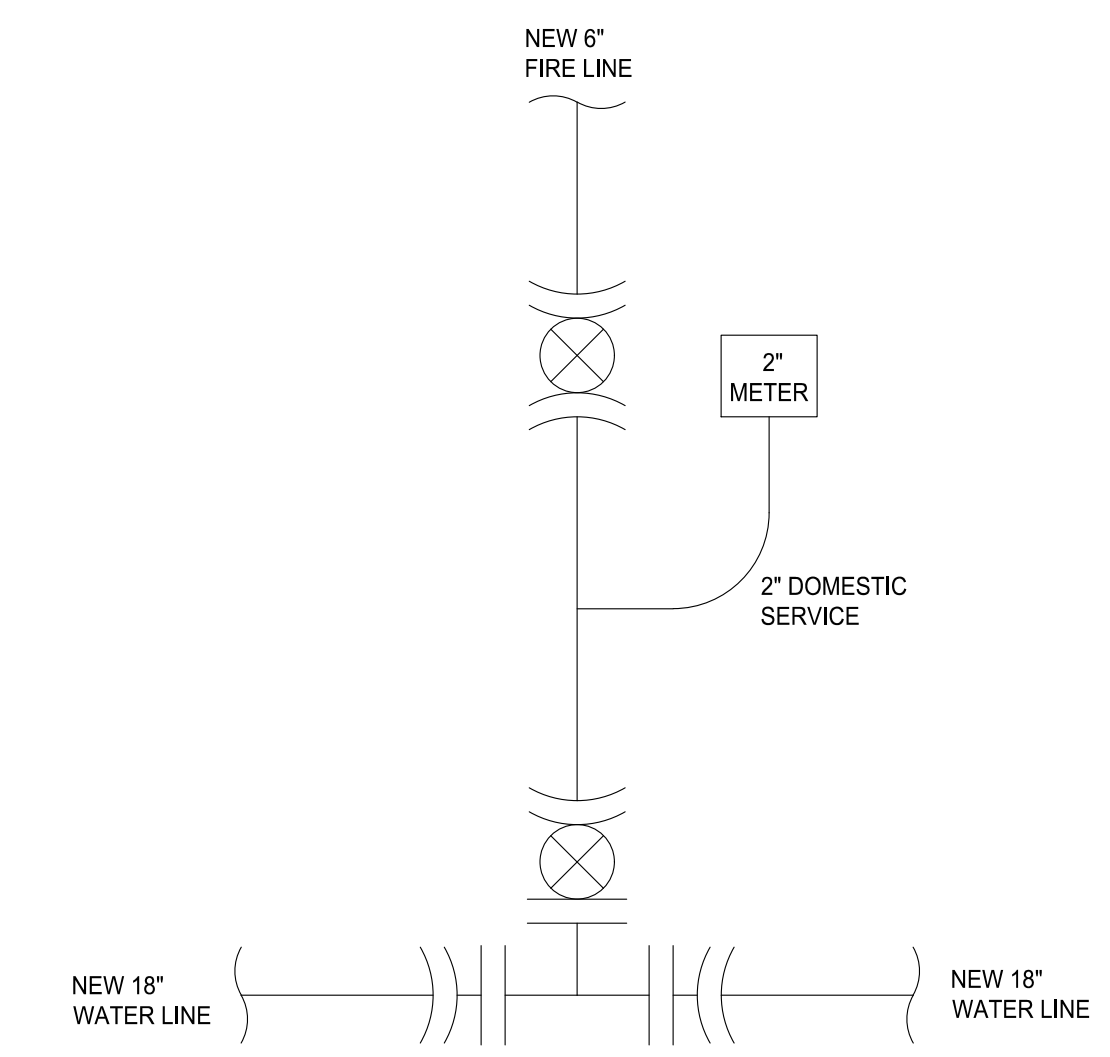

- ASSEMBLY COMPONENTS**
- (1) 18" x 6" ALL FLG TEE
 - (1) 6" FLG x MJ GV WITH RETAINER GLAND
 - (2) 18" FLG x MJ ADAPTORS WITH RETAINER GLAND
 - (1) 6" MJ x MJ GV WITH 2 RETAINER GLANDS

6 SERVICE CONNECTION ASSEMBLY
NTS

DATE: 4/2/2021 3:53 PM; FILE PATH: T:\ACTIVE PROJECTS\20335_SODERSTROMARCHITECTS_MILLERSBURG_MILLERSBURGFIRESTATION\CIVIL\3D\PRODUCTION DRAWINGS\C3.0 UTILITY PLAN; © 2019 CROW ENGINEERING, INC.



Project


Consultant



Revisions

No.	Description	Date
1	Pre-Bid Revisions	2/3/21

Stamp

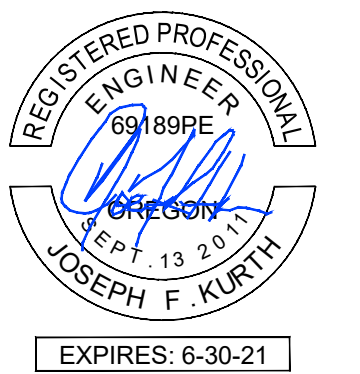

Issuance

CONFORM SET

Date

4/2/21

Project Number

20335

Drawing Title


**WEST ROW UTILITY
PLAN AND PROFILE**

Sheet No

C3.20



NOTES

- FOR WATER/SANITARY CROSSING WITH LESS THAN 18" OF VERTICAL SEPARATION, INSTALL CLSM SUPPORT PER DETAIL 3 THIS SHEET.
- BLOW OFF WATERLINE THROUGH 6" LINE PRIOR TO INSTALLING HYDRANT, THEN INSTALL HYDRANT PRIOR TO PRESSURE TESTING.

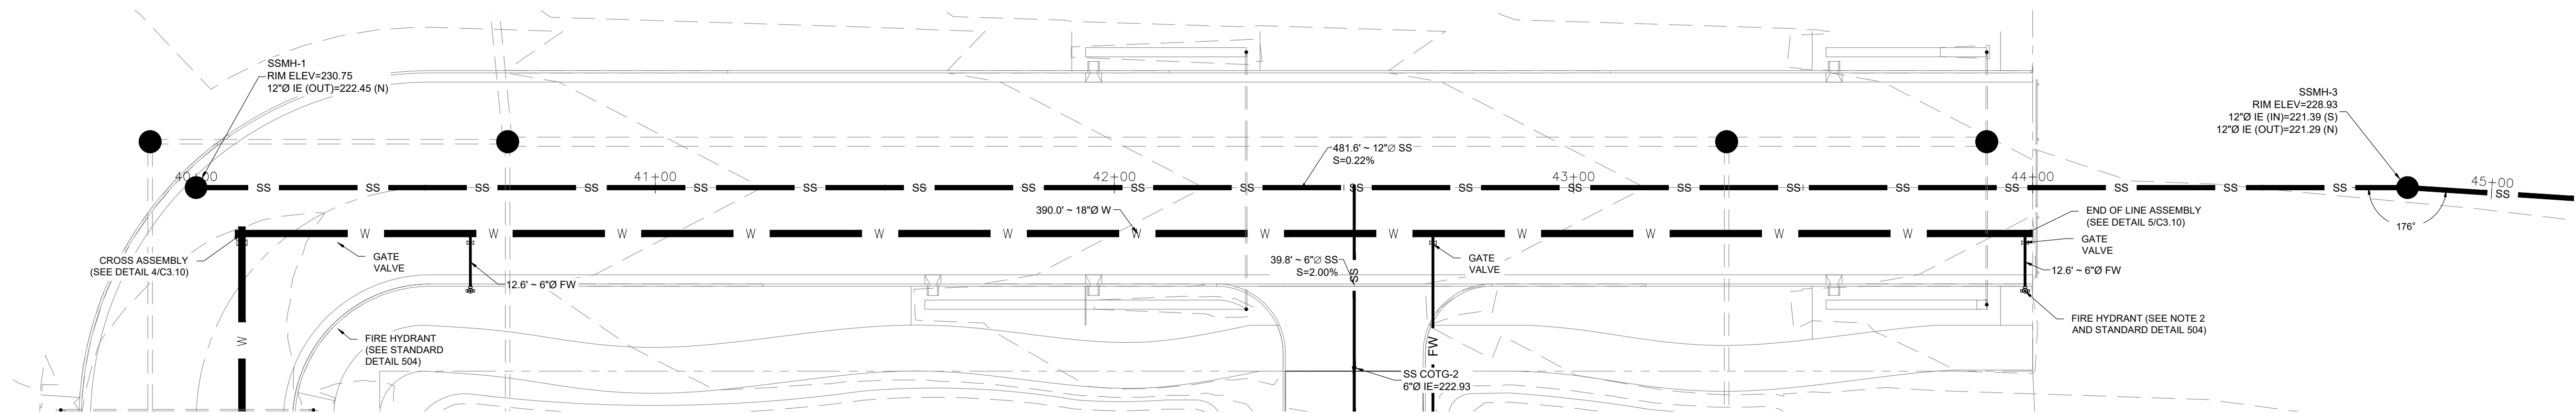


1 WEST ROW PUBLIC UTILITY PLAN (SOUTH)

1" = 20'

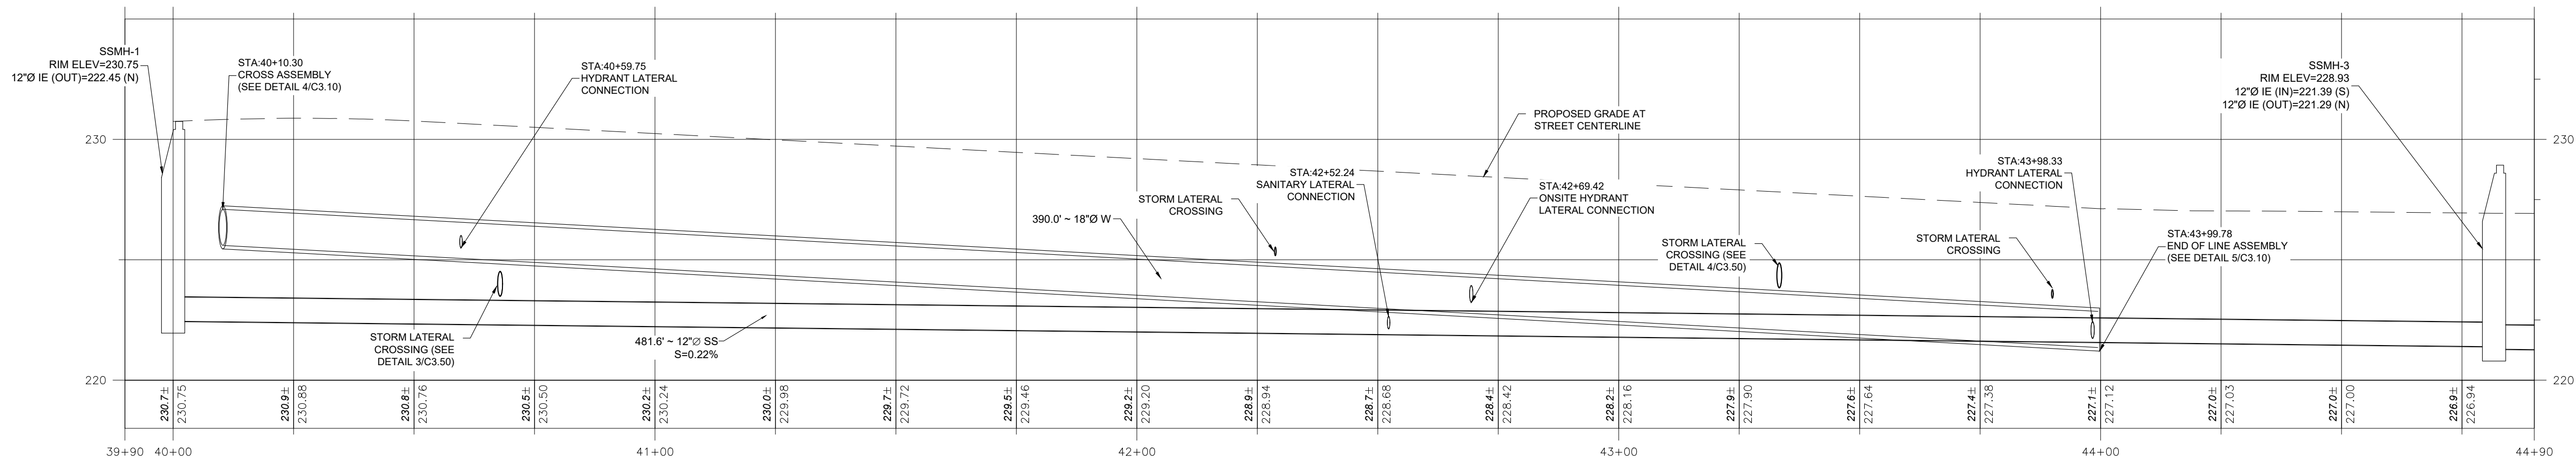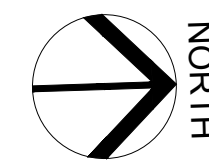

2 WEST ROW PUBLIC UTILITY PROFILE (SOUTH)

1" = 20' H, 1" = 4' V

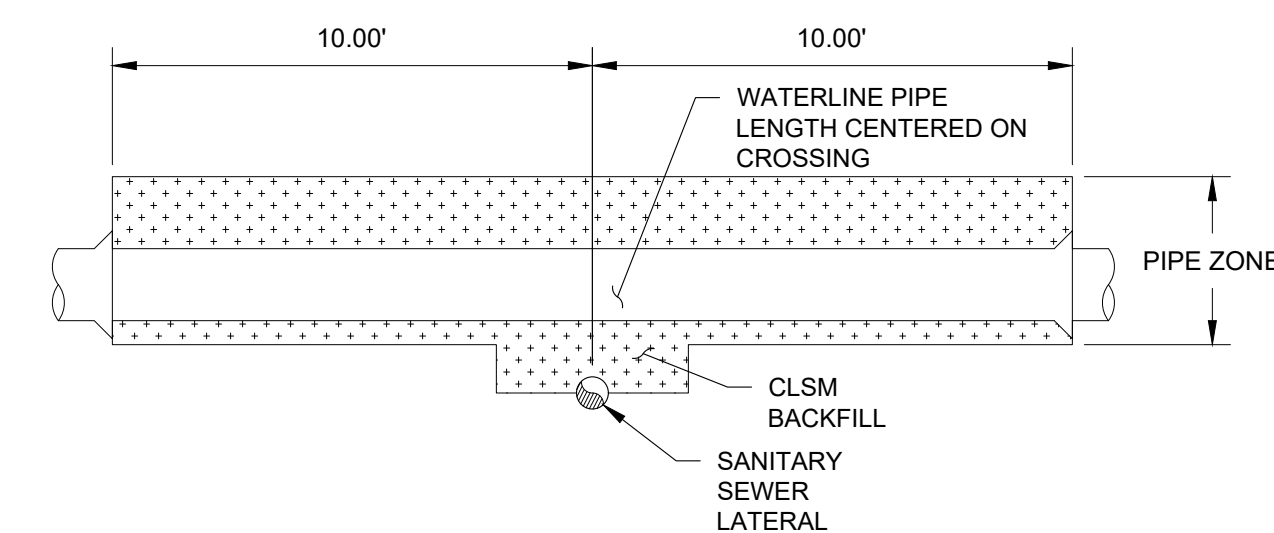


3 WATER/SANITARY CLSM BACKFILL

NTS



NOTES

1. MINIMIZE DISTURBANCE OF SOIL THROUGH WETLAND AREA. TRENCH SHALL BE A MAXIMUM OF 4 FEET WIDE. NO ADDITIONAL SOIL DISTURBANCE WITHIN THE WETLAND AREA SHALL BE ALLOWED.

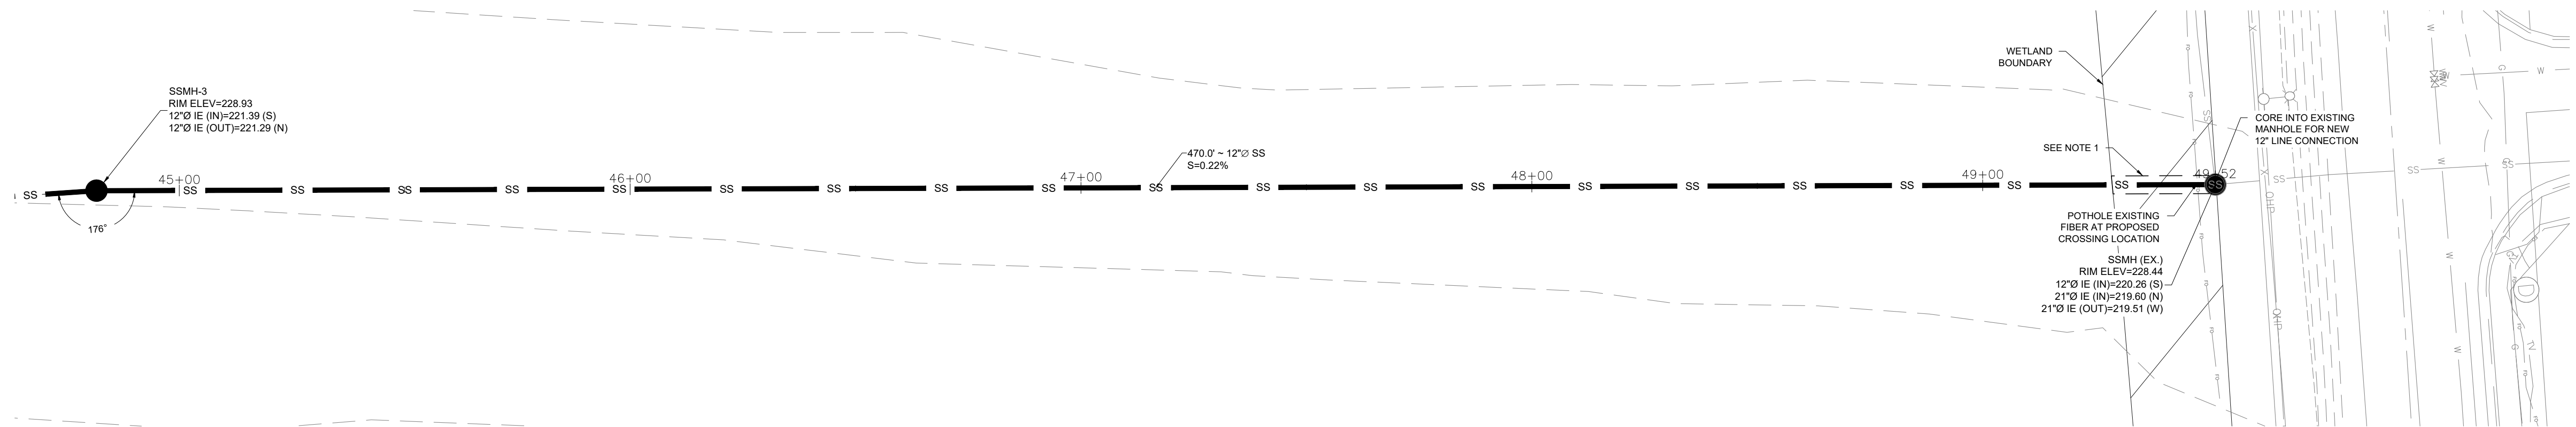

1 WEST ROW PUBLIC UTILITY PLAN (NORTH)

1" = 20'

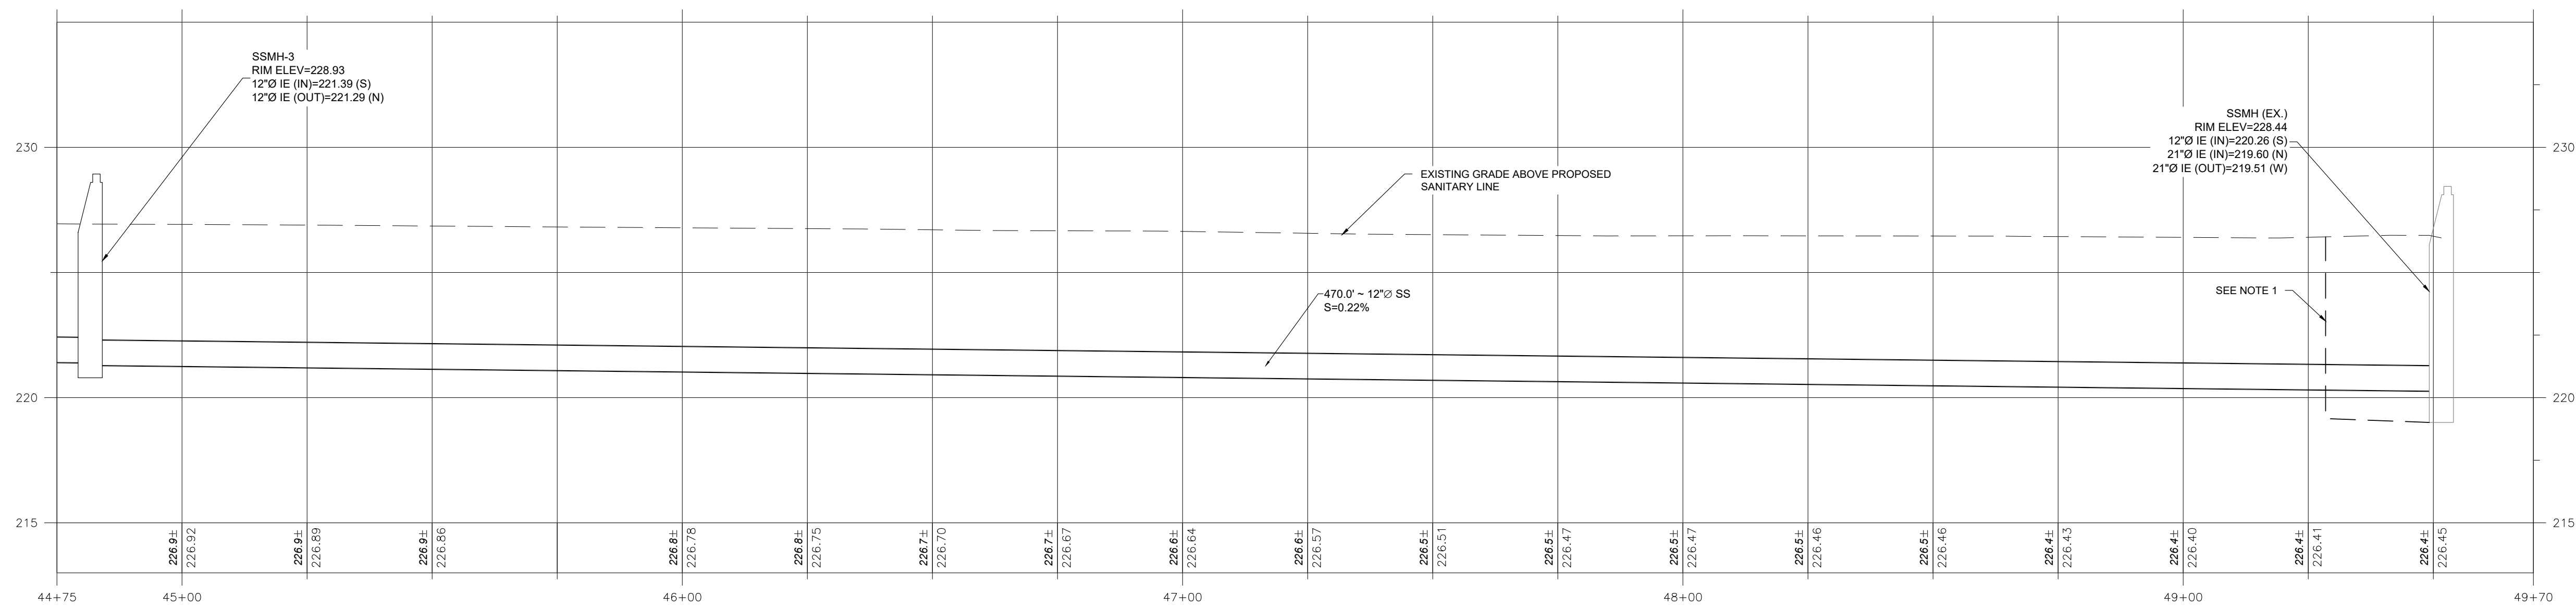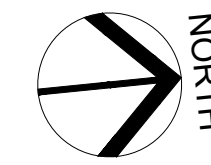

2 WEST ROW PUBLIC UTILITY PROFILE (NORTH)

1" = 20' H, 1" = 4' V



Project


Consultant



Revisions

No.	Description	Date
1	Pre-Bid Revisions	2/3/21

Stamp

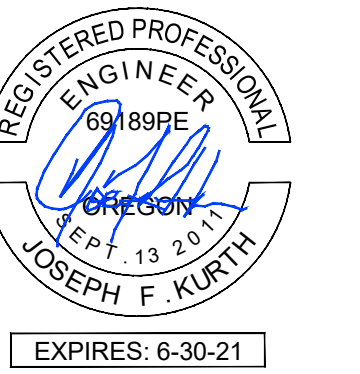

Issuance

CONFORM SET

Date
4/2/21

Project Number
20335

Drawing Title


**SOUTH ROW STORM
PLAN AND PROFILE**

Sheet No


C3.40

ROW STORM NOTES

1. SLOPE ALL ROADSIDE SWALE OVERFLOW LATERALS AS NECESSARY TO AVOID CONFLICTS WITH CROSSING UTILITIES. MAINTAIN A MINIMUM 2% SLOPE.

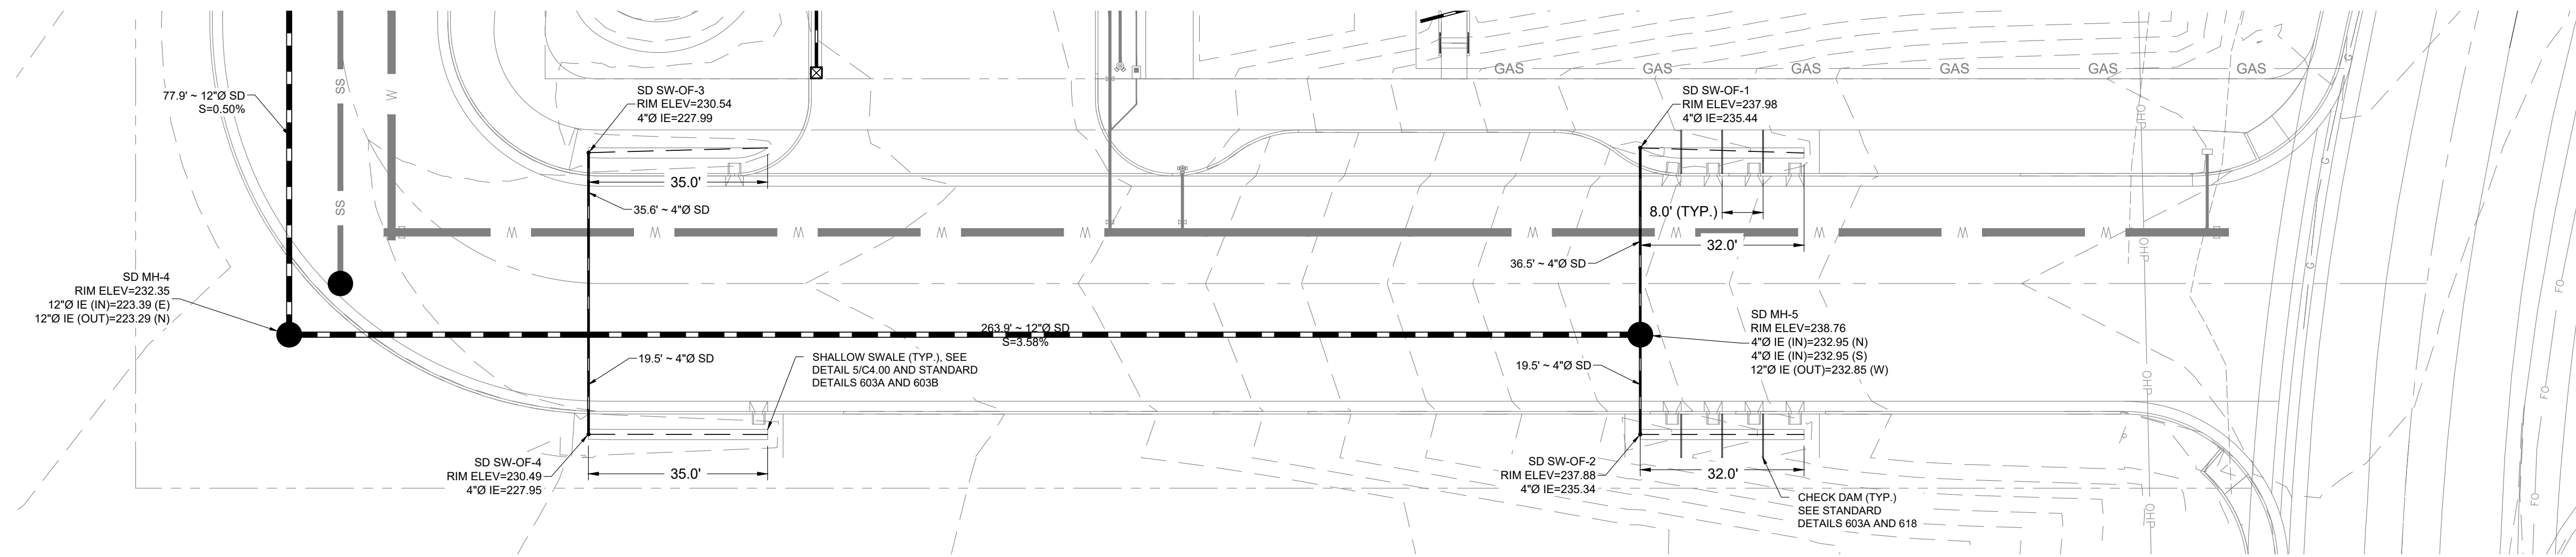


1 SOUTH ROW STORM PLAN
1" = 20'

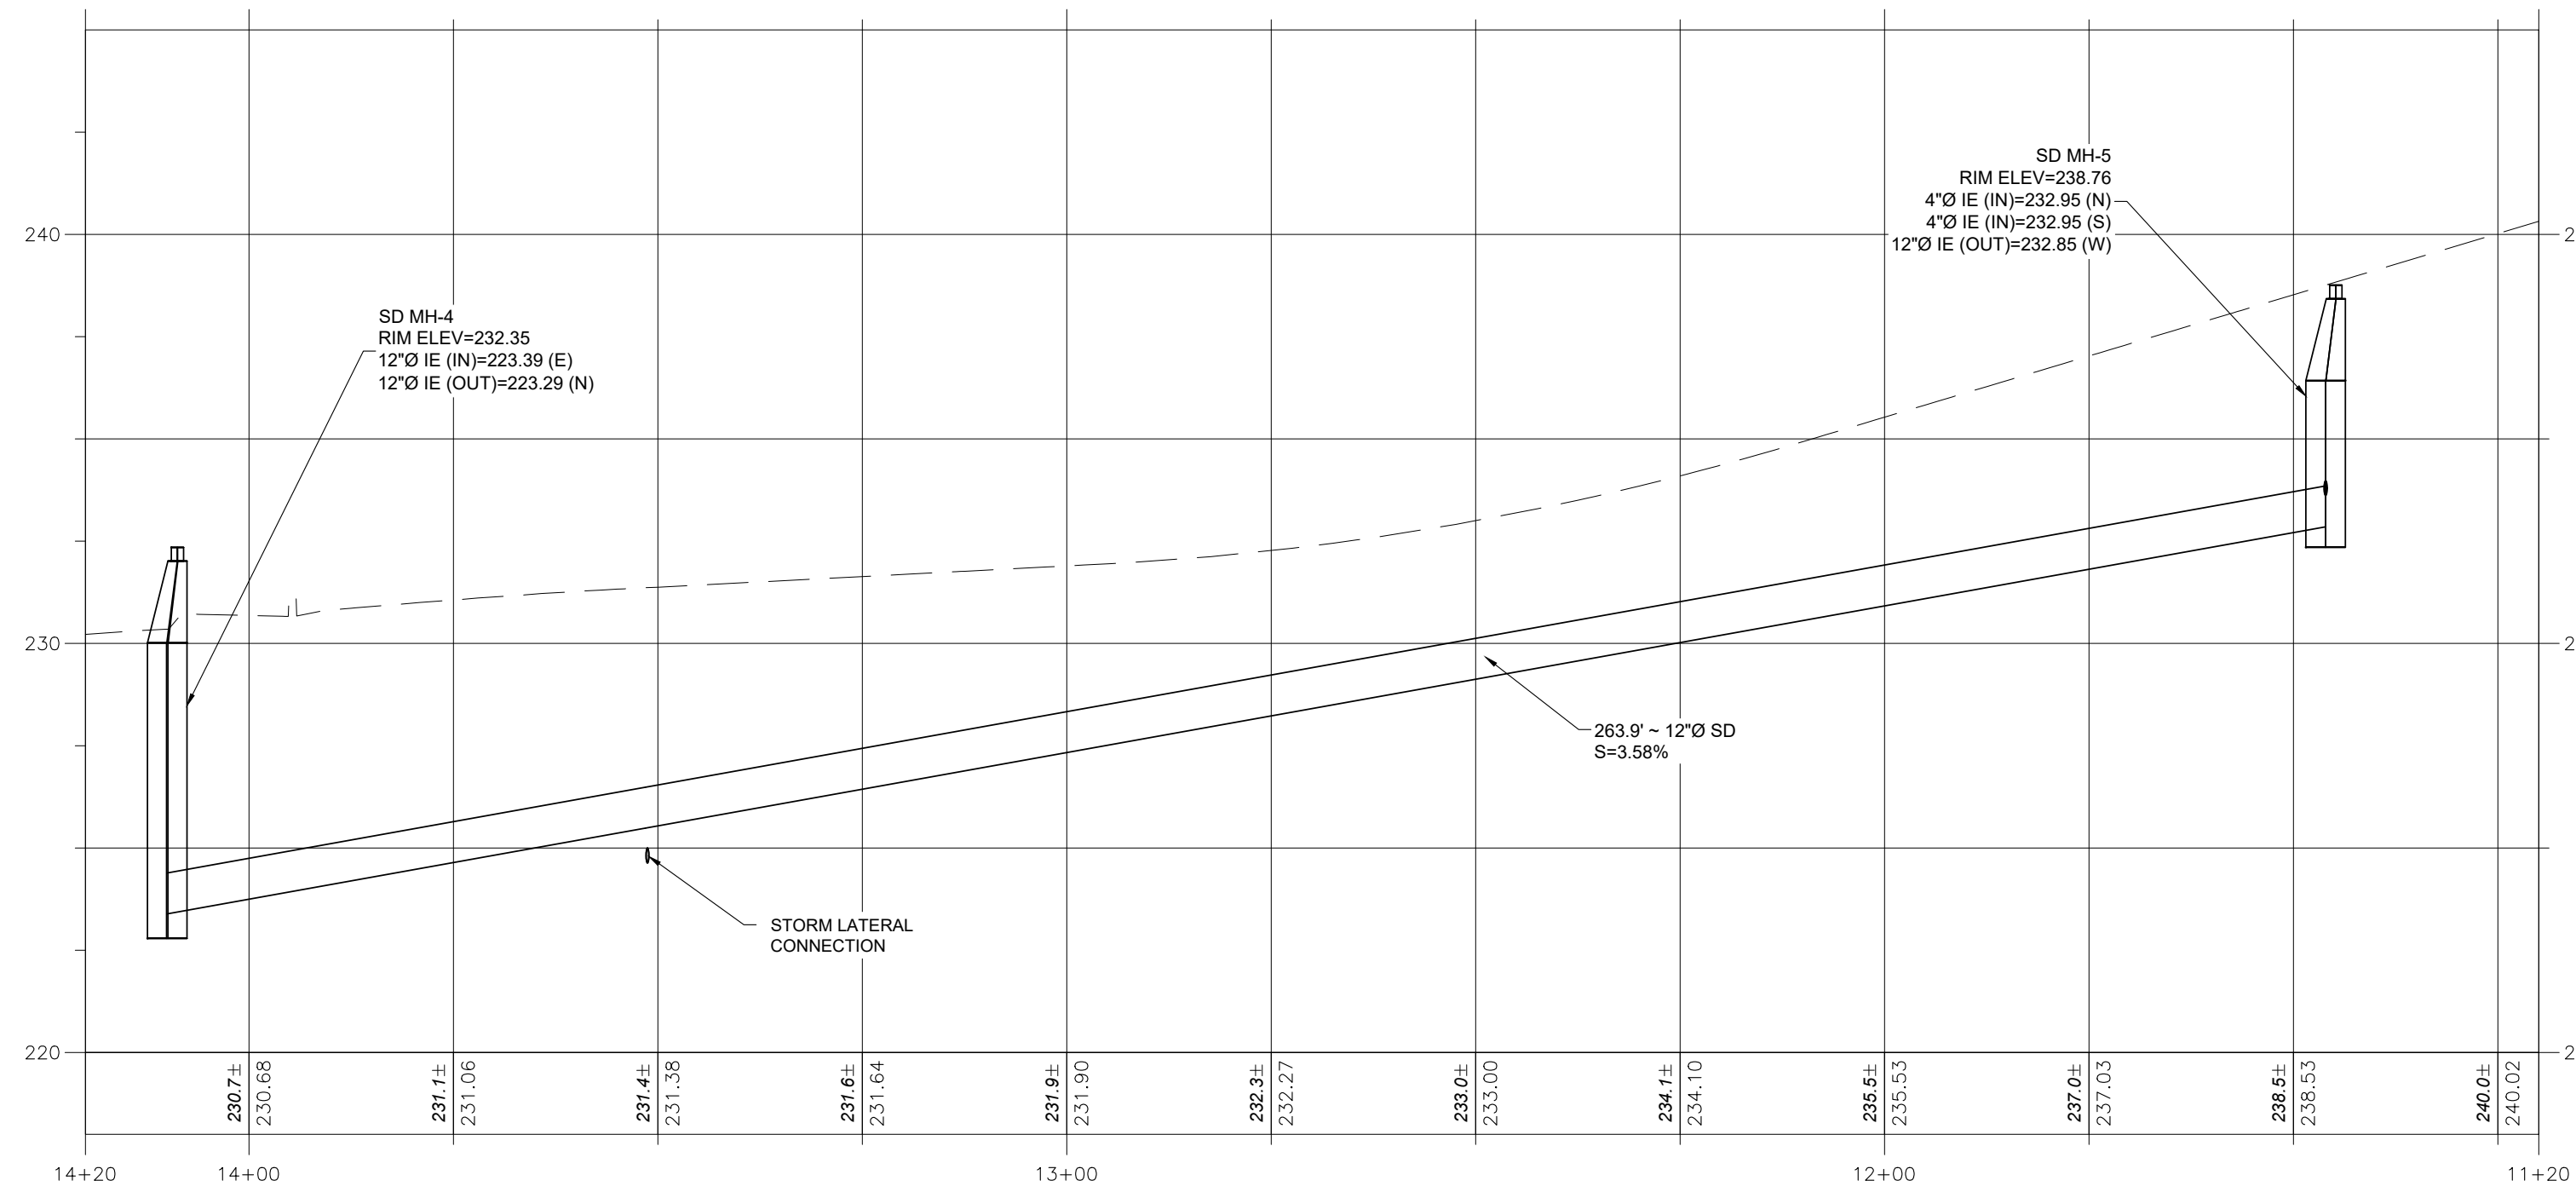

2 SOUTH ROW STORM PROFILE
1" = 20' H, 1" = 4' V

No.	Description	Date
1	Pre-Bid Revisions	2/3/21
2	Addendum 2	3/2/21

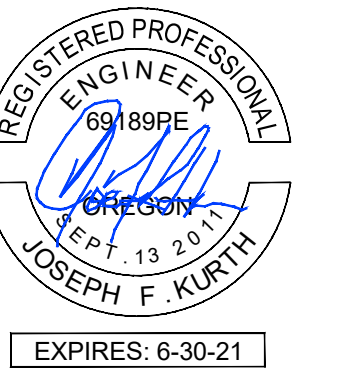

CONFORM SET

Date
4/2/21

Project Number
20335


Drawing Title

**WEST ROW STORM
PLAN AND PROFILE**


C3.50

ROW STORM NOTES


1. SLOPE ALL ROADSIDE SWALE OVERFLOW LATERALS AS NECESSARY TO AVOID CONFLICTS WITH CROSSING UTILITIES. MAINTAIN A MINIMUM 2% SLOPE.
2. FOR STORM/WATER OR STORM/SANITARY CROSSINGS WITH LESS THAN 12" OF VERTICAL SEPARATION, INSTALL CLSM SUPPORT PER DETAIL 5 THIS SHEET.

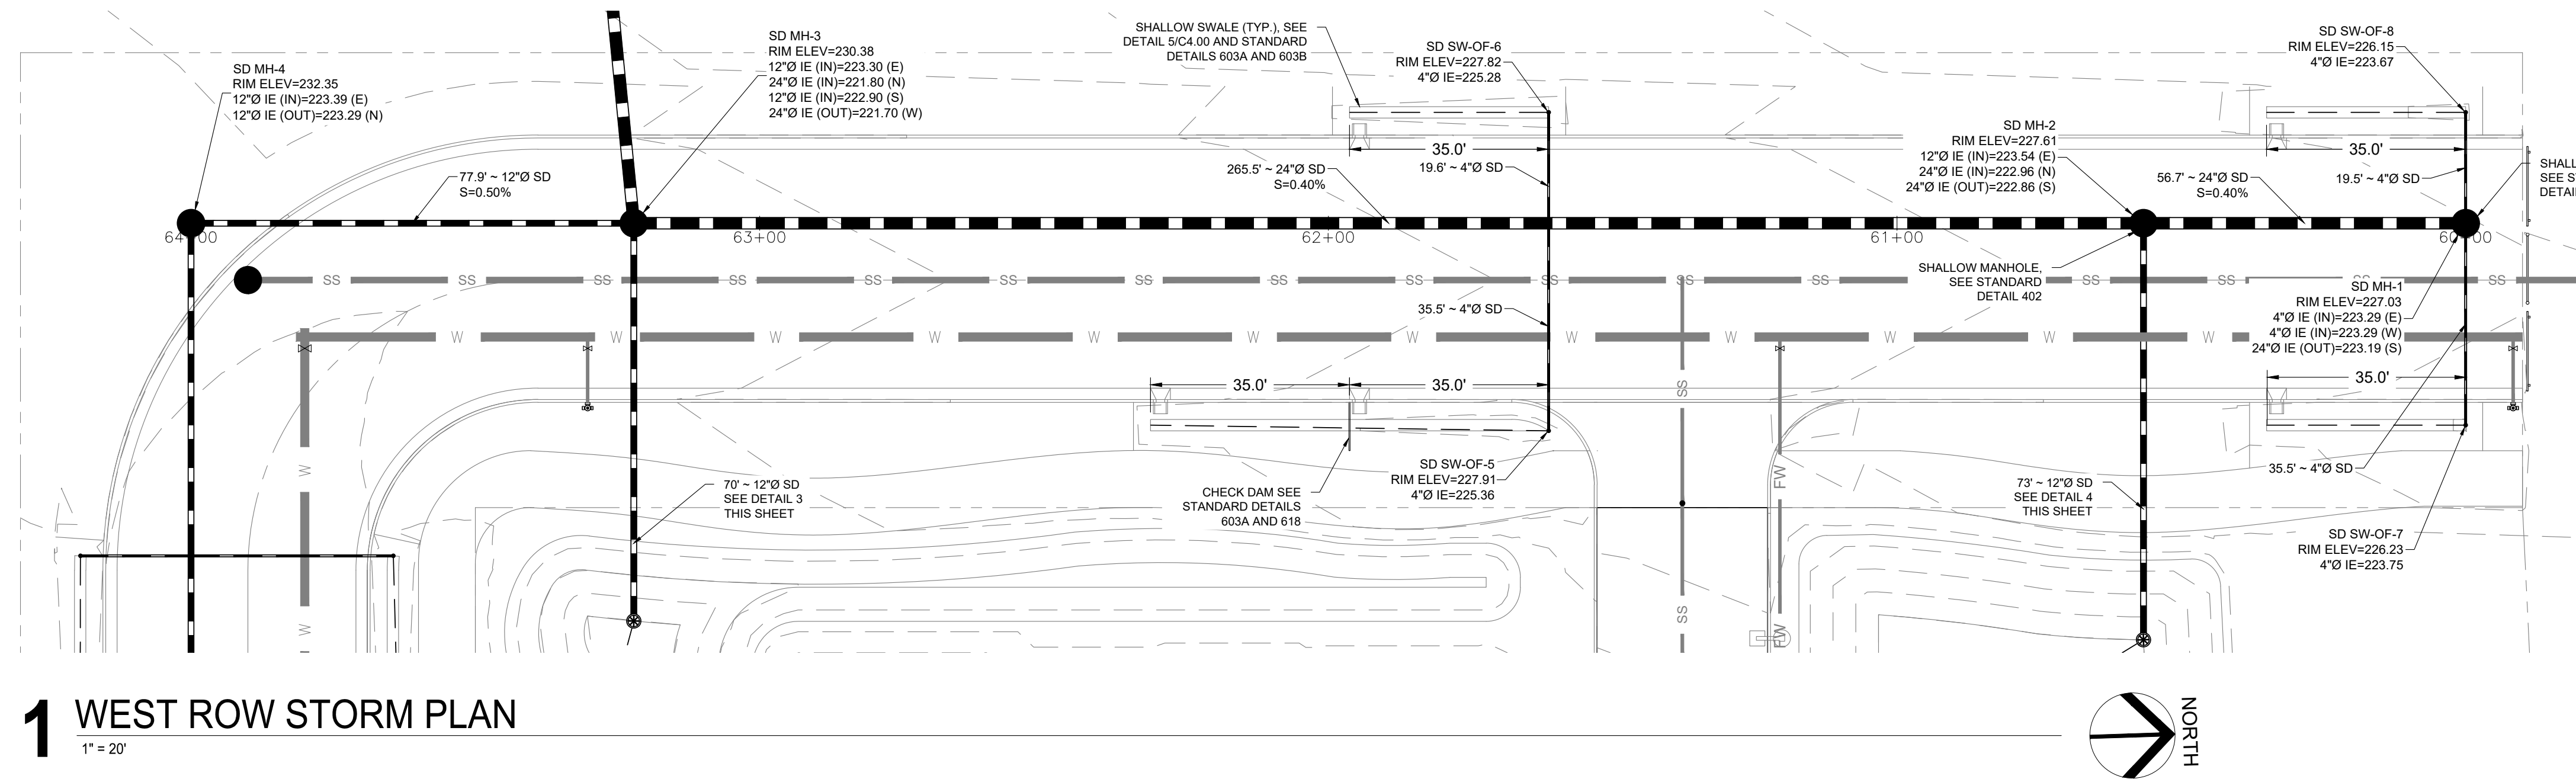


1 WEST ROW STORM PLAN
1" = 20'

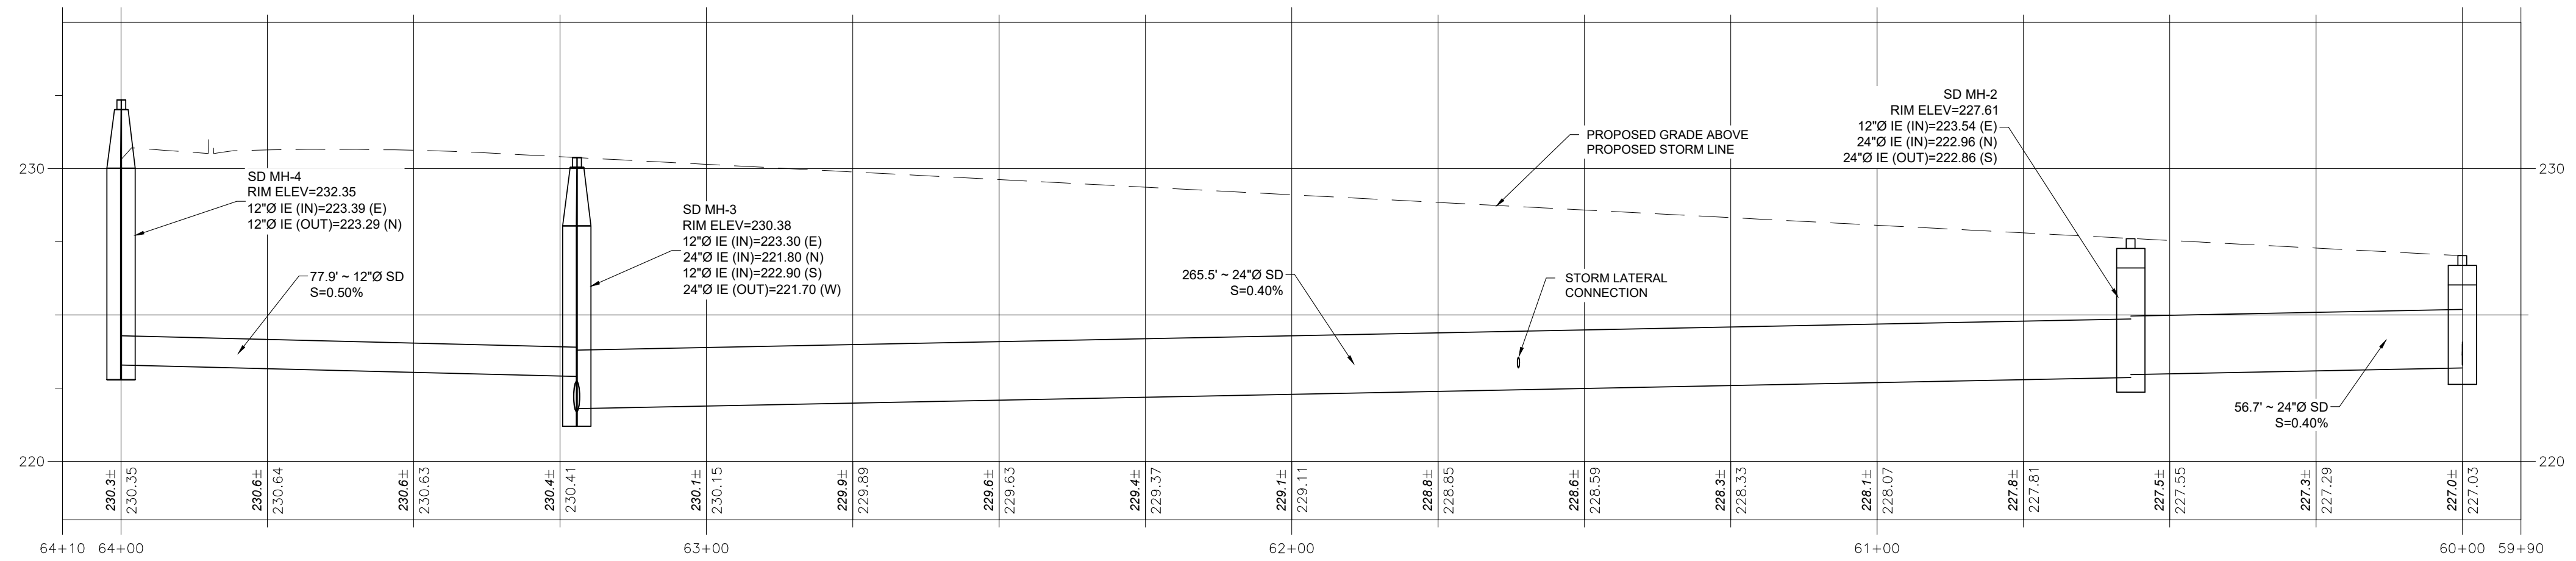


2 WEST ROW STORM PROFILE
1" = 20' H, 1" = 4' V

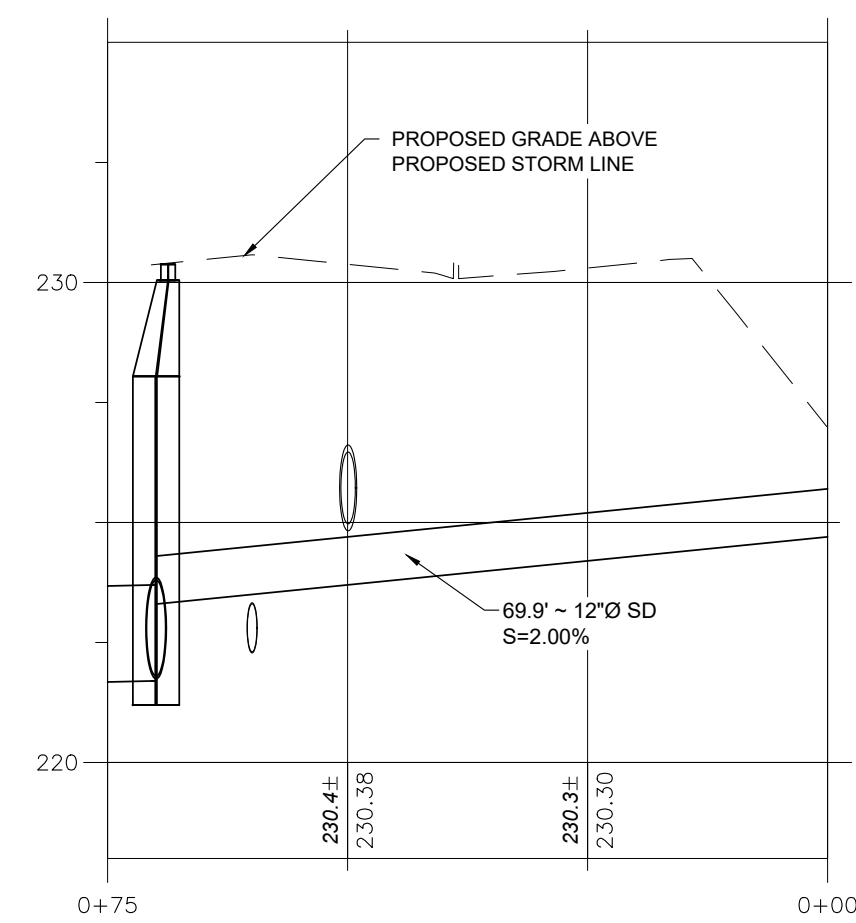

3 SOUTH OVERFLOW LATERAL PROFILE
1" = 20' H, 1" = 4' V

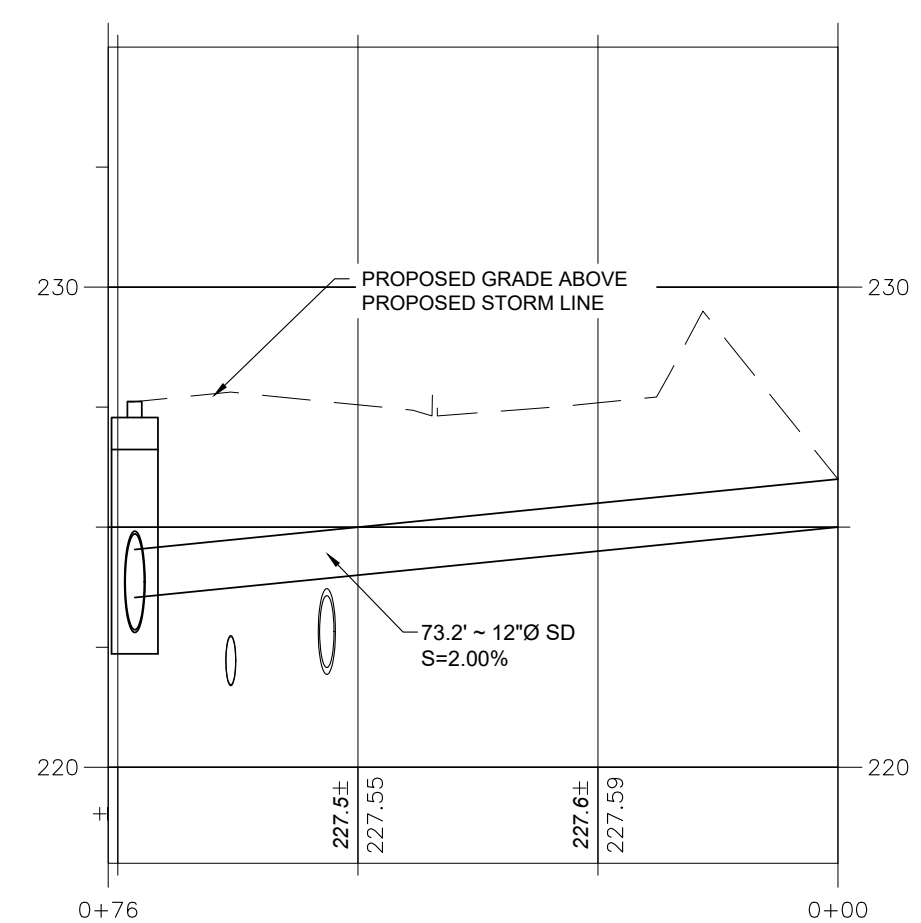

4 NORTH OVERFLOW LATERAL PROFILE
1" = 20' H, 1" = 4' V

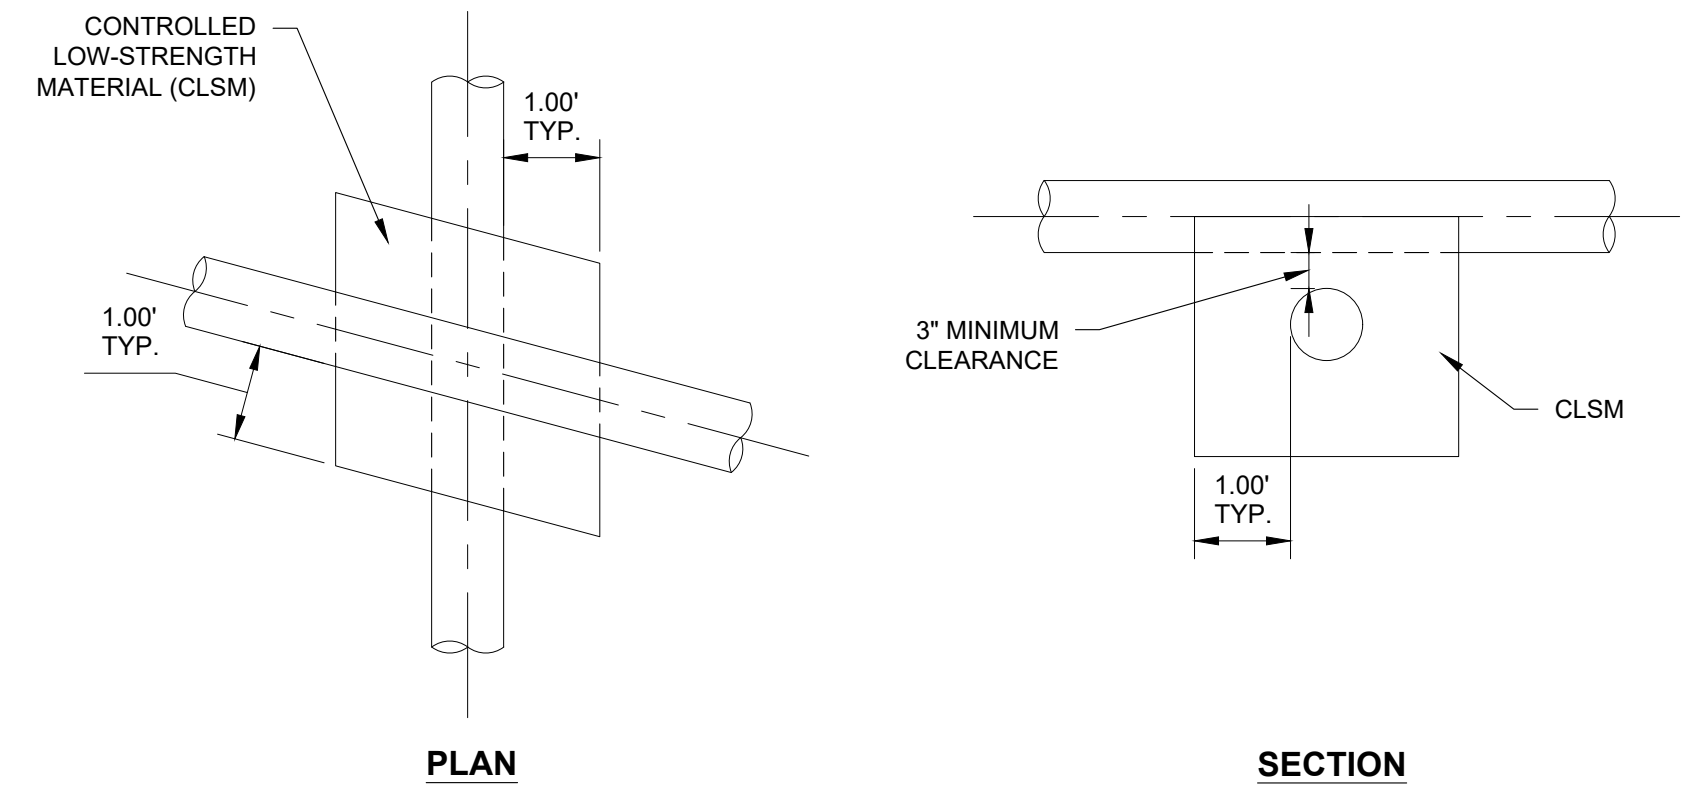

NOTES

1. FOR CLSM REQUIREMENTS, REFER TO THE OREGON DOT STANDARD SPECIFICATION FOR CONSTRUCTION, SECTION 00442, 2021 EDITION.

5 CLSM SUPPORT
NTS



Project

Consultant



Revisions

No.	Description	Date
1	Pre-Bid Revisions	2/3/21

Stamp



Issuance

CONFORM SET

Date

4/2/21

Project Number


20335

Drawing Title


**WEST STORM
OUTFALL PLAN AND
PROFILE**

Sheet No


C3.60

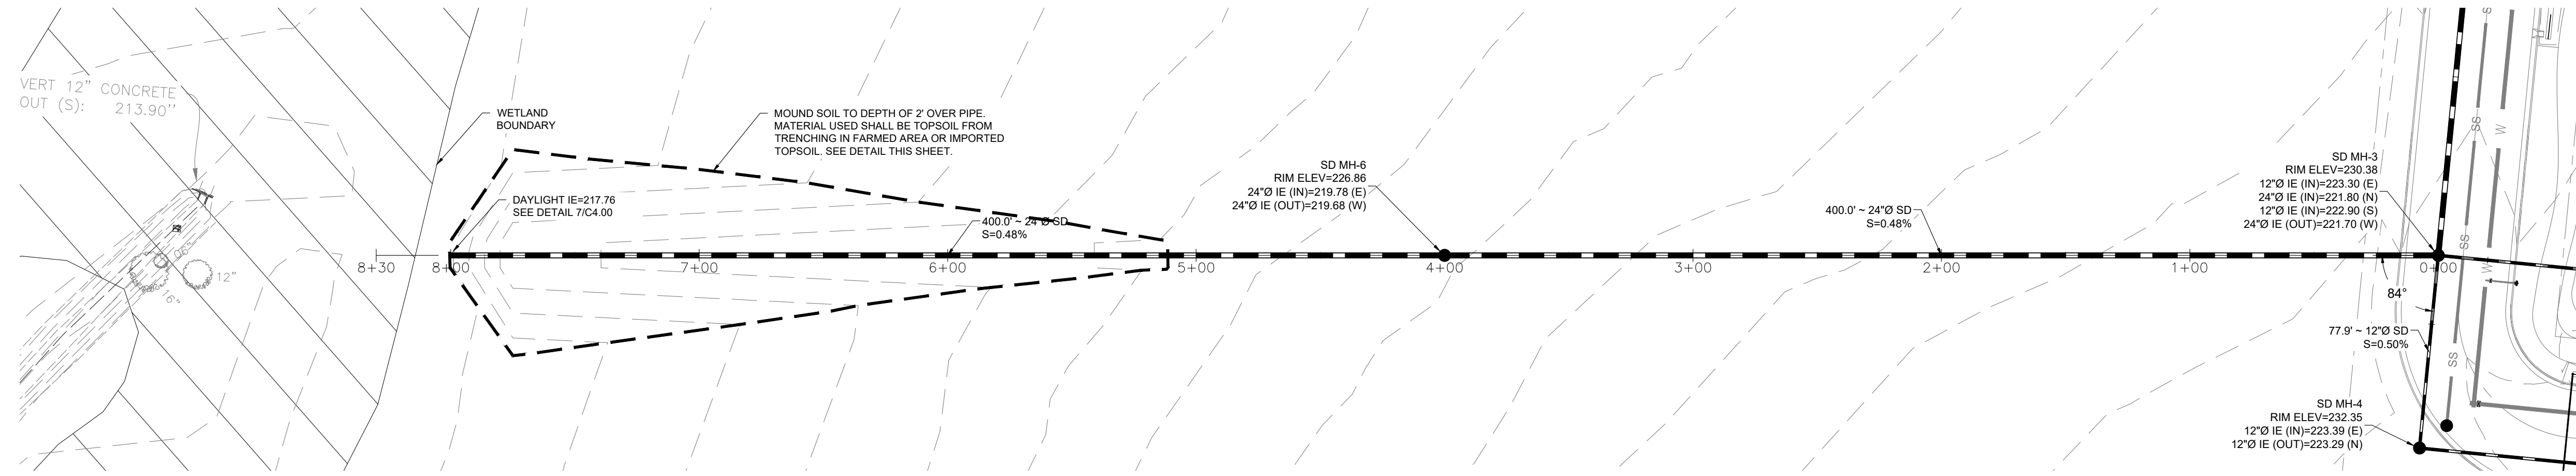

1 WEST STORM OUTFALL PLAN
1" = 40'

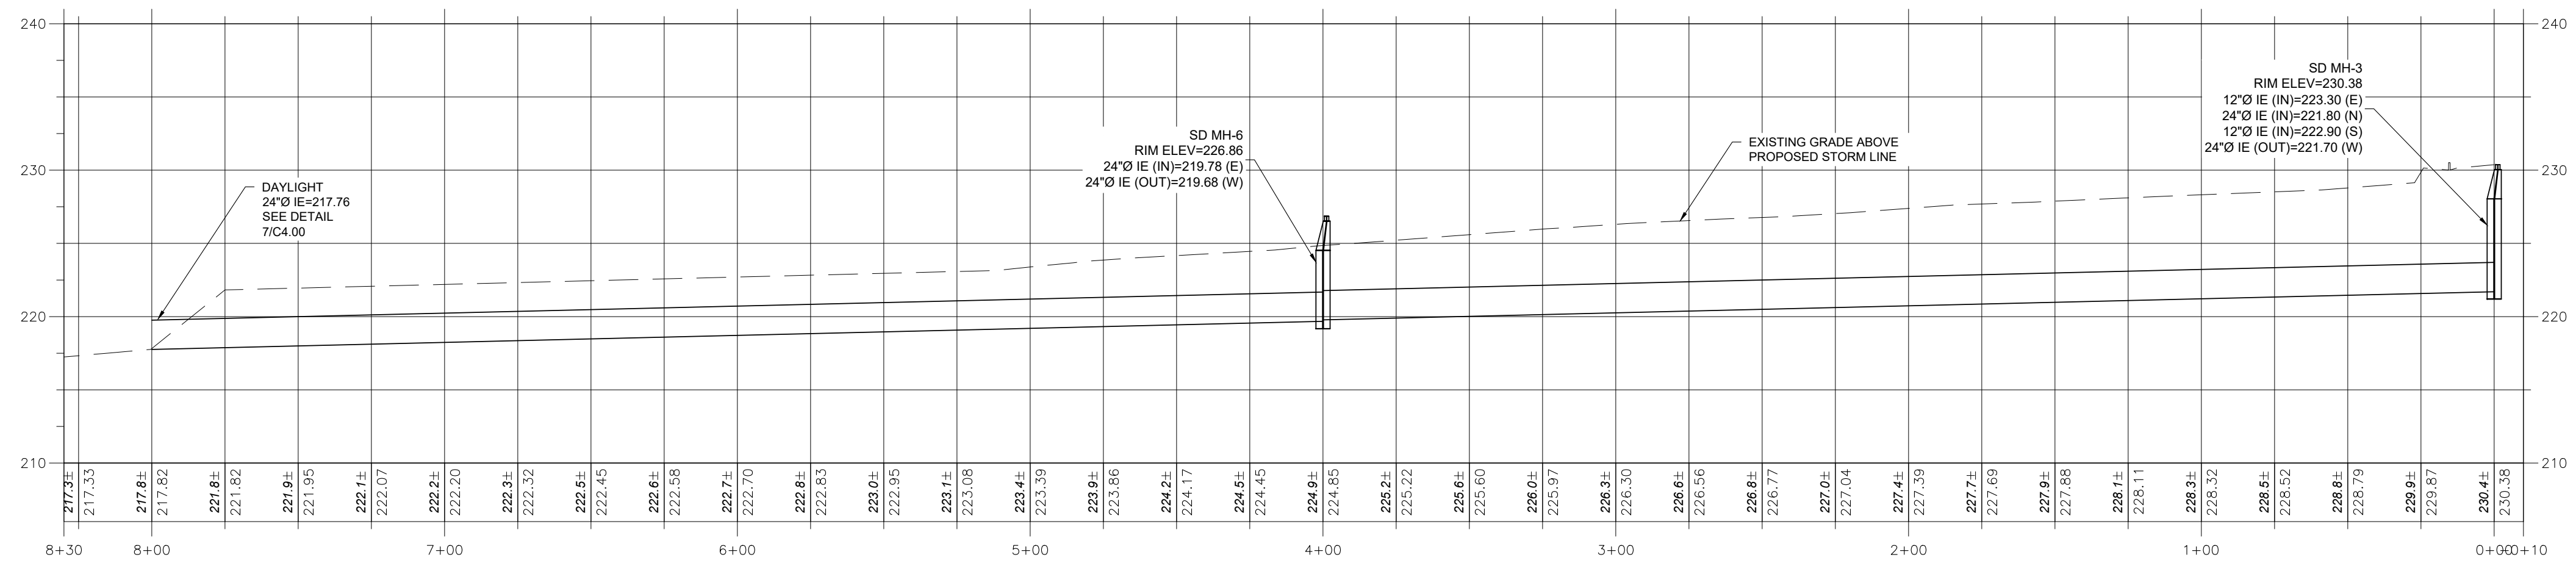

2 WEST STORM OUTFALL PROFILE
1" = 40' H, 1" = 8' V

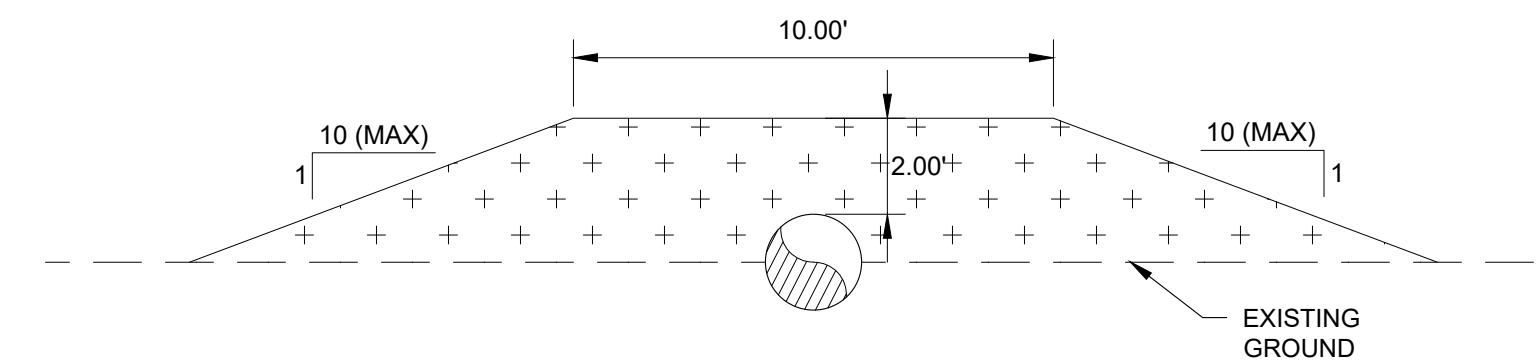

3 OUTFALL PIPE COVER DETAIL
NTS



Project

Consultant



Revisions

No.	Description	Date
1	Pre-Bid Revisions	2/3/21

Stamp



Issuance

CONFORM SET

Date
4/2/21









Project Number
20335

Drawing Title

DETAILS

Sheet No

C4.00

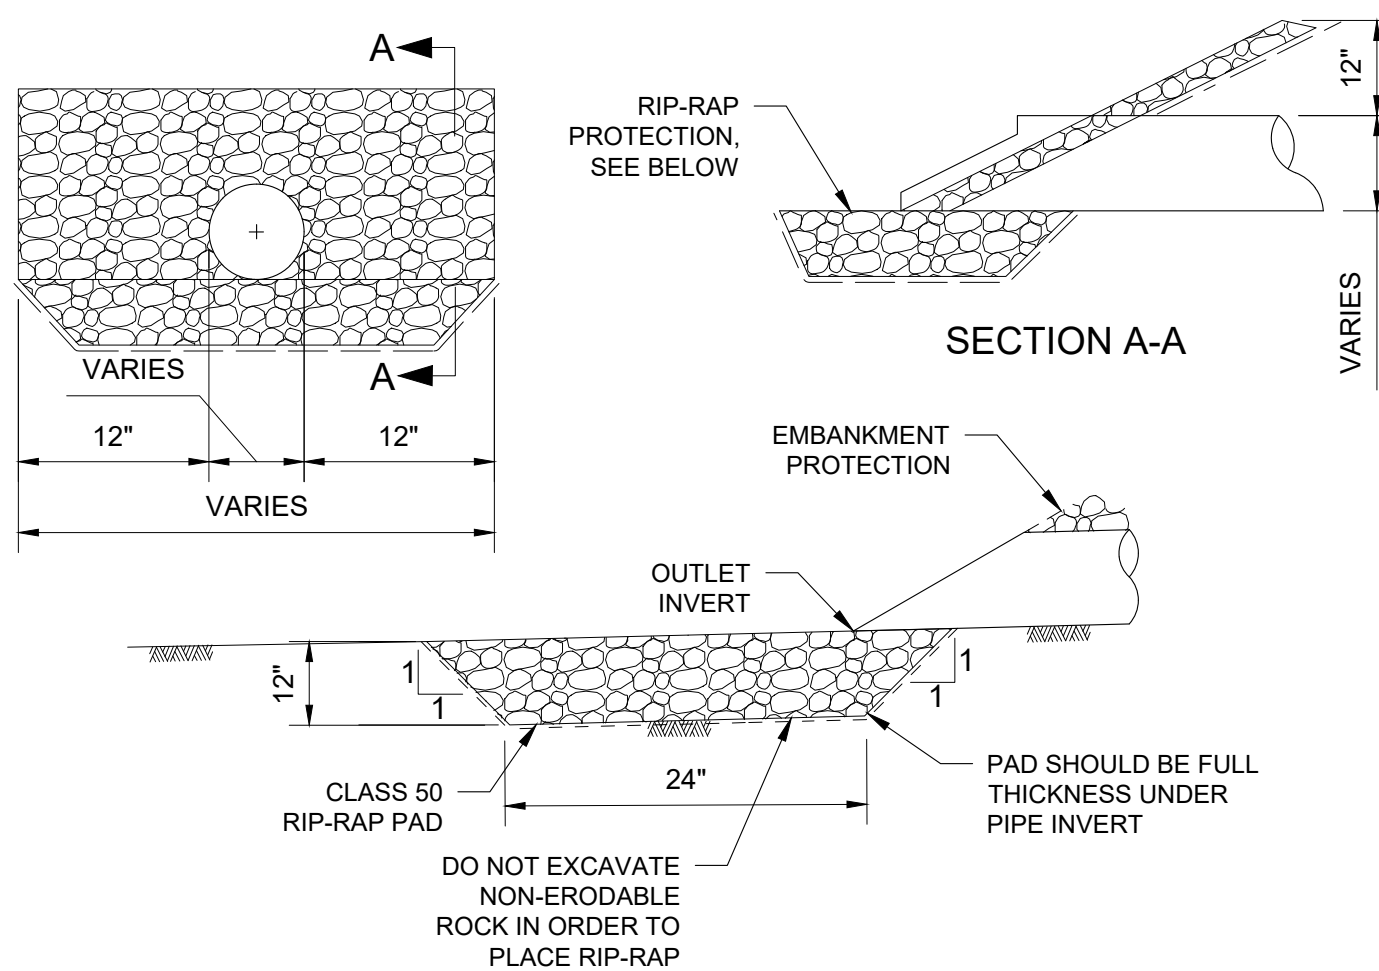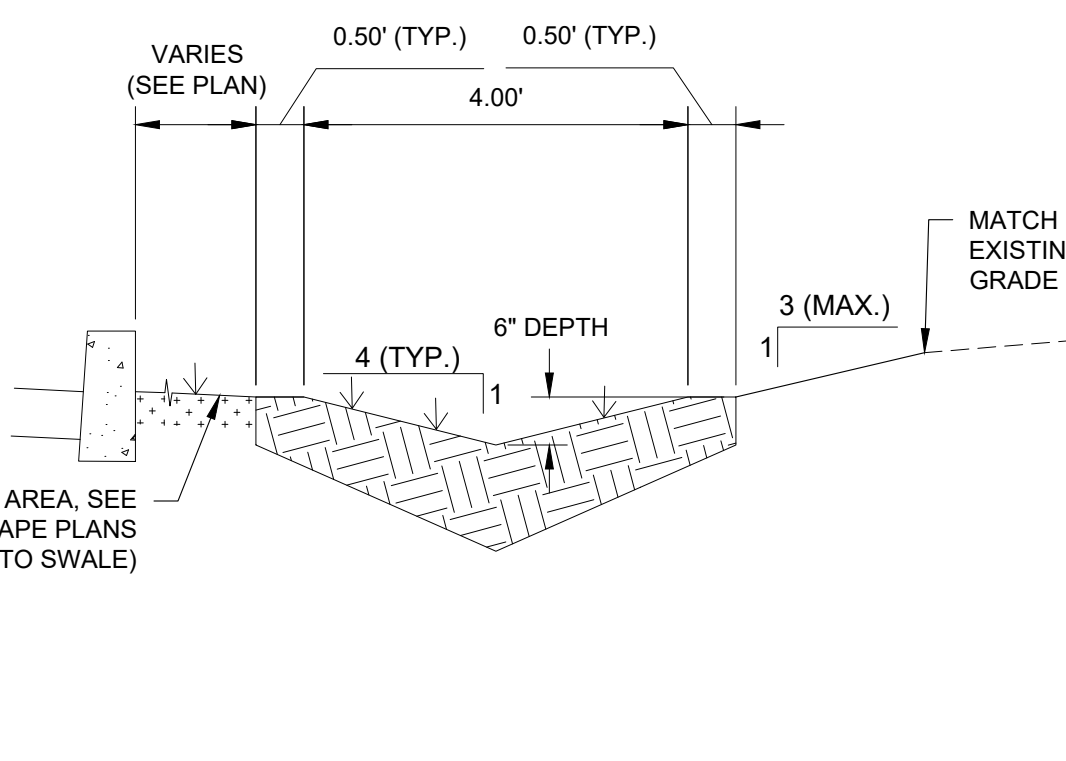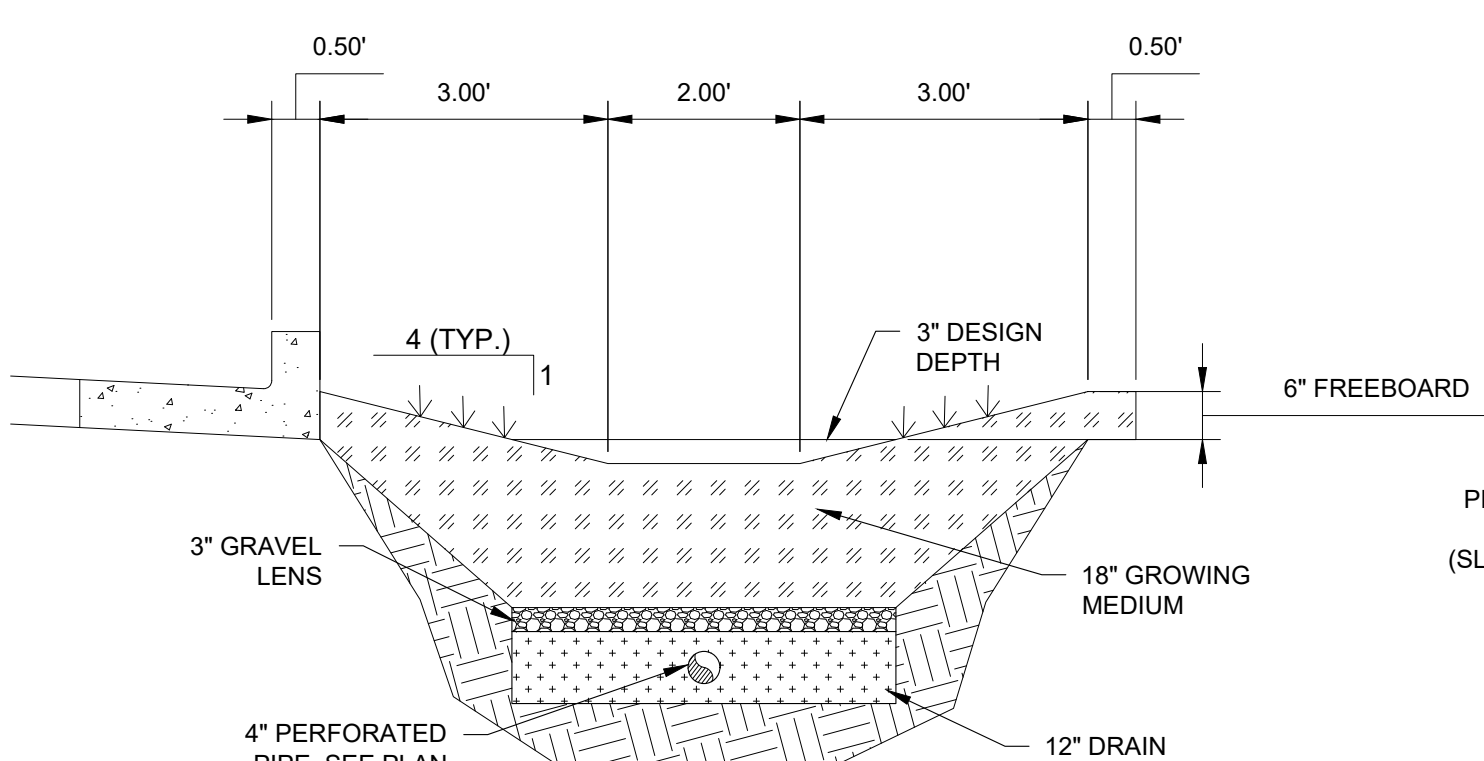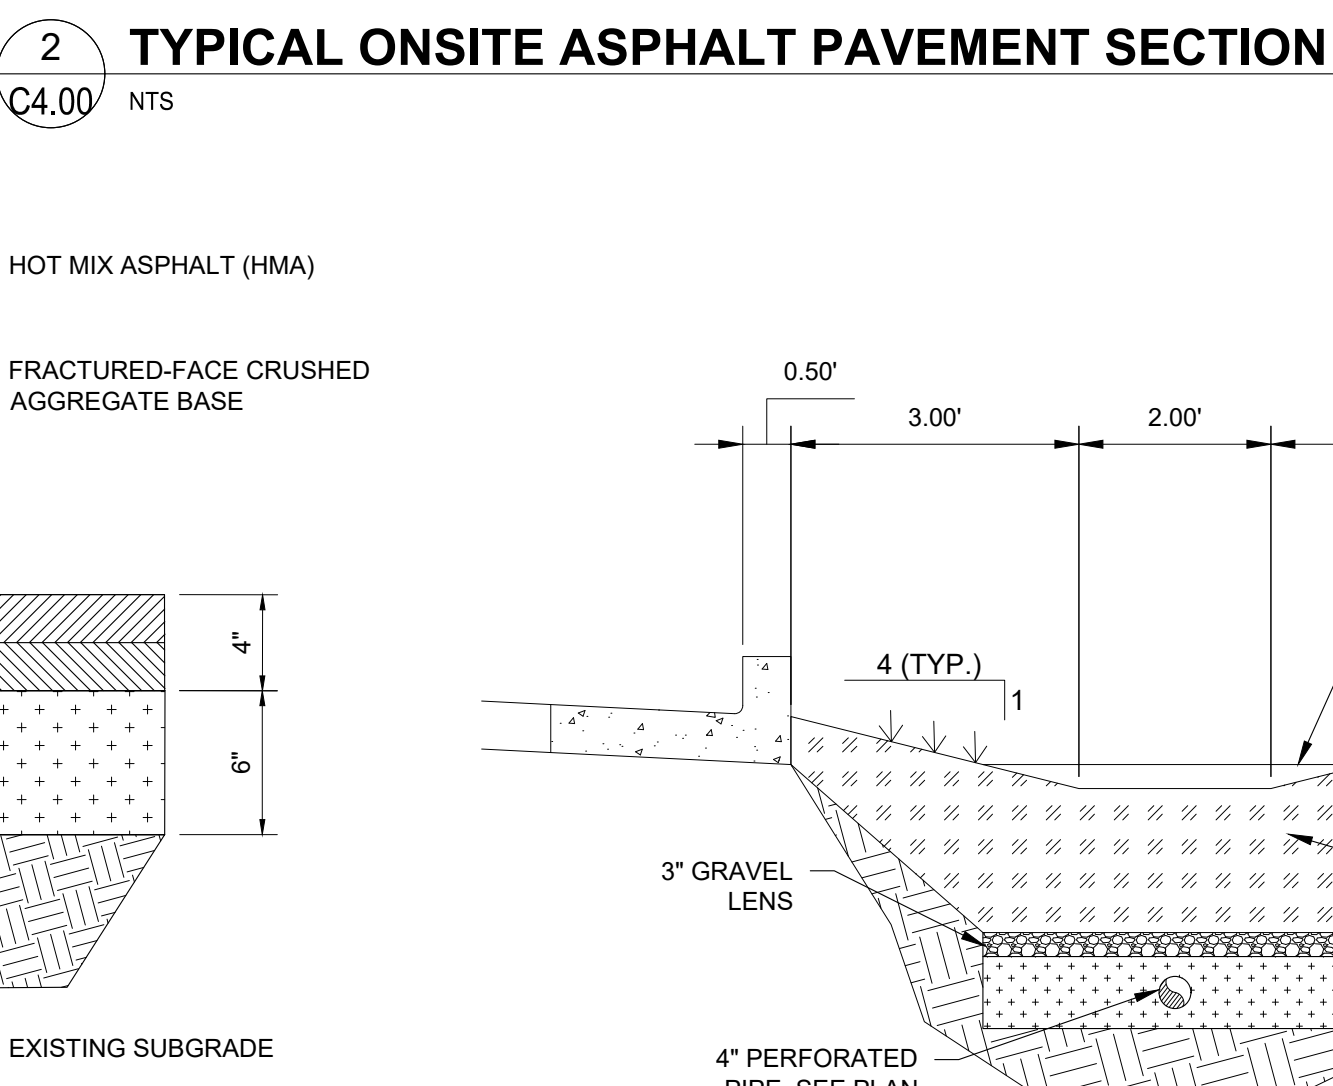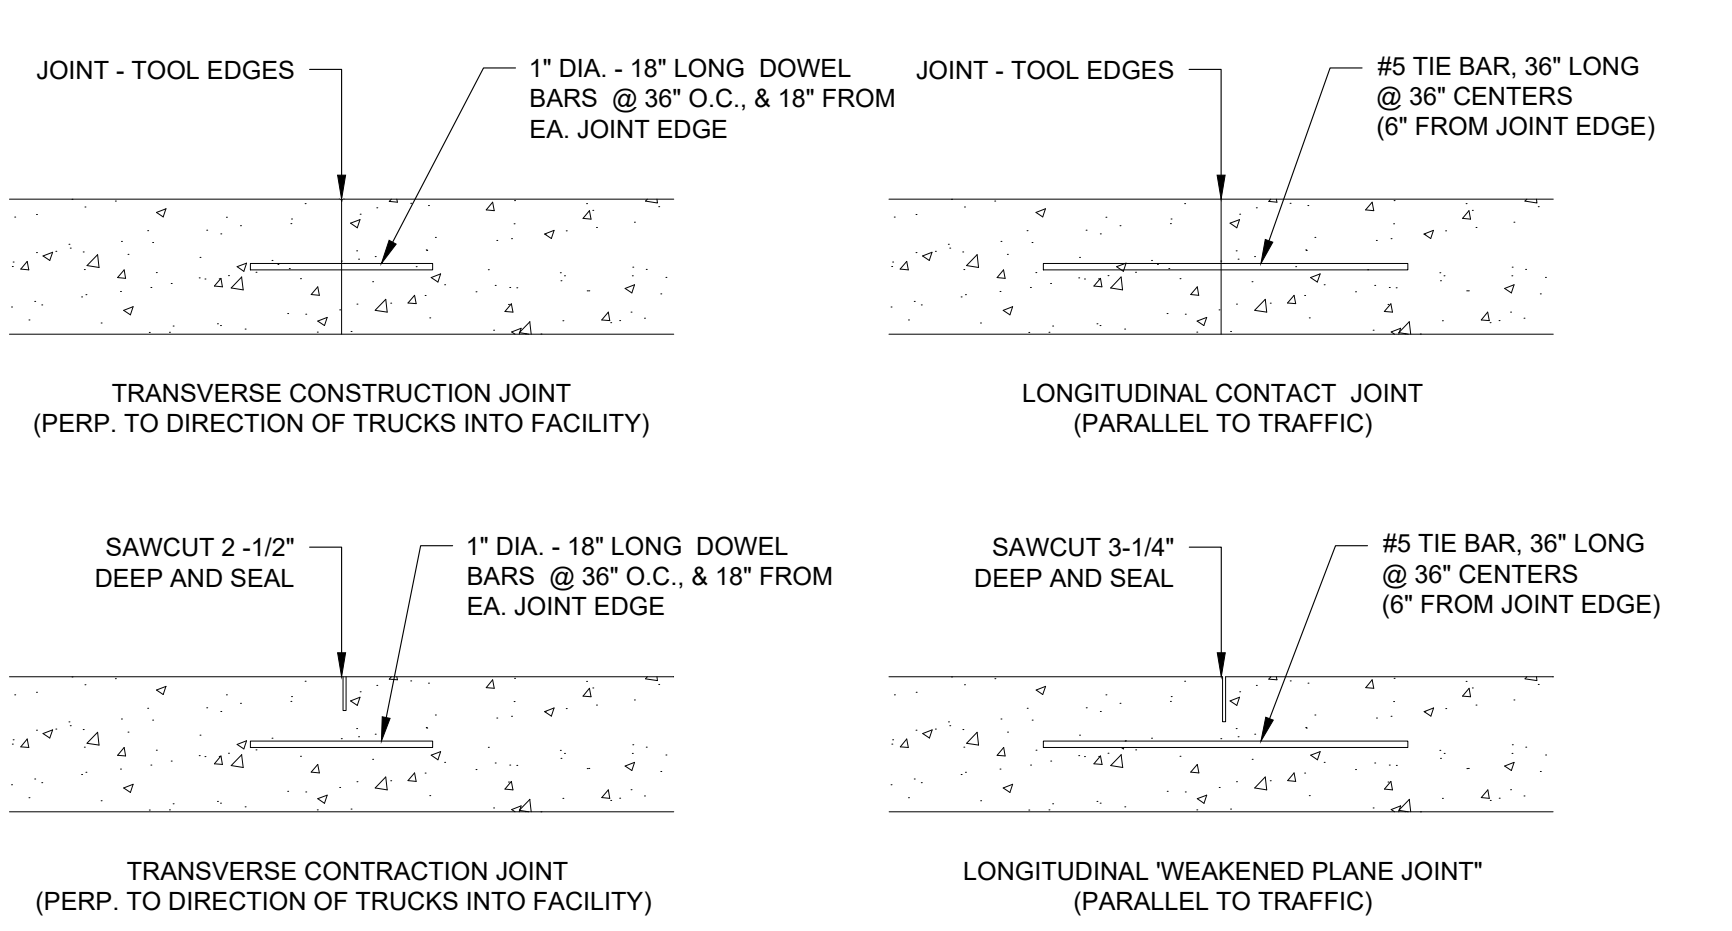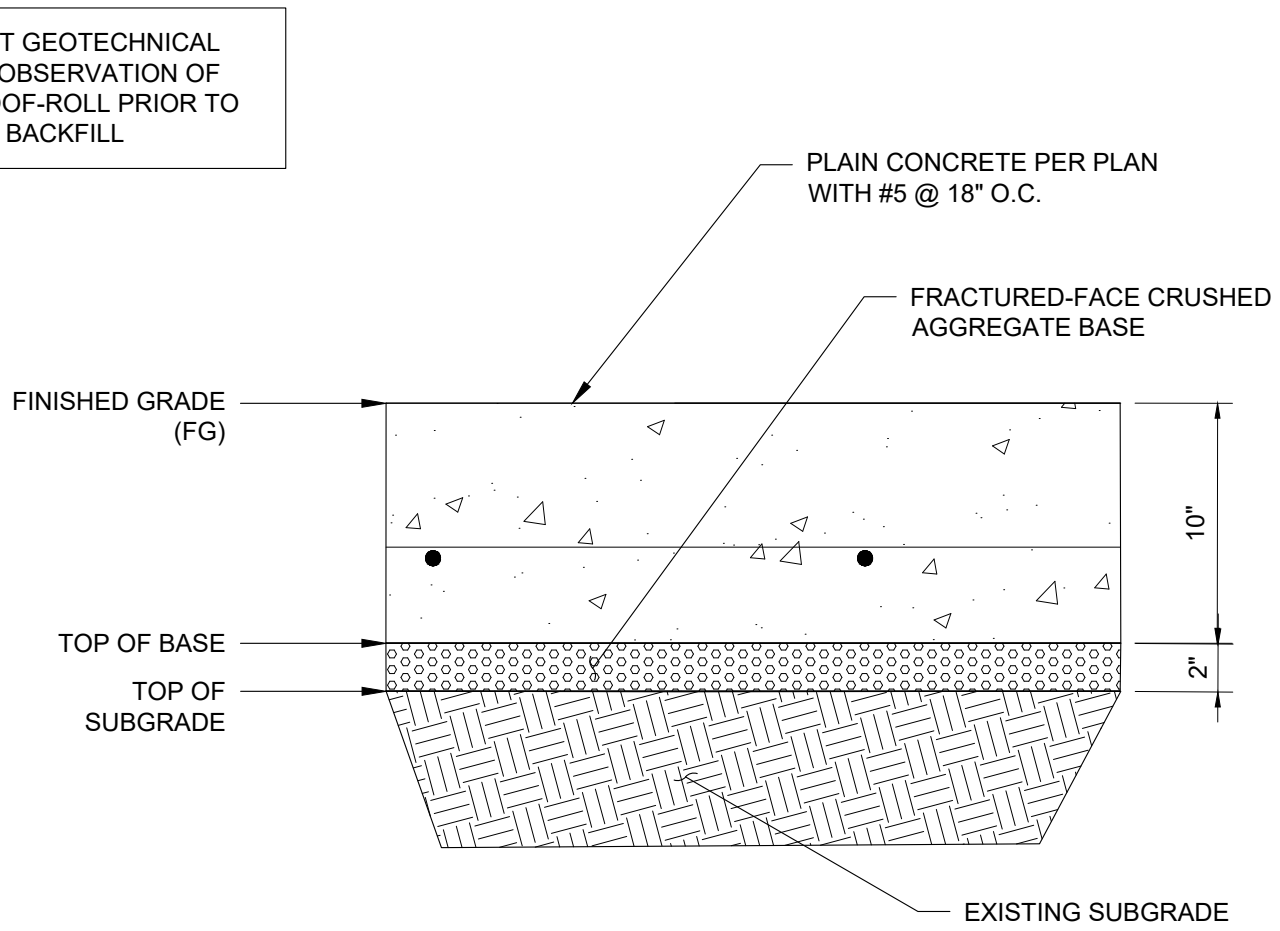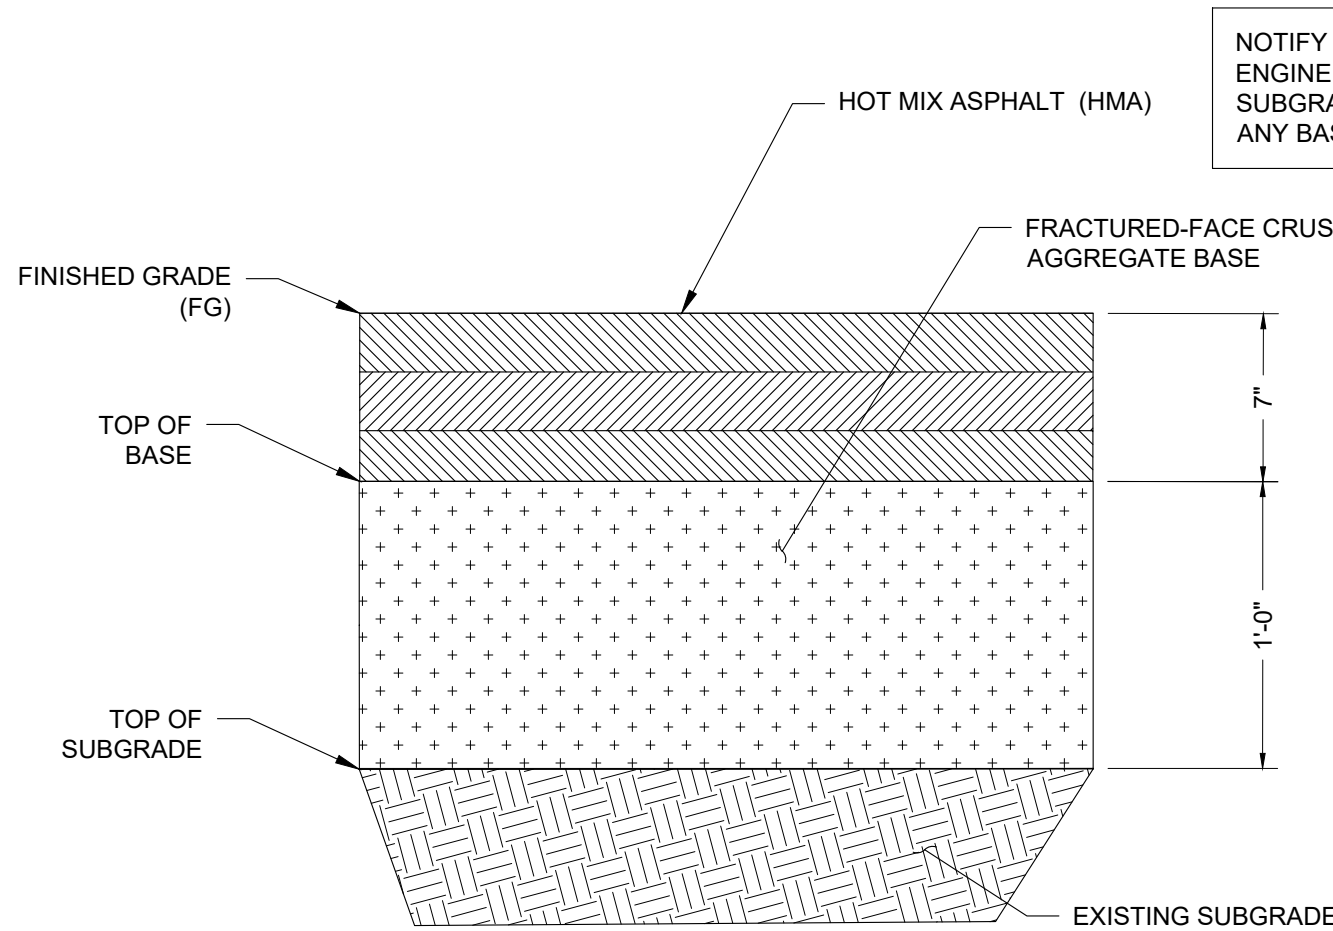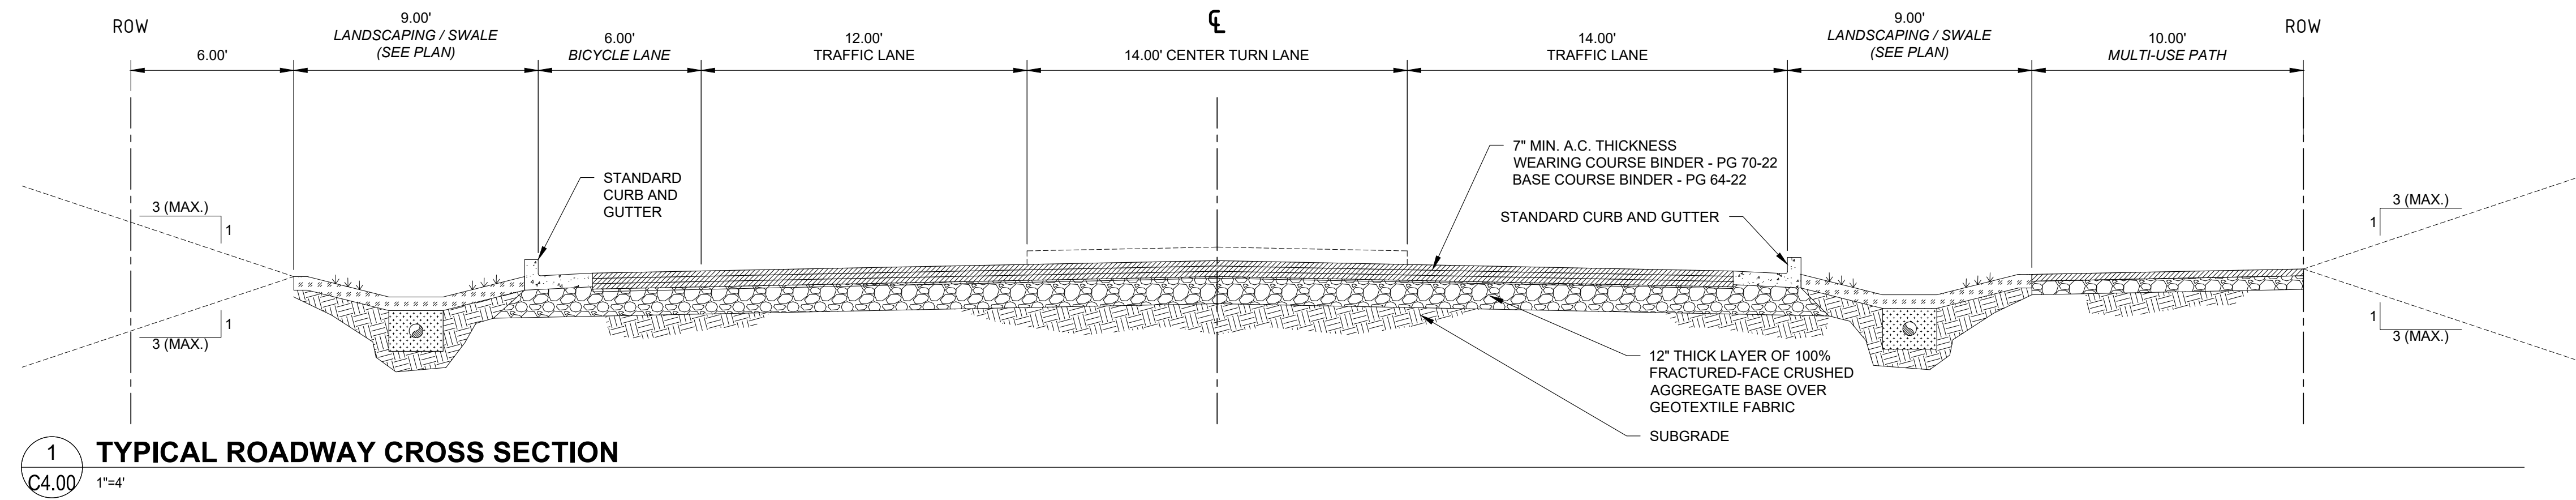


DATE: FILE PATH: \\ACTIVE PROJECTS\20335_SODERSTROMARCHITECTS_MILLERSBURG_ARCHITECTS_MILLERSBURG_FIRE_STATION\CIVIL\3D\PRODUCTION DRAWINGS\C4.00 DETAILS © 2019 CROW ENGINEERING, INC.



Revisions

No.	Description	Date
1	Pre-Bid Revisions	2/3/21

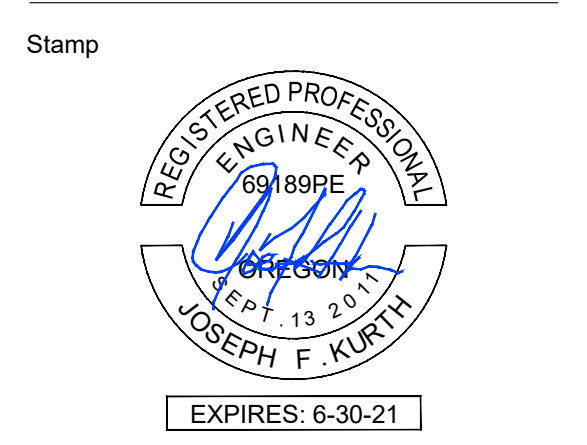


Issuance
CONFORM SET


Date
4/2/21
Project Number
20335
Drawing Title

DETAILS


Sheet No
C4.10

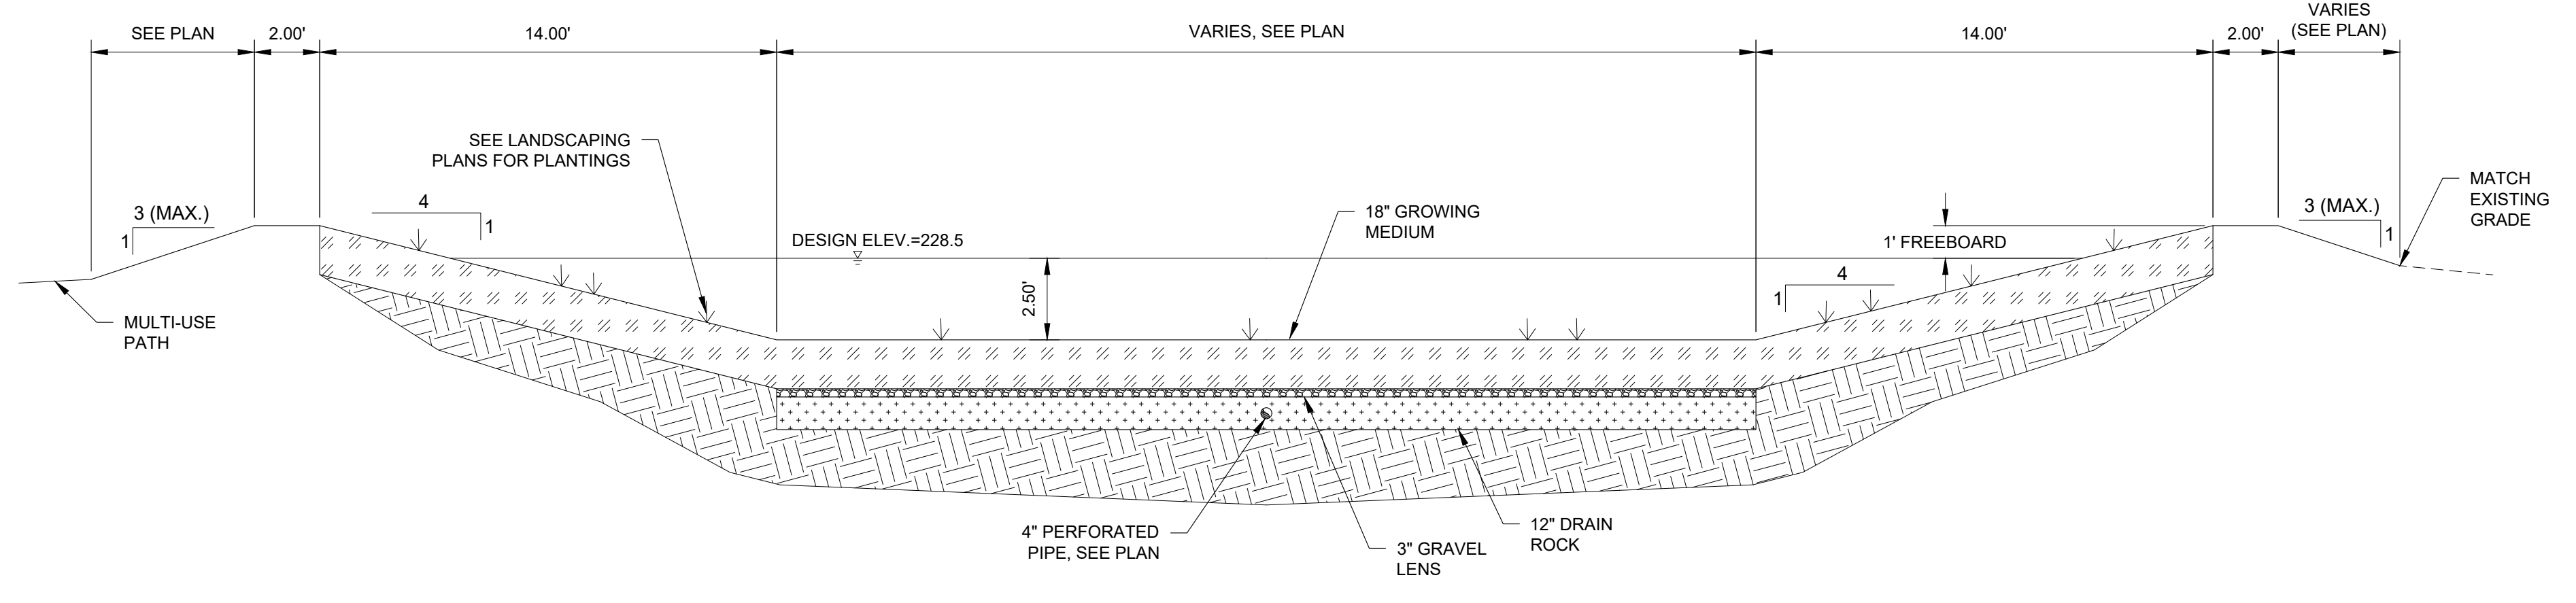


1 NORTH POND SECTION
C4.10 NTS

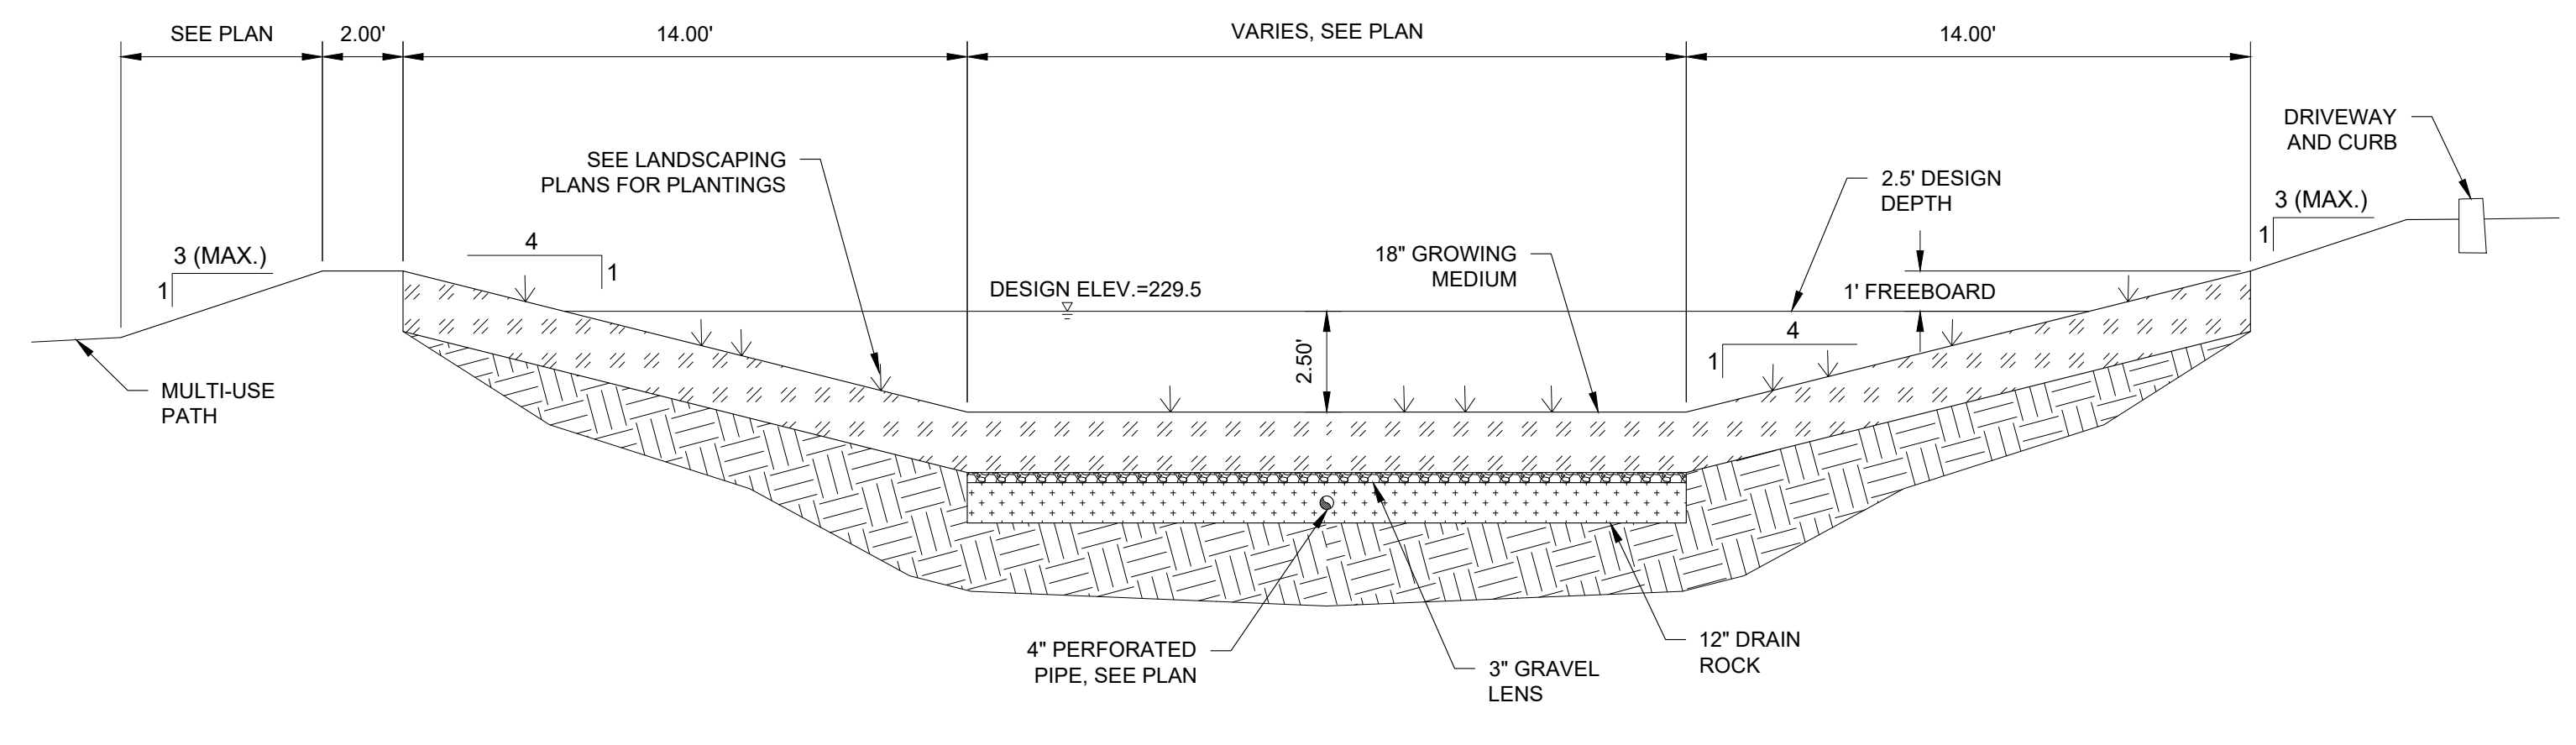


3 SOUTH POND SECTION 2
C4.10 NTS

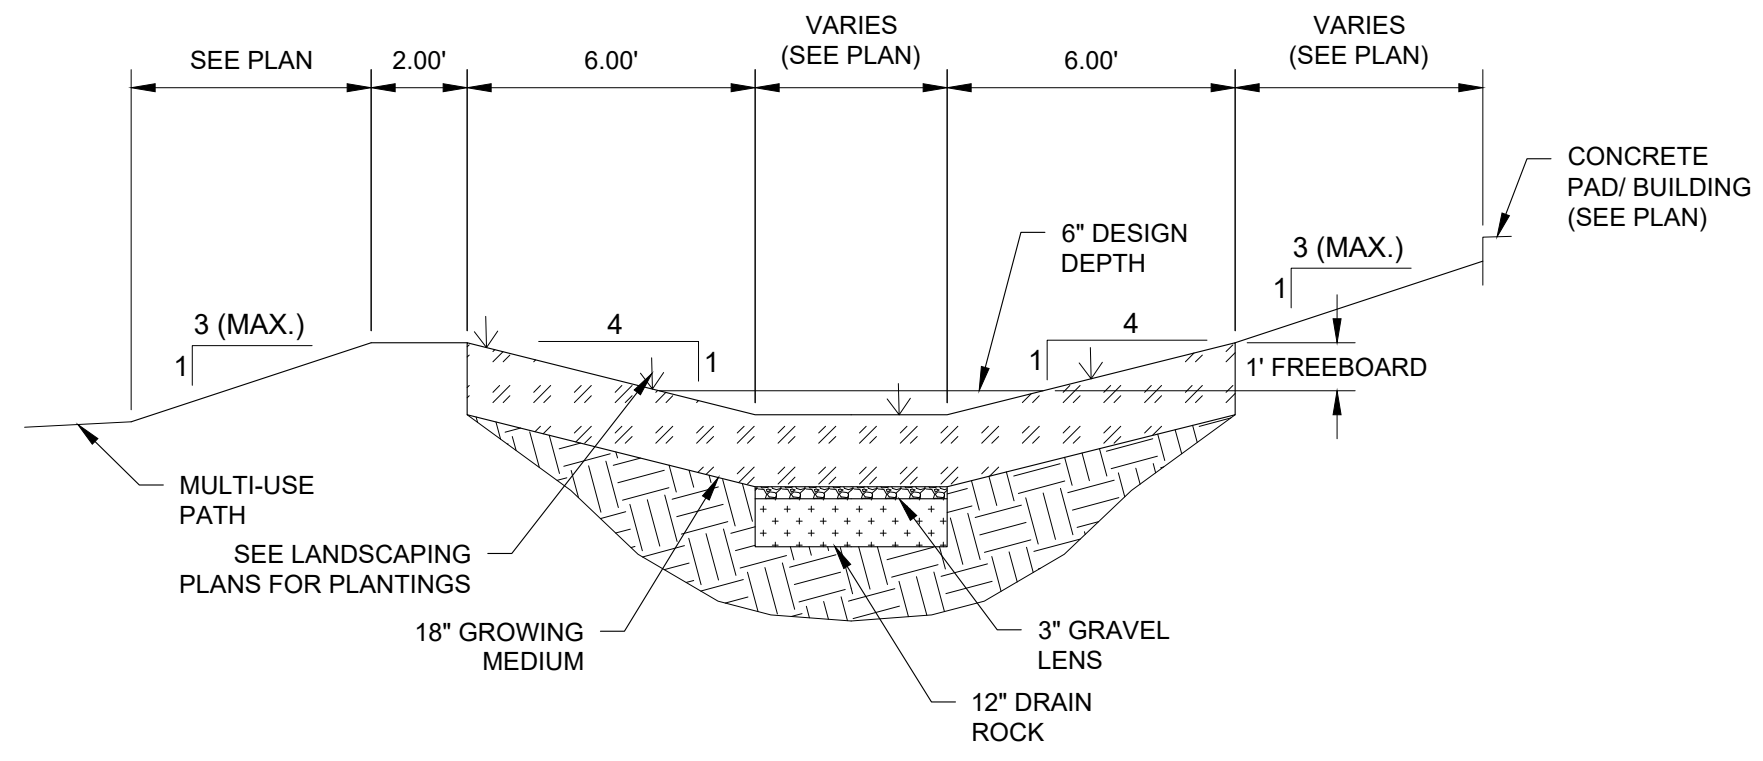


2 SOUTH POND SECTION 1
C4.10 NTS

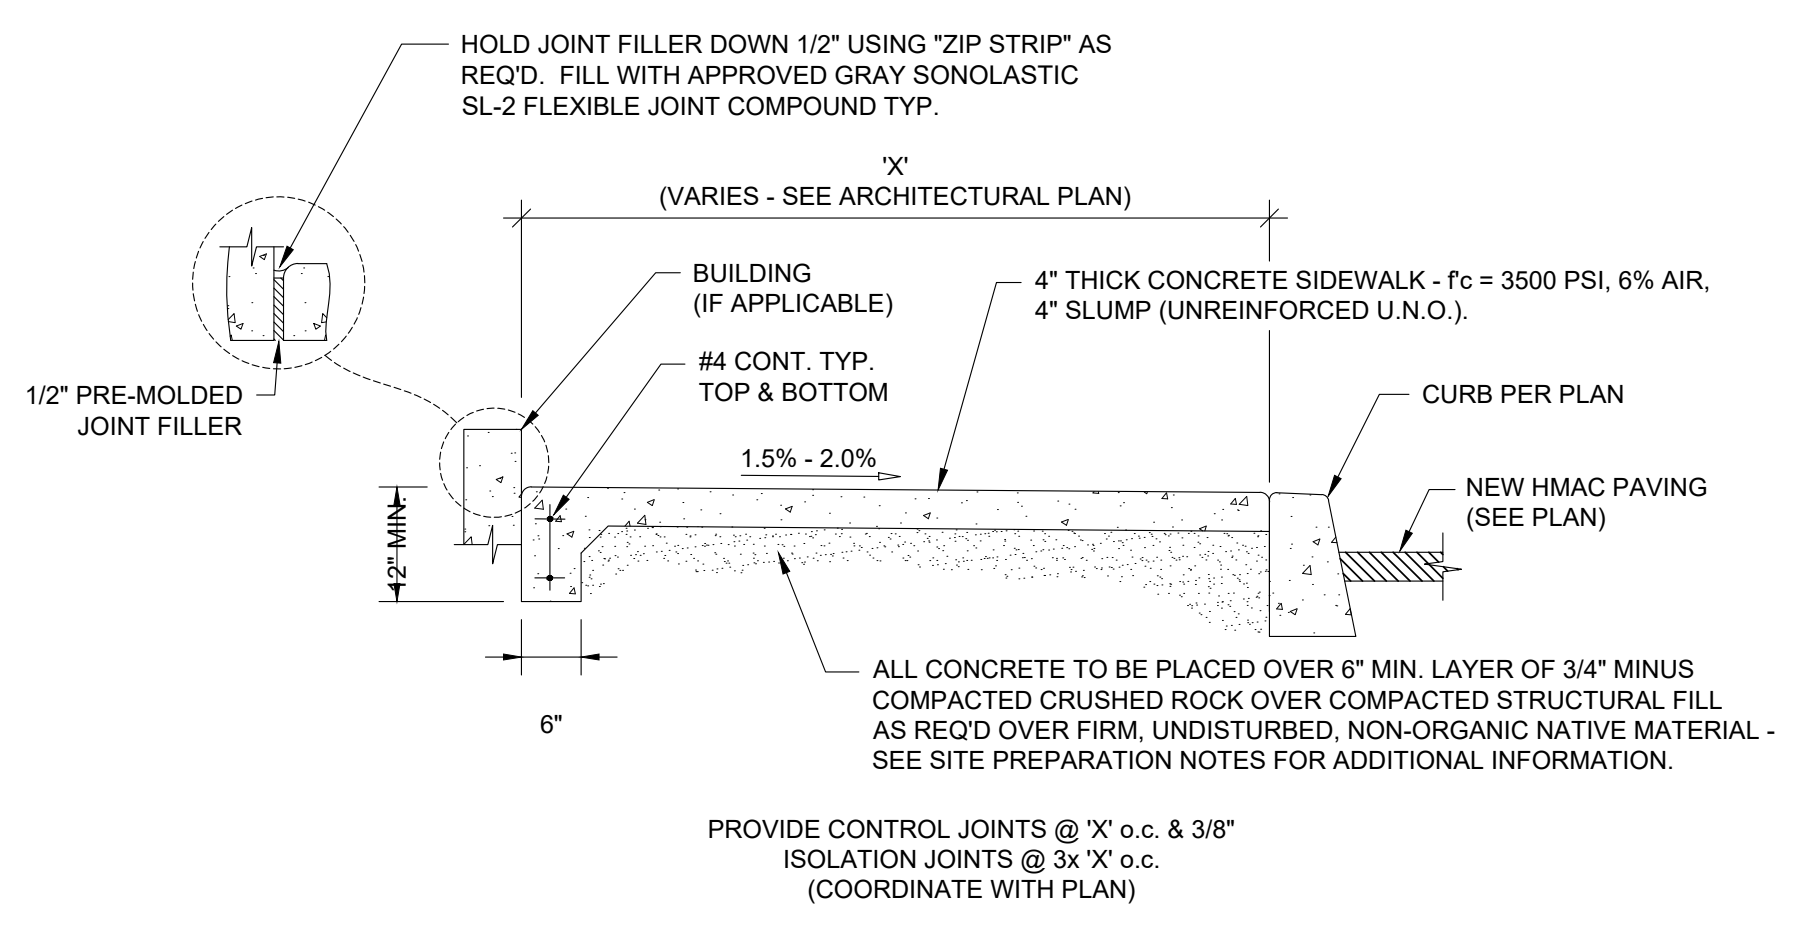


4 PRIVATE SIDEWALK SECTION WITH CURB
C4.10 NTS

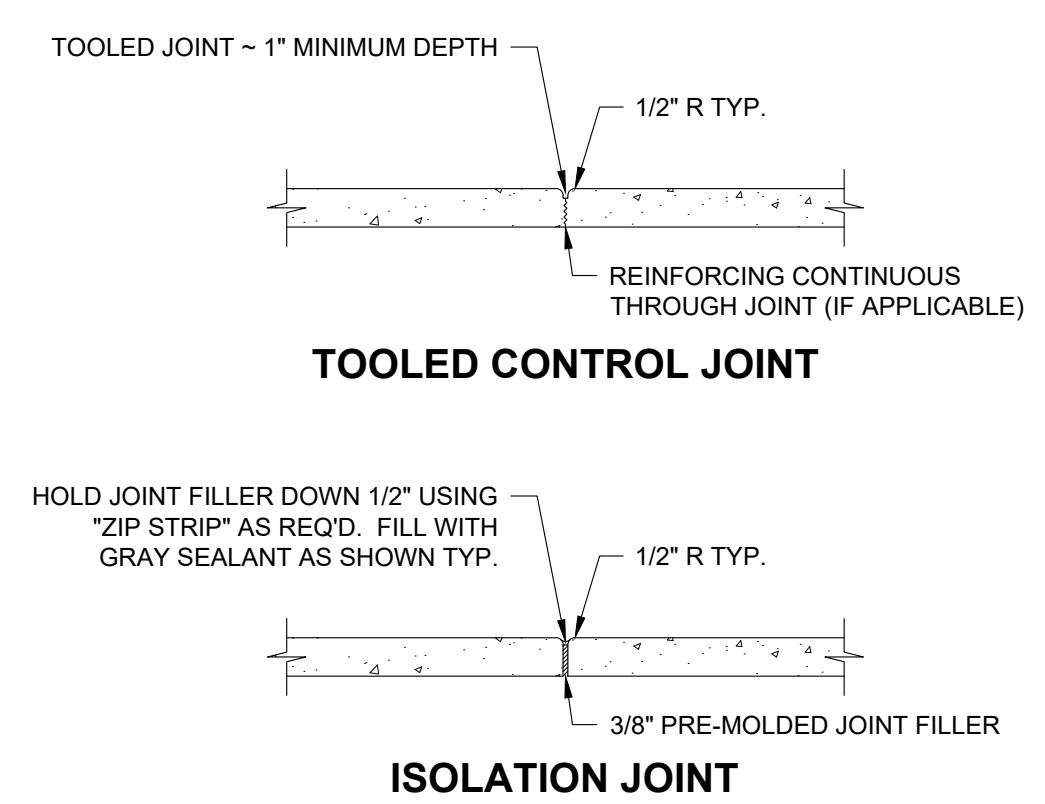

5 SIDEWALK JOINTING DETAILS
C4.10 NTS

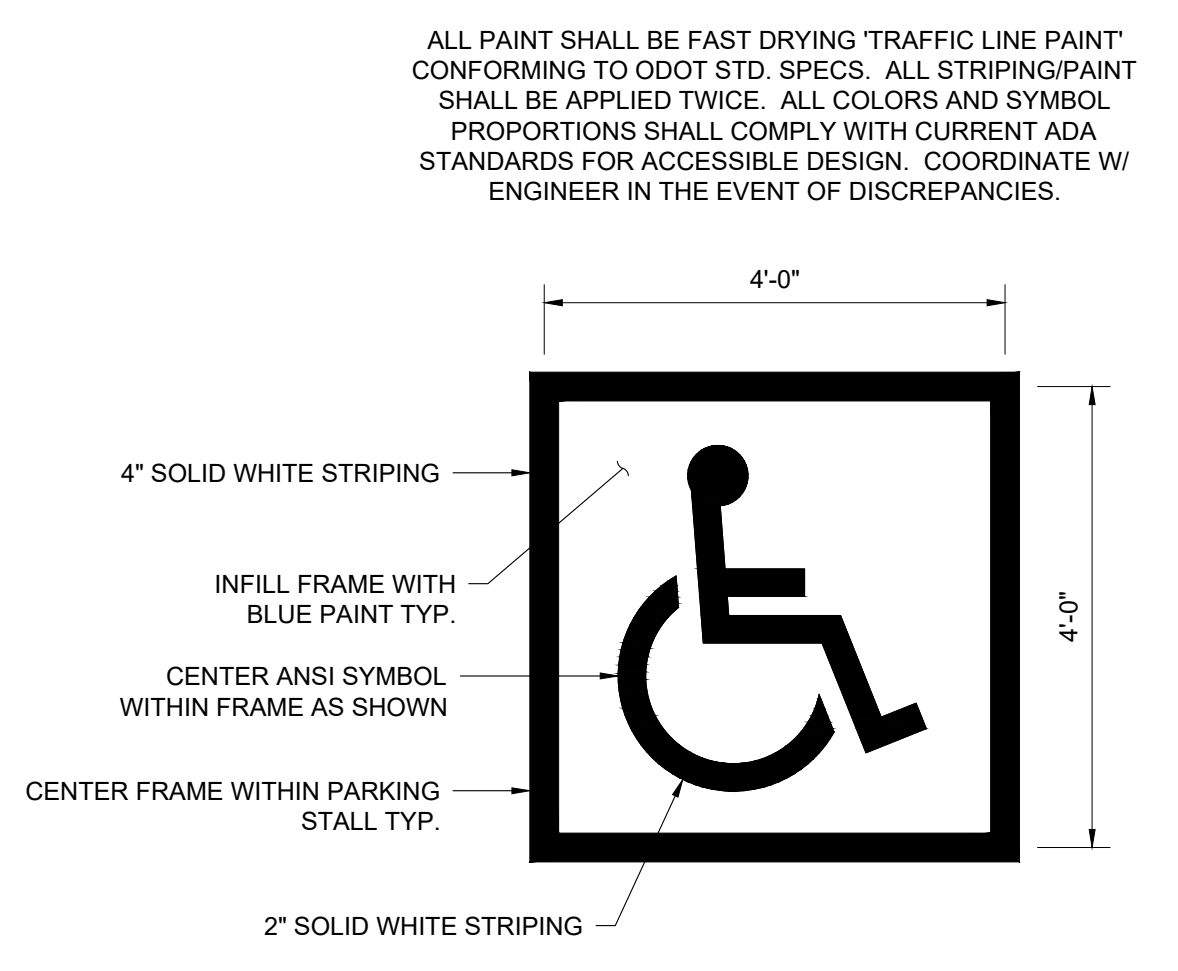


6 ACCESSIBILITY SYMBOL AND SIGNAGE
C4.10 NTS

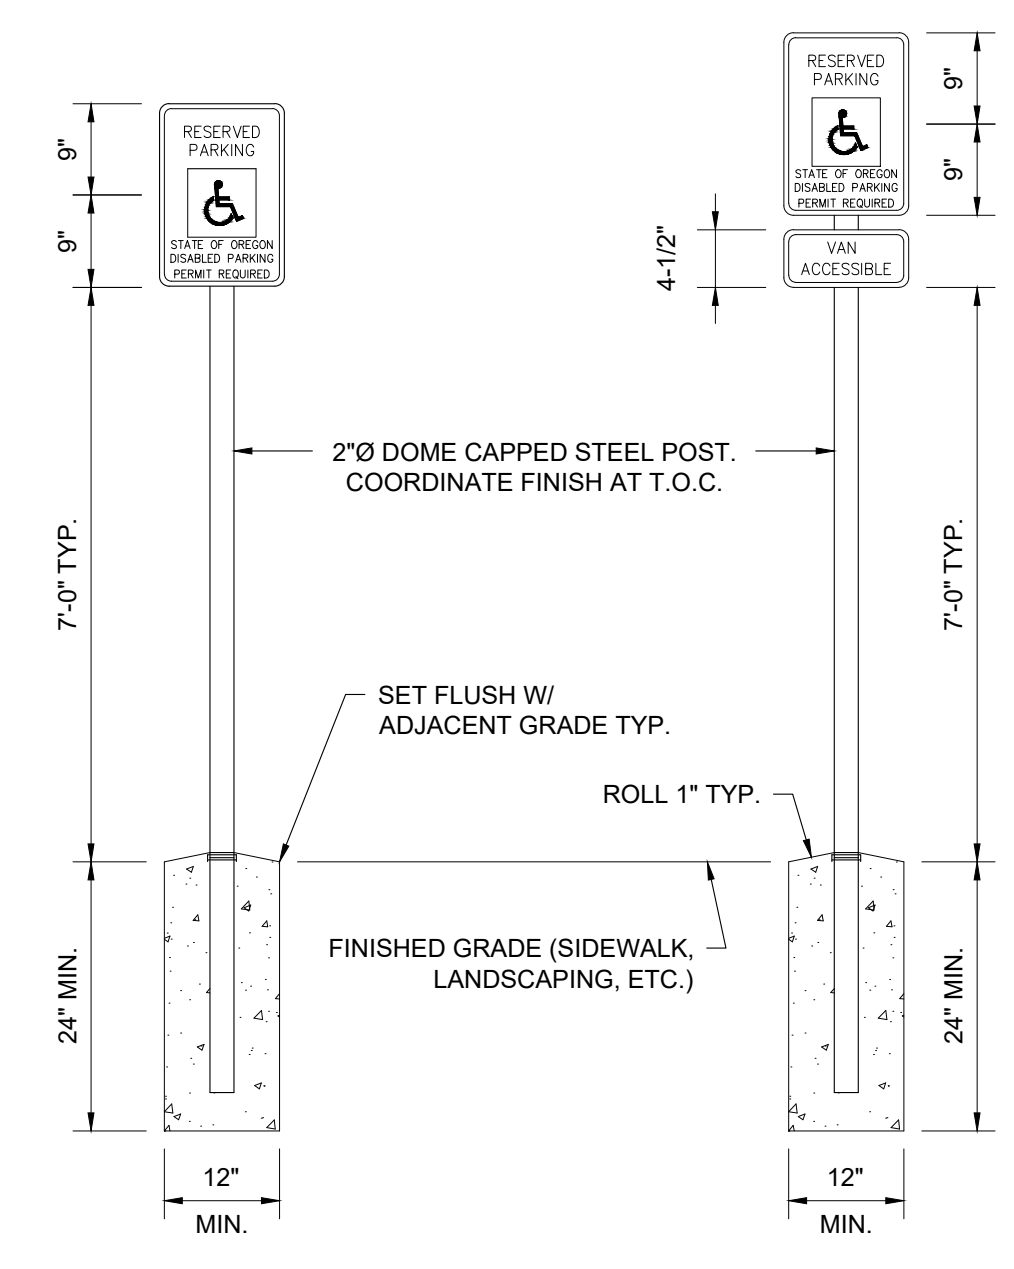

DATE FILE PATH: T:\ACTIVE PROJECTS\20335_SODERSTROMARCHITECTS_MILLERSBURG_MILLERSBURGFIRESTATION\CIVIL\3D\PRODUCTION DRAWINGS\C4.0 DETAILS © 2019 CROW ENGINEERING, INC.


8. Level 3 Communications Fiber-Optic Cable Route

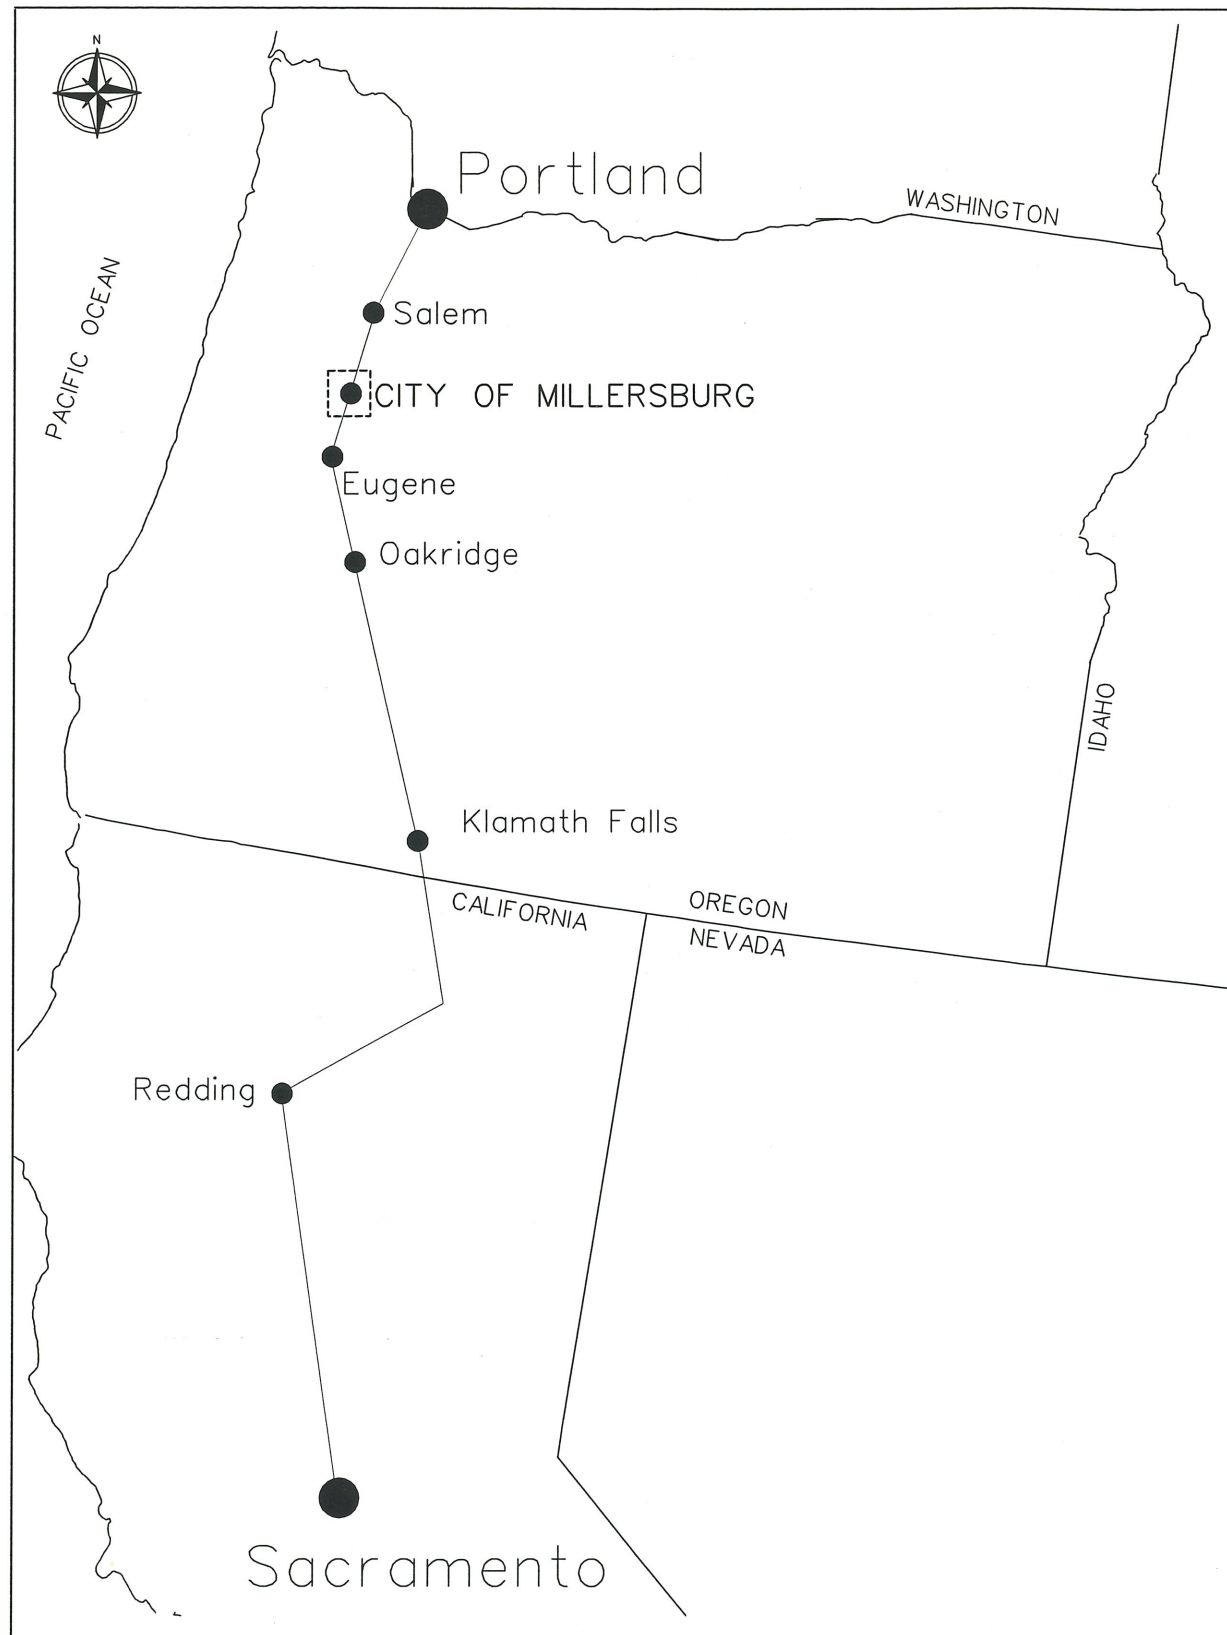

Level(3)
COMMUNICATIONS

FIBER-OPTIC CABLE ROUTE
CONSTRUCTION DRAWINGS
FOR LEVEL 3 COMMUNICATIONS

PROJECT SPAN
CITY OF MILLERSBURG

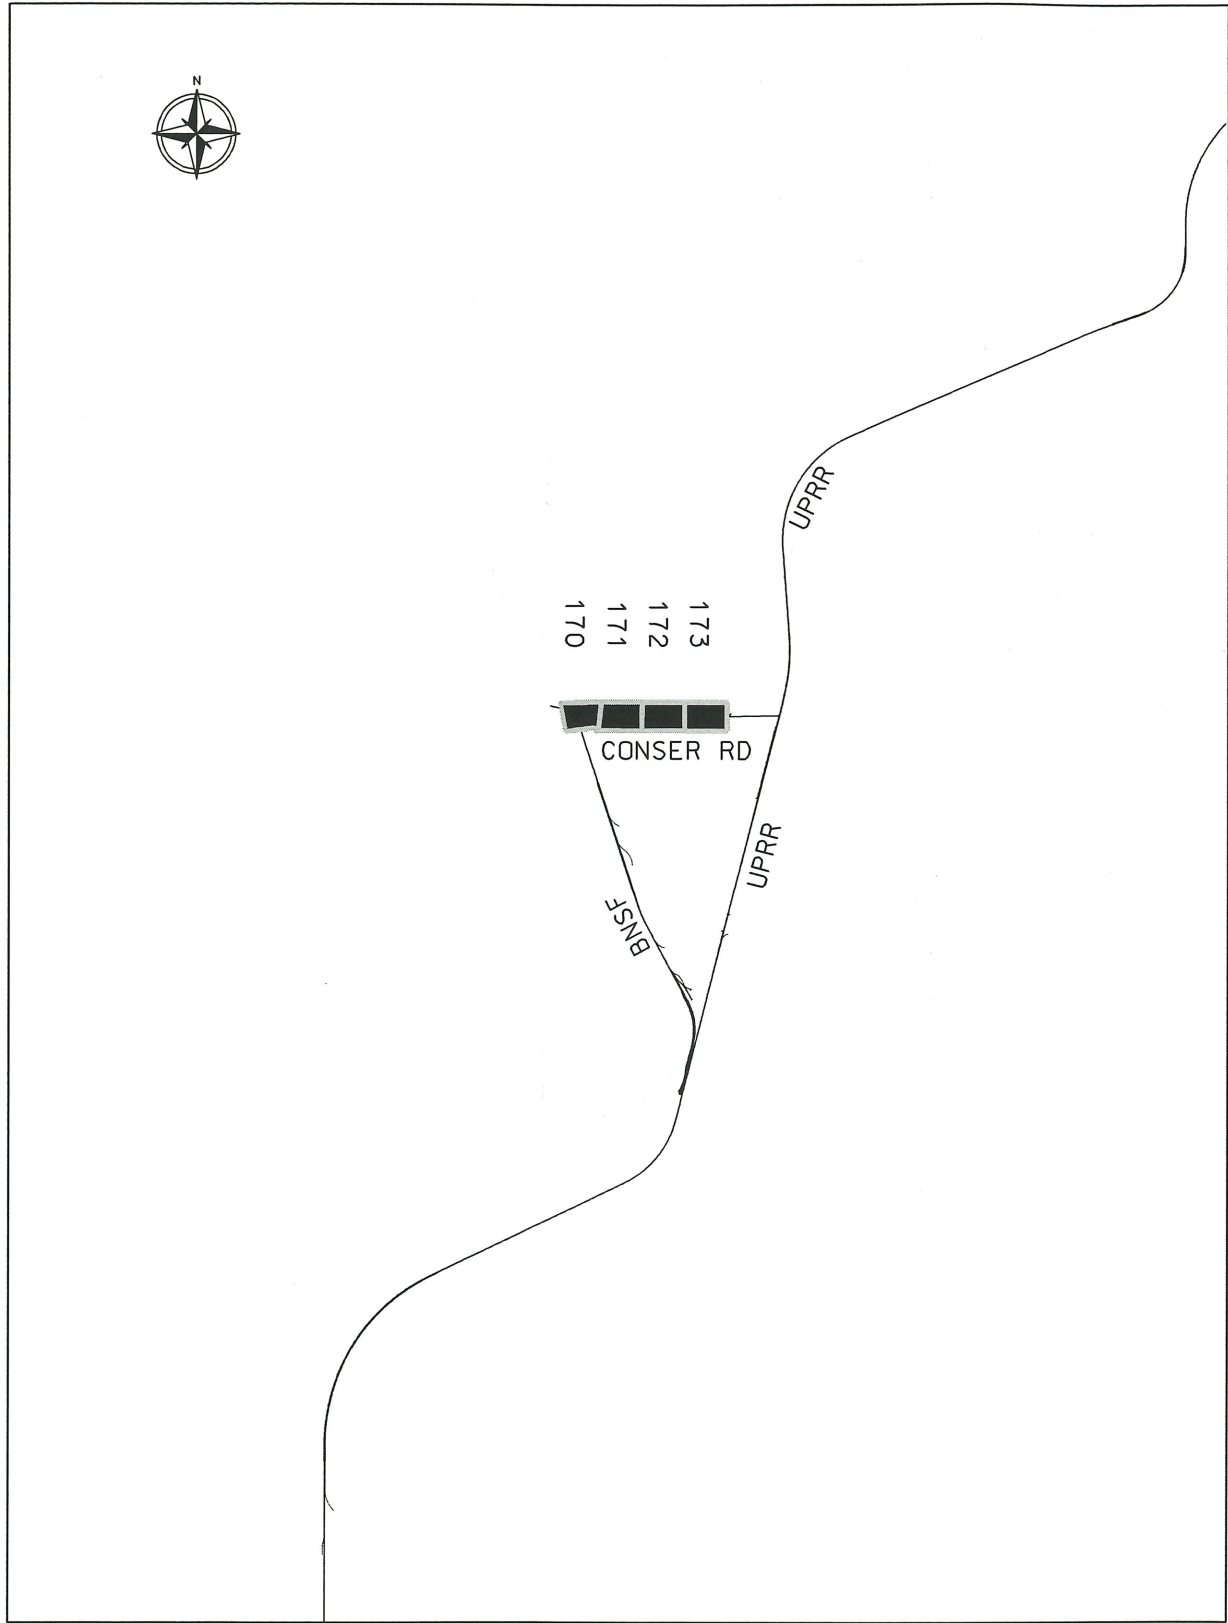

Level(3)

COMMUNICATIONS

CITY OF MILLERSBURG INDEX

DRAWING NO.	STREET NAME
170	Woods Roads
171	Waverly Drive Amenda Lane
172	Bain Street
173	Approach Road

As-Built Annotation

Description	Options
Duct Type	H = HDPE P = PVC Z = Other
Duct Bank Count	2, 3, 4, 6, 8, 10, 12, 14, 16, 18, 20, 22, 24, 26, 28, 30 Z = Other
Installation Method (other than plow or trench)	A = Attachment (i.e. bridges) B = Bore Z = Other No annotation if duct is plowed/trenched
Duct Bank Casing Type	F = FRE casing H = HDPE casing P = PVC casing S = Steel casing Z = Other
Duct Bank Casing Size	8 = 8 inch casing 9 = 9 inch casing 10 = 10 inch casing 12 = 12 inch casing 2*5 = 2-5 inch casing 2*6 = 2-6 inch casing Z = Other
Duct Bank Encasement	C = Concrete Q = Flowable fill M = Multicell (integrated duct and casing system) T = Steel plate on top of duct bank Z = Other
Duct Bank Cover Depth	Inches 20 (20" or less) 20/40 40/60 60/100 100 (100" or more)
Surface Restoration	PR = Pavement Restoration Roadway PW = Pavement Restoration Walkway
Handhole	HHA = FRP: API Model: 13-4800-42, concrete cover HHB = FRP: API Model: 13-4800-42, cast iron cover HHZ = Other
Manhole	MHA = FRP: API Model 13-4882-20, hatch doors MHB = FRP: API Model 13-4882-45, cast iron cover MHC = Manhole, 4.0' x 4.0' x 4.0' MHZ = Manhole (other)

User: \$(User)
Time: 10:26:29
Date: 30 MAY 2011
Filename: I:\paper_deliverable\sacpor\millersburg\codelegend.dgn

The locations of utilities shown on this drawing are only approximate. Level 3 Communications, LLC hereby disclaims any responsibility to third parties for the accuracy of this information. Persons working in the area covered by this drawing must contact the statewide Call-Before-You-Dig System to ascertain the location of underground utilities prior to performing any excavation.

Rev	Description	Design By	Quality Control		Approved	
			By	Date	By	Date
1	AS-BUILT DWGS			5/20/11		



CALL BEFORE YOU DIG
1-800-332-2344
48 HOURS NOTICE
REQUIRED



Owner: **Level (3) COMMUNICATIONS**

Contractor: **PKS Kiewit Network Services Co.**

Engineer: **PARSONS BRINCKERHOFF**

Program: Intercity Network		City Pair: Sacramento to Portland		Package Title: City of Millersburg		Drawing Title: As-Built Annotation Code Legend	
City Pair Code	Span No.	Package No.	Type	Drawing No.	Rev	Sheet No.	
SACPOR	10		P	L1	A	1	1

SEC 20, T10S, R3W, W.M.
CITY OF MILLERSBURG, OR

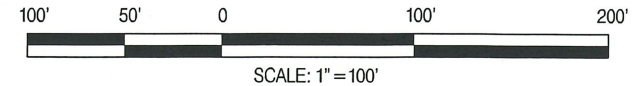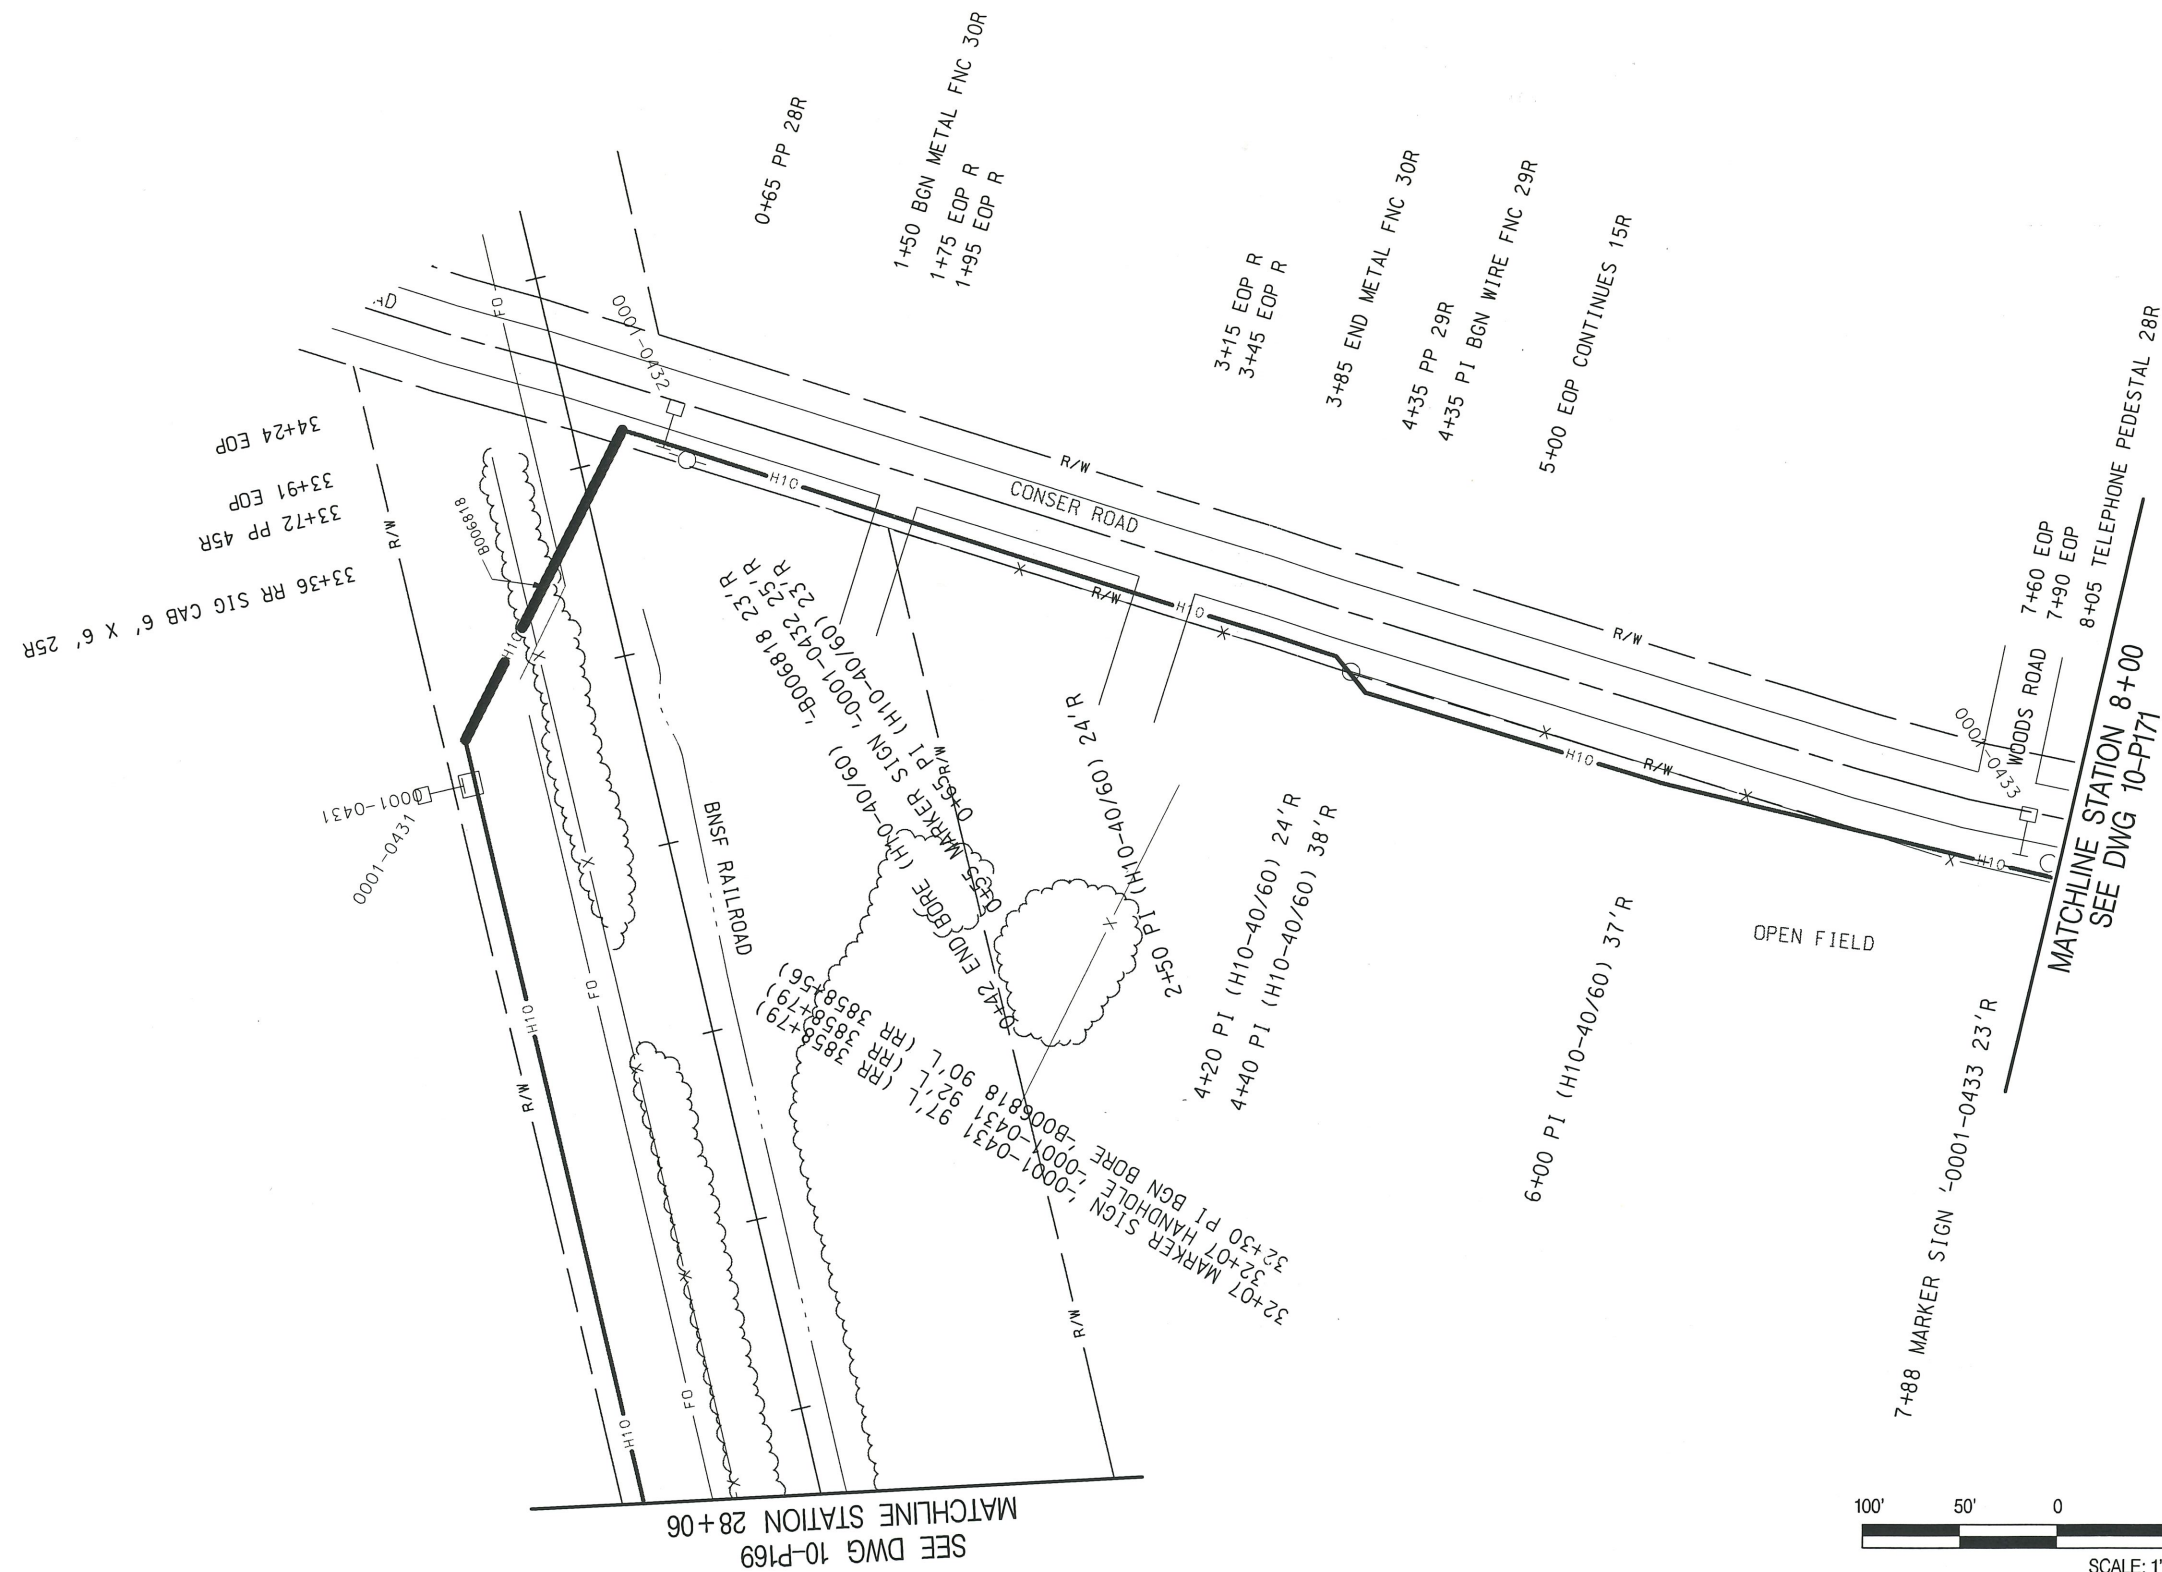

User: \$(User)
Time: 11:10:57
Date: 30 MAY 2011
Filename: I:\paper_deliverable\sacpor\millersburg\span10_170.dgn

The locations of utilities shown on this drawing are only approximate. Level 3 Communications, LLC hereby disclaims any responsibility to third parties for the accuracy of this information. Persons working in the area covered by this drawing must contact the statewide Call-Before-You-Dig System to ascertain the location of underground utilities prior to performing any excavation.

Rev	Description	Design By	Quality Control		Approved	
			By	Date	By	Date
1	AS-BUILT DWGS			5/20/01		

CALL BEFORE YOU DIG
1-800-332-2344
48 HOURS NOTICE
REQUIRED


Owner:
Level (3) COMMUNICATIONS

Contractor:
PKS Kiewit Network Services Co.

Engineer:
PARSONS BRINCKERHOFF

Program: Intercity Network		City Pair: Sacramento to Portland		Package Title: City of Millersburg		Drawing Title: 28+06 to 8+00	
City Pair Code	Span No.	Package No.	Type	Drawing No.	Rev	Sheet No.	
SACPOR	10		P	170	A		

SEC 20&21, T10S, R3W, W.M.
CITY OF MILLERSBURG, OR

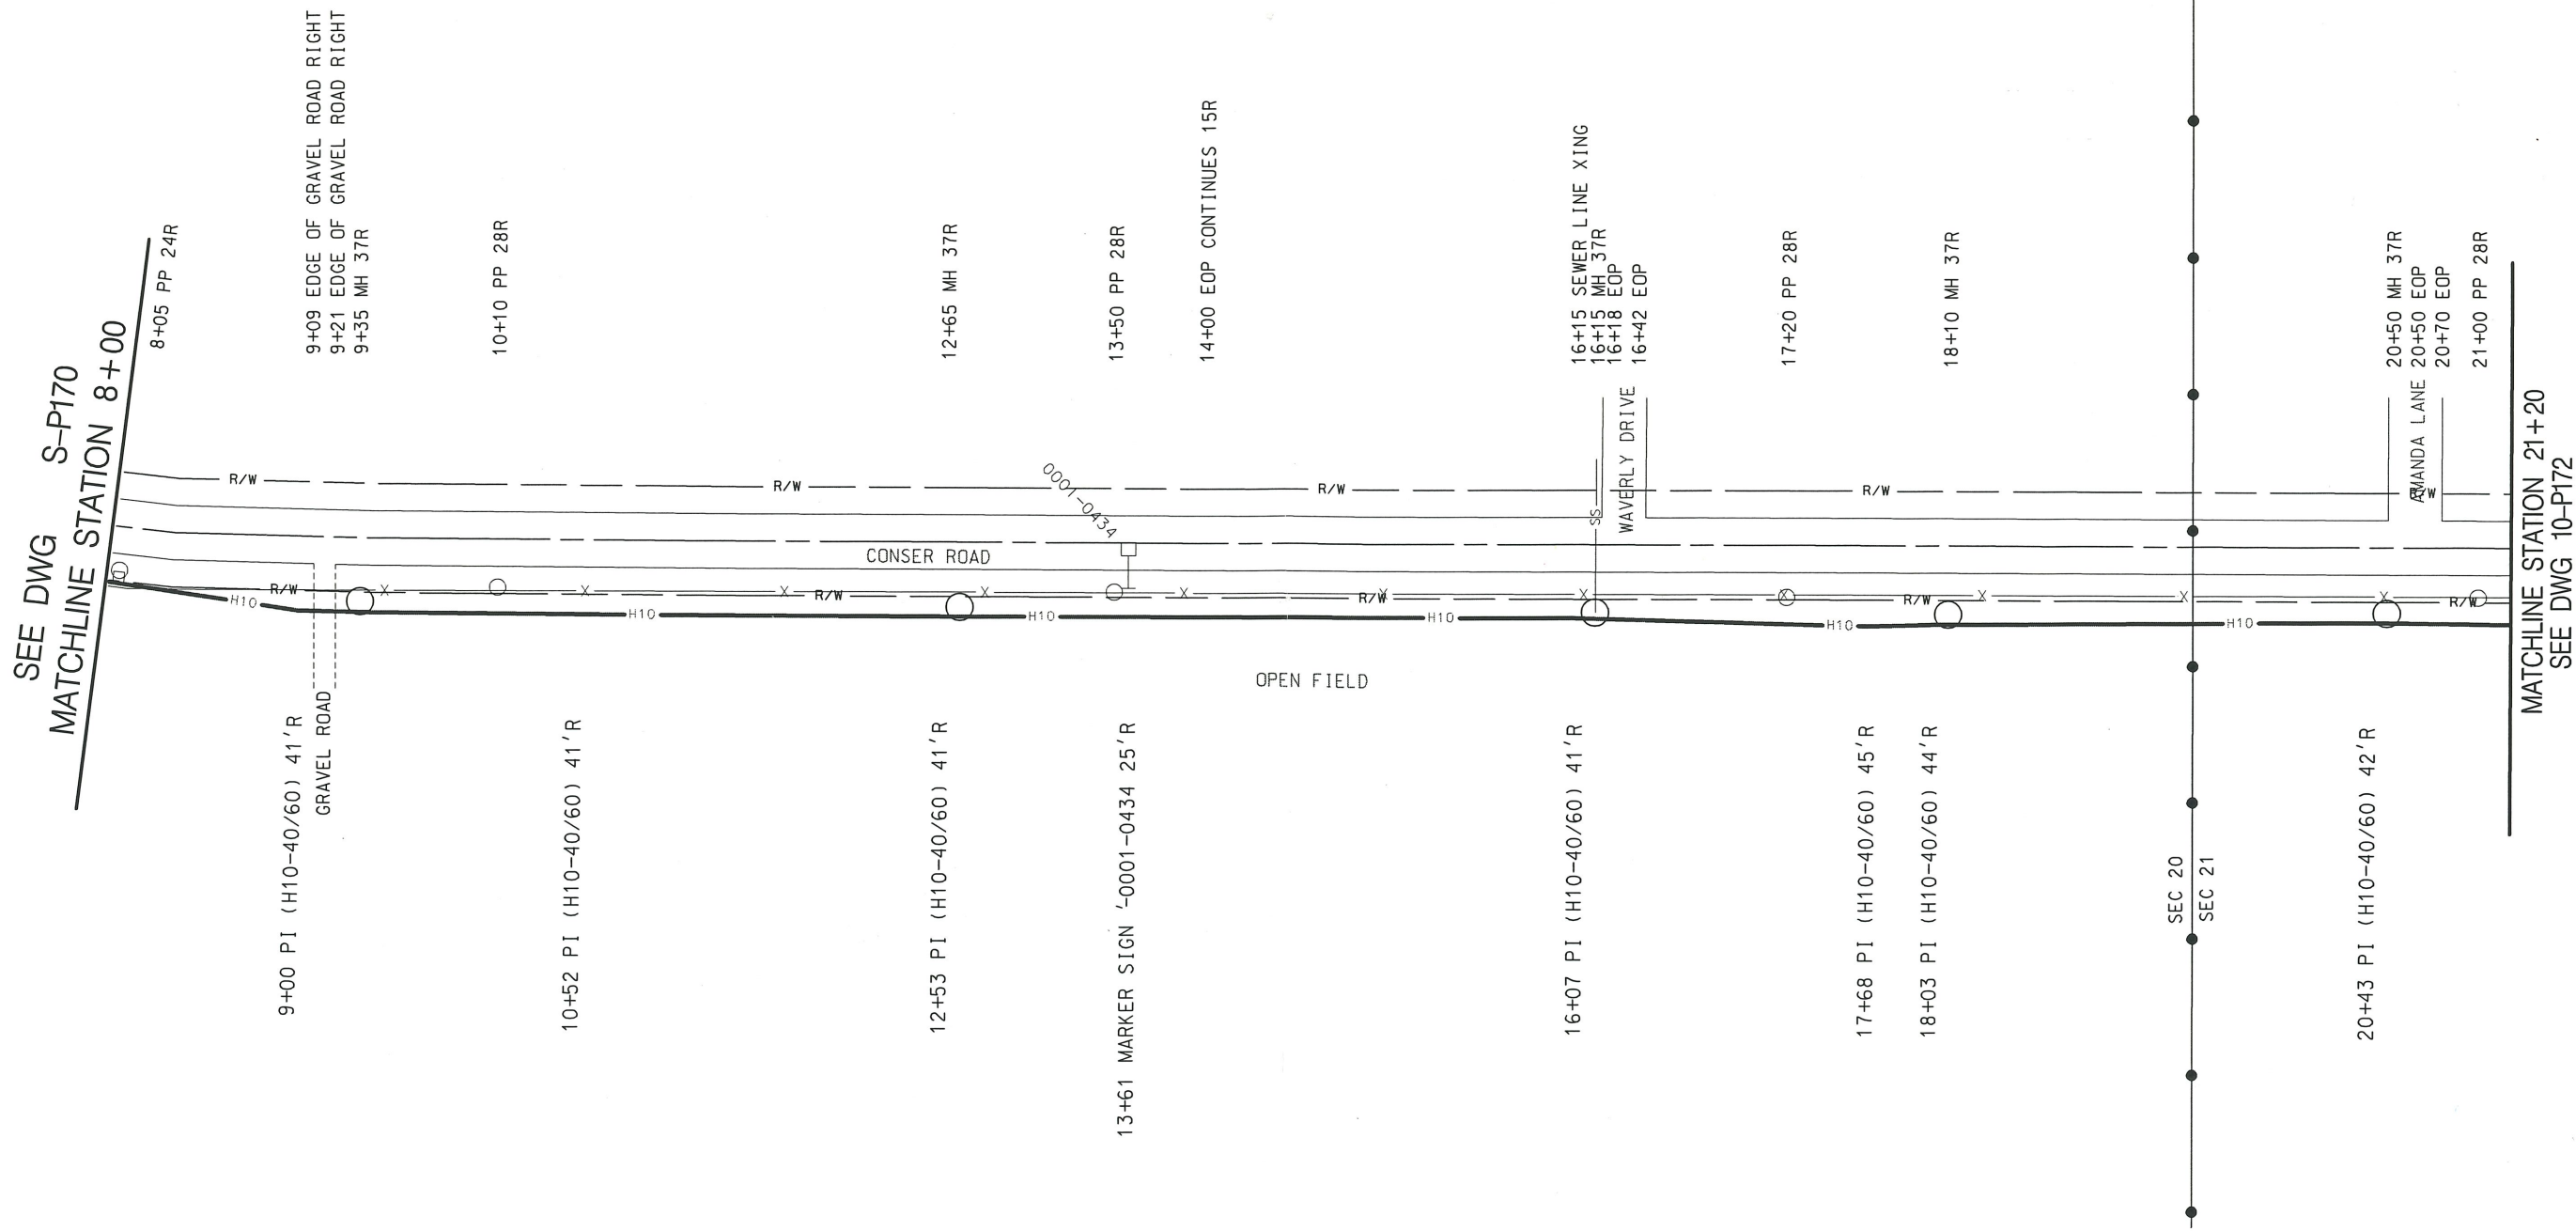

User: \$(User)
Time: 11:11:07
Date: 30 MAY 101
Filename: I:\paper_deliverable\sacpor\millersburg\span10_171.dgn

The locations of utilities shown on this drawing are only approximate. Level 3 Communications, LLC hereby disclaims any responsibility to third parties for the accuracy of this information. Persons working in the area covered by this drawing must contact the statewide Call-Before-You-Dig System to ascertain the location of underground utilities prior to performing any excavation.

Rev	Description	Design By	Quality Control		Approved	
			By	Date	By	Date
1	AS-BUILT DWGS			52001		

CALL BEFORE YOU DIG
1-800-332-2344

48 HOURS NOTICE
REQUIRED



Owner: **Level(3) COMMUNICATIONS**

Contractor: **PKS Kiewit Network Services Co.**

Engineer: **PARSONS BRINCKERHOFF**

Program:	Intercity Network					
City Pair:	Sacramento to Portland					
Package Title:	City of Millersburg					
Drawing Title:	8+00 to 21+20					
City Pair Code	Span No.	Package No.	Type	Drawing No.	Rev	Sheet No.
SACPOR	10		P	171	A	

SEC 21, T10S, R3W, W.M.
CITY OF MILLERSBURG, OR

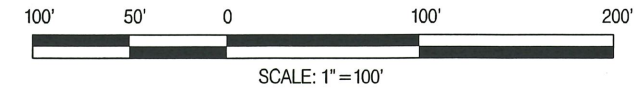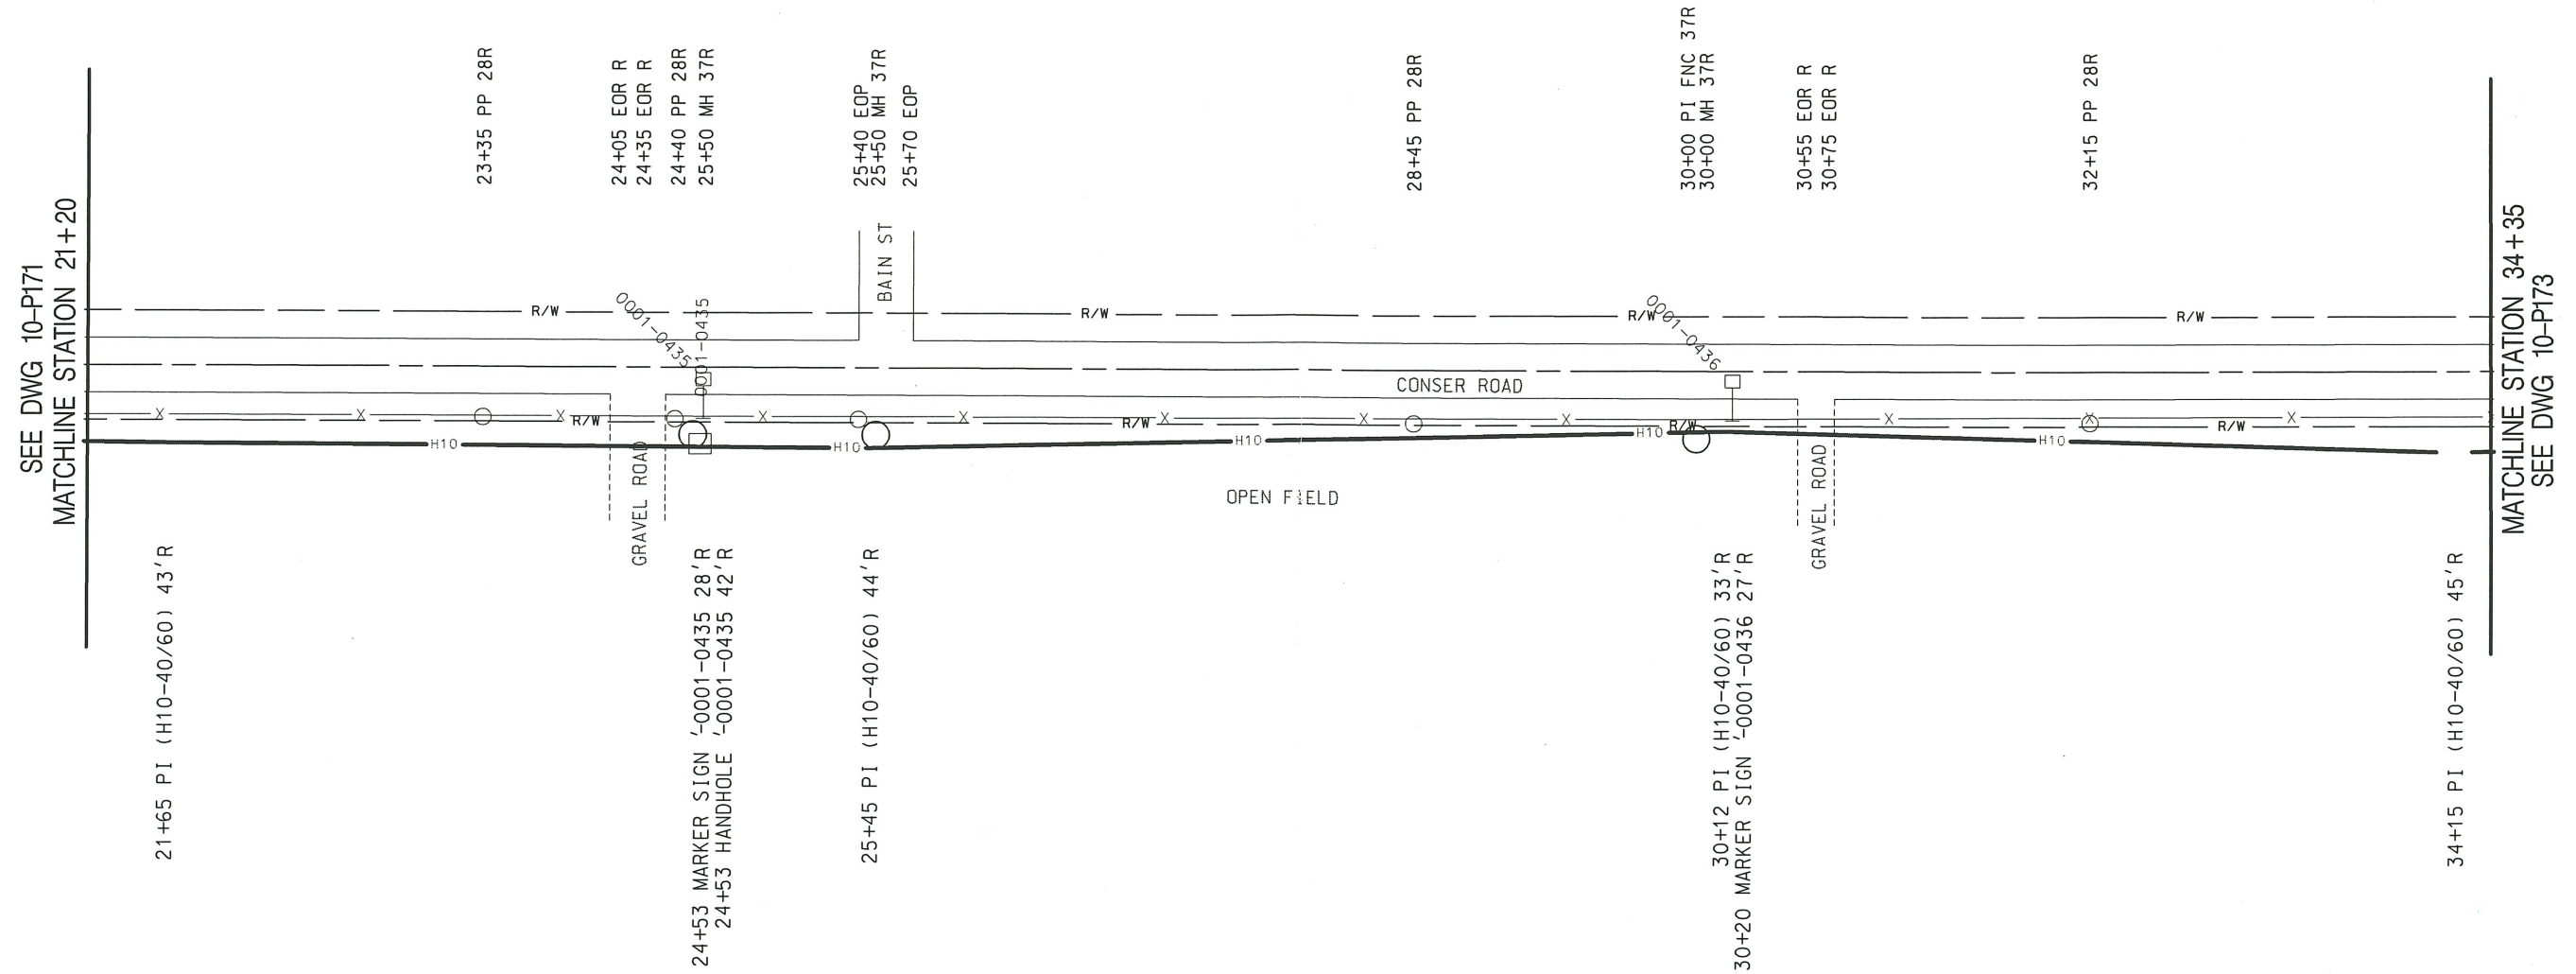

User: \$(User)
Time: 11:11:16
Date: 30 MAY 101
Filename: I:\paper_deliverable\sacpor\millersburg\span10_172.dgn

The locations of utilities shown on this drawing are only approximate. Level 3 Communications, LLC hereby disclaims any responsibility to third parties for the accuracy of this information. Persons working in the area covered by this drawing must contact the statewide Call-Before-You-Dig System to ascertain the location of underground utilities prior to performing any excavation.

Rev	Description	Design By	Quality Control		Approved	
			By	Date	By	Date
1	AS-BUILT DWGS			5/20/01		

CALL BEFORE YOU DIG
1-800-332-2344
48 HOURS NOTICE
REQUIRED



Owner: **Level (3) COMMUNICATIONS**

Contractor: **PKS Kiewit Network Services Co.**

Engineer: **PARSONS BRINCKERHOFF**

Program:	Intercity Network					
City Pair:	Sacramento to Portland					
Package Title:	City of Millersburg					
Drawing Title:	21+20 to 34+35					
City Pair Code	Span No.	Package No.	Type	Drawing No.	Rev	Sheet No.
SACPOR	10		P	172	A	

SEC 21, T10S, R3W, W.M.
CITY OF MILLERSBURG, OR

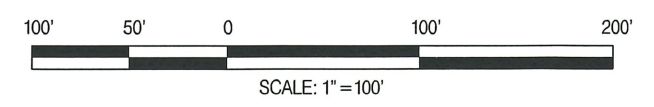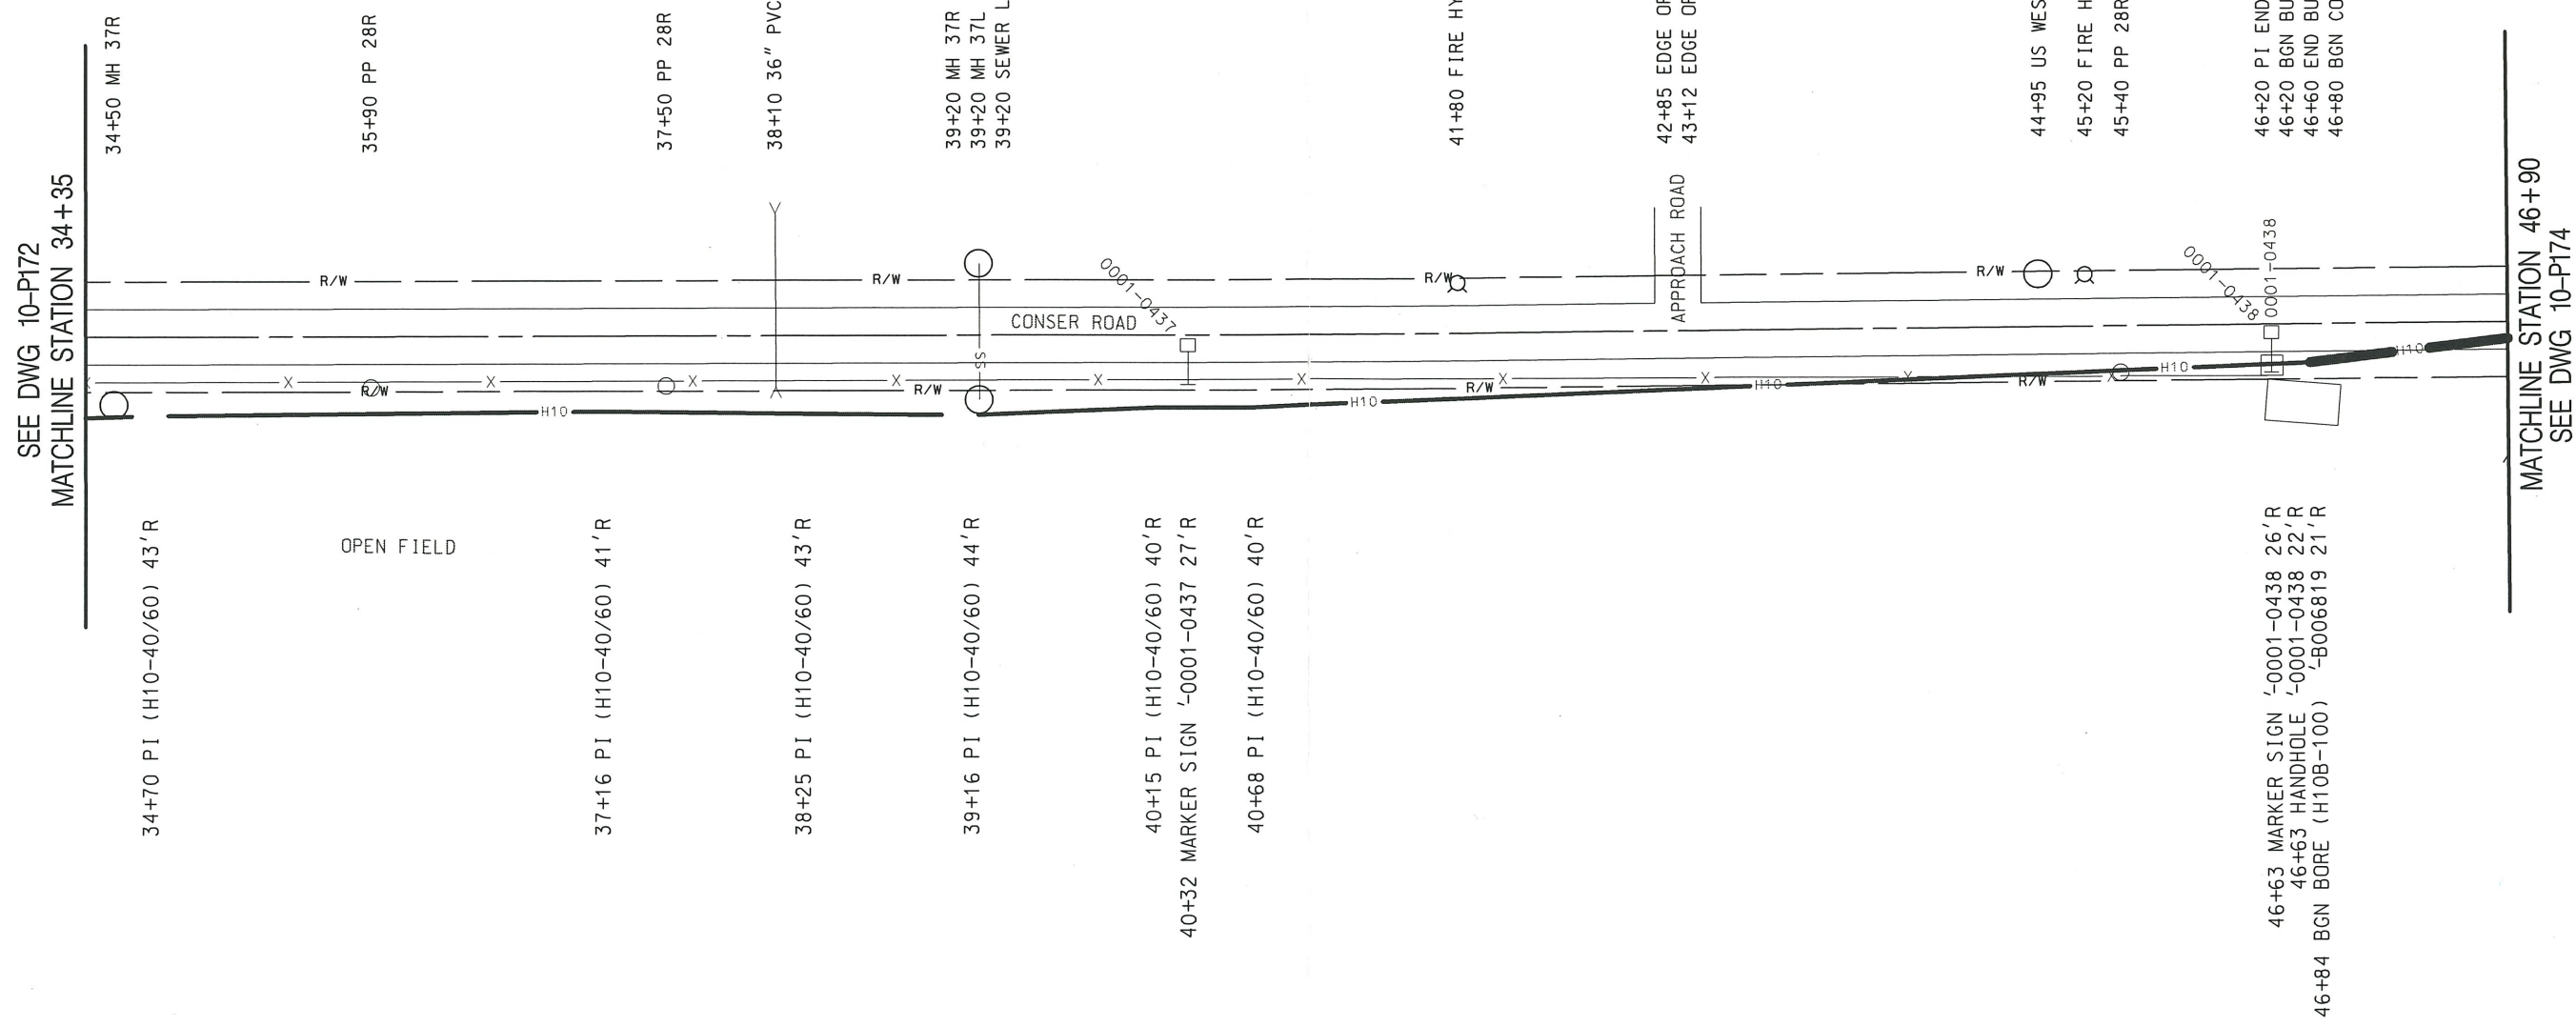

User: \$(User)
Time: 11:11:27
Date: 30 MAY '01
Filename: I:\paper_deliverable\sacpor\millersburg\span10_173.dgn

The locations of utilities shown on this drawing are only approximate. Level 3 Communications, LLC hereby disclaims any responsibility to third parties for the accuracy of this information. Persons working in the area covered by this drawing must contact the statewide Call-Before-You-Dig System to ascertain the location of underground utilities prior to performing any excavation.

Rev	Description	Design By	Quality Control		Approved	
			By	Date	By	Date
1	AS-BUILT DWGS			52001		

CALL BEFORE YOU DIG
1-800-332-2344

48 HOURS NOTICE
REQUIRED

Owner:
Level (3) COMMUNICATIONS

Contractor:
PKS Kiewit Network Services Co.

Engineer:
PARSONS BRINCKERHOFF

Program:	Intercity Network					
City Pair:	Sacramento to Portland					
Package Title:	City of Millersburg					
Drawing Title:	34 + 35 to 46 + 90					
City Pair Code	Span No.	Package No.	Type	Drawing No.	Rev	Sheet No.
SACPOR	10		P	173	A	